



---

**[EXTERNAL] Muskogee Community RDF - Tier III Permit Modification**

---

**From** Queen, Jonathan <jqueen@wcgrp.com>

**Date** Wed 10/8/2025 11:00 AM

**To** Jeff Biddick <Jeff.Biddick@deq.ok.gov>

**Cc** gcampbe1@wm.com <gcampbe1@wm.com>; Ignaski, Johnna <jpuhr@wcgrp.com>

 1 attachment (4 MB)

2025-10-08 Musk Revised Figures.pdf;

Jeff,

Thanks for reaching out regarding the Muskogee Community RDF Tier III permit modification.

Based on our phone conversation on 10/07/25 we have revised the following figures that are included in the attached pdf.

- Figure 10
- Figure E-1-3

The revisions on both figures include the following

- Added Well c – This is the private well that was installed in April 2023 to the west of the site location. Information on Well c has been added to the table on the right side of the figure as well.
- Added Well E – This private well is located to the northwest of the site right at the 3-mile radius line. Based on the OWRB GIS system, it appears to be just outside the 3-mile radius, however, to be conservative given we were updating the dwg, we add Well E in. Information on Well E has been added to the table on the right side of the figure as well.
- Added Well F – This private well is located to the southwest of the site near the 3-mile radius line. Well F was installed in July 2025. Information on Well F has been added to the table on the right side of the figure as well.
- Note 3 – Note 3 was updated to reflect the October 2025 update.
- Note 5 – Note 5 was removed. The not indicated that no wells were located within 1-mile. Given the additional of Well c, this note was removed.
- Revision Note – A description of the revisions to the figure were added to the title block.

Please feel free to reach out with any questions.

Thanks

**Jonathan Queen, P.E.**

Principal



6420 Southwest Blvd. | Suite 206

Fort Worth, TX 76109

10/9/25, 8:59 AM

[EXTERNAL] Muskogee Community RDF - Tier III Permit Modification - Jeff Biddick - Outlook

O: 817-735-9770 | F: 817-735-9775 | M: 817-851-9464


[jqueen@wcgrp.com](mailto:jqueen@wcgrp.com) | [www.wcgrp.com](http://www.wcgrp.com) 



**SAFETY FIRST, TRUSTED ADVISORS, 12:1 CULTURE**

IMPORTANT NOTICE: The information contained in this email message (including any attachments) may be confidential, privileged or both, and is intended exclusively for the addressee(s) intended by the sender. If it appears you have received this email message in error, please notify the sender immediately and then delete; any other use of this email message is prohibited. Thank you.



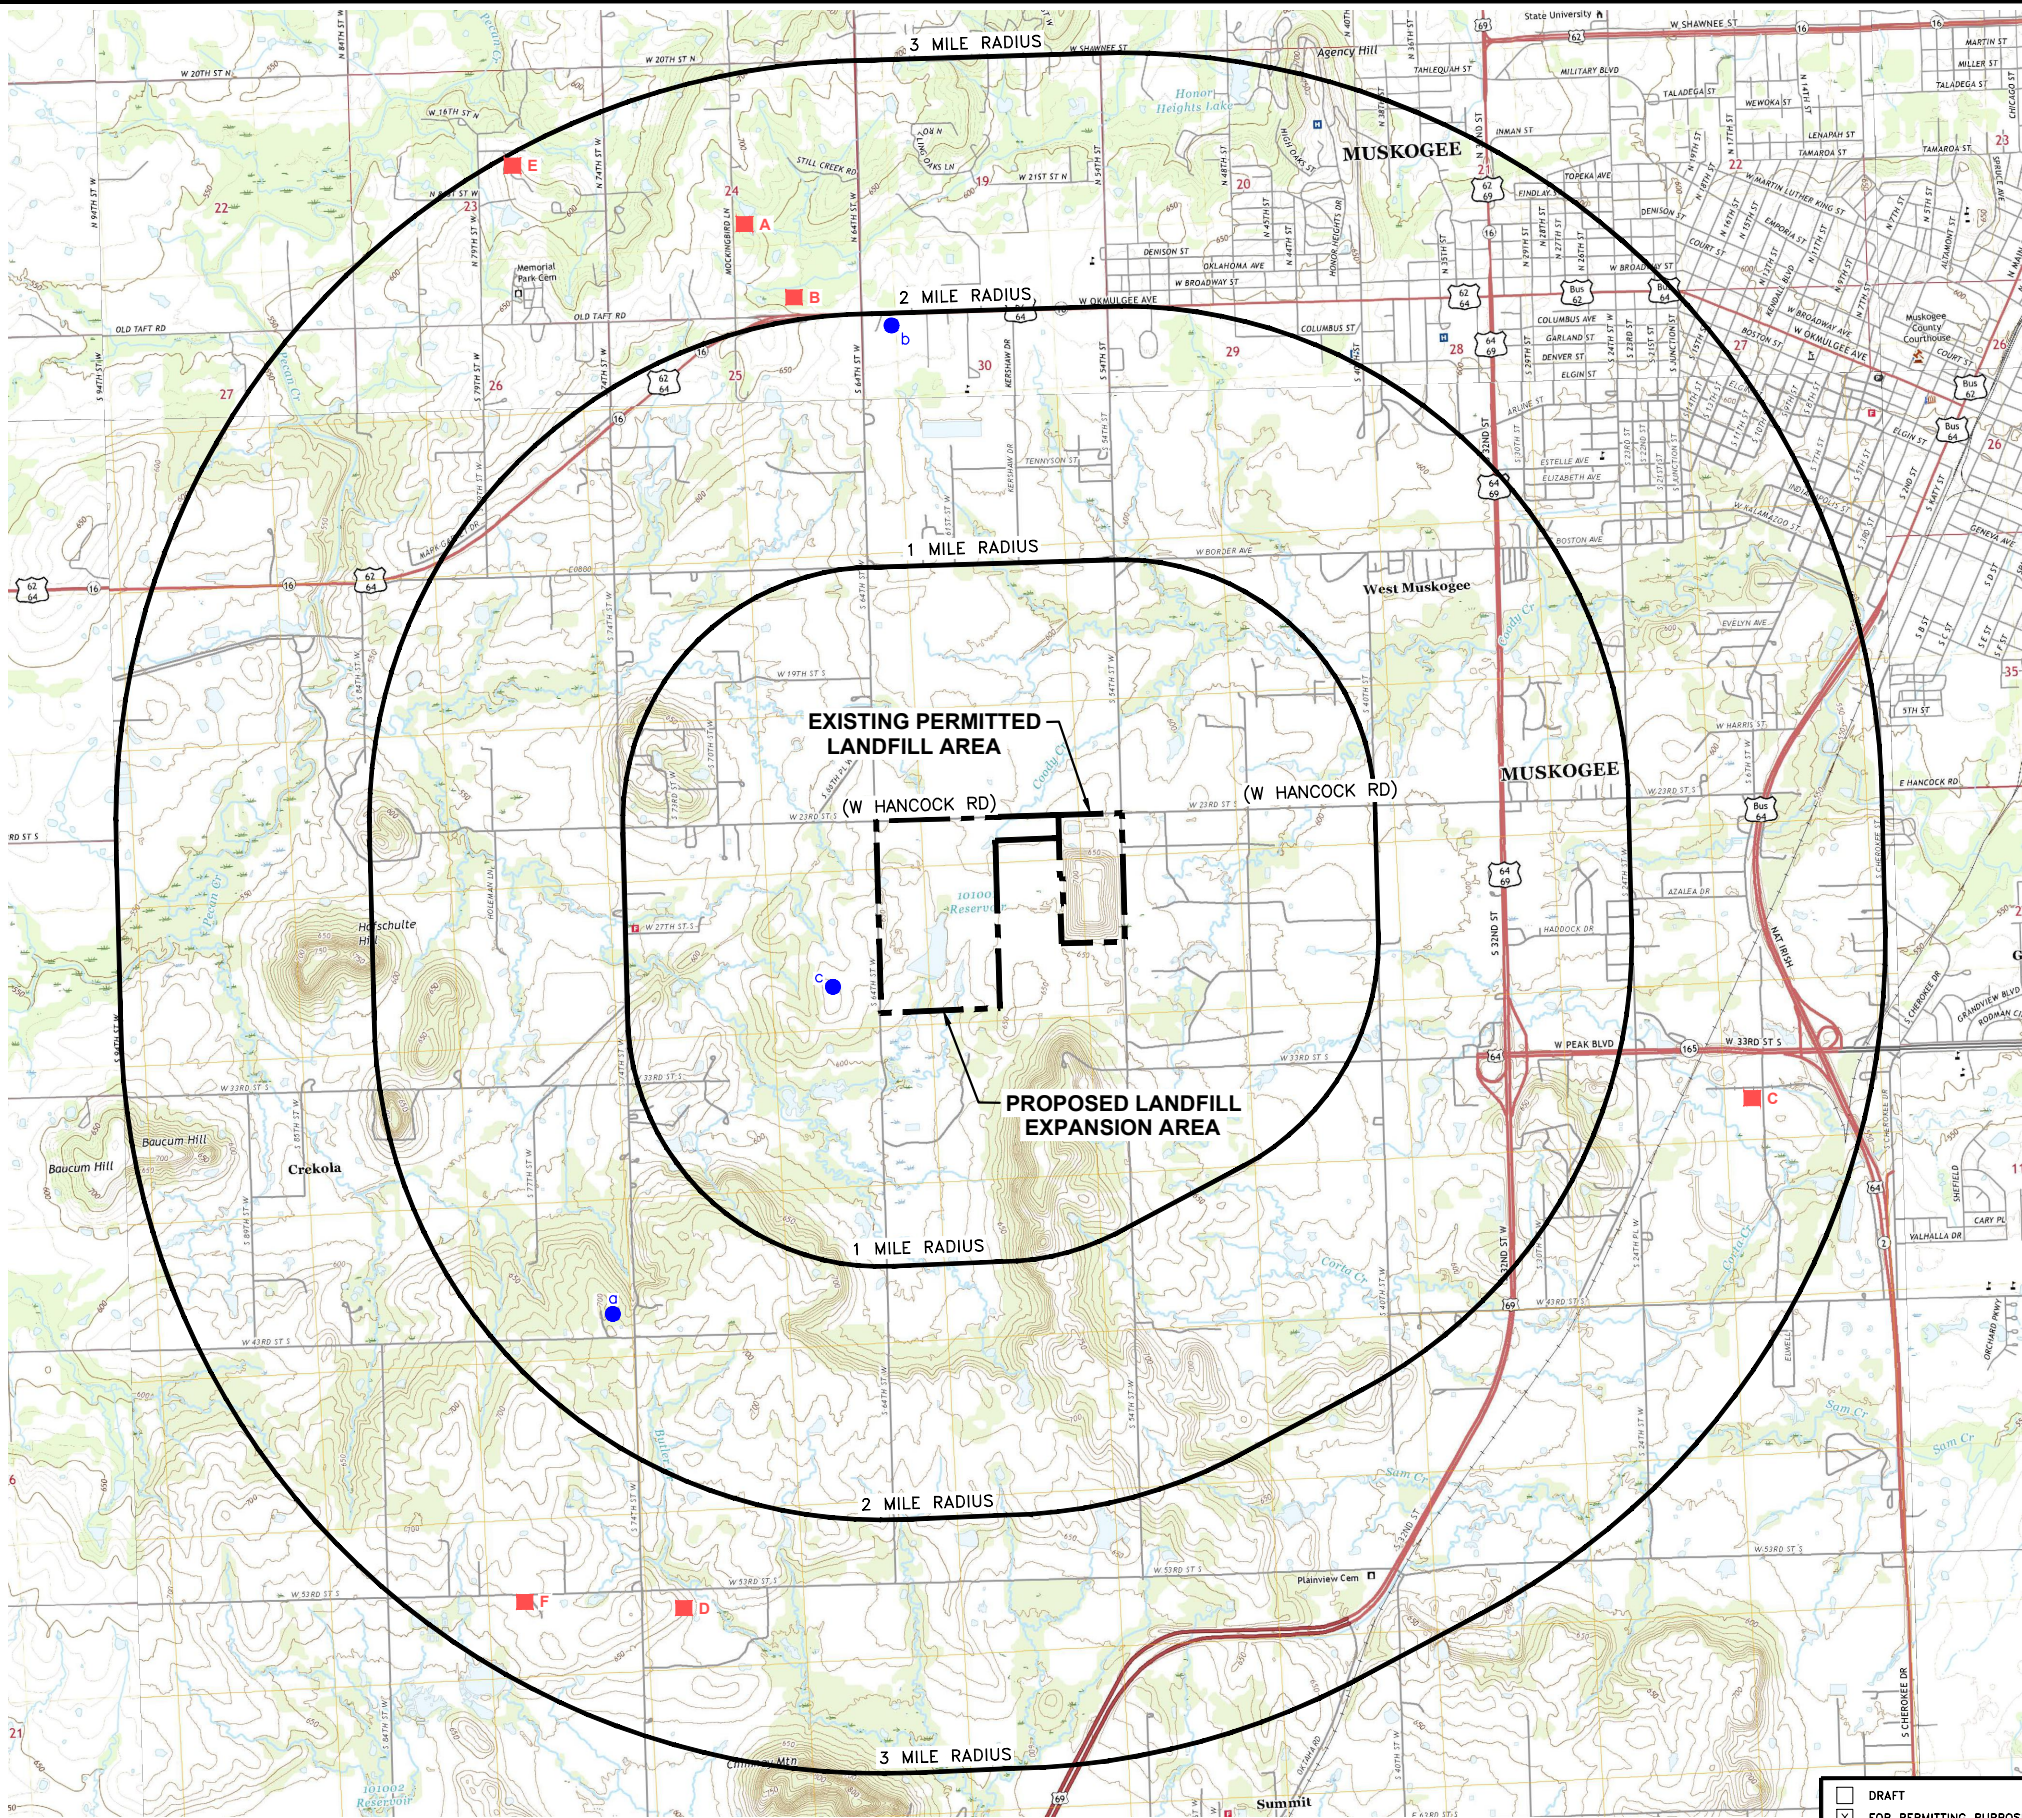

0

2000

4000

SCALE IN FEET

LEGEND

EXISTING PERMIT BOUNDARY

PROPOSED PERMIT BOUNDARY

OWRB PRIVATE WATER WELL LOCATION WITHIN 2.0 MILE OF PROPOSED PERMIT BOUNDARY

OWRB PRIVATE WATER SUPPLY WELL LOCATION WITHIN 3.0 MILES OF PROPOSED PERMIT BOUNDARY

LICENSED PROFESSIONAL ENGINEER

JONATHAN V. QUEEN

24456

OKLAHOMA

10/08/2025

PRIVATE WATER SUPPLY WELLS INSIDE 2 MILE RADIUS				
MAP ID	WELL ID #	OWNER	TOTAL DEPTH	GROUNDWATER ELEVATION
a	23573	B.E. DAVIS	102	N/A*
b	23573	B.E. DAVIS	75	40
c	22085	W. GREUEL	120	28

PRIVATE WATER SUPPLY WELLS INSIDE 3 MILE RADIUS				
MAP ID	WELL ID #	OWNER	TOTAL DEPTH	GROUNDWATER ELEVATION
A	168576	ANTHIS	140	14
B	185470	DONALD BROOKS	180	60
C	36841	JACK ASHWOOD	175	113
D	71669	JIM HALEY	70	54
E	47657	DOYLE BESS	125	N/A*
F	237128	XAI MOUA	180	40

\* INFORMATION NOT AVAILABLE ON THE OKLAHOMA WATER RESOURCES BOARD WEB PAGE.

NOTES:

- ADAPTED FROM USGS 7.5 MINUTE QUADRANGLE TOPOGRAPHIC MAP (SOUTHWEST MUSKOGEE, SOUTHEAST MUSKOGEE, NORTHWEST MUSKOGEE, NORTH WEST MUSKOGEE, TAFT, BEELAND, WAIN WRIGHT, OKTAHA AND KEETTON, OK 2022).
- PERMIT BOUNDARY WAS REPRODUCED FROM LEGAL DESCRIPTION PREPARED BY WEAVER CONSULTANTS GROUP, SIGNED BY MICHAEL D BYTNER, LLS# 1986.
- PUBLIC WATER WELL RECORDS OBTAINED FROM THE OKLAHOMA WATER RESOURCES BOARD (OWRB) ON-LINE GIS DATABASES (SEPTEMBER 2022, UPDATED OCTOBER 2025).
- THE OWRB RECORDS INDICATE THERE ARE NO SURFACE WATER INTAKES LOCATED WITHIN 3.0 MILES DOWNSTREAM OF THE FACILITY.

DRAFT

FOR PERMITTING PURPOSES ONLY

ISSUED FOR CONSTRUCTION

DATE: 10/2023

FILE: 0086-364-11

CAD: FIG 10-GW RESOURCES/USAGE MAP.DWG

DRAWN BY: RAA

DESIGN BY: JBP

REVIEWED BY: JVO

Weaver Consultants Group

CA 3804 PE-06/30/2027

PREPARED FOR

WASTE MANAGEMENT OF OKLAHOMA, INC.

REVISIONS

NO.	DATE	DESCRIPTION
1	10/2025	ADDED WELLS 22085, 237128, AND 47657 UPDATED NOTE 3, REMOVED NOTE 5

TIER III PERMIT MODIFICATION  
PUBLIC AND PRIVATE WATER WELLS

MUSKOGEE COMMUNITY RDF  
MUSKOGEE COUNTY, OKLAHOMA

WWW.WCGRP.COM

FIGURE 10

COPYRIGHT © 2023 WEAVER CONSULTANTS GROUP. ALL RIGHTS RESERVED.



