

F.M. ENG'R	BRIDGE ENG'R	CONST. ENG'R	P.R.A.
<i>[Signature]</i>			

PUB. ROAD DIV. NO.	STATE	F.A.S. PROJ. NO.	FISCAL YEAR	SHEET NO.	TOTAL SHEETS
6	OKLA.	S-219(2)	1956	1	12

STATE OF OKLAHOMA DEPARTMENT OF HIGHWAYS

GRADY COUNTY

PLAN AND PROFILE FEDERAL AID SECONDARY PROJECT NO. S-219 (2) C

ROADWAY LENGTH 26,240.31 FT. 4.969 MI.
BRIDGE LENGTH 0.00 FT. 0.000 MI.
PROJECT LENGTH 4.969 MI.


EXCEPTIONS ----- 0) RR-17.35 FT.
EQUATIONS ----- (2) Sta. 67+43.02 Bk. = Sta. 67+94.98 Fwd. -51.96
Sta. 78+23.0 Bk. = Sta. 77+85.9 +37.10

CONVENTIONAL SIGNS



STATE OR COUNTY LINE	---
TOWNSHIP LINE	----
SECTION LINE	- - - -
1/4 SECTION LINE	- . - .
FENCE	—+—+—+—+—
RIGHT-OF-WAY-LINE	=====
TRAVELED WAY	=====
RAILROAD	—+—+—+—+—
GUARD RAIL	—+—+—+—+—
SURVEY LINE	—+—+—+—+—
CULVERT (BOX)	—+—+—+—+—
DROP INLET	—+—+—+—+—
CULVERT (PIPE)	—+—+—+—+—
TEL. POLE	—+—+—+—+—
POWER POLE	—+—+—+—+—
MARSH	—+—+—+—+—
TREES	—+—+—+—+—
STONE WALL	—+—+—+—+—
LEVEL DATUM:	—+—+—+—+—

INDEX OF SHEETS

SHEET NO. 1 TITLE SHEET
SHEET NO. 2 QUANTITIES AND DRAINAGE SCHEDULE
SHEET NO. 3-II PLAN & PROFILE
SHEET NO. 12 OKLA. STATE HIGHWAY COMM. STD. NO. 4-0

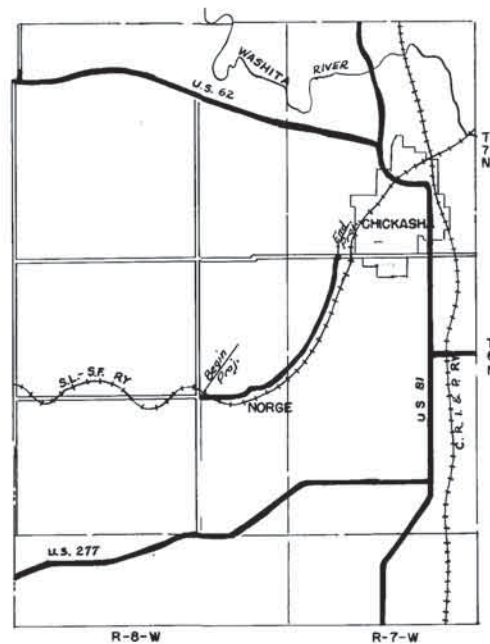

GRADY COUNTY
PROJECT LOCATION

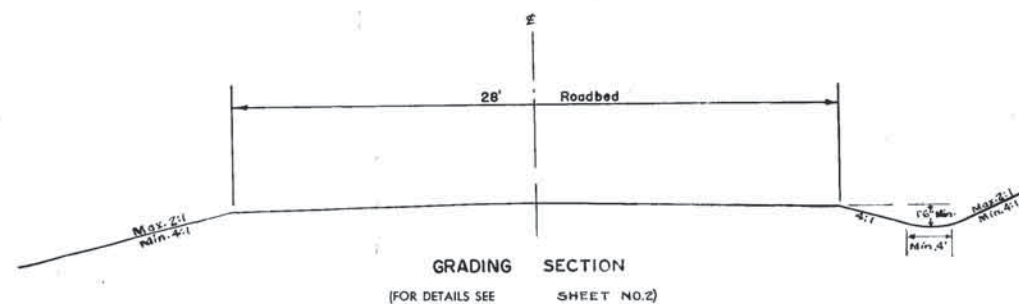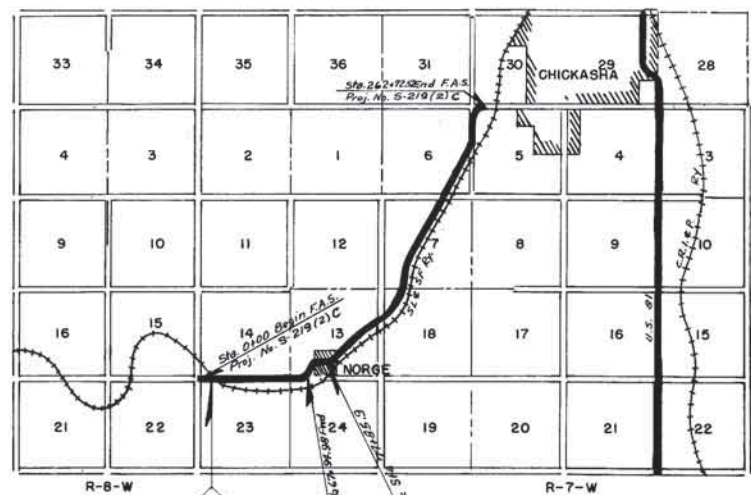

(SIGNED) *Ward H. Brown*
County Engineer

(SEAL)

APPROVED	DATE	3-30-56
DIST. 1	<i>H. J. Nickelson</i>	
DIST. 2	<i>Geo. R. Butler</i>	
DIST. 3		
COUNTY COMMISSIONERS		
APPROVED	DATE	
CHIEF ENGINEER		
OKLAHOMA HIGHWAY COMMISSION		
APPROVED	DATE	
DISTRICT ENGINEER		
DEPARTMENT OF COMMERCE		
BUREAU OF PUBLIC ROADS		

FA SPECIAL PROVISIONS GOVERN AND STATE STANDARD SPECIFICATIONS GOVERN.
APPROVED APRIL 28, 1955

As Built

PLAN	SURVEYED	B'	DATE

PROFILE		BY	DATE
SURVEYED			
PLOTTED			
GRADIS CHECKED			
B. M. NOTED			
STRUCTURE NOTATION'S CH'KD			
NO.			



PLAN	DATE	BY
DESIGNED		
PLOTTED		
NOTE BOOK		
NO.		

PROFILE	DATE	BY
DESIGNED		
PLOTTED		
NOTE BOOK		
NO.		

PUB. ROAD DIV. NO.	STATE	F.A.S. PROJ. NO.	FISCAL YEAR	SHEET NO.	TOTAL SHEETS
6	OKLA.	S-219(2)	1956	4	12

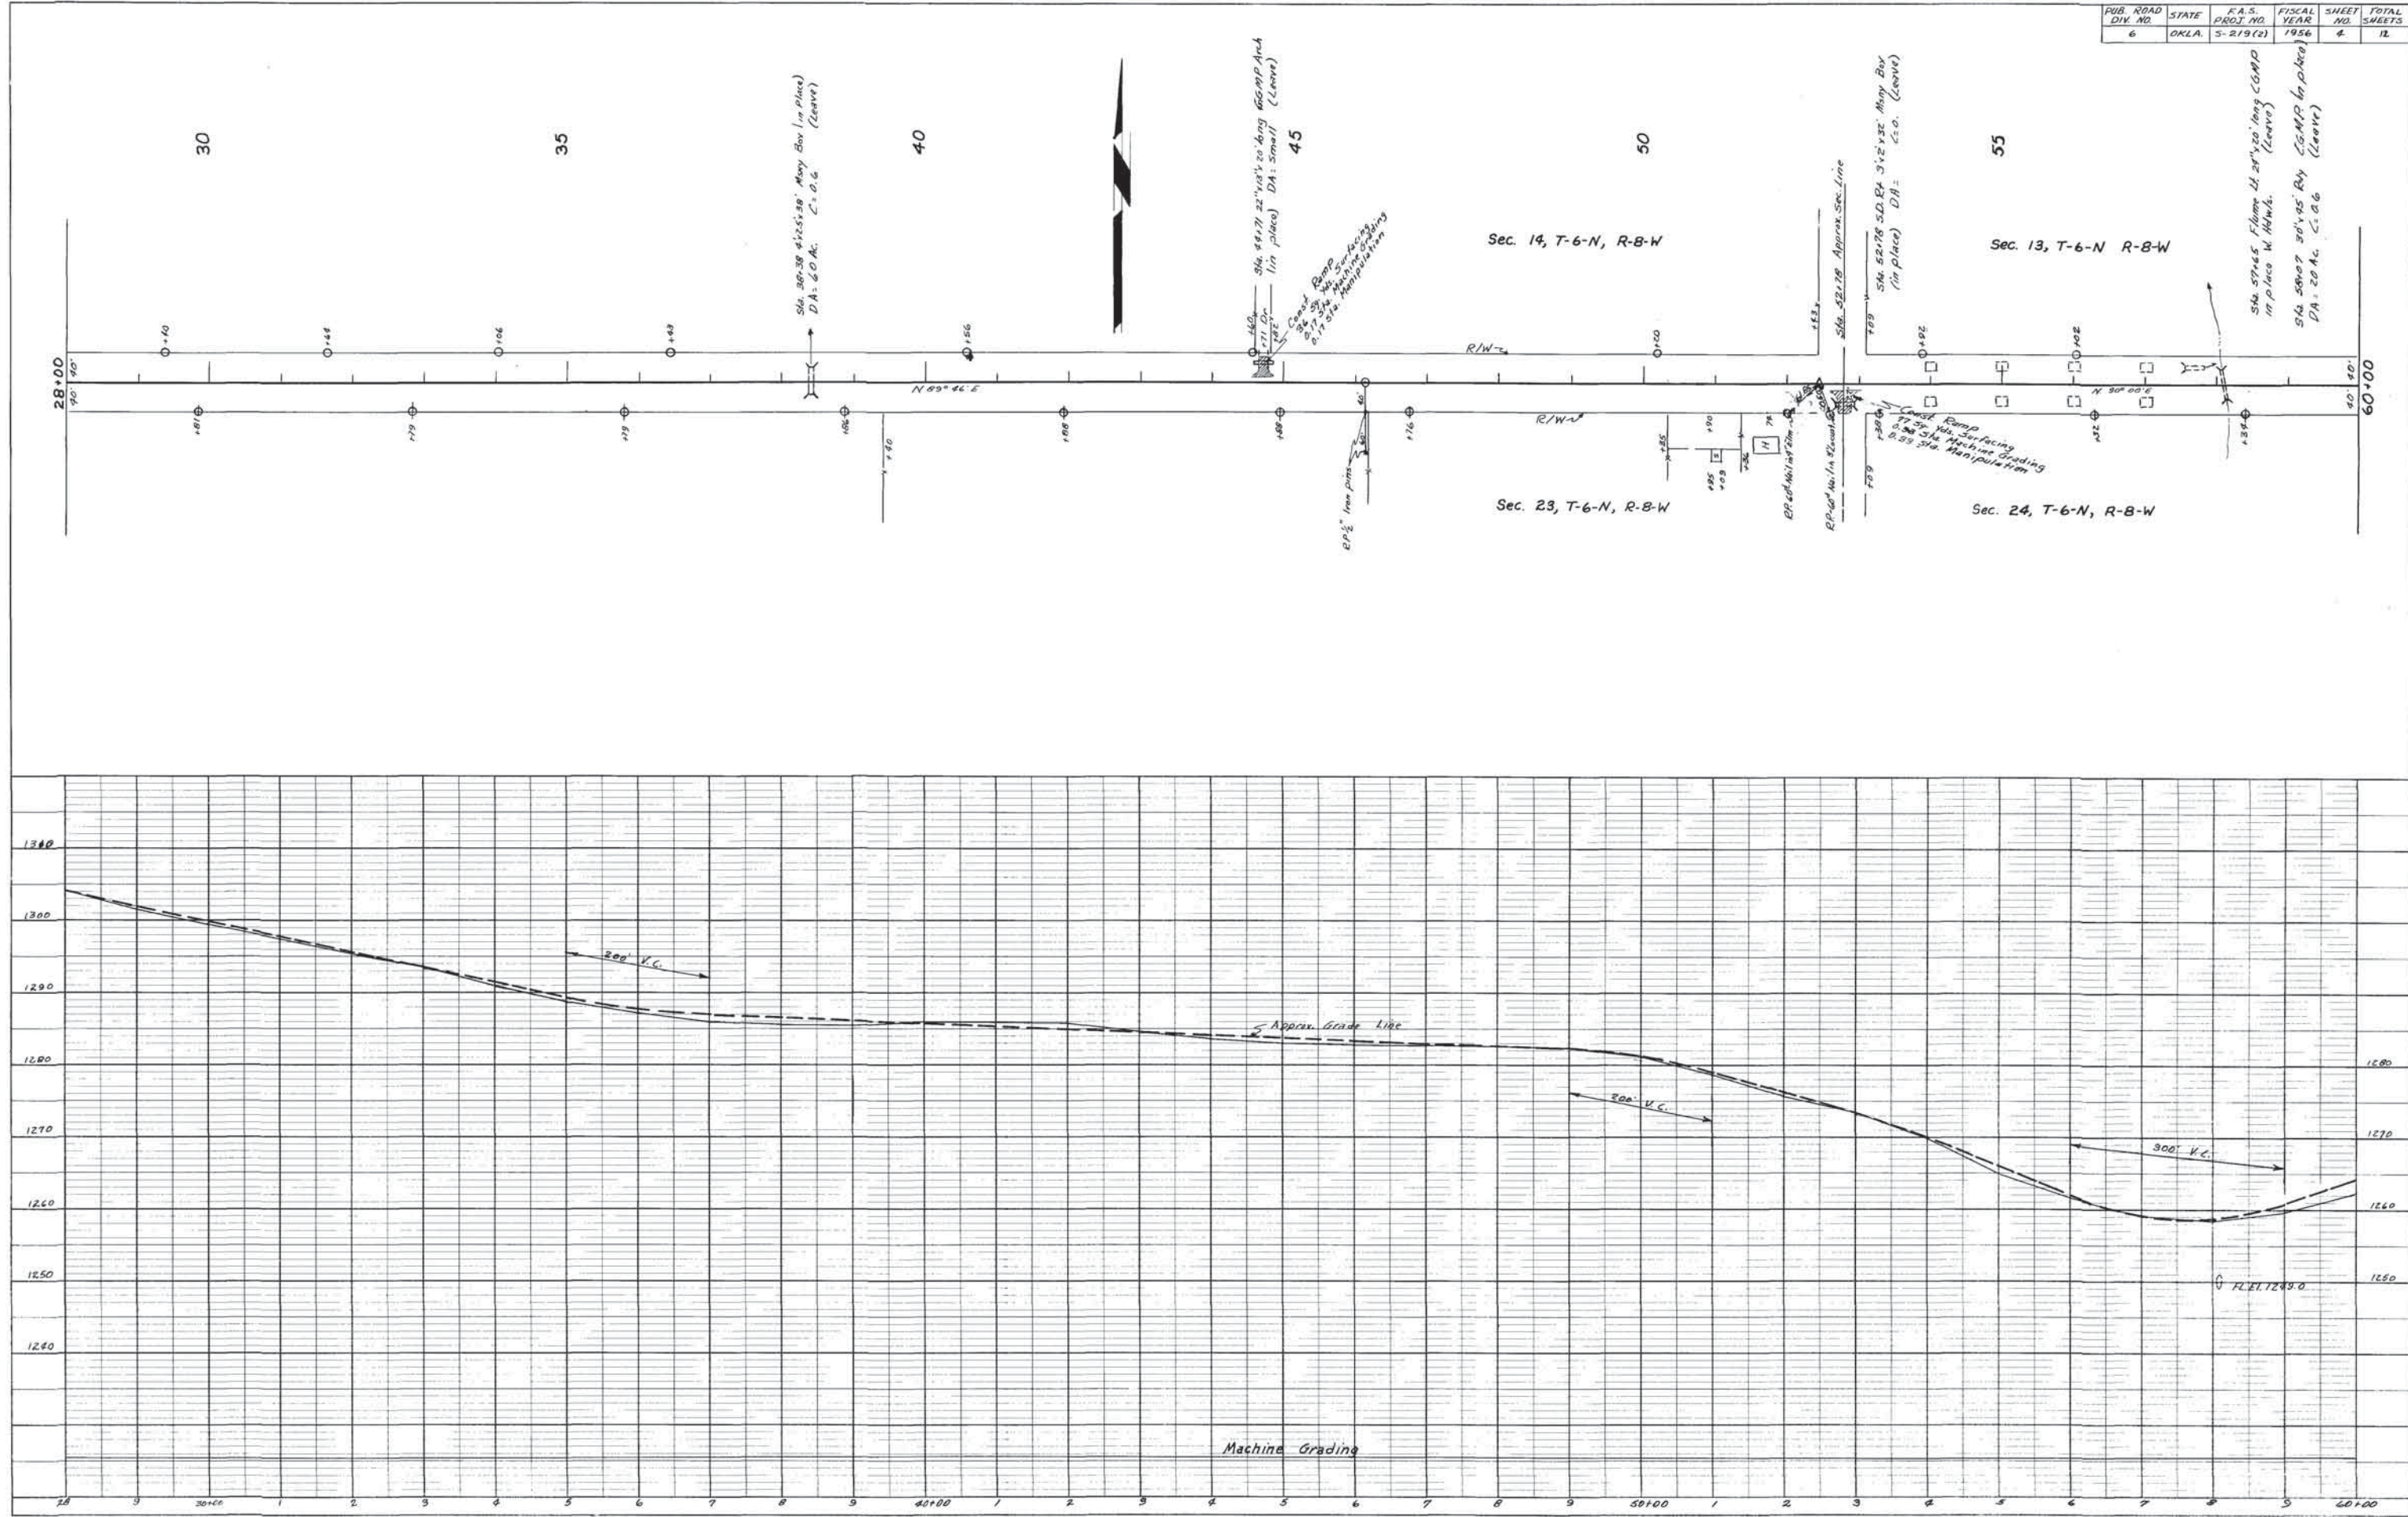


PLATE 1-PLAN-PROFILE B. R. R. STANDARD
100% RAG PAPER MADE AND PRINTED IN U. S. A.
EUGENE DIETZGEN CO.

PUB. ROAD DIV. NO.	STATE	F.A.S. PROJ. NO.	FISCAL YEAR	SHEET NO.	TOTAL SHEETS
6	OKLA.	5-219(2)	1956	5	12

PLAN	SURVEYED	DATE
	PLOTTED	BY
	CHECKED	
	NOTED	

PROFILE	SURVEYED	DATE
	PLOTTED	BY
	CHECKED	
	NOTED	




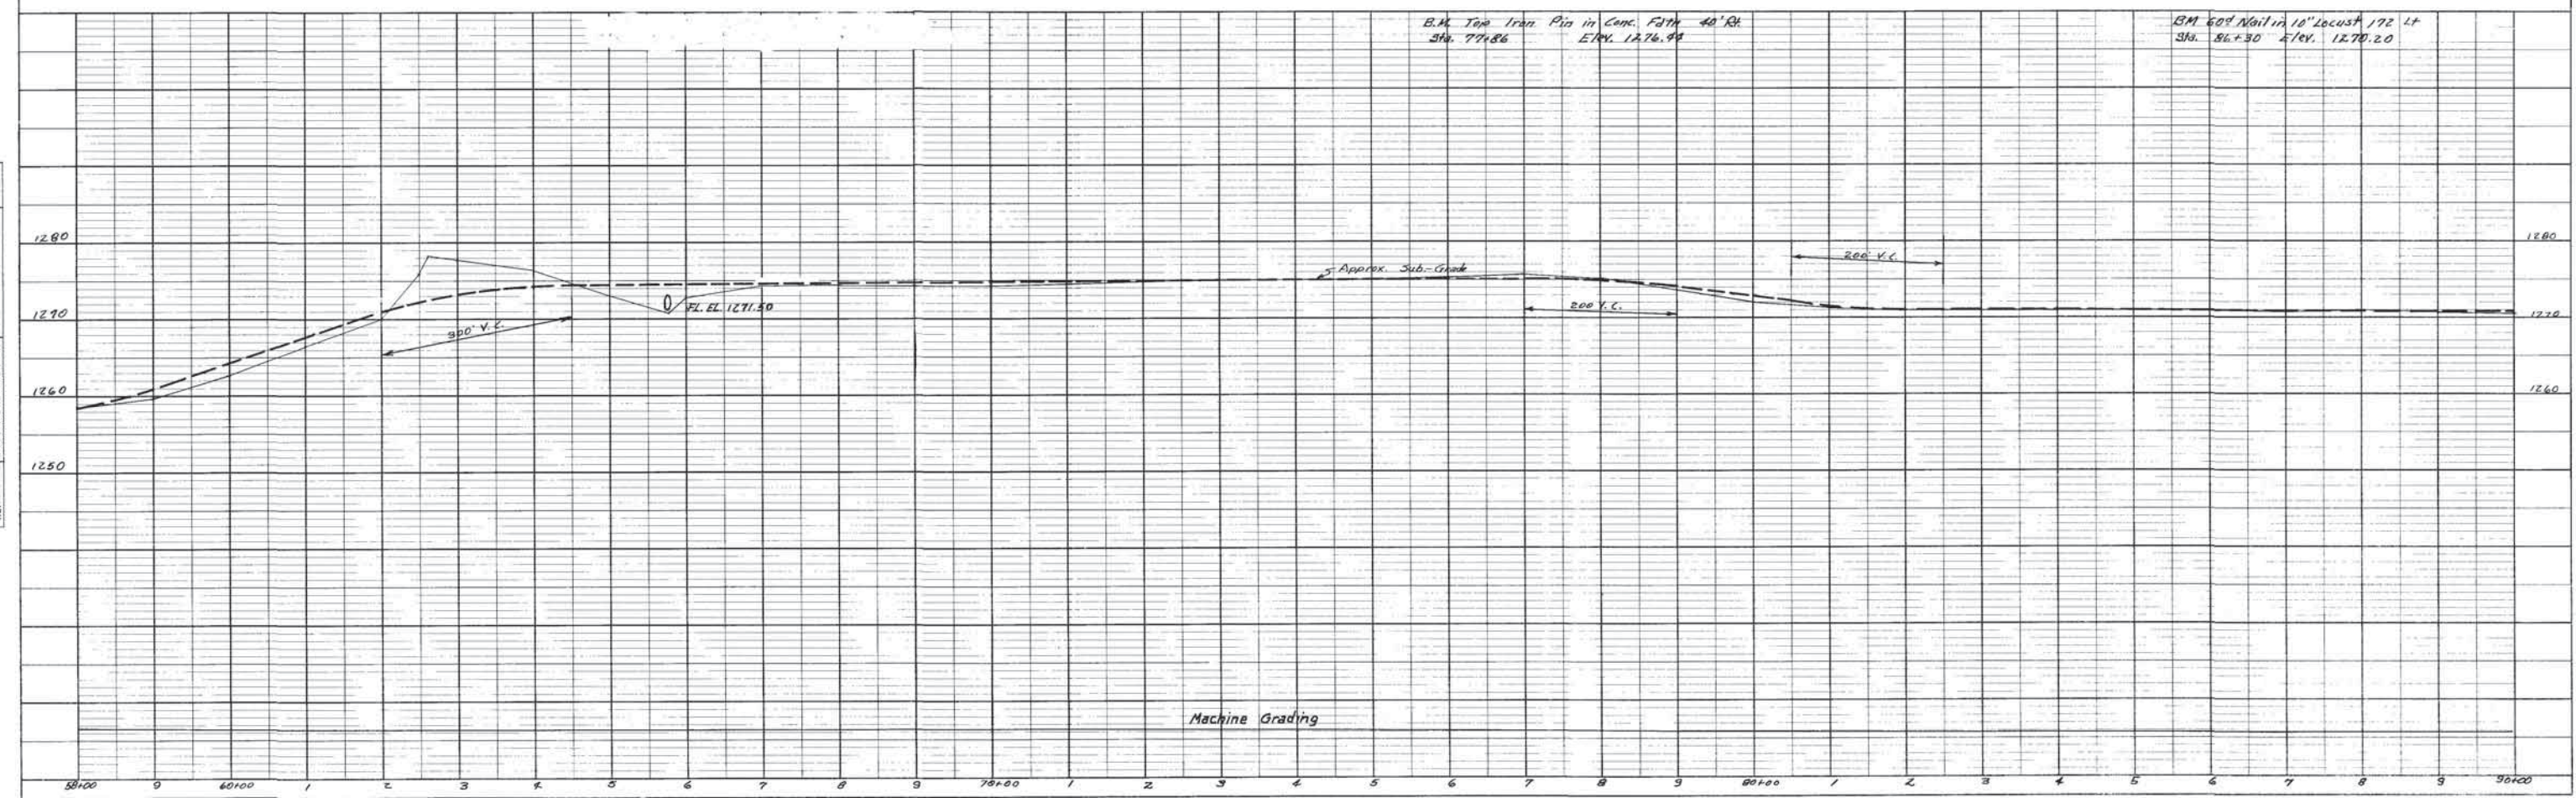


PLATE 1-PLAN-PROFILE B. R. R. STANDARD
100' HORIZ. SCALE - 1\"/>

PLAN	SURVEYED	DATE
	PLOTTED	BY
	ALIGNED CHECKED	
	NOTE BOOK	


PROFILE	SURVEYED	DATE
	PLOTTED	BY
	GRADES CHECKED	
	STRUCTURE NOTATIONS CH'NO.	

PUB. ROAD DIV. NO.	STATE	F.A.S. PROJ. NO.	FISCAL YEAR	SHEET NO.	TOTAL SHEETS
6	OKLA.	5-219(2)	1956	7	12

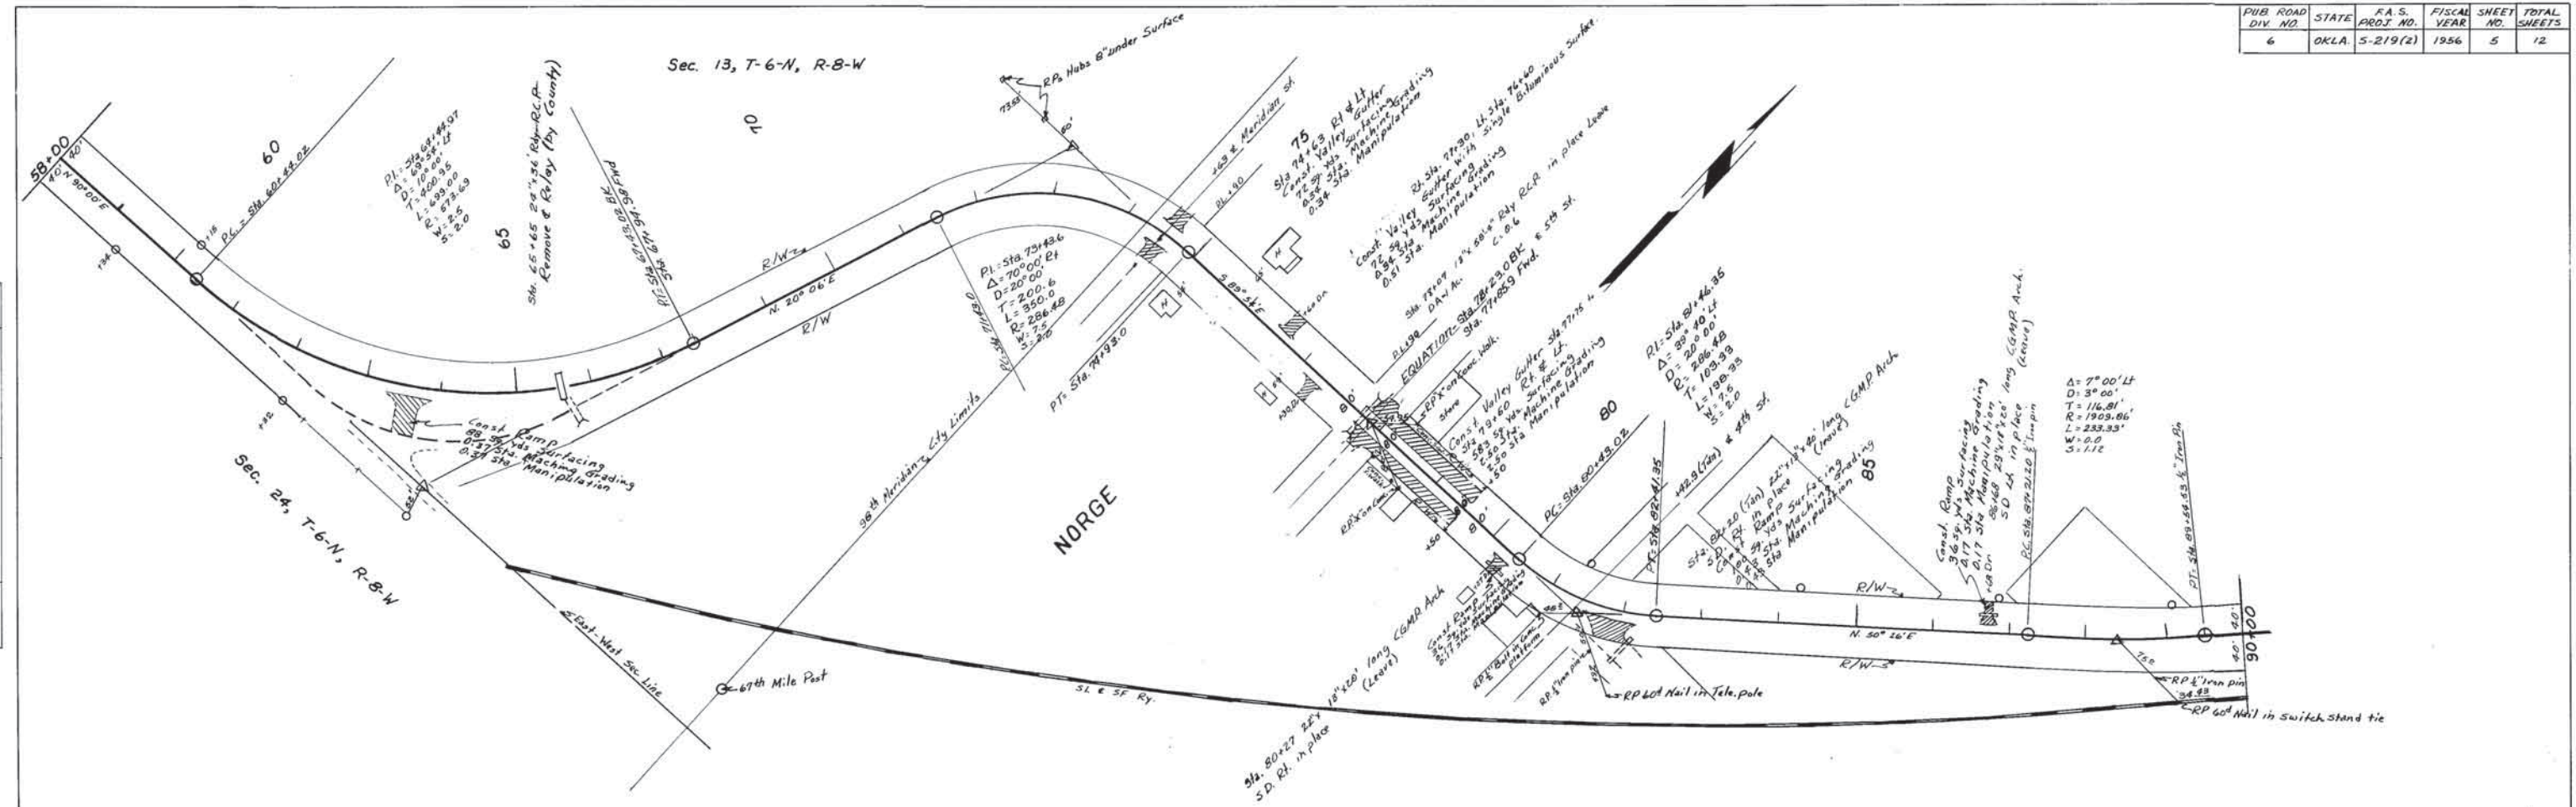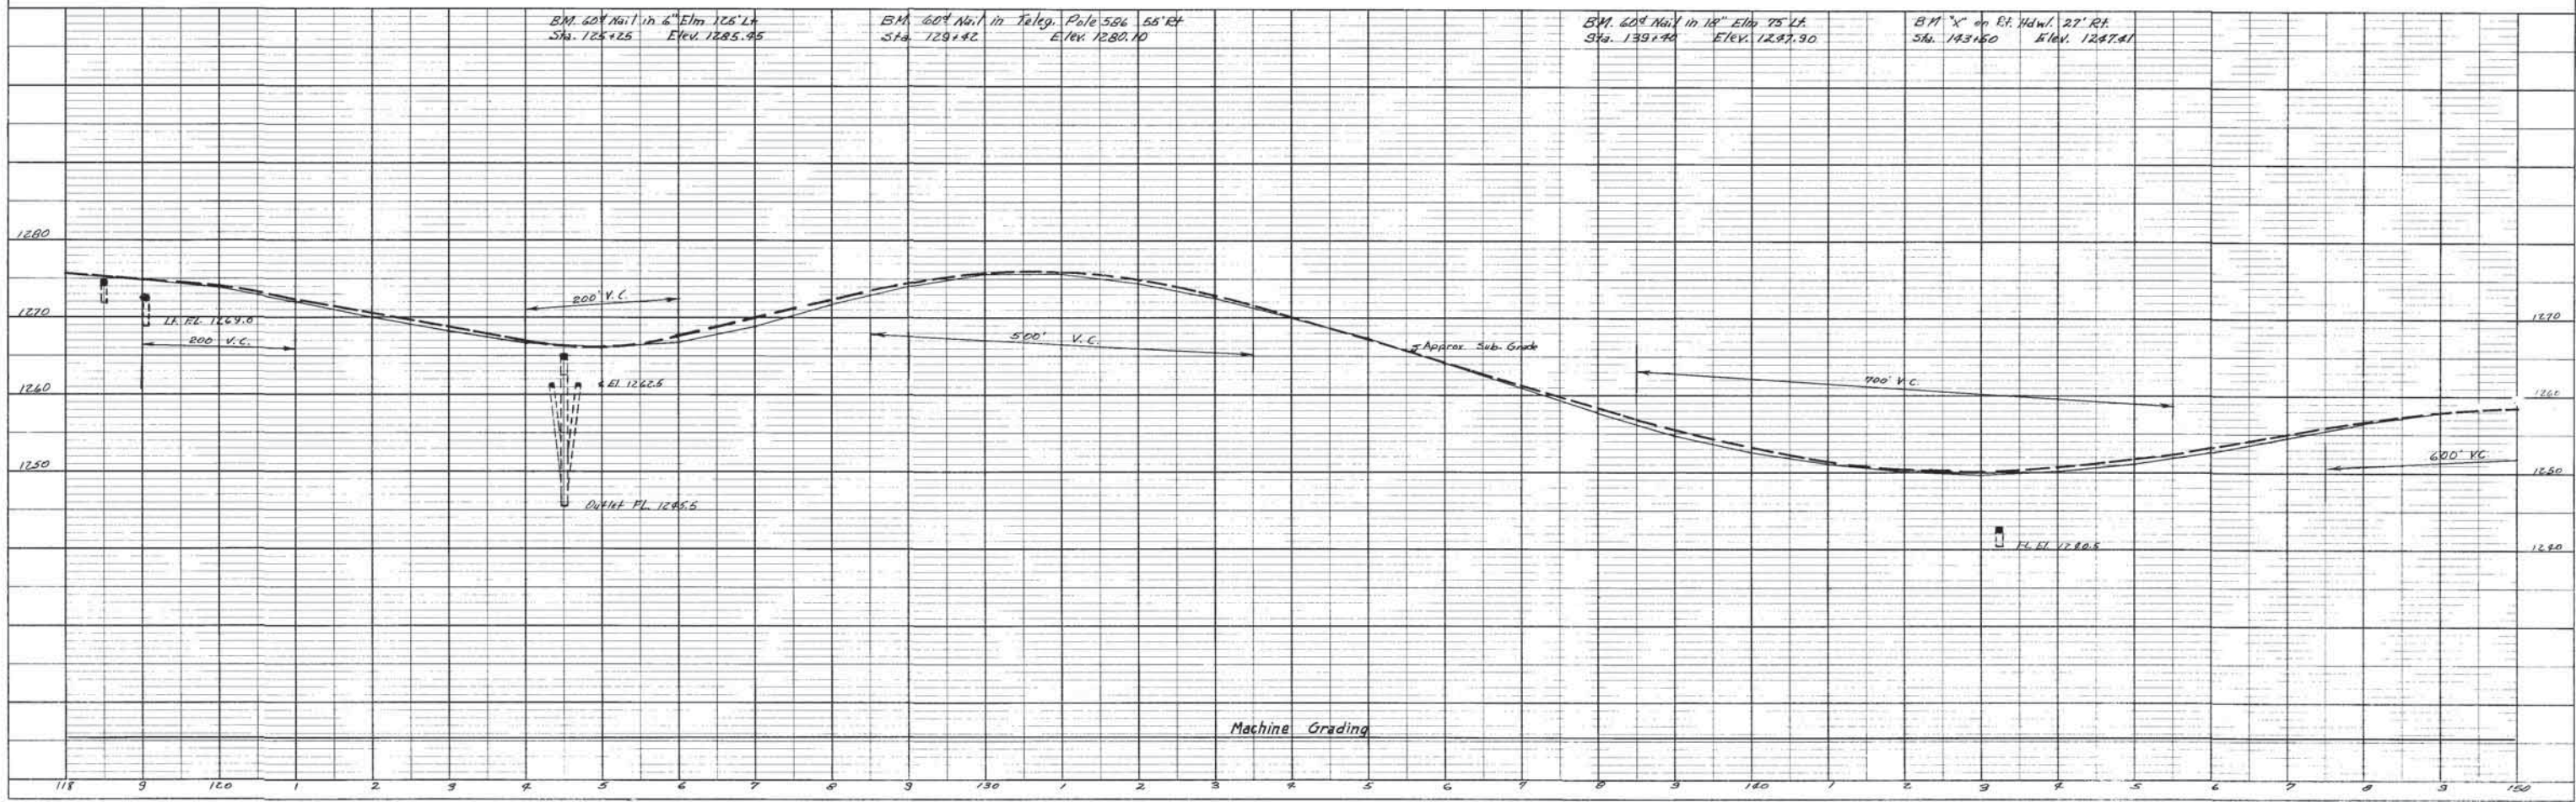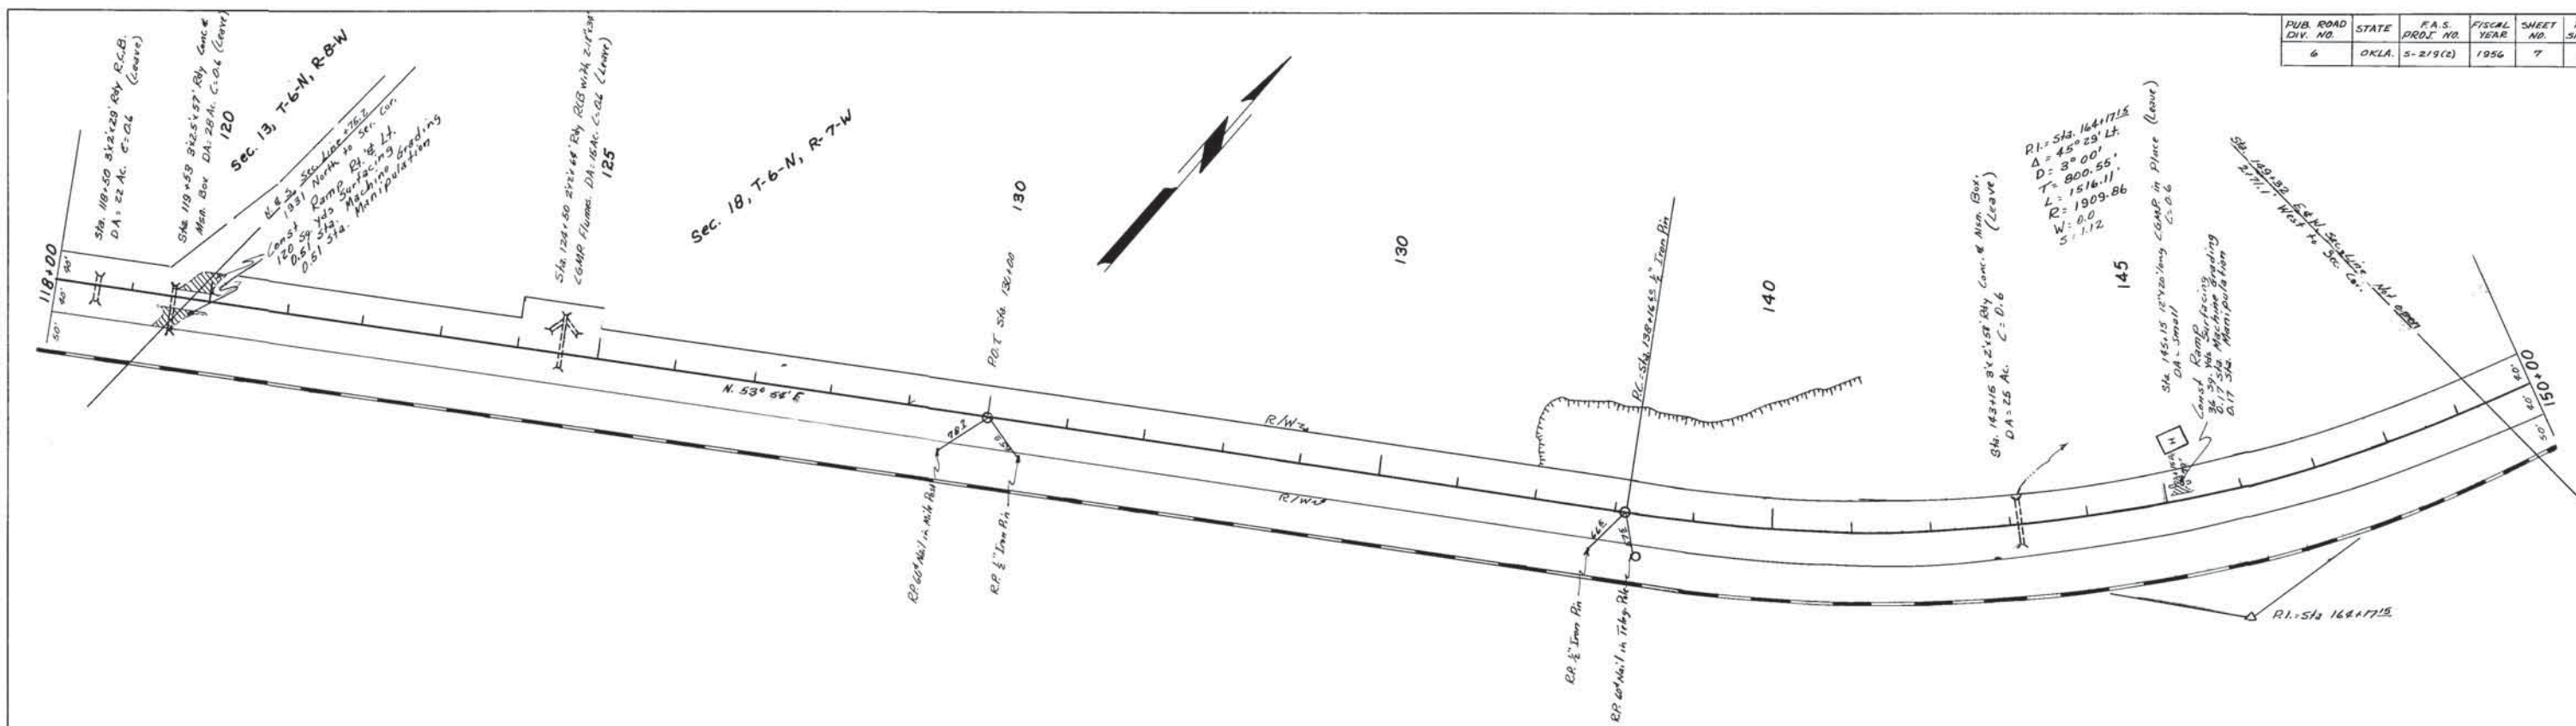


PUB. ROAD DIV. NO.	STATE	F.A.S. PROJ. NO.	FISCAL YEAR	SHEET NO.	TOTAL SHEETS
6	OKLA.	5-219(6)	1966	8	12

PLAN	SURVEYED	DATE
	PLOTTED	BY
	ALIGNED CHECKED	
	RT. OF WAY CHECKED	
NO.		

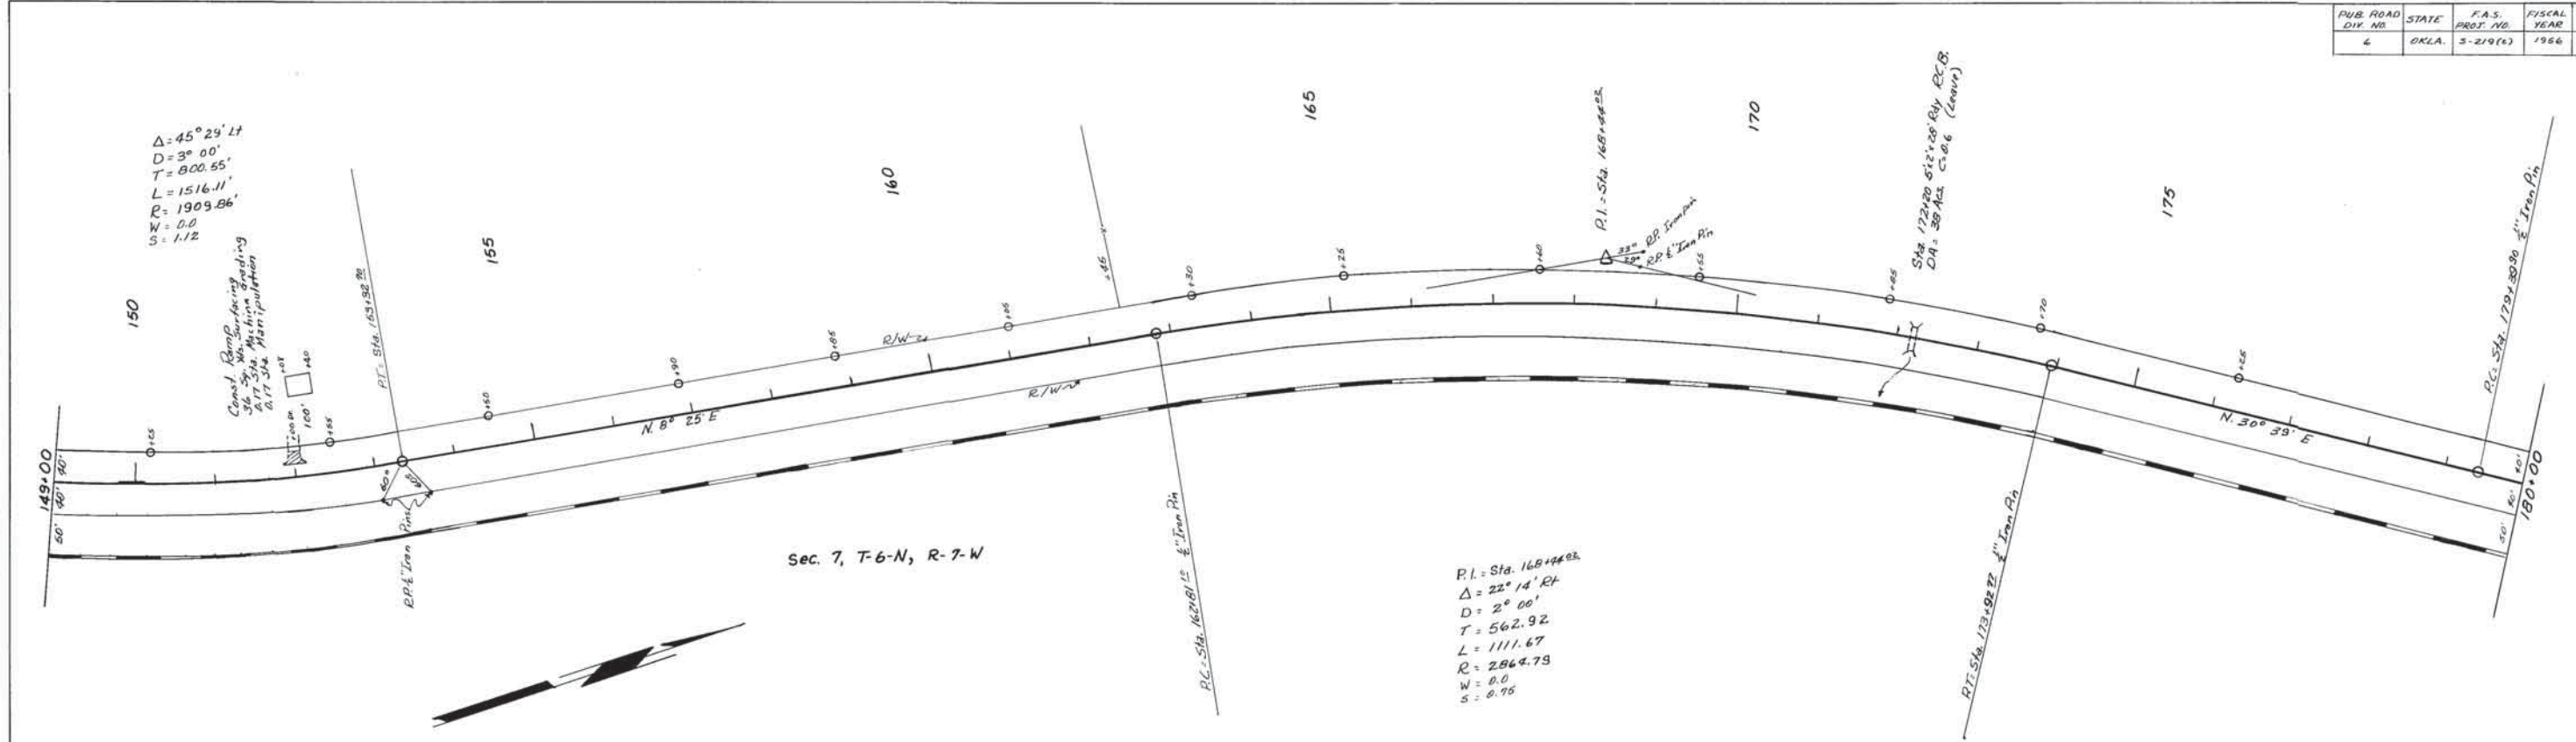

PROFILE	SURVEYED	DATE
	PLOTTED	BY
	GRADES CHECKED	
	STRUCTURE NOTATION CHECKED	
NO.		

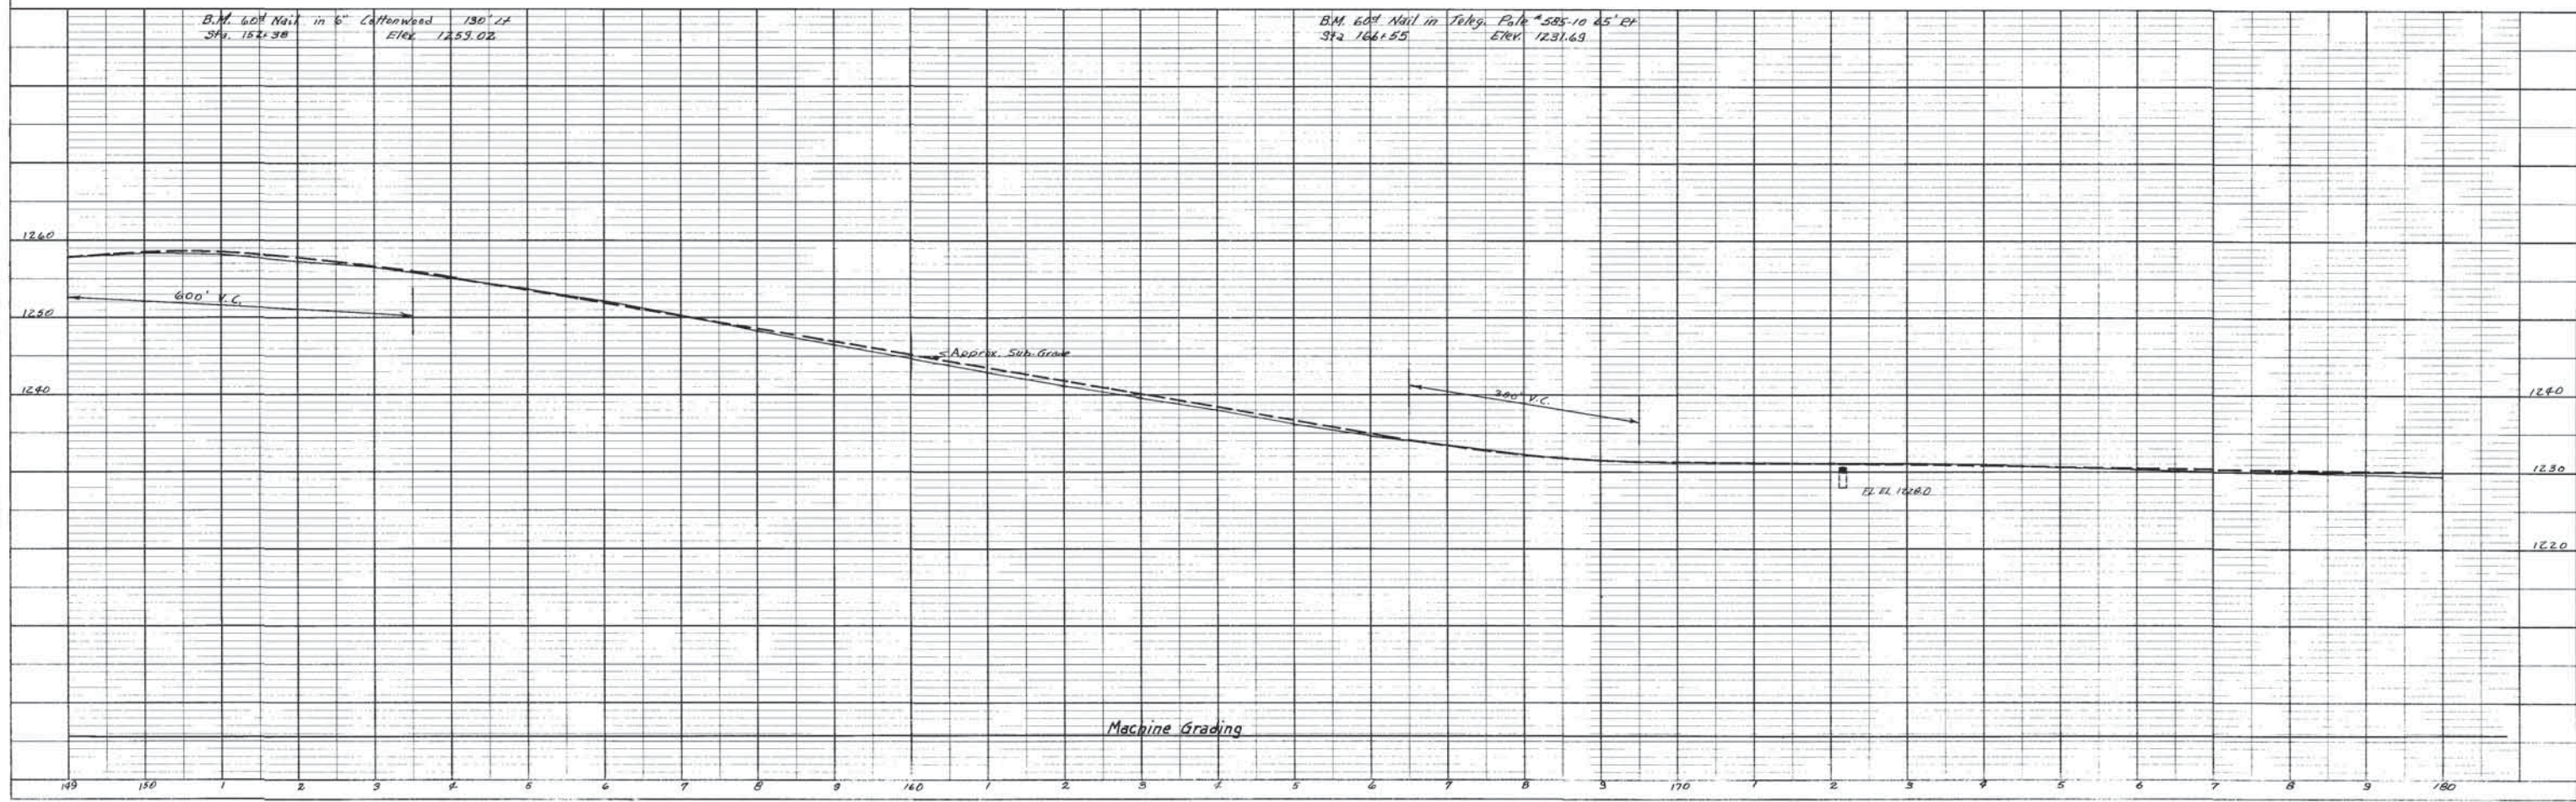

PLAN	SURVEYED		BY	DATE
	PLOTTED			
NOTE BOOK	ALIGNMENT CHECKED			
NO	RT. OF WAY CHECKED			

PROFILE		BY	DATE
SURVIVED			
PLOTTED			
GRADES CHECKED			
B. M. NOTED			
STRUCTURE NOTATION'S CH'KO.			
NO.			



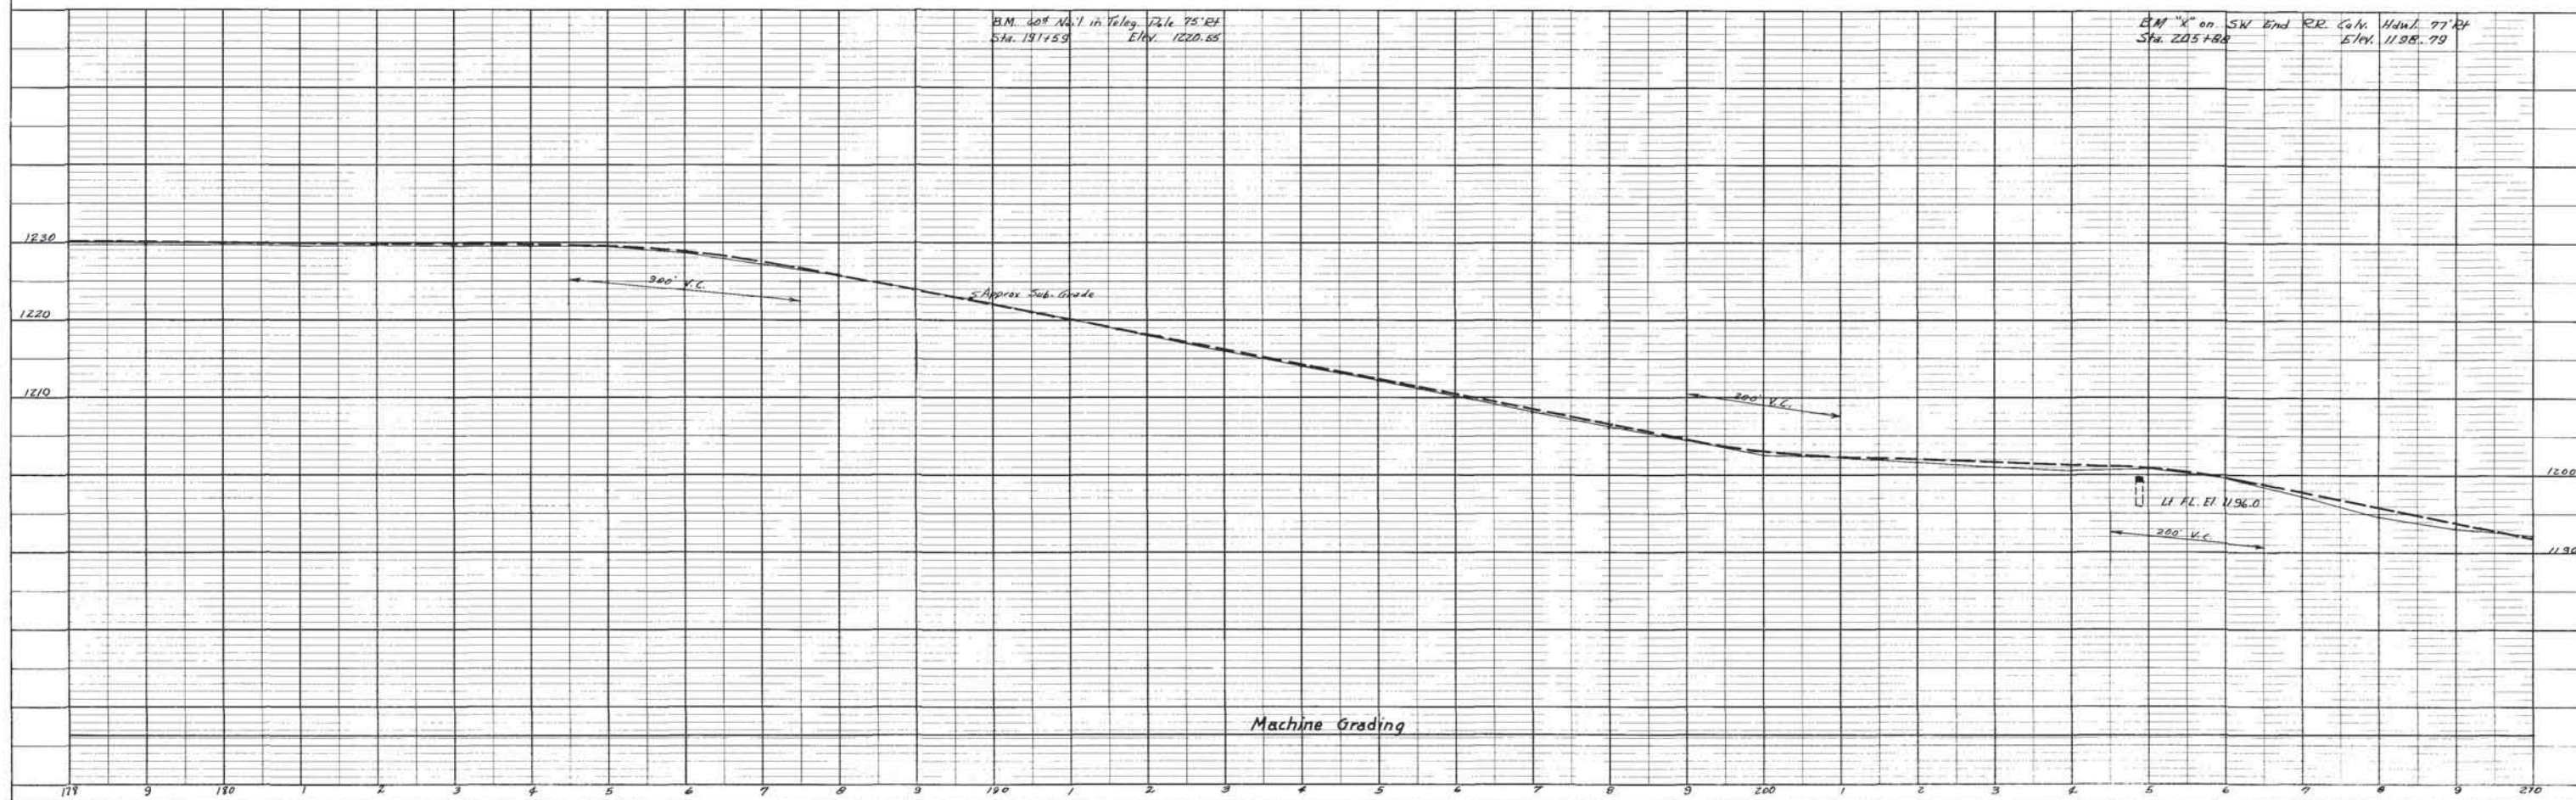


PLATE 1-PLAN-PROFILE B. R. R. STANDARD
100% RAS PAPER-MADE AND PRINTED IN U. S. A.
EUGENE DIETZGEN CO.

PLAN	SURVEYED _____	BY _____	DATE _____
NOTE BOOK	PLOTTED _____		
NO _____	ALIGNMENT CHECKED _____		
	RT, OF WAY CHECKED _____		


PROFILE	SURVEYED _____	HV _____	DATE _____
NOTE BOOK _____	PLOTTED _____		
NO. _____	GRADES CHECKED _____		
	E. M.L. NOTED _____		
	STRUCTURE NOTATION CH'NO _____		

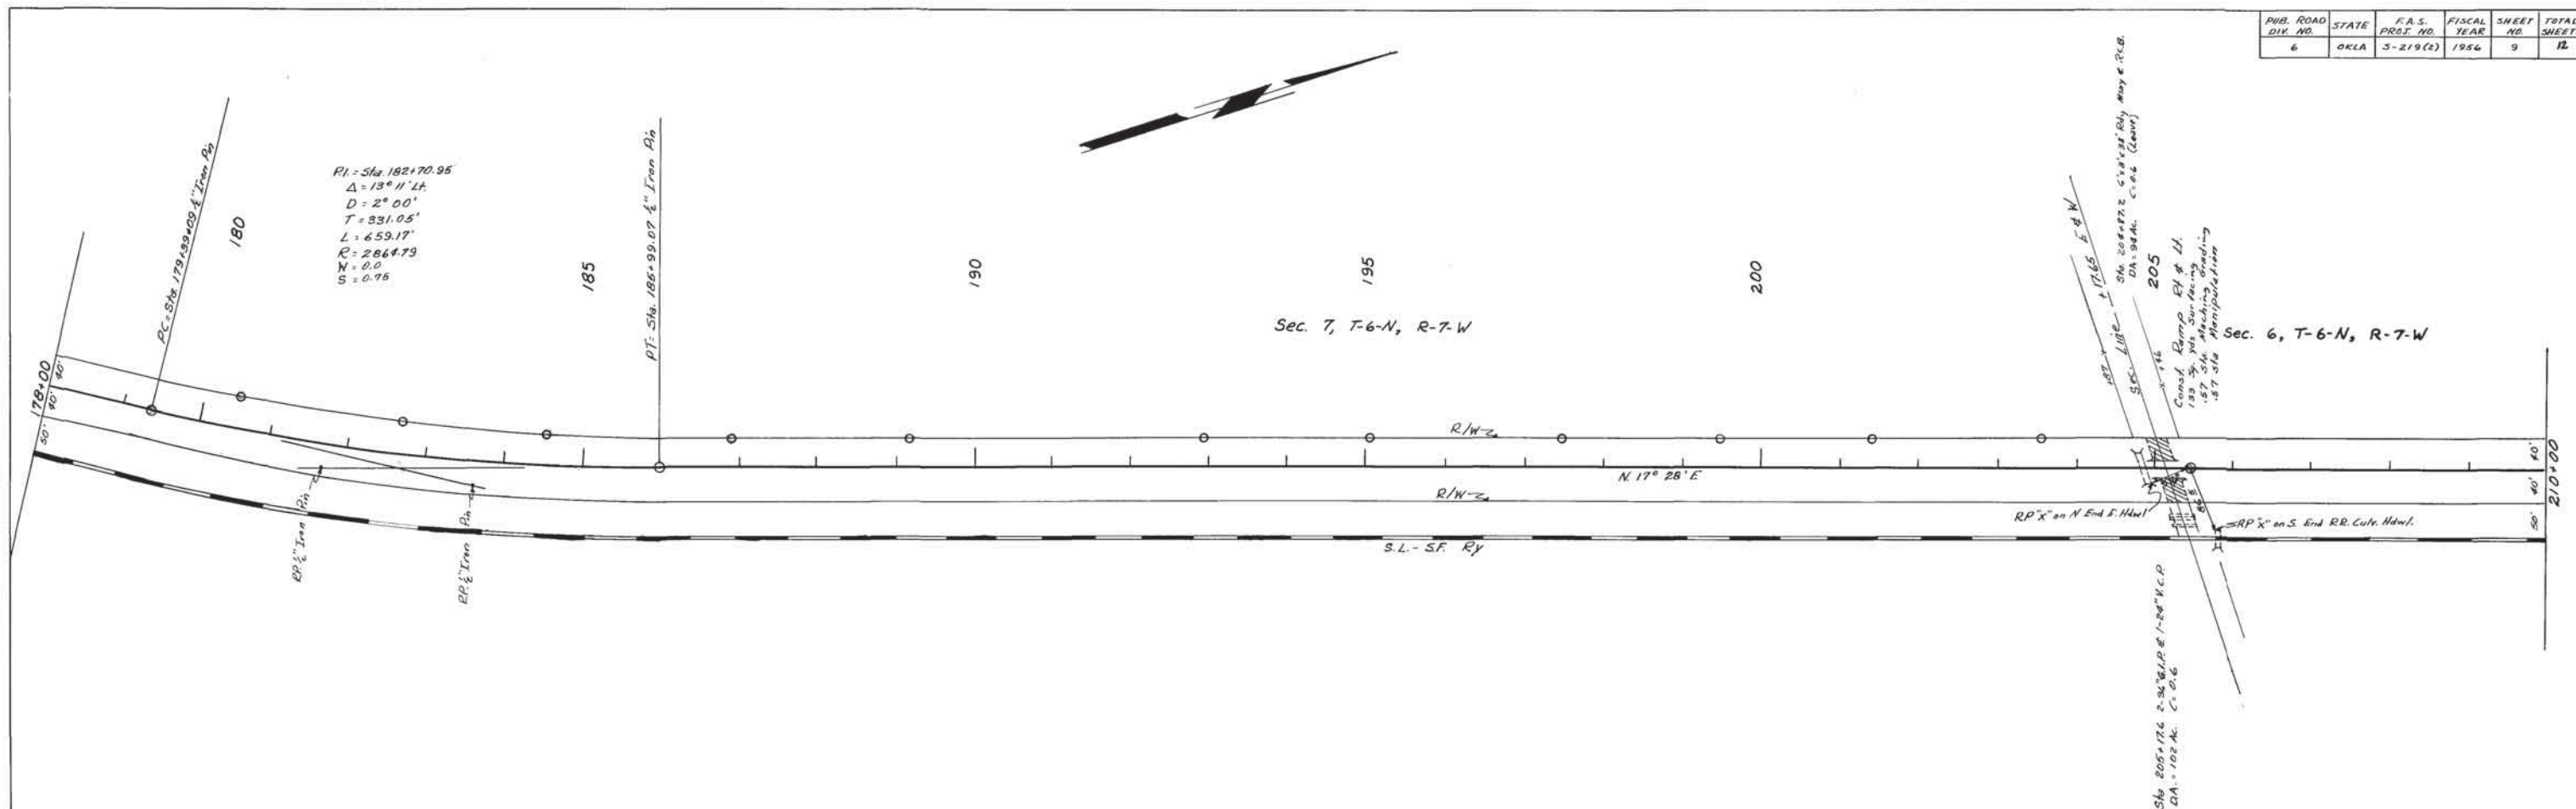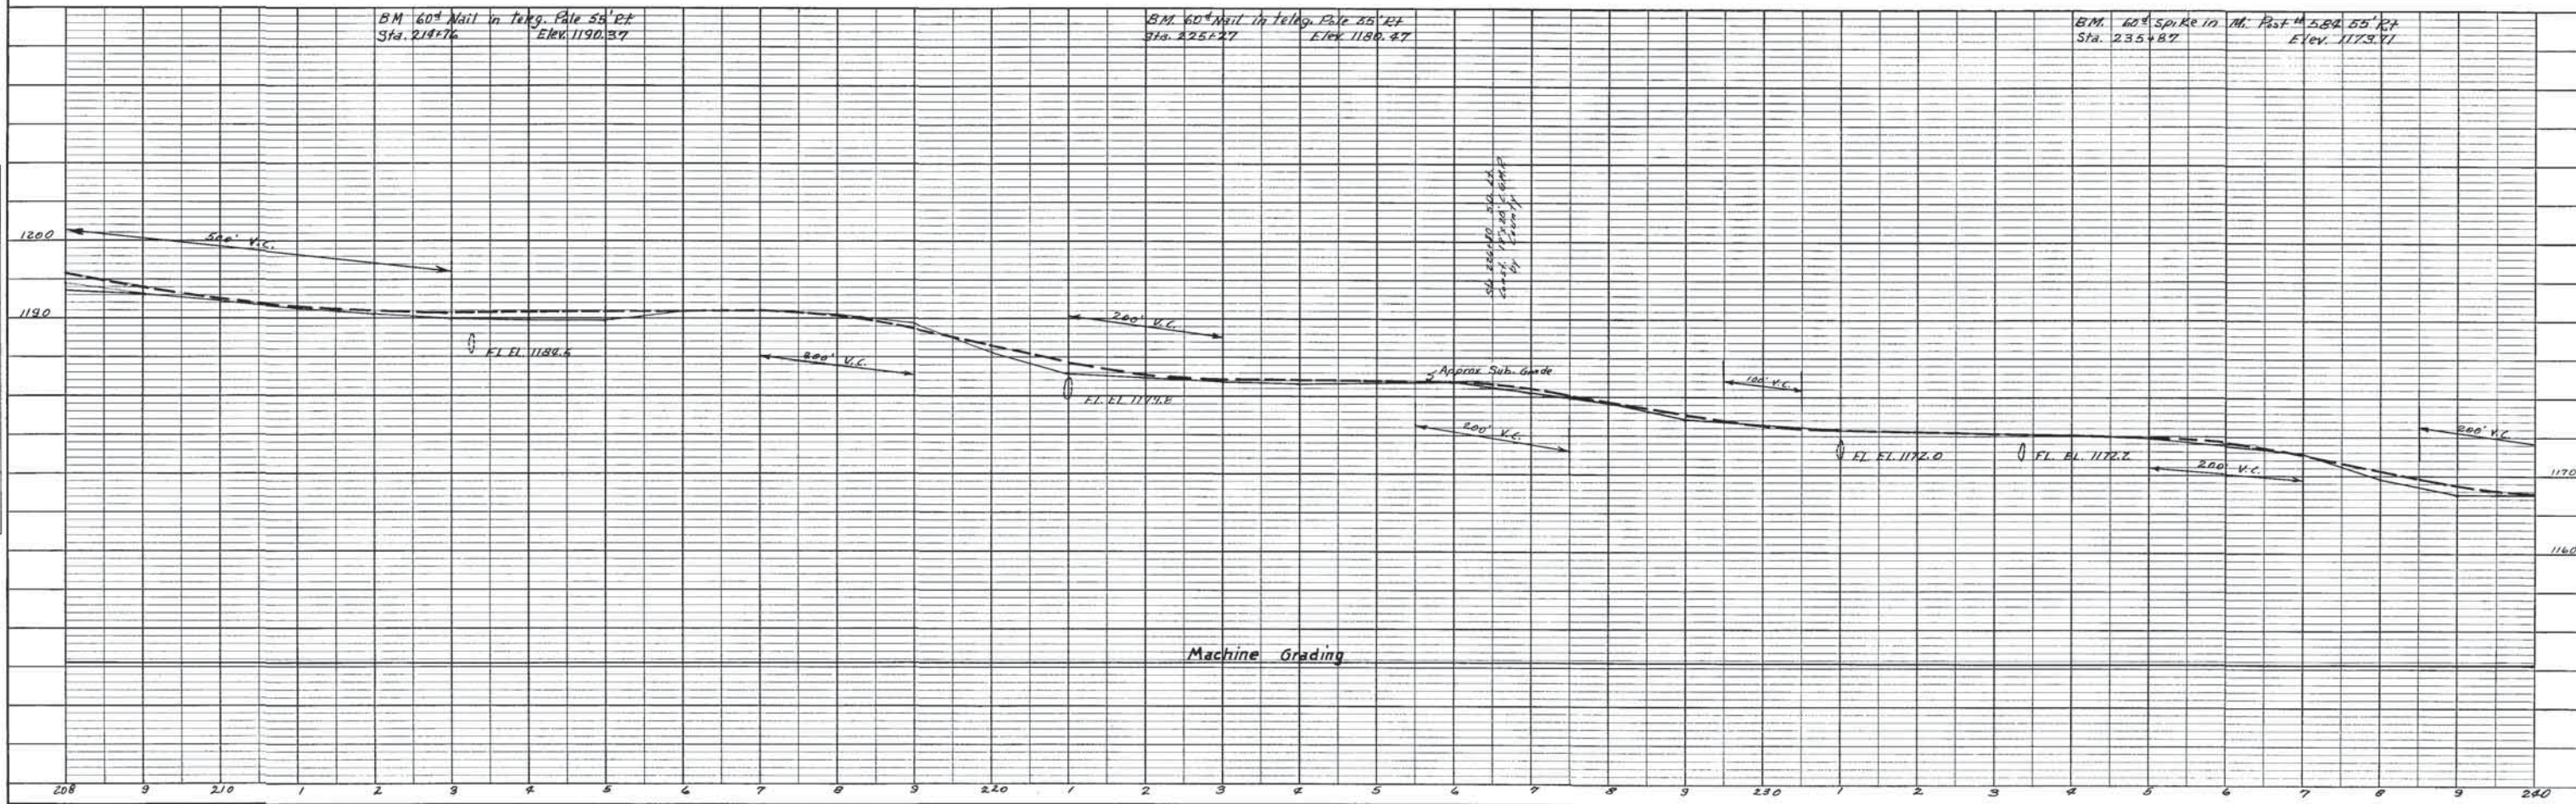

Federal Aid Secondary Project No. 5-219(2) Street No. 10

PUB. ROAD DIV. NO.	STATE	F.A.S. PROJ. NO.	FISCAL YEAR	SHEET NO.	TOTAL SHEETS
6	OKLA	S-219(2)	1956	11	12

PLAN	SURVEYED	DATE
	PLOTTED	BY
	CHECKED	
	REVIEWED	
NOTE BOOK		
NO. OF WAY CHECKED		
NO.		

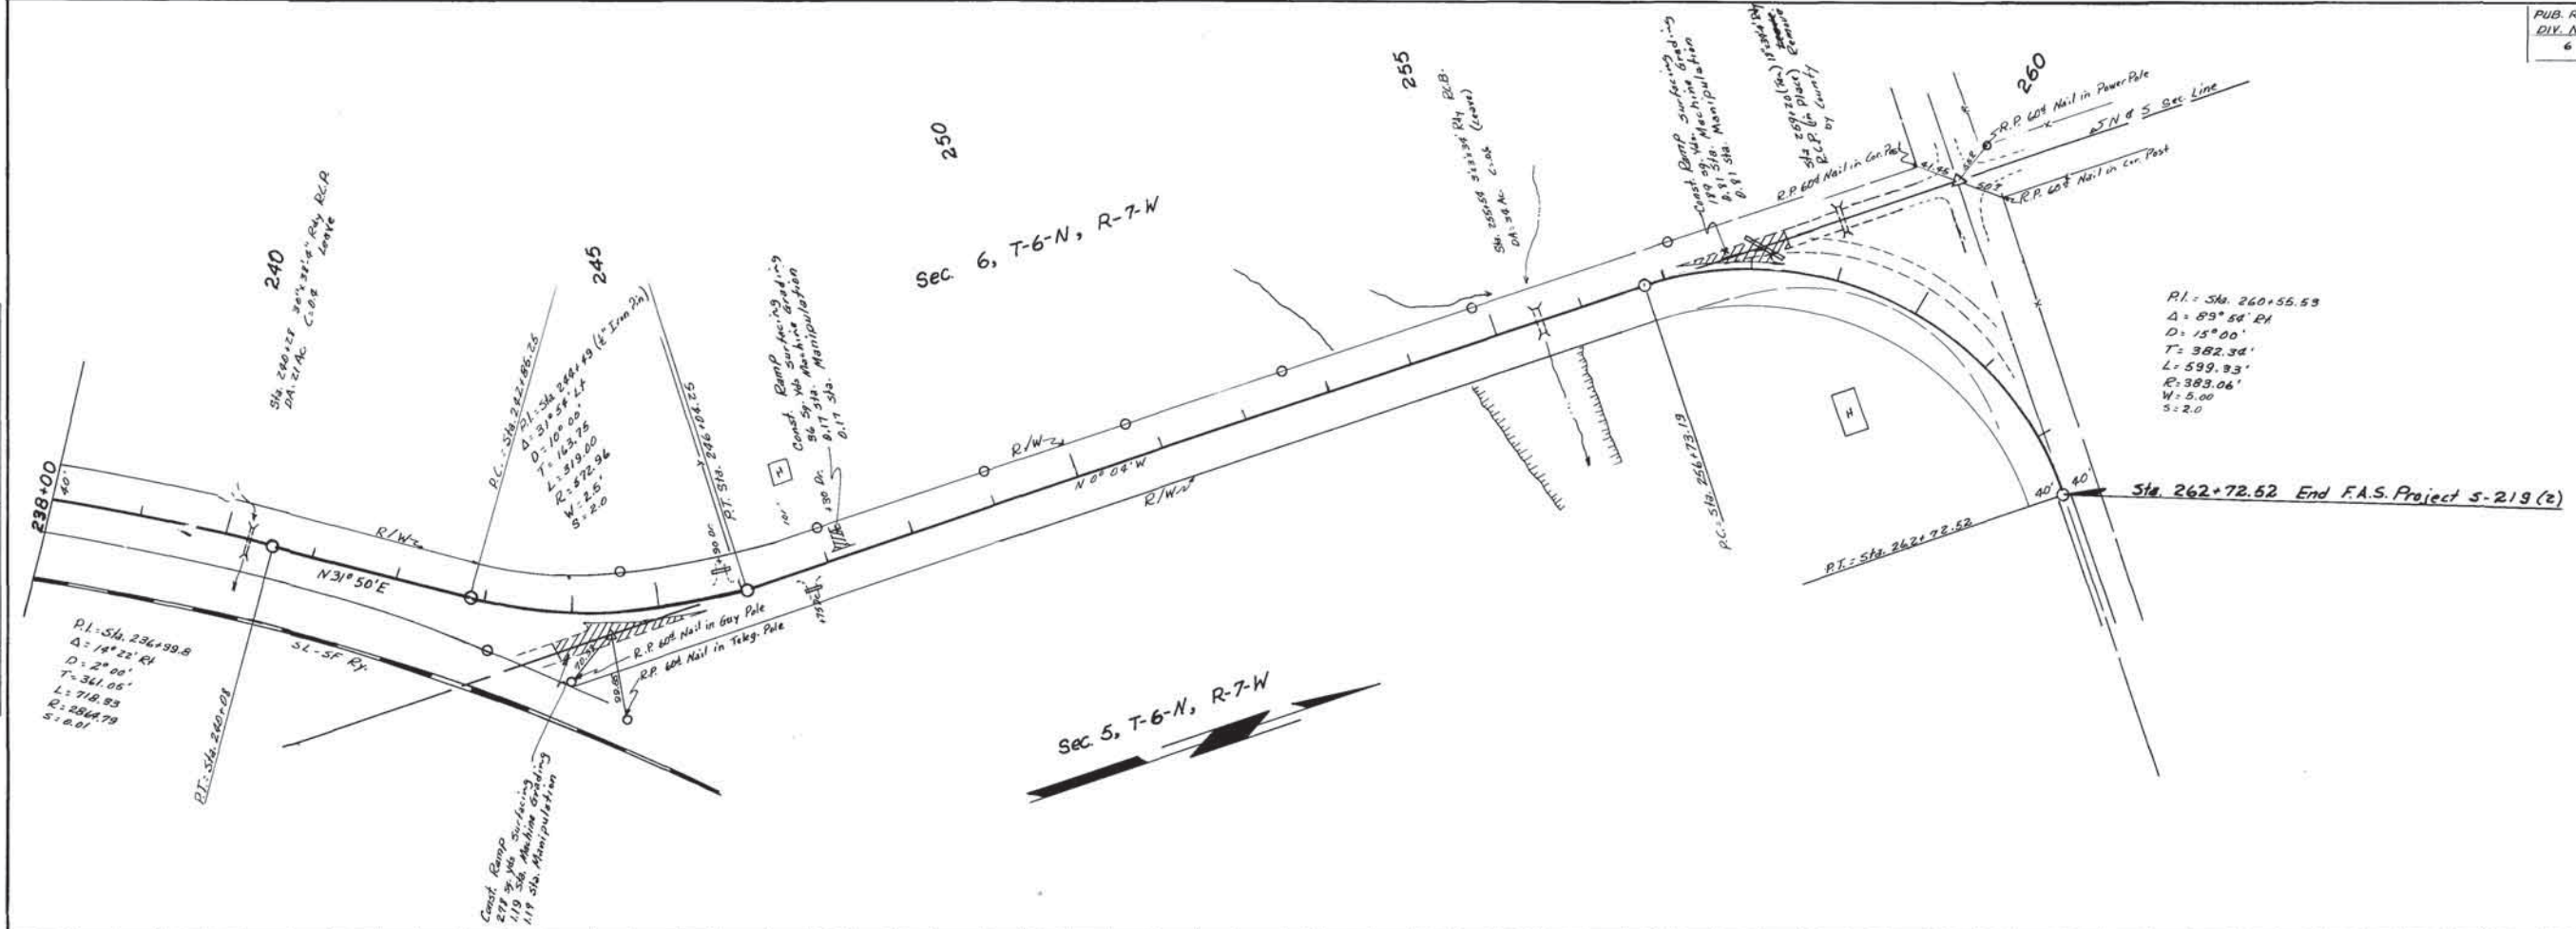

PROFILE	SURVEYED	DATE
	PLOTTED	BY
	CHECKED	
	REVIEWED	
NOTE BOOK		
STRUCTURE NOTES CHECKED		
NO.		

