

INDEX SHEETS

- 24 TYPICAL SECTION SHEETS
- 5 INTERCHANGE LAYOUT-U.S. 77
- 610 PLAN & PROFILE SHEETS
- 11 INTERCHANGE LAYOUT-S.E. 74th ST.
- 8 PLAN & PROFILE SHEETS
- 3 SUMMARY OF PAY QUANTITIES
- 20 GEN. ELEV. PLAN & SUMMARY OF QUANT.-STR. NO. 1
- 21 DETAILS OF ABUTMENTS
- 22 DETAILS OF PIERS
- 23 DETAILS OF SUPERSTRUCTURE
- 24 DETAILS OF SUPERSTRUCTURE
- 25 DETAILS OF SLAB ELEVATIONS
- 26 DETAILS OF APPR. SLABS & SLOPE WALLS
- 27 STD. CSP-3
- 28 STD. IASD-1
- 29 STD. SGF-1
- 30 STD. HR-3
- 31 GEN. ELEV. PLAN & SUMMARY OF QUANT.-STR. NO. 2
- 32 GEN. ELEV. PLAN & SUMMARY OF QUANT.-STR. NO. 3
- 33 STD. DETAILS OF ABUTS. 36'-62.5'-36' CONC. SLAB SPANS
- 34 DETAILS OF PIERS-STR. NO. 2 & NO. 3
- 35 STD. DETAILS OF SUPERSTR. 36'-62.5'-36' CONC. SLAB SPANS
- 36 DETAILS OF SLAB ELEVATIONS-STR. NO. 2 & NO. 3
- 37 STD. DETAILS OF APPR. SLAB & SLOPE WALL FOR 36'-62.5'-36' CONC. SLAB SPANS
- 38 GEN. ELEV. PLAN, SUMMARY OF QUANT.-STR. NO. 4
- 39 GEN. ELEV. PLAN, SUMMARY OF QUANT.-STR. NO. 5
- 40 DETAILS OF PIERS-STR. NO. 4 & NO. 5
- 41 DETAILS OF SLAB ELEV.-STR. NO. 4 & NO. 5
- 42 GEN. ELEV. PLAN & SUMMARY OF QUANT.-STR. NO. 6
- 43 DETAILS OF ABUTMENTS
- 44 DETAILS OF PIERS
- 45 DETAILS OF SUPERSTRUCTURE-STR. NO. 6 & NO. 9
- 46 DETAILS OF SLAB ELEVATIONS
- 47 GEN. ELEVATION, PLAN & SUMM. OF QUANT.-STR. NO. 7
- 48 DETAILS OF ABUTMENTS
- 49 DETAILS OF PIERS-STR. NO. 7 & NO. 8
- 50 DETAILS OF SUPERSTRUCTURE-STR. NO. 7 & NO. 8
- 51 DETAILS OF SUPERSTRUCTURE-STR. NO. 7 & NO. 8
- 52 DETAILS OF APPR. SLABS STR. NO. 7 & NO. 8
- 53 STD. IB-2E-F
- 54 GEN. ELEV. PLAN & SUMM. OF QUANT. STR. NO. 8
- 55 DETAILS OF ABUTMENTS
- 56 GEN. ELEV. PLAN & SUMM. OF QUANT. STR. NO. 9
- 57 DETAILS OF ABUTMENTS
- 58 DETAILS OF PIERS
- 59 DETAILS OF SLAB ELEVATIONS
- 60 GEN. ELEV. PLAN & SUMM. OF QUANT.-STR. NO. 10
- 61 DETAILS OF ABUTMENTS
- 62 DETAILS OF PIERS-STR. NO. 10 & NO. 11
- 63 DETAILS OF SUPERSTR.-STR. NO. 10 & NO. 11
- 64 DETAILS OF SUPERSTR.-STR. NO. 10 & NO. 11
- 65 DETAILS OF SLAB ELEVATIONS
- 66 DETAILS OF APPR. SLABS
- 67 GEN. ELEV. PLAN & SUMMARY OF QUANT.-STR. NO. 11
- 68 DETAILS OF ABUTMENTS

INDEX (CONT.)

- 69 DETAILS OF SLAB ELEVATIONS
- 70 DETAILS OF APPR. SLABS-STR. NO. 11
- 71 GEN. ELEV. PLAN & SUMM. OF QUANT.-STR. NO. 12
- 72 DETAILS OF ABUTMENTS
- 73 DETAILS OF PIERS
- 74 DETAILS OF PIERS
- 75 DETAILS OF DECK REINFORCING
- 76 STRUCTURAL STEEL DETAILS
- 77 DETAILS OF APPROACH SLABS
- 78 GEN. ELEV. PLAN & SUMM. OF QUANT.-STR. NO. 13
- 79 DETAILS OF ABUTMENTS
- 80 DETAILS OF PIERS
- 81 DETAILS OF PIERS
- 82 DETAILS OF DECK REINFORCING
- 83 STRUCTURAL STEEL DETAILS
- 84 DETAILS OF APPROACH SLABS
- 85 STRUCTURAL STEEL DETAILS
- 86 STRUCTURAL STEEL DETAILS
- 87 STD. AHR-1
- 88 DETECTED

STATE OF OKLAHOMA DEPARTMENT OF HIGHWAYS

PLAN AND PROFILE OF PROPOSED STATE HIGHWAY

FEDERAL AID PROJECT NO. I-381(16) ; I-35-3(16) 119

U.S. 77

OKLAHOMA AND CLEVELAND COUNTIES

CONTROL SECTION NO. 55-15 (OKLAHOMA CO.)

CONTROL SECTION NO. 14-07 (CLEVELAND CO.)

SCALES

PLAN 1" = 50'
PROFILE HOR. 1" = 50'
PROFILE VER. 1" = 5'
CROSS SECTIONS 1" = 40'
LAYOUT MAP 1" = 1750'


CONVENTIONAL SIGNS

- PROPOSED ROAD
- RAILROADS
- RANGE & TOWNSHIP LINES
- SECTION LINES
- QUARTER SECTION LINES
- FENCES
- BASE LINE
- RIGHT OF WAY LINES
- GROUND LINES
- GRADE LINE
- TRAVELLED ROADS
- CULVERTS & BRIDGES
- TELEPHONE & TELEGRAPH
- POWER LINES
- BUILDINGS
- UNLOADING POINTS
- WELLS
- POINT OF WAY MARKERS

USE OF DATA	PERCENT
1. 10%	10.00
2. 12%	12.00
3. 14%	14.00
46. 100%	100.00


MICROFILMED
SCALE 2 inches

ROADWAY LENGTH 9614 FT
OVERPASS LENGTH 74825 FT
PROJECT LENGTH 90825 FT

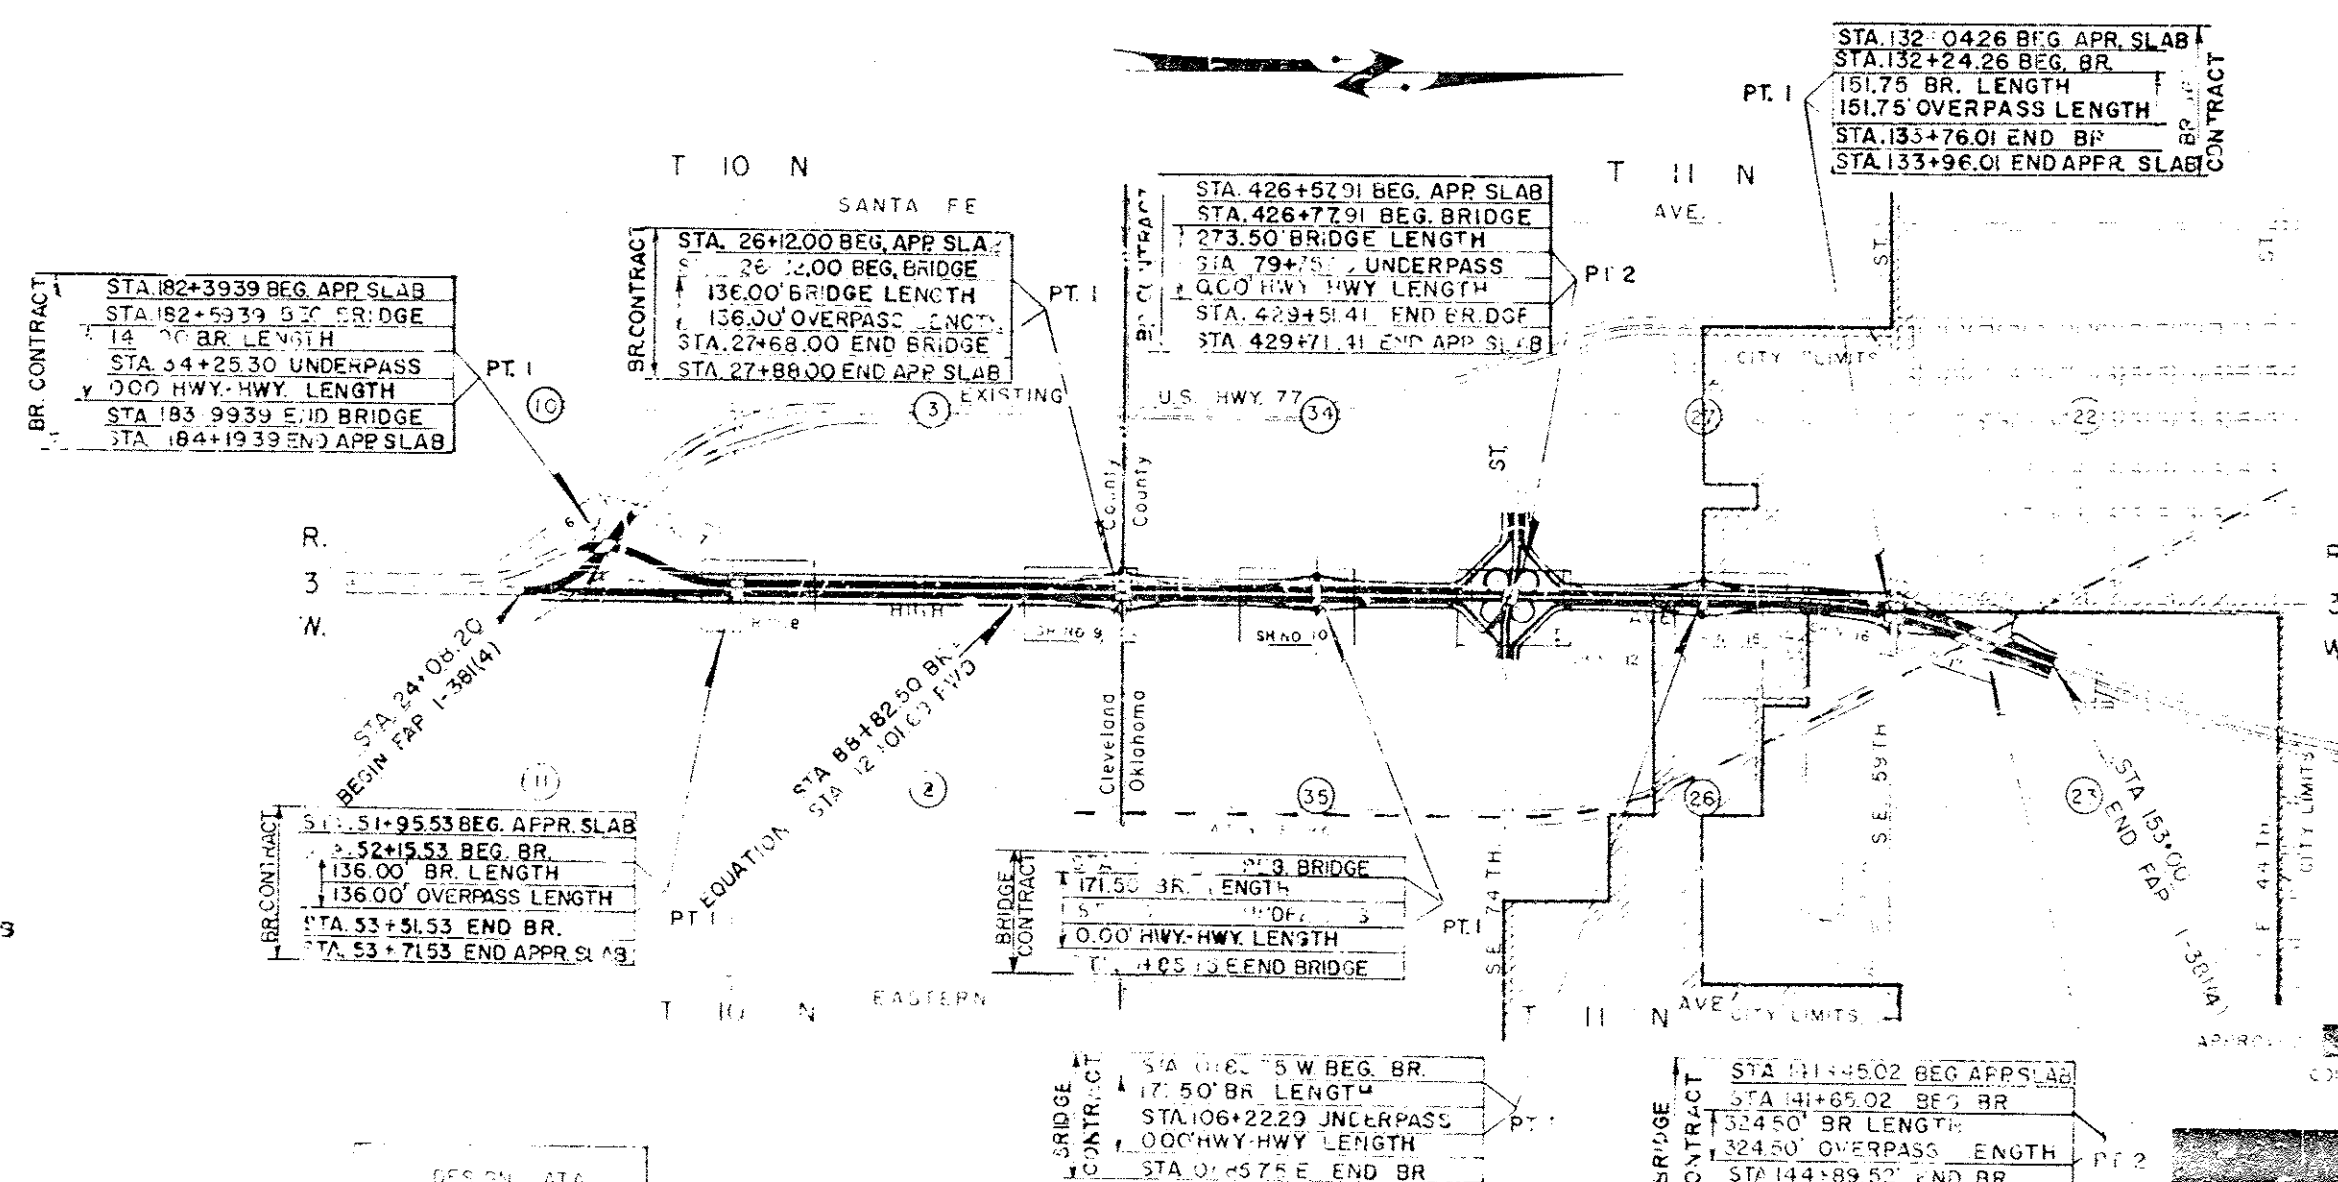

SKETCH OF PROJECT MODIFICATION


PENHAM ENGINEERING COMPANY
OKLAHOMA CITY, OKLAHOMA
BY: [Signature]
DATE: [Date]

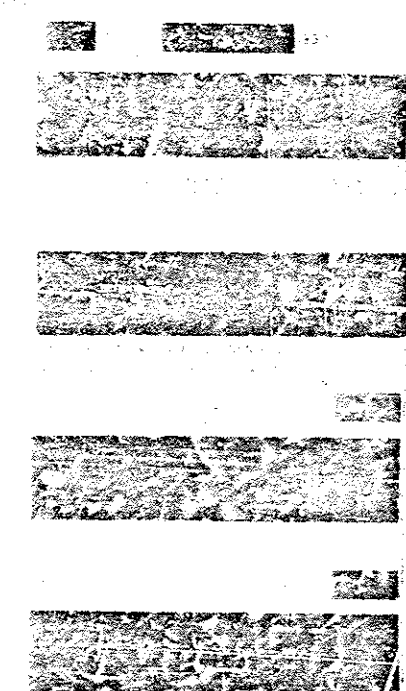


SWO 1835 (2)

TYPICAL SECTIONS


FED. ROAD DIST. NO.	STATE	PROJECT NO.	FISCAL YEAR	SHEET NO.	TOTAL SHEETS
6	OKLA	1-33-20		2	20

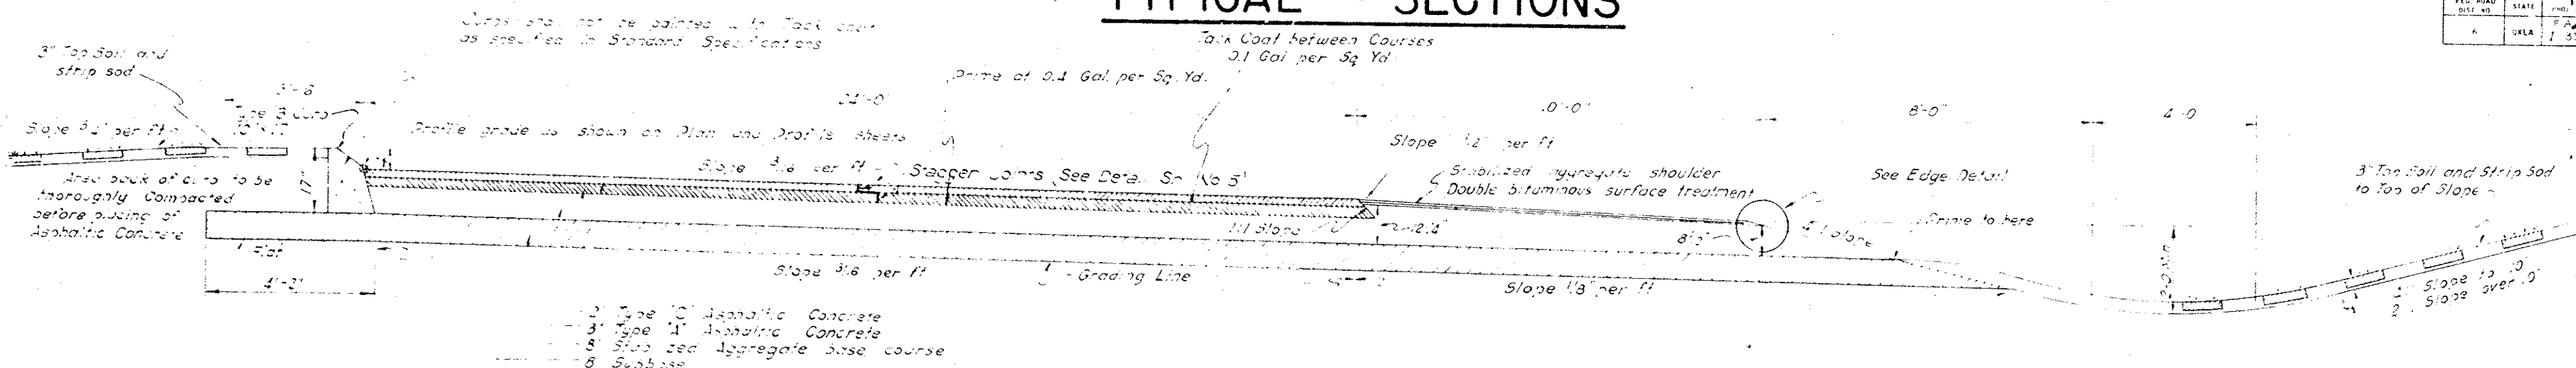


DETAIL OF 1/2 EXPRESSWAY STA. 2+06.62 TO STA. 88+82.50 BK = STA. 12+01.69 AHD STA. 12+01.69 TO STA. 153+00

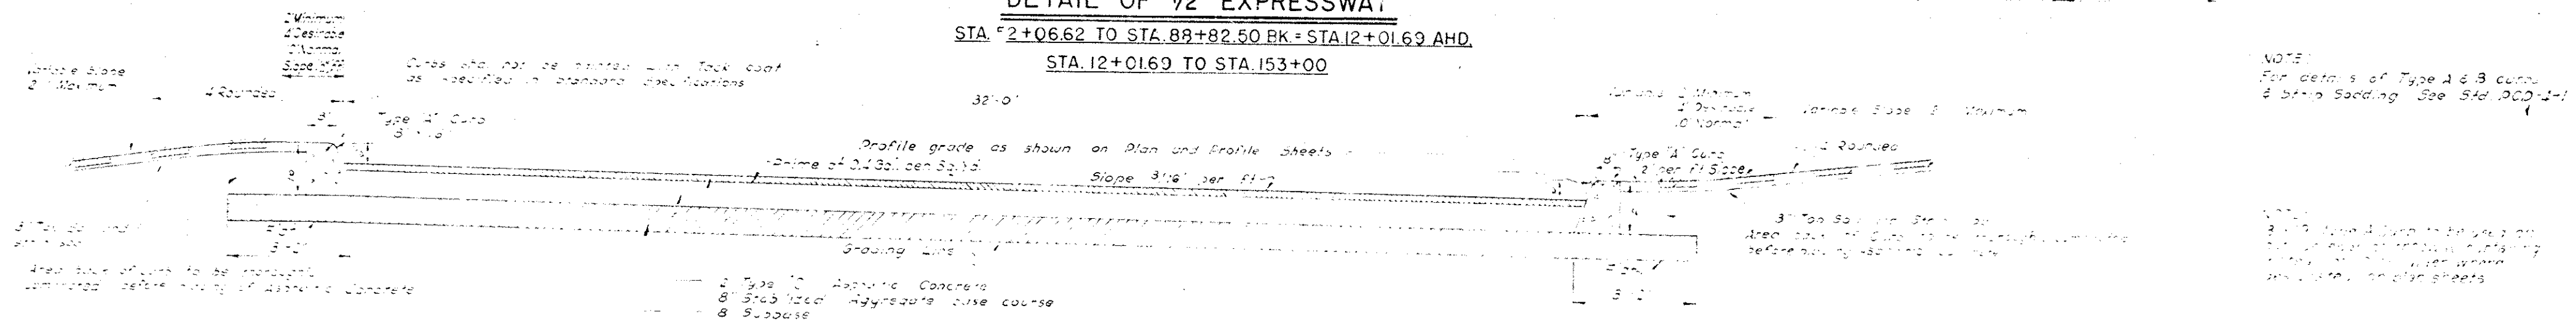

DETAIL OF SERVICE ROAD STA. 27+00 TO STA. 132+81.28 LT STA. 27+00 TO STA. 133+26.62 RT

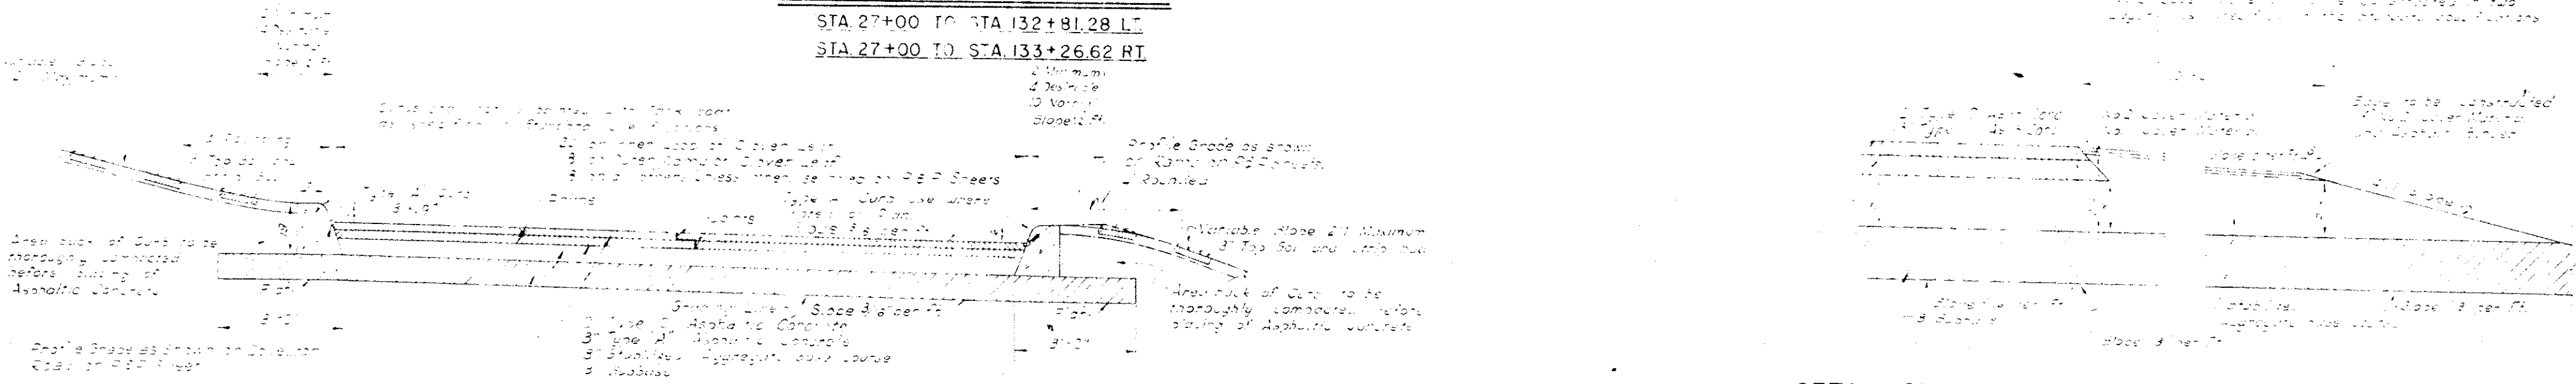


DETAIL RAMP & COLLECTOR ROAD SECTION

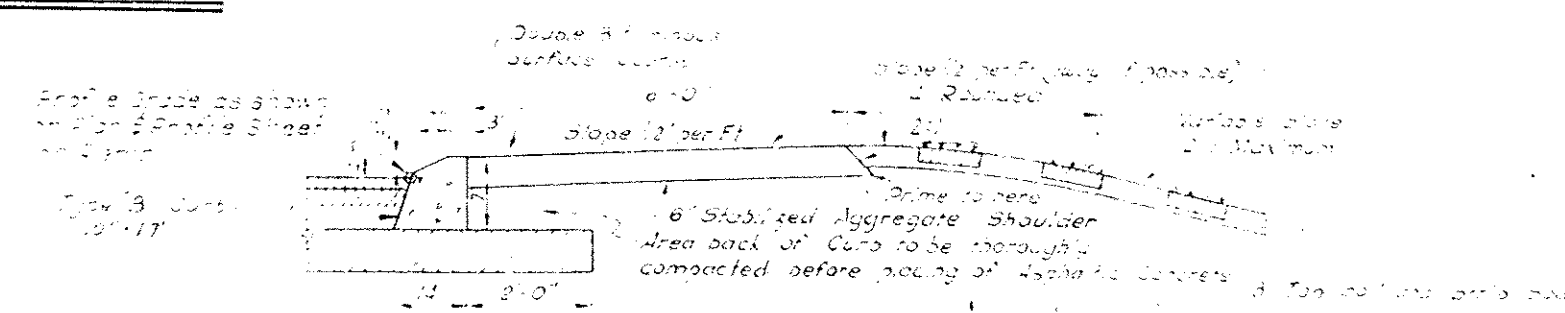


DETAIL RAMP & COLLECTOR ROAD WITH SHOULDER

ALTERNATE DETAIL COLLECTOR ROAD WITH SHOULDER

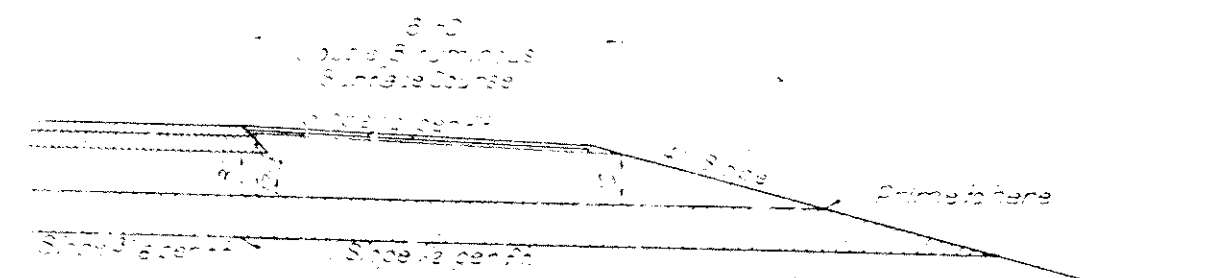


TYPICAL SECTIONS

FED. ROAD DIST. NO.	STATE	PROJECT NO.	SHEET NO.	TOTAL SHEETS
6	OKLA.	F-35	3	88

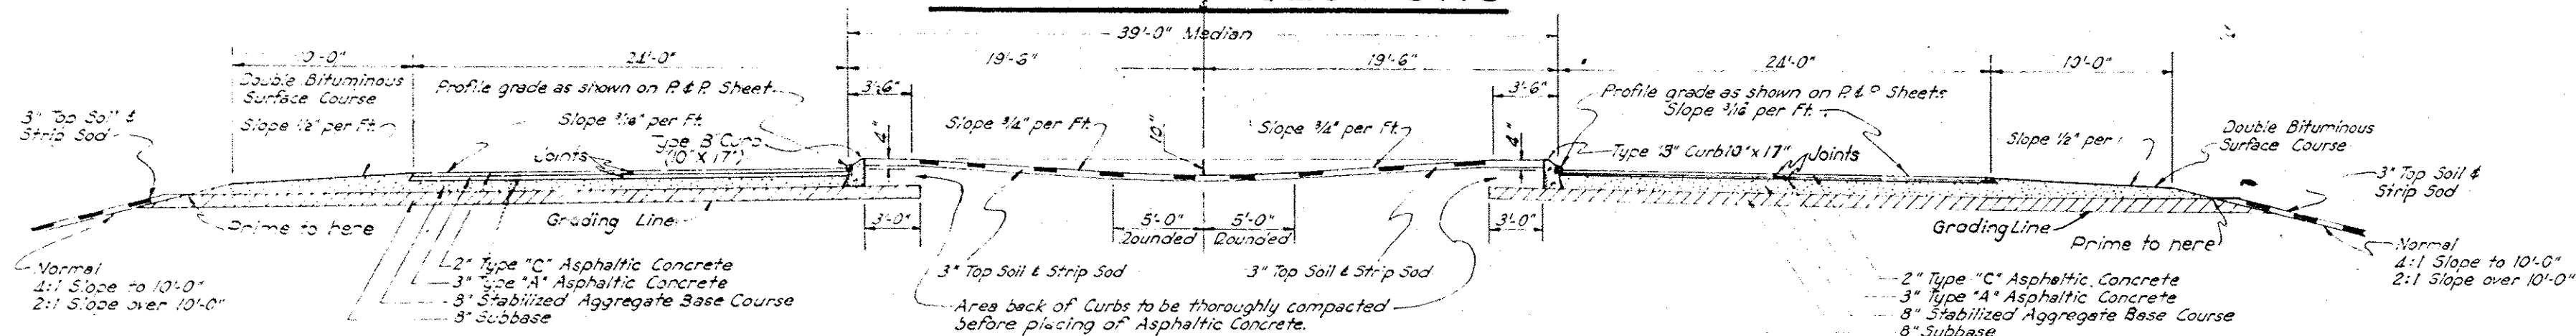


TYPICAL SURFACING SECTION OF EXPRESSWAY STA. 5+06.62 TO STA. 88+82.50BK+ STA. 12+01.69AHD. STA. 12+01.69 TO STA. 153+00

Note: 8"x19" Type 'A' Curb to be used on outside edge of freeway surfacing instead of 10' Shoulder where designated on plan sheets.

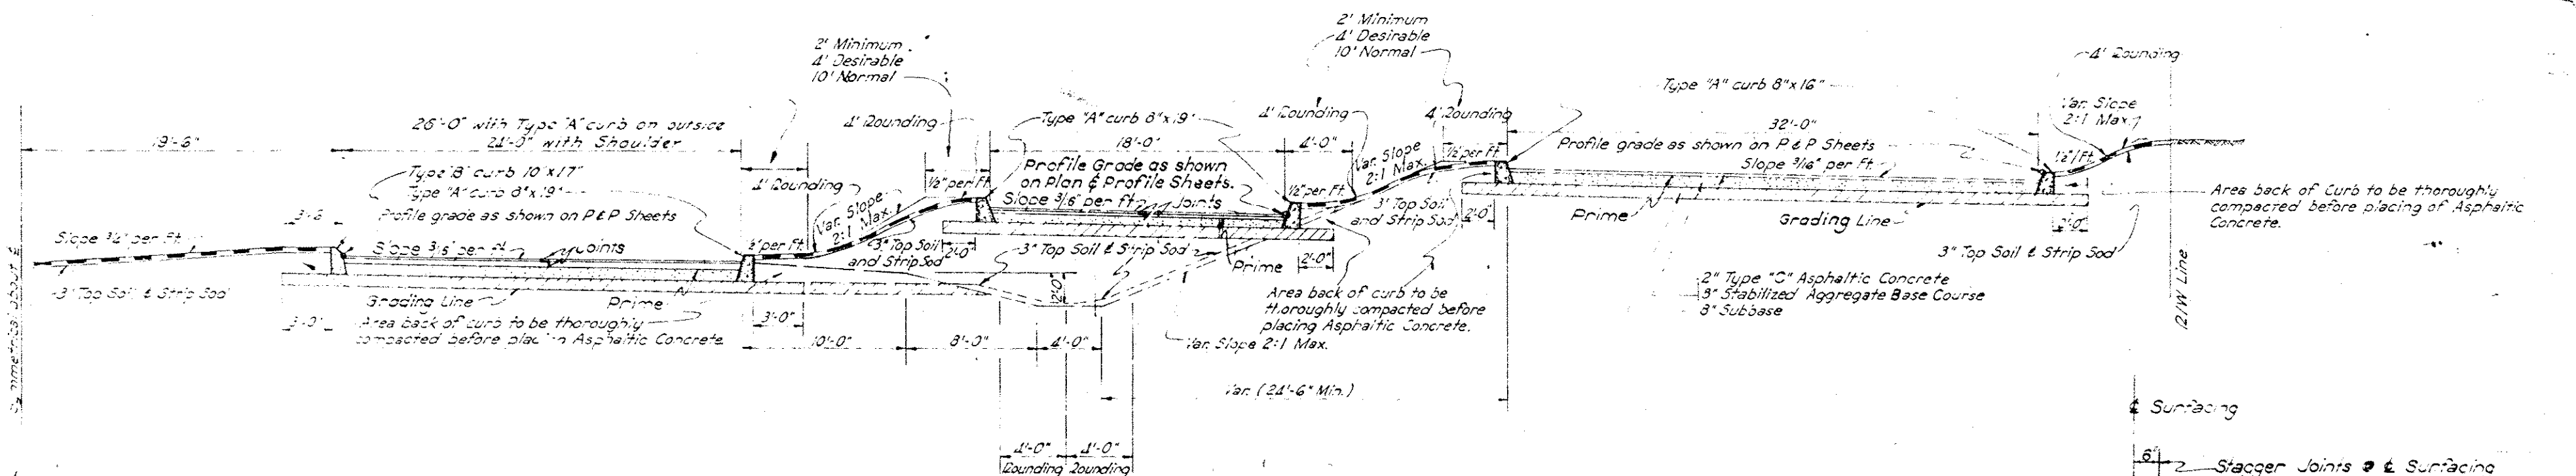


EXPRESSWAY, RAMP, & SERVICE ROAD WITH EXPRESSWAY IN CUT

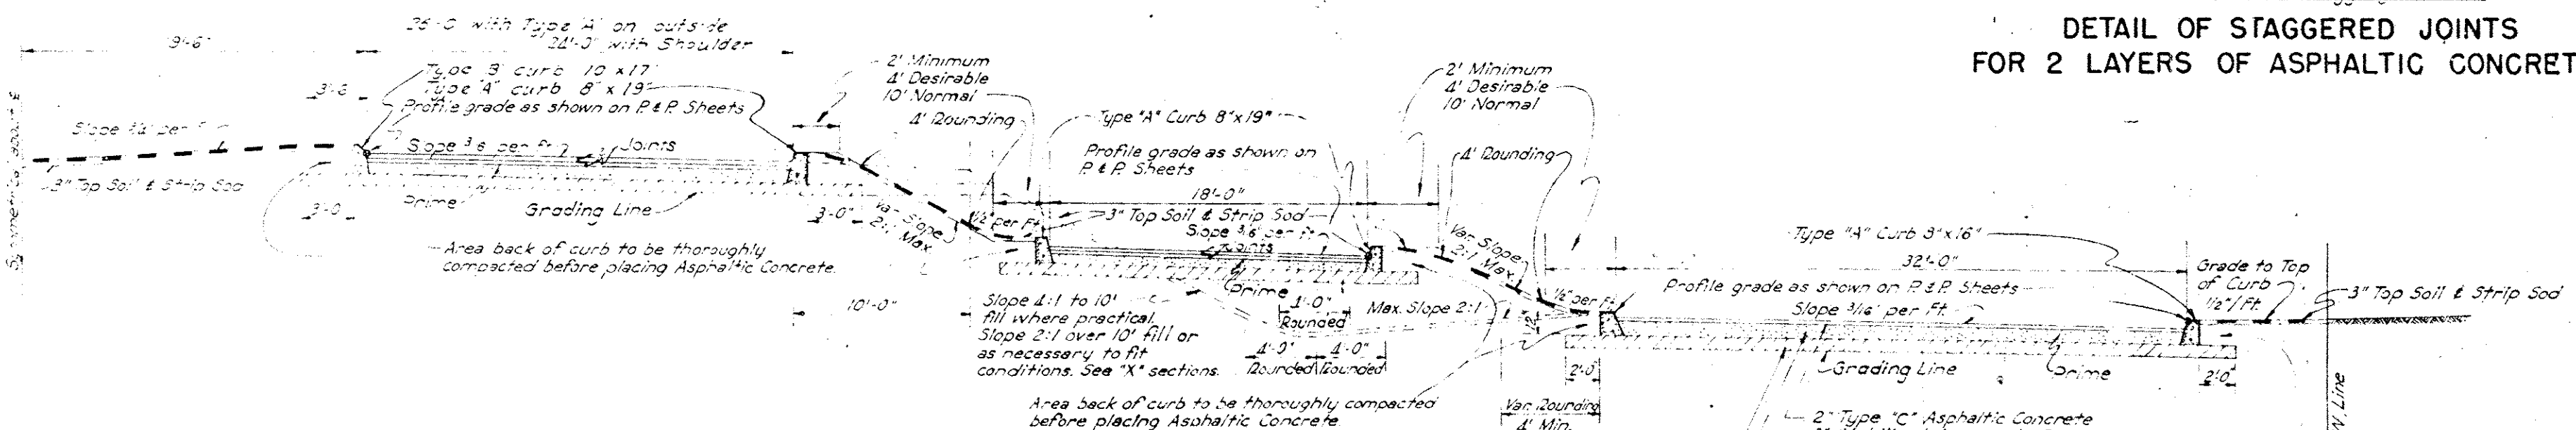

EXPRESSWAY, RAMP, & SERVICE ROAD WITH EXPRESSWAY IN FILL


DETAIL OF STAGGERED JOINTS FOR 2 LAYERS OF ASPHALTIC CONCRETE

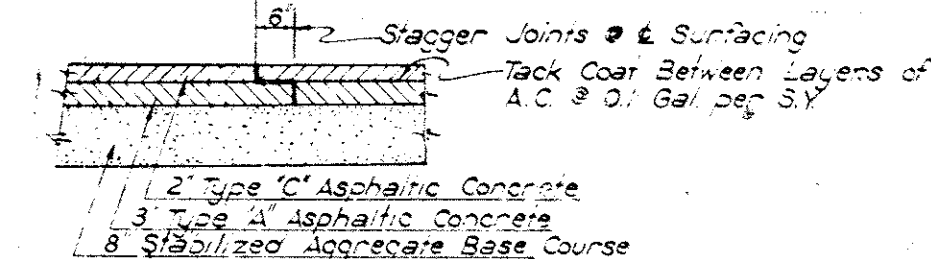

NO	NOTE BOOK	PLOTTED	GRADES CHECKED	8 IN. x 11 IN.	STRUCTURE NOTATIONS CHECKED
1					
2					
PLAN	UNREVED	LOTTED	ALIGNMENT CHECKED	RT OF WAY CHECKED	DATE
NOTE 800.					
NO					

PROFILE	NOTE BOOK	SURVEYED PLOTTED GRADES CHECKED B.M.'S NOTED STRUCTURE NOTATIONS CHECKED
NO		

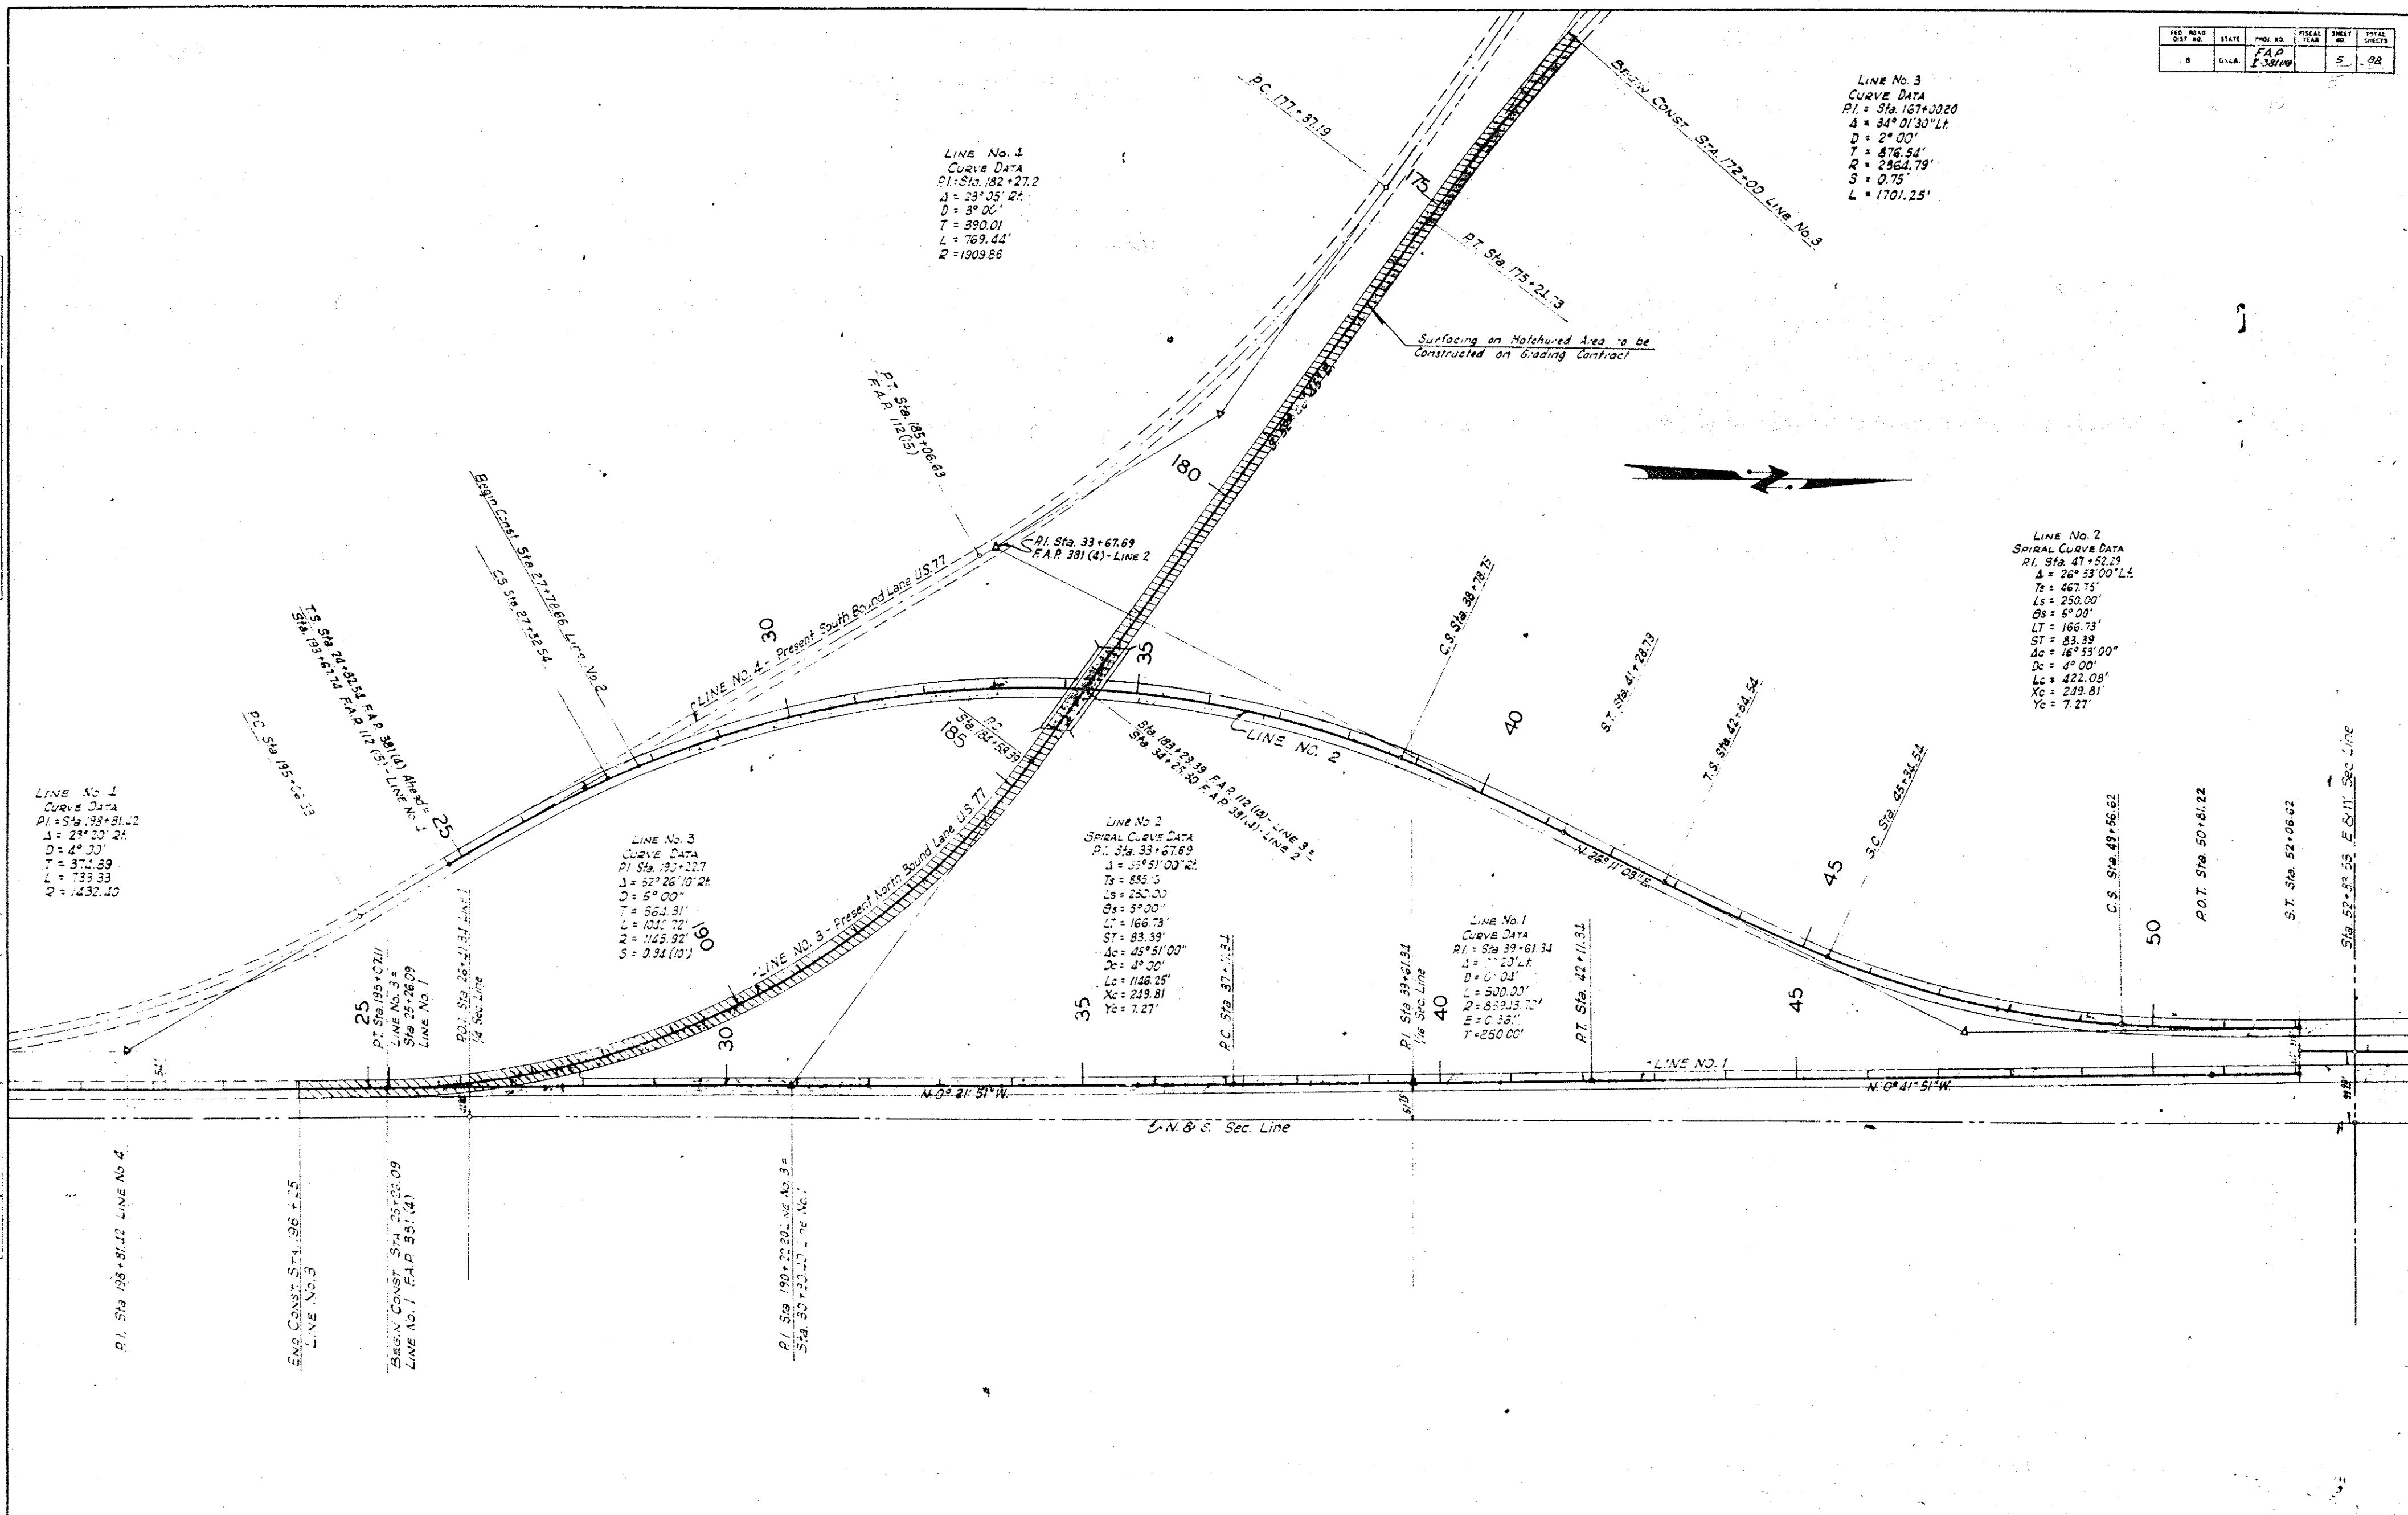


FED. ROAD DIST NO.	STATE	PROJ. NO.	FISCAL YEAR	SHEET NO.	TOTAL SHEETS
6	OKLA.	FAP 1-30116	16	7	88



ALIGNED CHECKED
BY: [Signature]
DATE: [Date]

NOTE BOOK
GRADES CHECKED
BY: [Signature]
DATE: [Date]

NO. []

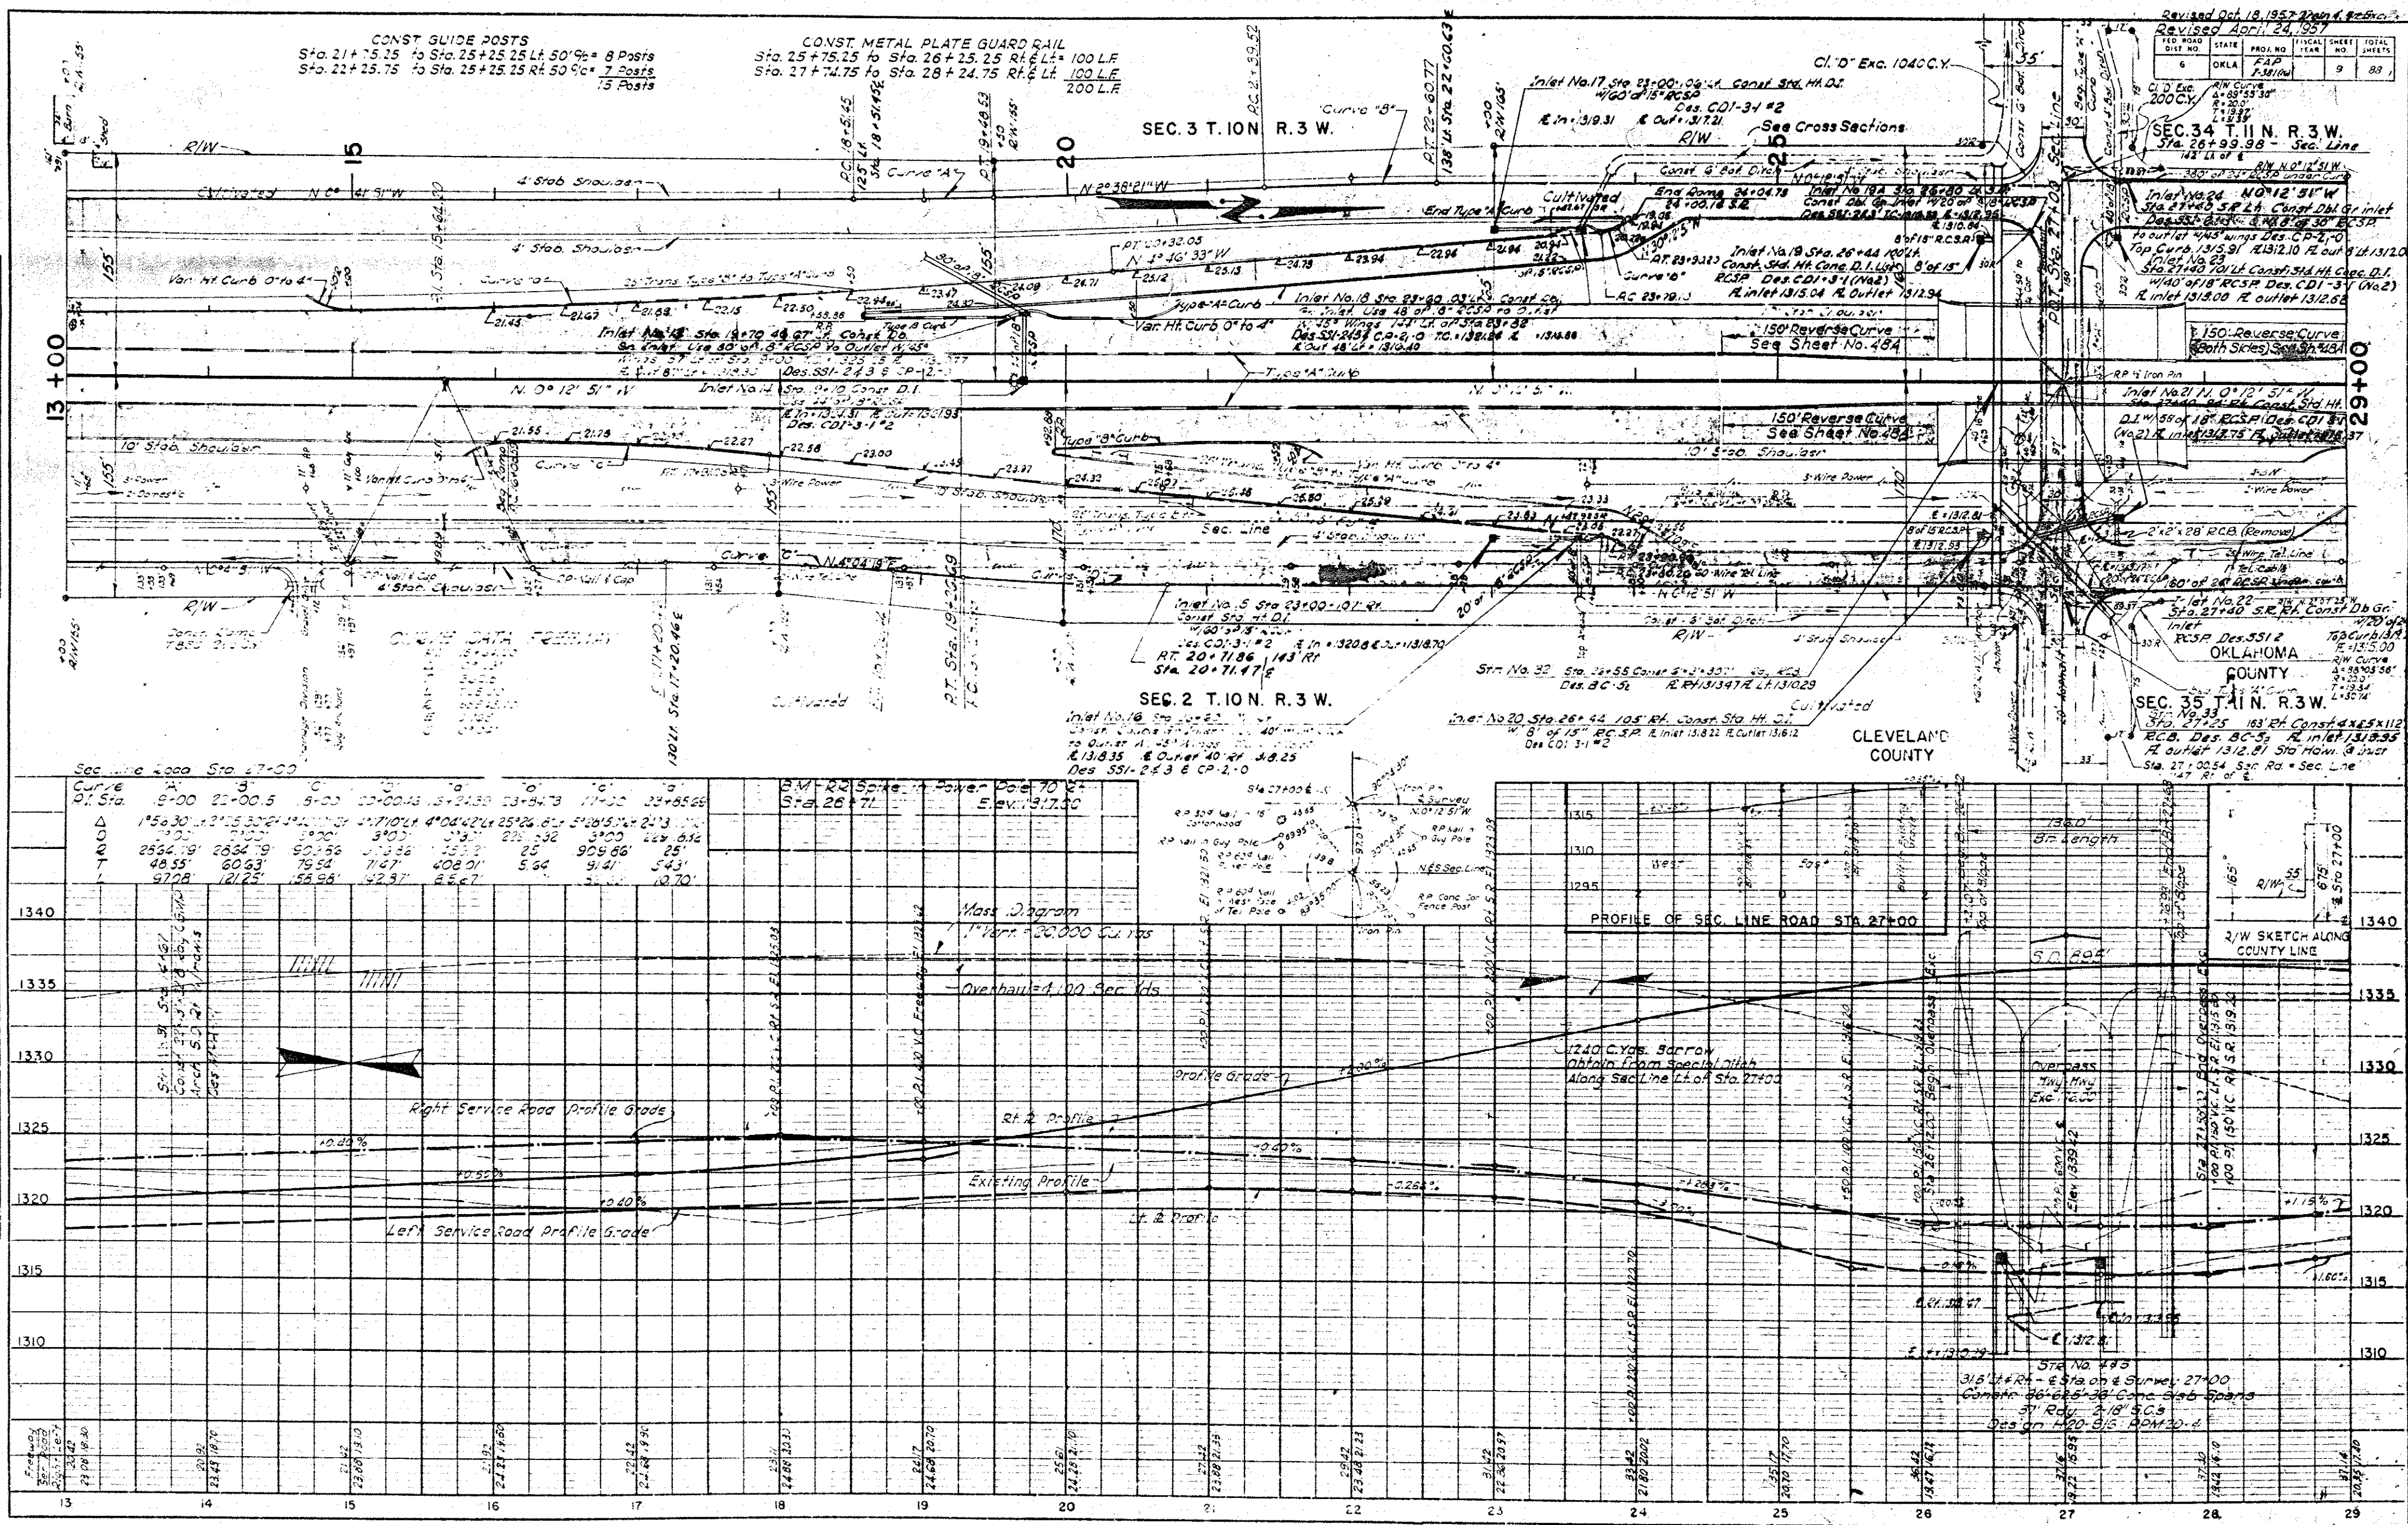


FED. ROAD DIST. NO.	STATE	PROJ. NO.	FISCAL YEAR	SHEET NO.	TOTAL SHEETS
6	OKLA.	FAP	1957	10	88

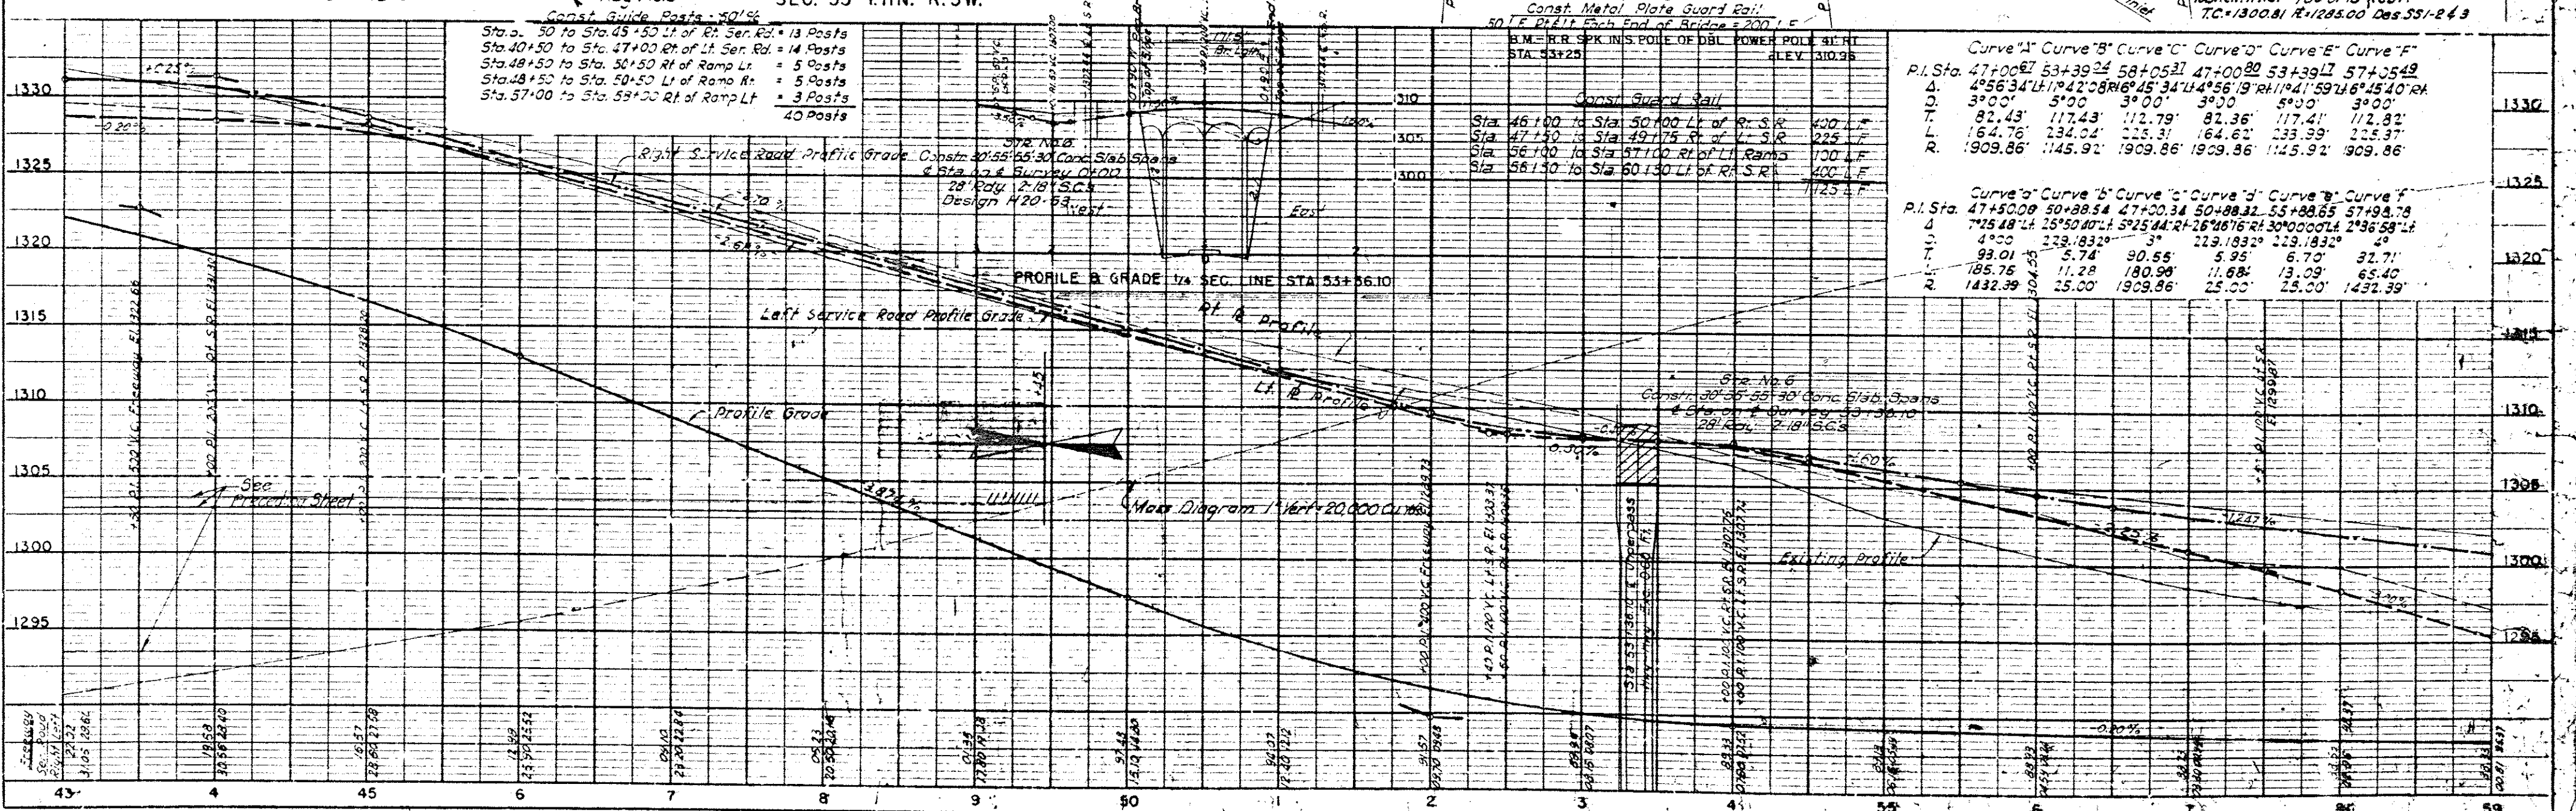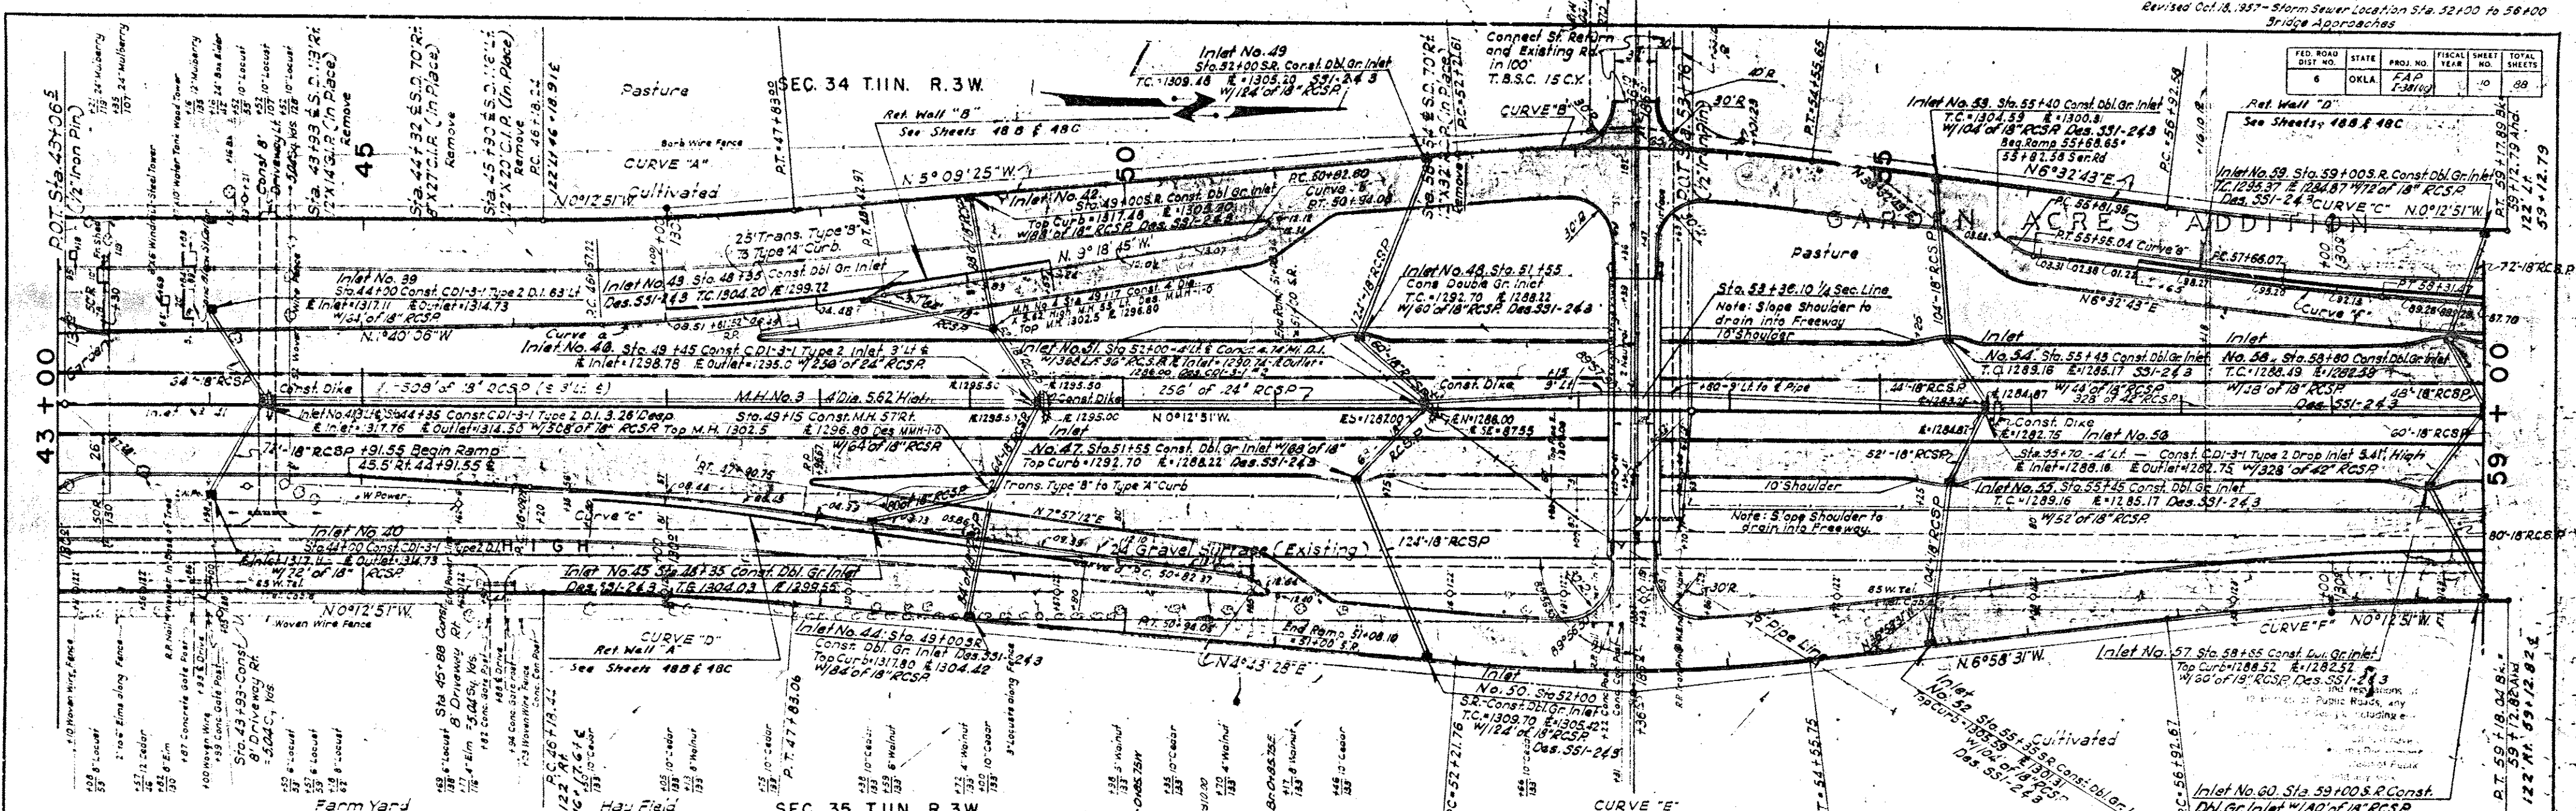

CURVE DATA													
CURVE	"a"	"b"	"c"	"d"	"e"	"f"	"g"	"h"	"i"	"j"	"k"	"l"	"m"
P.L.	84+65.00	84+50.00	88+10.88	88+00.00	88+25.00	87+00.00	88+62.21	87+73.14	70+13.45	70+51.18	72+00.00	76+00.00	88+80.00
A	10°28'15"	4°17'21"	4°17'21"	5°56'15"	10°34'25"	10°34'25"	10°26'15"	6°04'40"	5°56'15"	5°56'15"	4°38'42"	4°38'42"	6°44'24"
D	2°30'	3°00'	3°00'	3°00'	14°00'	14°00'	6°00'	5°00'	4°30'	4°30'	3°00'	3°00'	3°52'
T	203.38'	71.52'	71.52'	98.05'	57.97'	37.87'	104.67'	60.84'	68.03'	66.03'	77.46'	77.46'	68.55'
L	417.50'	142.97'	142.97'	197.82'	75.53'	75.53'	208.75'	121.56'	131.94'	131.94'	154.83'	154.83'	156.61'
R	2291.63'	1808.66'	1808.66'	1808.66'	409.26'	409.26'	1145.92'	1143.92'	1273.24'	1273.24'	1908.86'	1908.86'	1621.59'
S Max P.I./L	0.05'								0.04			0.04	0.04

CURVE DATA													
CURVE	"a"	"b"	"c"	"d"	"e"	"f"	"g"	"h"	"i"	"j"	"k"	"l"	"m"
P.L.	89+75.48	91+00.00	92+19.00	94+50.00	94+40.00	89+149.16	76+50.00	73+50.00	74+50.00	83+00.00	84+00.00	84+50.00	85.50'
A	4°49'37"	6°44'24"	4°34'26"	4°49'37"	4°34'26"	6°44'24"	4°38'42"	2°17'26"	2°17'26"	2°17'26"	2°17'26"	2°17'26"	2°17'26"
D	3°32'	3°24'	3°24'	3°32'	3°24'	3°24'	5°00'	6°00'	3°00'	3°00'	3°00'	3°00'	3°00'
T	58.38'	98.23'	67.30'	95.38'	67.30'	67.48'	38.73'	38.18'	38.18'	38.18'	38.18'	38.18'	38.18'
L	138.81'	198.24'	134.53'	190.54'	134.53'	134.60'	77.34'	76.35'	76.35'	76.35'	76.35'	76.35'	76.35'
R	1621.59'	1885.17'	1885.17'	2261.71'	1885.17'	1145.92'	954.93'	1909.86'	1909.86'	1909.86'	1909.86'	1909.86'	1909.86'

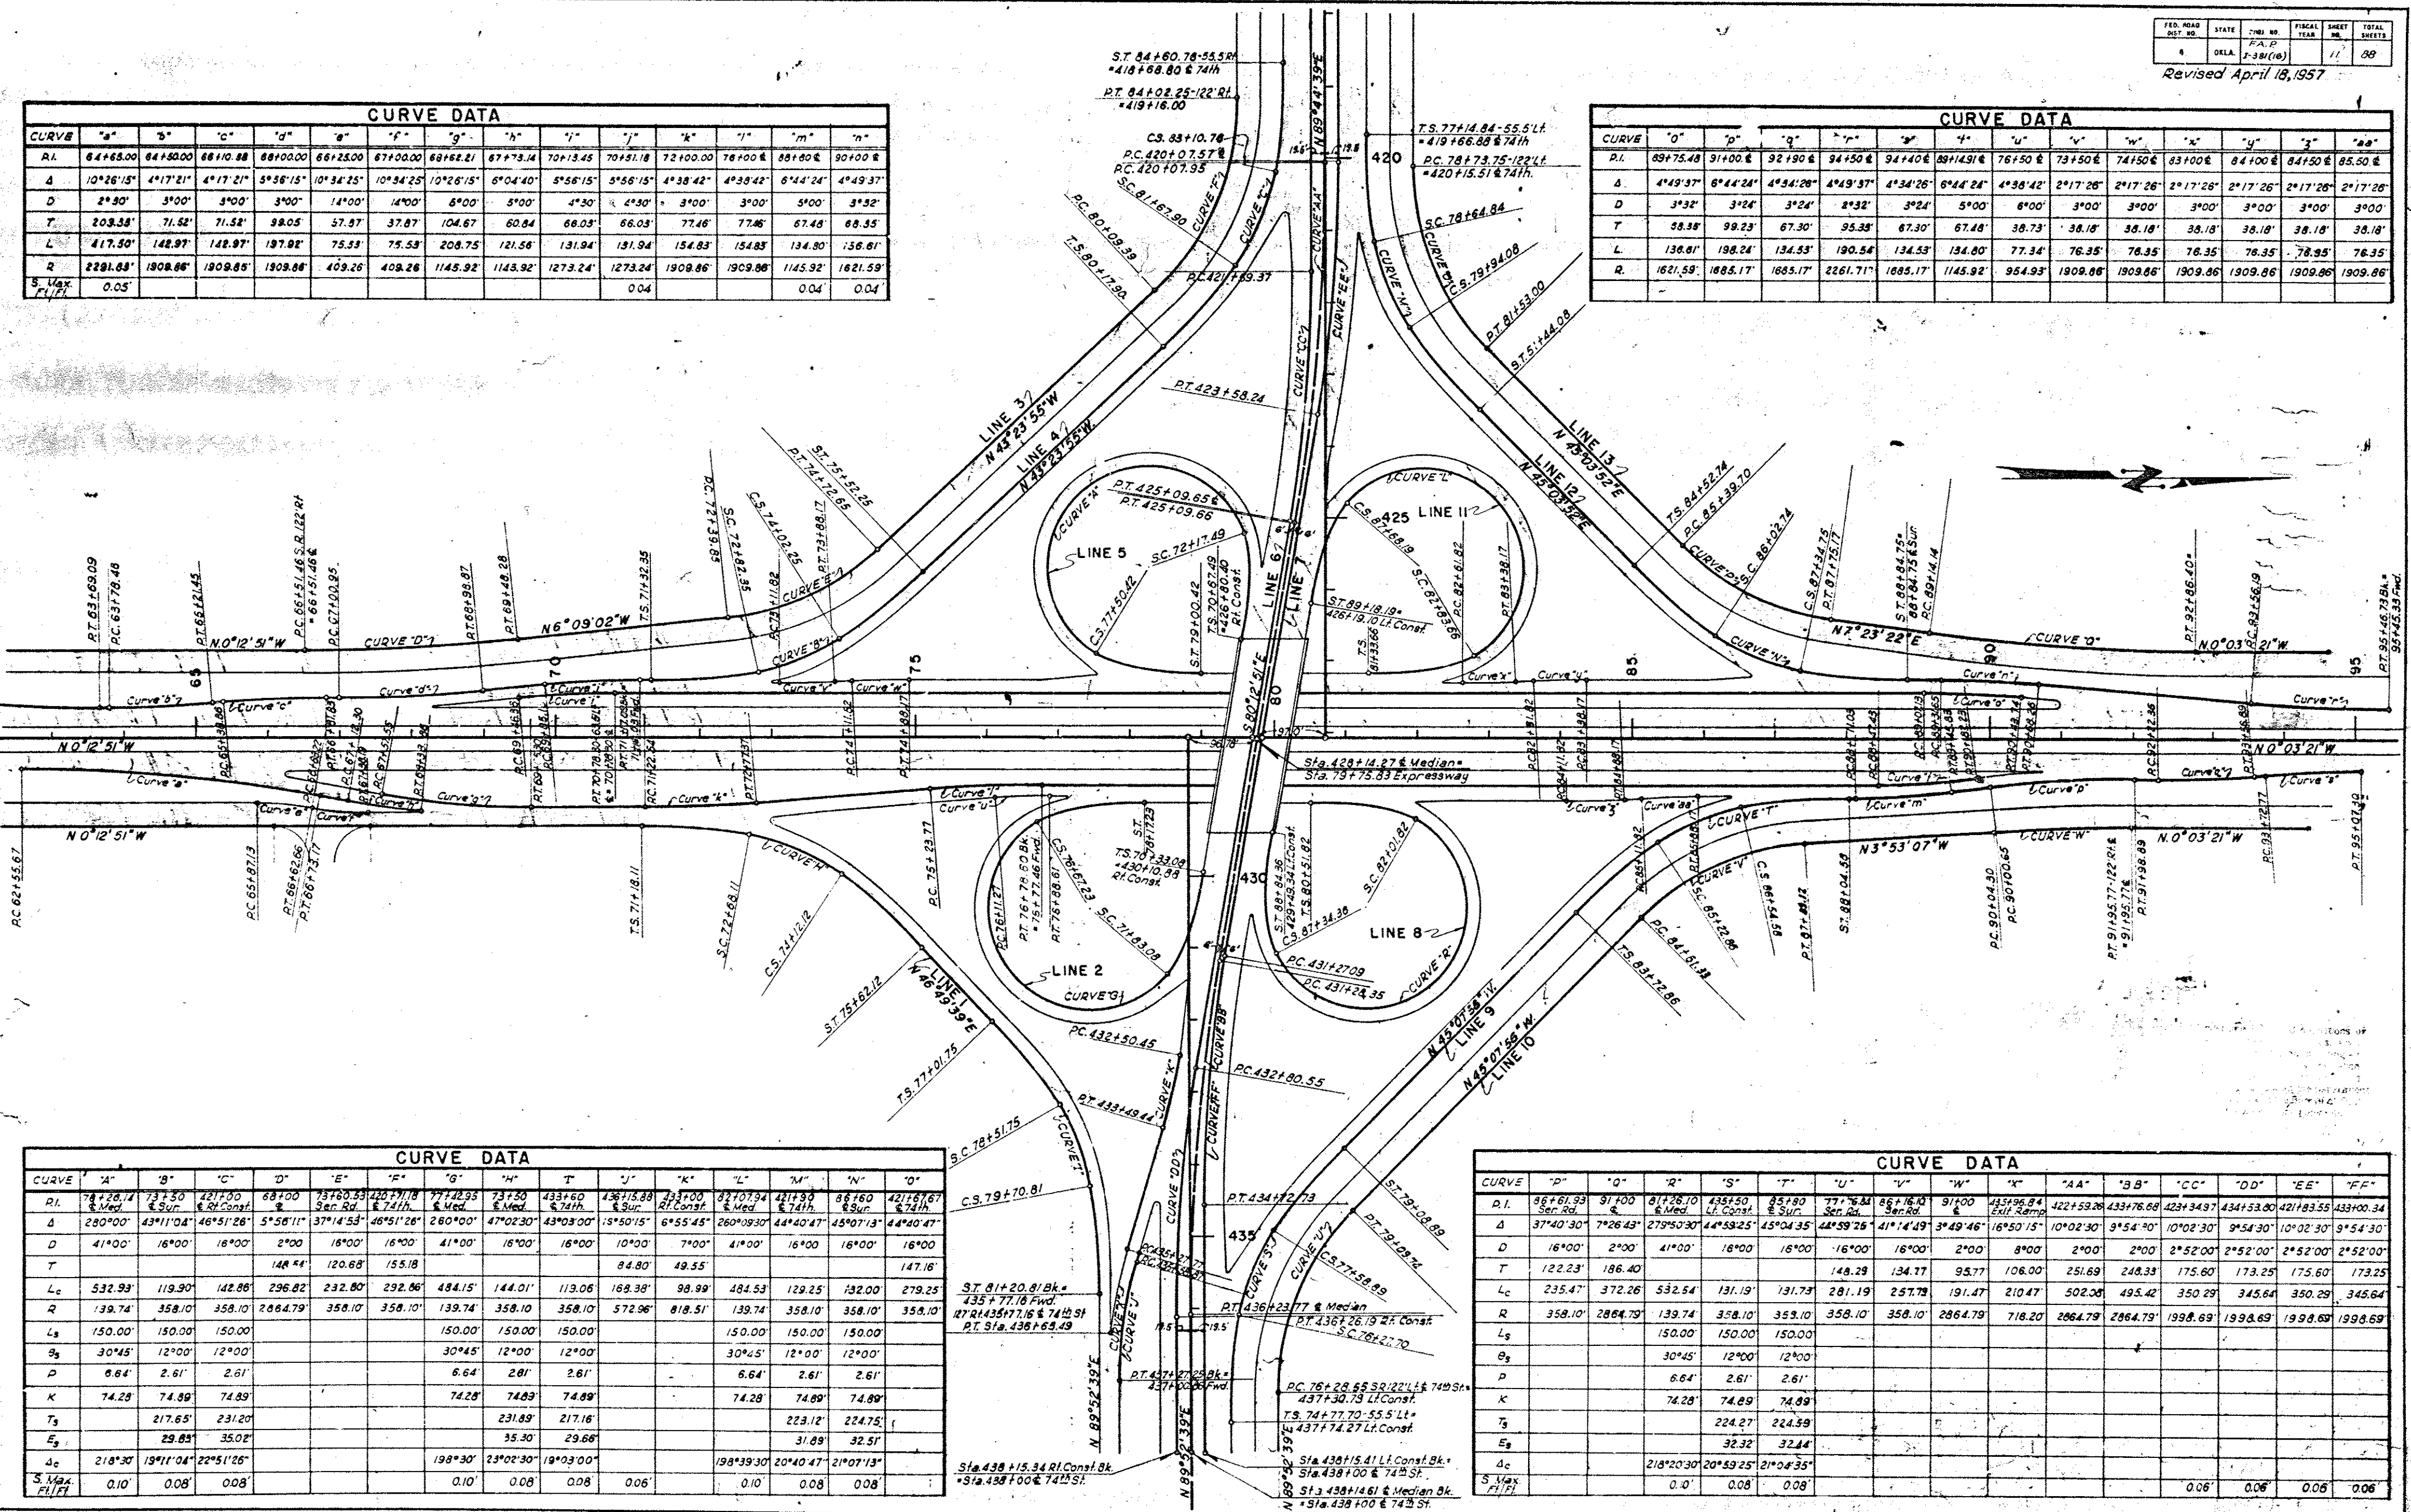

CURVE DATA													
CURVE	"A"	"B"	"C"	"D"	"E"	"F"	"G"	"H"	"I"	"J"	"K"	"L"	"M"
P.L.	78+28.74	73+50	42+50	68+00	73+60.53	42+71.18	77+42.93	73+50	43+60	43+60	82+70.94	42+50	68+00
A	280°00'	43°11'04"	46°51'28"	5°56'11"	37°14'53"	46°51'28"	260°00'	47°02'30"	43°03'00"	13°50'15"	6°55'45"	260°09'30"	44°40'47"
D	41°00'	16°00'	16°00'	2°00'	16°00'	16°00'	41°00'	16°00'	16°00'	10°00'	7°00'	41°00'	16°00'
T				148.44'	120.68'	155.18'				84.80'	49.55'		147.16'
L	532.93'	119.90'	142.86'	296.82'	232.80'	292.06'	484.15'	144.01'	119.06'	168.38'	98.99'	484.53'	129.25'
R	139.74'	358.10'	358.10'	2864.79'	358.10'	358.10'	139.74'	358.10'	358.10'	572.96'	818.51'	139.74'	358.10'
Ls	150.00'	150.00'	150.00'		150.00'	150.00'		150.00'	150.00'			150.00'	150.00'
g _s	30°45'	12°00'	12°00'				30°45'	12°00'	12°00'			30°45'	12°00'
P	6.64'	2.61'	2.61'				6.64'	2.61'	2.61'			6.64'	2.61'
K	74.28'	74.89'	74.89'				74.28'	74.89'	74.89'			74.28'	74.89'
T _s	217.65'	231.20'					231.89'	217.16'				231.89'	217.16'
E _s		29.83'	35.02'					35.30'	29.66'				31.89'
A _c	218°30'	19°11'04"	22°51'26"				198°30'	23°02'30"	19°03'00"			198°39'30"	20°40'47"
S Max P.I./L	0.10'	0.08'	0.08'				0.10'	0.08'	0.08'	0.06'		0.10'	0.08'



CURVE DATA													
CURVE	"P"	"Q"	"R"	"S"	"T"	"U"	"V"	"W"	"X"	"AA"	"BB"	"CC"	"DD"
P.L.	96+61.93	91+00	81+28.10	43+50	85+80	77+76.44	86+16.10	91+00	43+50	42+59.26	43+76.68	42+59.26	43+76.68
A	37°40'30"	7°26'43"	279°50'30"	44°53'25"	45°04'35"	44°59'26"	41°14'49"	3°49'46"	16°50'15"	10°02'30"	9°54'30"	10°02'30"	9°54'30"
D	16°00'	2°00'	41°00'	16°00'	16°00'	16°00'	16°00'	2°00'	8°00'	2°00'	2°00'	2°52'00"	2°52'00"
T	122.23'	186.40'		148.28'	134.77'	95.77'	106.00'	251.69'	248.33'	175.60'	173.25'	175.60'	173.25'
L	235.47'	372.26'	532.54'	131.19'	131.73'	281.19'	257.79'	191.47'	210.47'	502.08'	495.42'	350.29'	345.64'
R	358.10'	2884.79'	139.74'	358.10'	358.10'	358.10'	358.10'	2864.79'	716.20'	2064.79'	2864.79'	1998.69'	1998.69'
Ls			150.00'	150.00'	150.00'								
g _s			30°45'	12°00'	12°00'								
P			6.64'	2.61'	2.61'								
K			74.28'	74.89'	74.89'								
T _s					224.27'	224.59'							
E _s				32.32'	32.44'								
A _c			218°20'30"	20°53'25"	21°04'35"							0.06'	0.06'
S Max P.I./L			0.10'	0.08'	0.08'							0.06'	0.06'

DATE
BY
CHECKED
NOTES BOOK
PLANNING
DESIGN
CONSTRUCTION
REVISIONS



DATE
BY
CHECKED
NOTES BOOK
PLANNING
DESIGN
CONSTRUCTION
REVISIONS

Const. 506' approach to Interchange.
 Meet Existing Grade at Present Section
 Line Road. See Typical Section this
 Sheet.
 Estimated C.I. "D" Excav. = 1500 C.Y.
 (Included in "D" St. Sheet Estimate -
 Sheet No. 34.)
 T.B.S.C. = 260 C.Y.



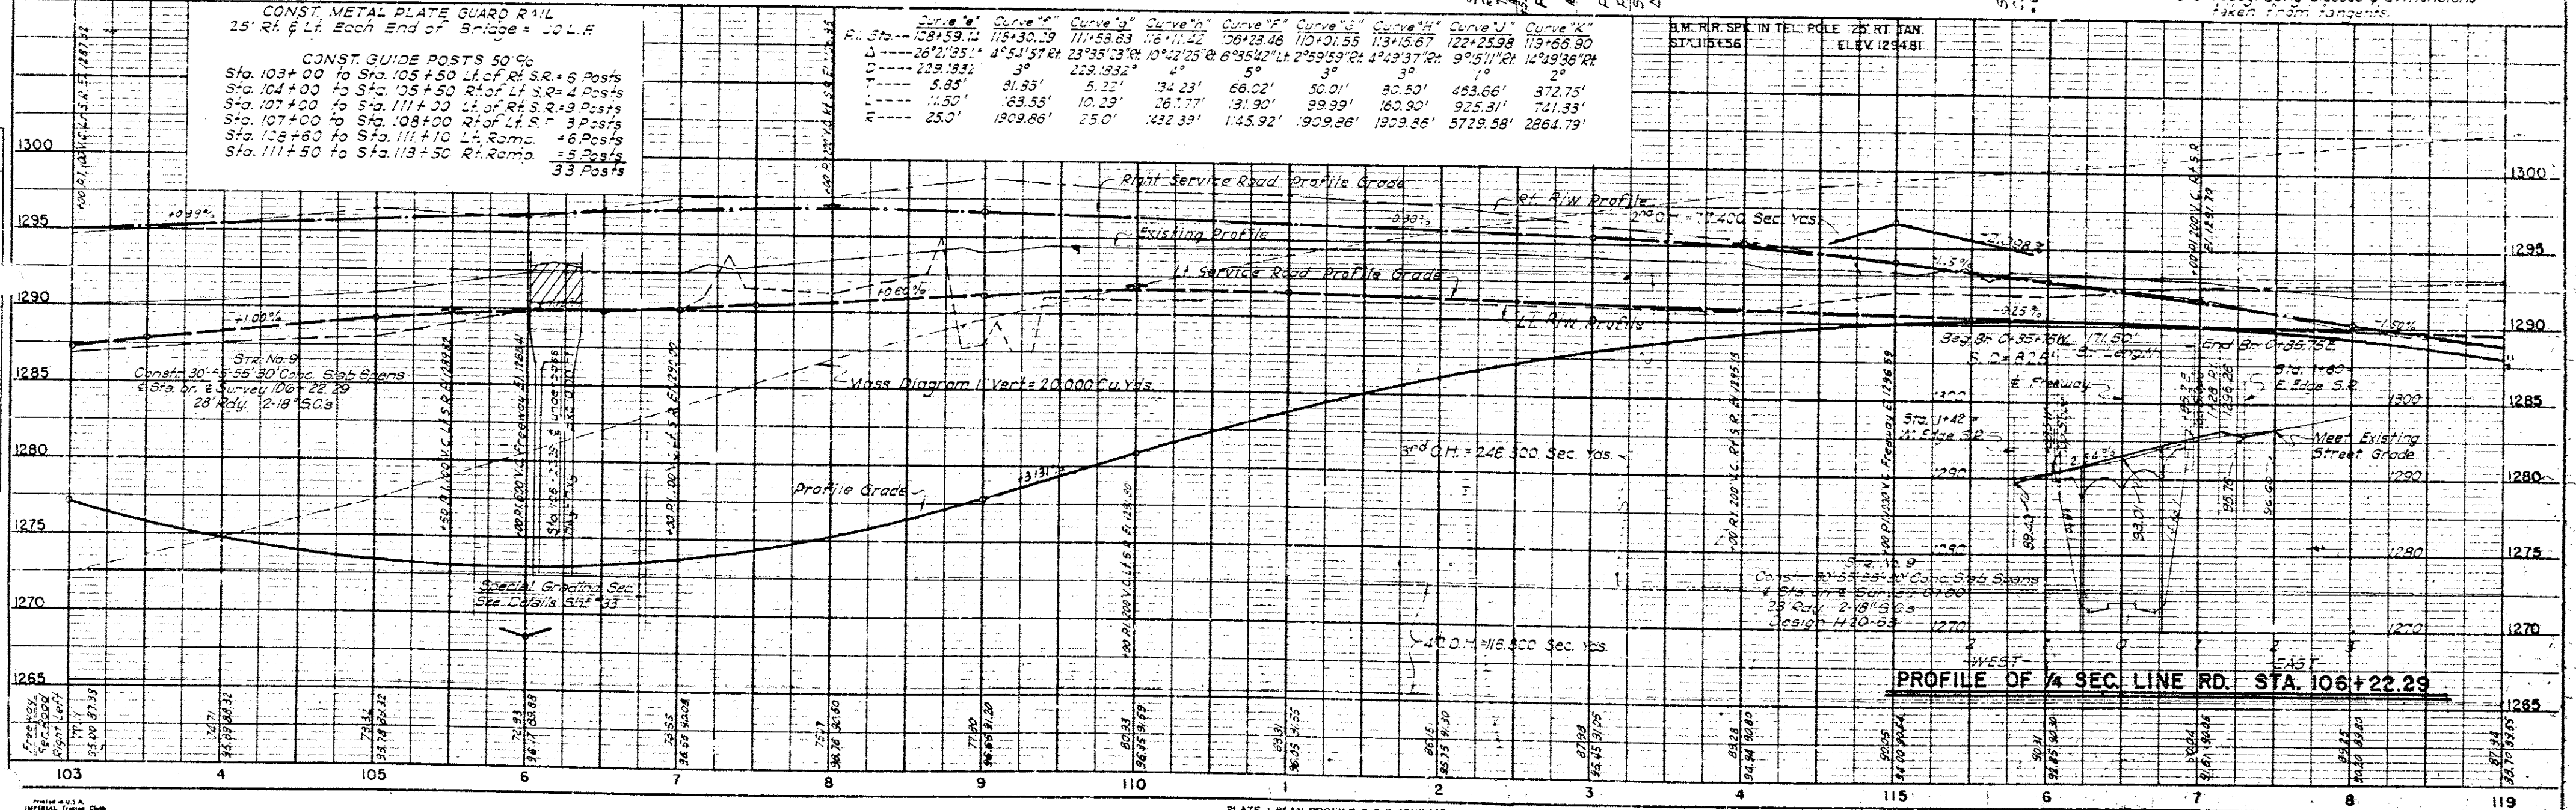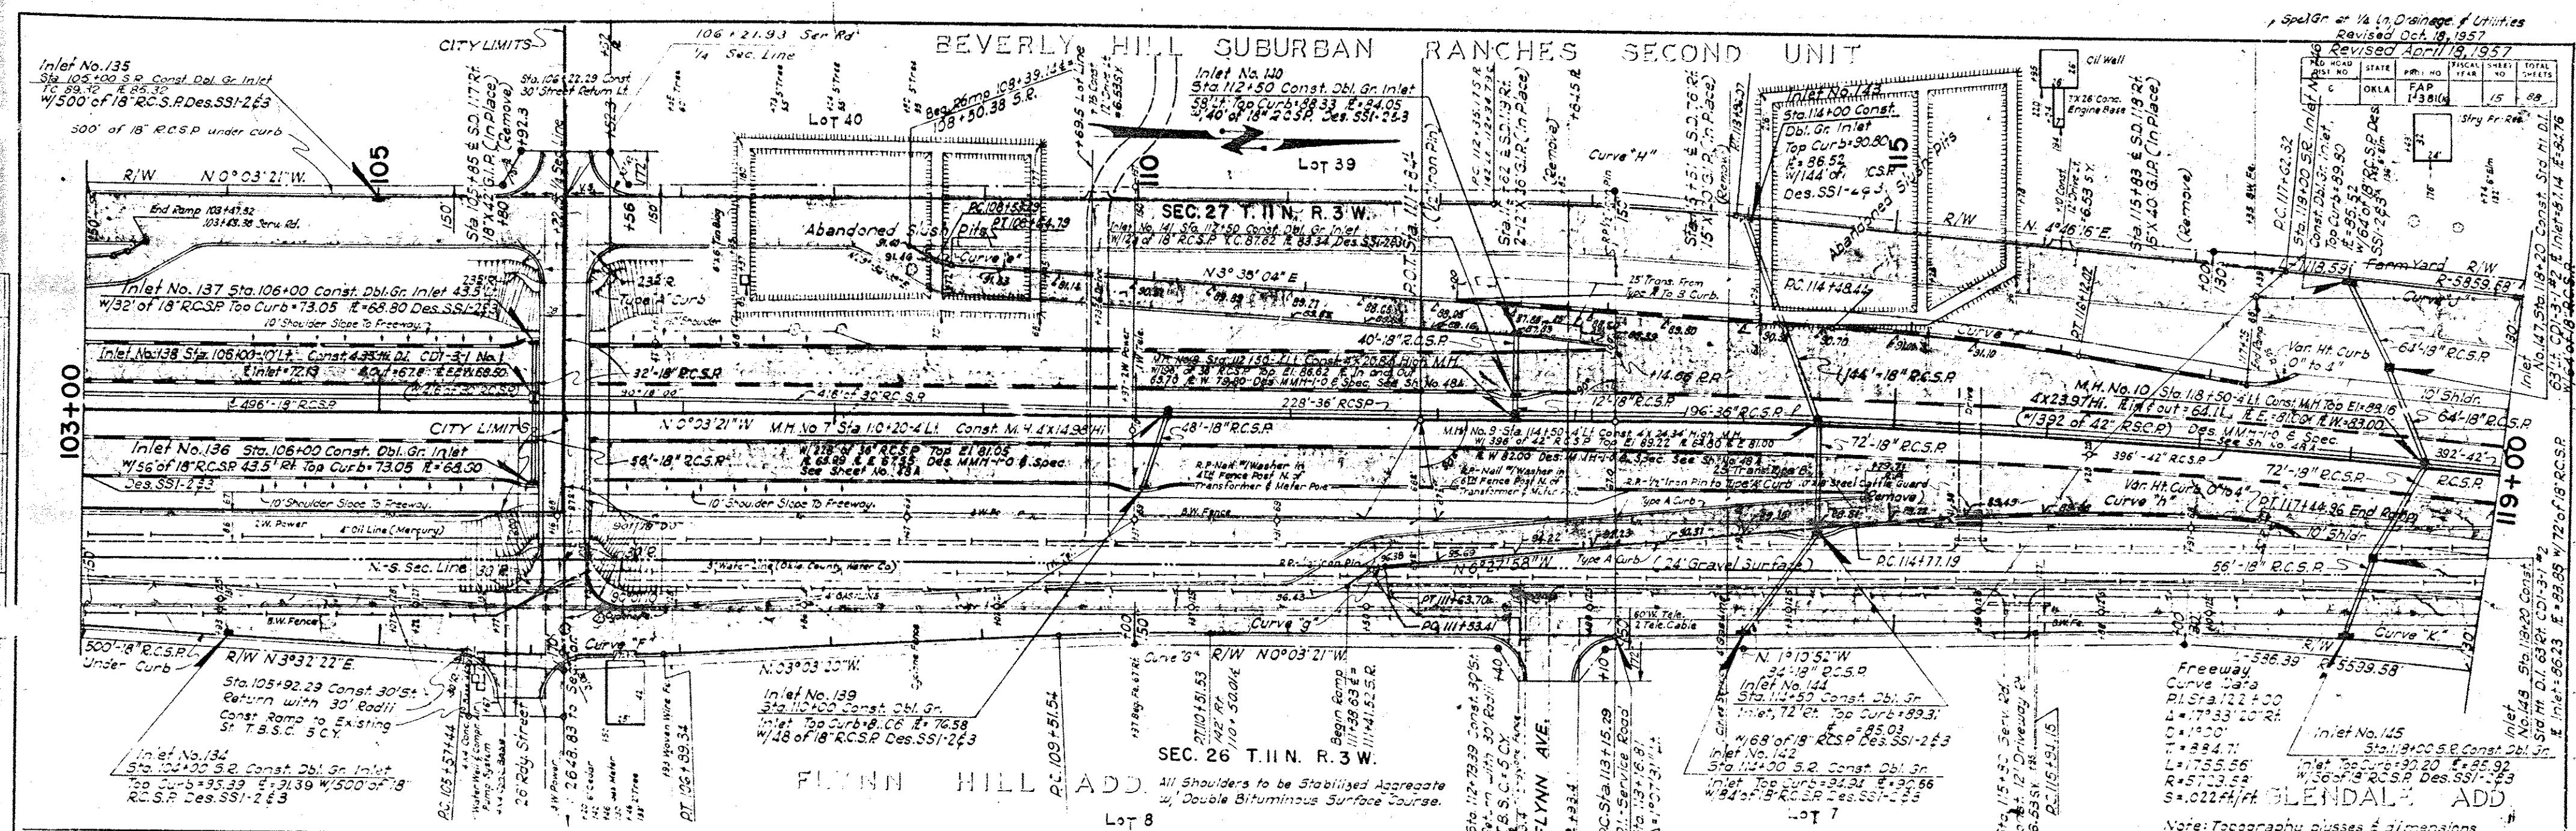

NOTES:
1. ALL DIMENSIONS TO BE STABILIZED AGGREGATE WITH DOUBLE BITUMINOUS SURFACE.
2. DIMENSIONED FROM BACK SLOPE.
3. ALL SHOULDER TO BE STABILIZED AGGREGATE WITH DOUBLE BITUMINOUS SURFACE.
4. ALL DIMENSIONS TO BE STABILIZED AGGREGATE WITH DOUBLE BITUMINOUS SURFACE.
5. ALL DIMENSIONS TO BE STABILIZED AGGREGATE WITH DOUBLE BITUMINOUS SURFACE.
6. ALL DIMENSIONS TO BE STABILIZED AGGREGATE WITH DOUBLE BITUMINOUS SURFACE.
7. ALL DIMENSIONS TO BE STABILIZED AGGREGATE WITH DOUBLE BITUMINOUS SURFACE.
8. ALL DIMENSIONS TO BE STABILIZED AGGREGATE WITH DOUBLE BITUMINOUS SURFACE.
9. ALL DIMENSIONS TO BE STABILIZED AGGREGATE WITH DOUBLE BITUMINOUS SURFACE.
10. ALL DIMENSIONS TO BE STABILIZED AGGREGATE WITH DOUBLE BITUMINOUS SURFACE.

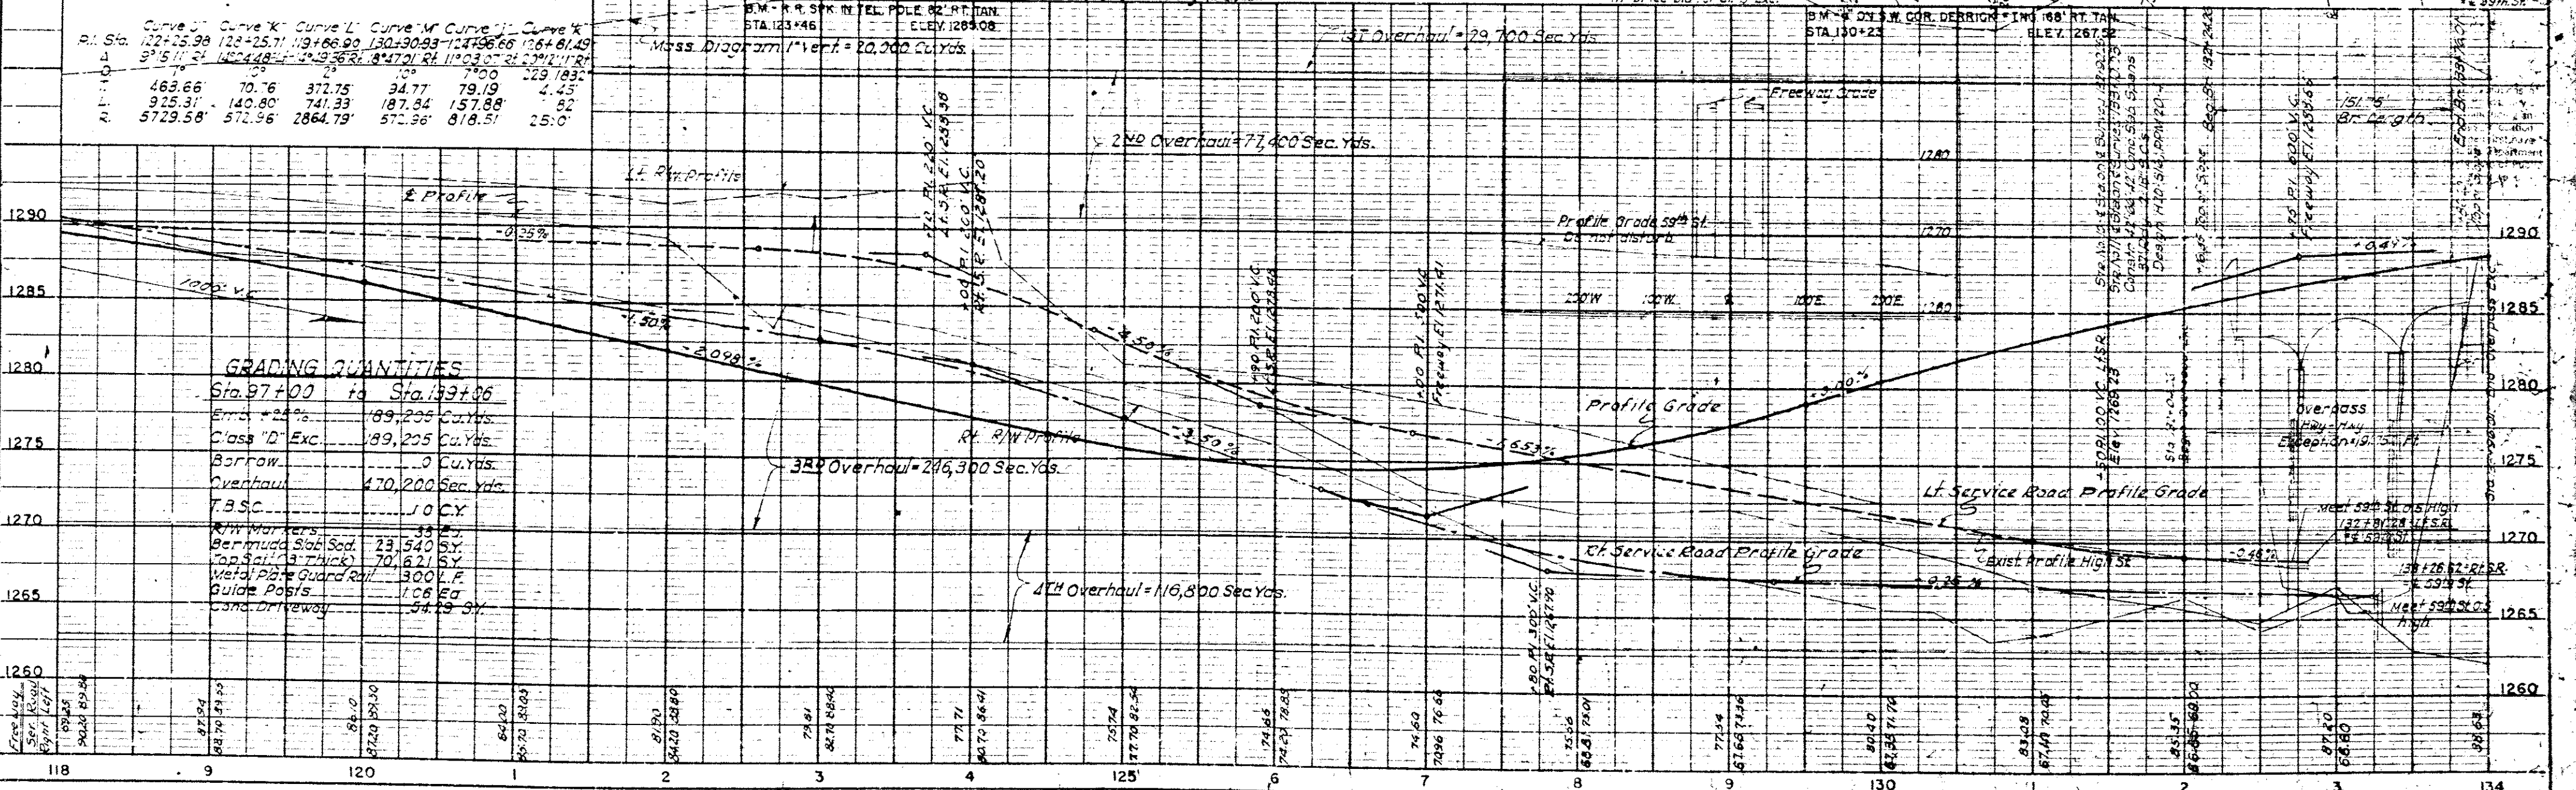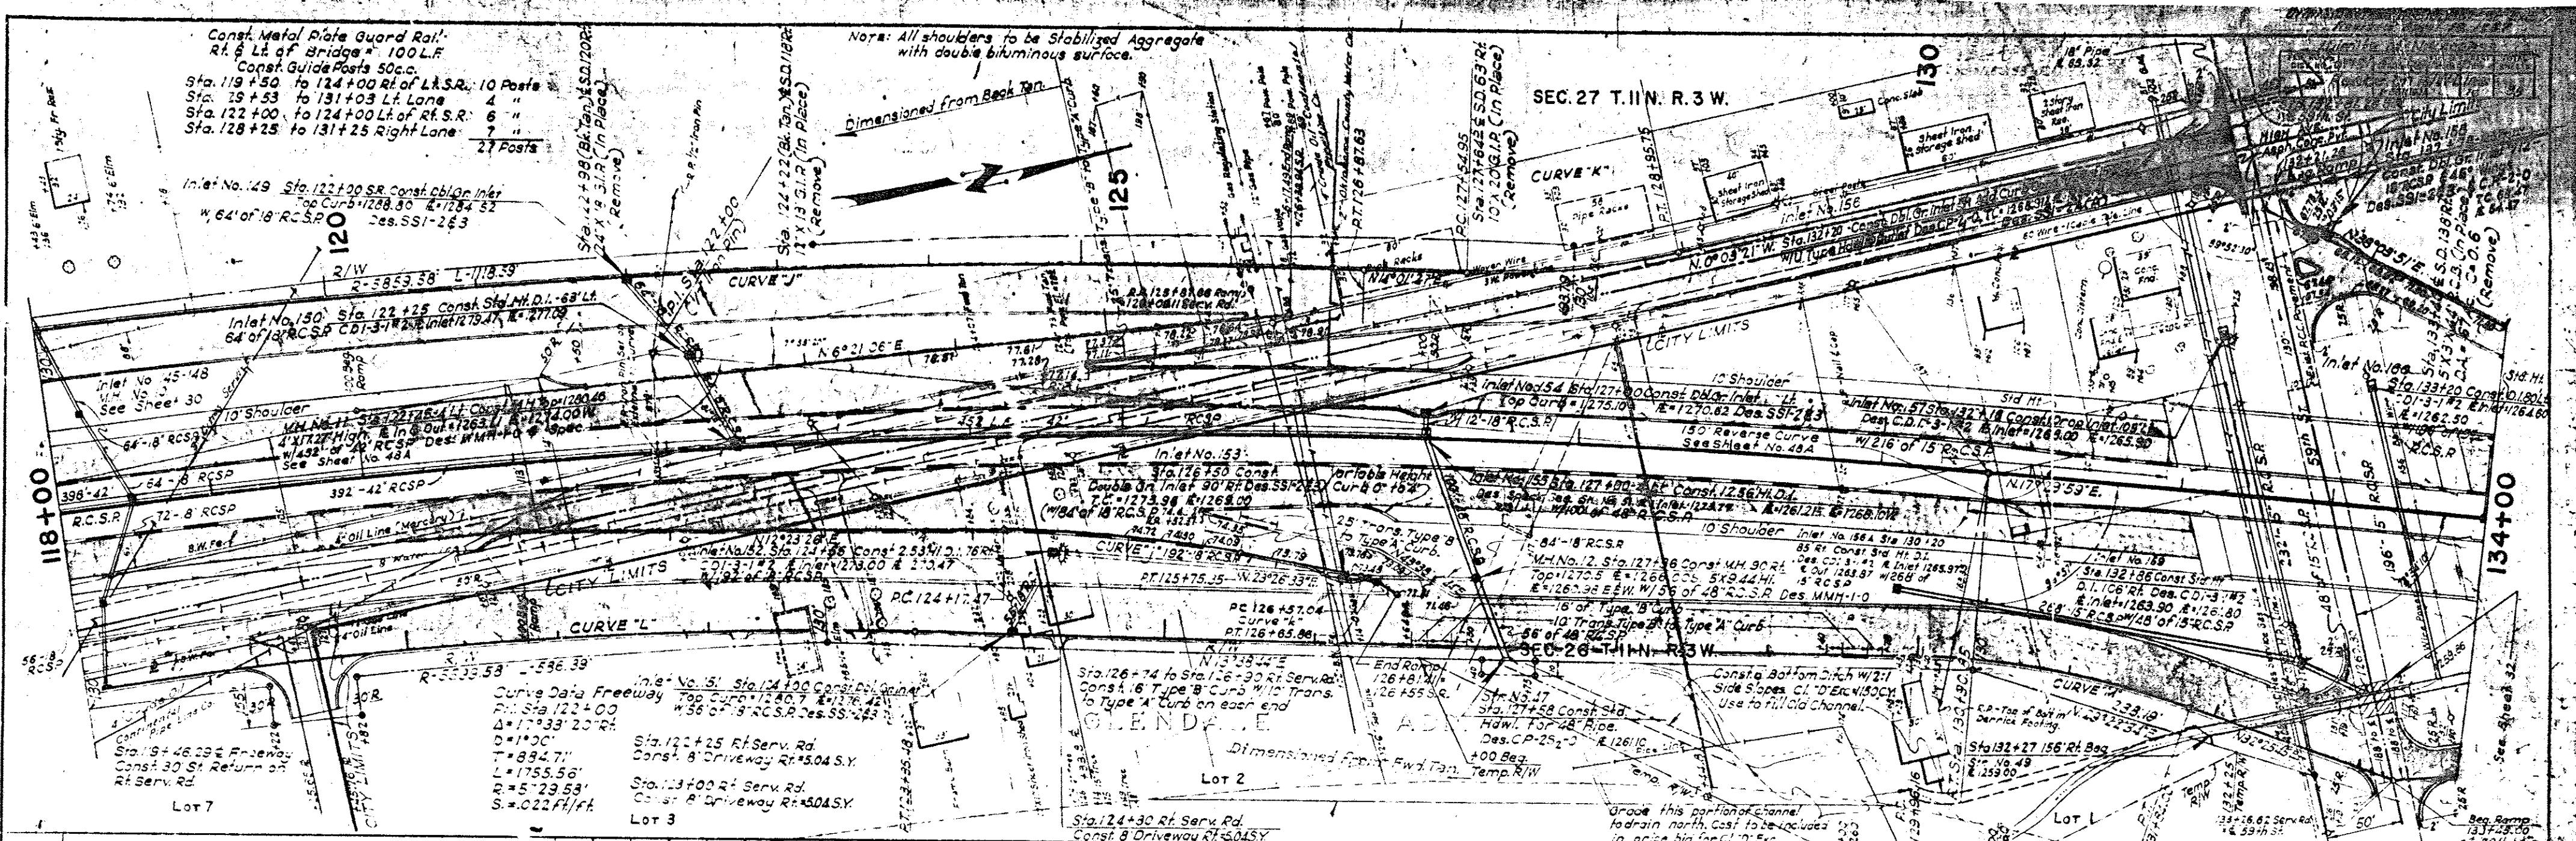

GRADING QUANTITIES

Sta. 97+00 to Sta. 139+00	
Excavation	89,205 Cu.Yds.
Class "D" Exc.	89,205 Cu.Yds.
Borrow	0 Cu.Yds.
Overhaul	470,200 Sec.Yds.
T.B.S.C.	10 CY
R/W Markers	33 E.P.
Bermuda Sub. Sod.	23,540 Sq.
Top Soil (3" Thick)	70,621 Sq.
Met. Plate Guard Rail	300 L.F.
Guide Posts	106 Ea.
Const. Driveway	54.23 Sq.

PLATE 1 - PLAN - PROFILE & P. & R. STANDARD

F.A. PROJECT NO. 1-21(1) SHEET NO. 6

FED. ROAD DIST. NO.	STATE	PROJ. NO.	FISCAL YEAR	SHEET NO.	TOTAL SHEETS
6	OKLA.	F.A.P. 1-191(3)		13	89

Revised Oct. 4, 1937 - Det. Sec. 1, 5th P.M. 1937

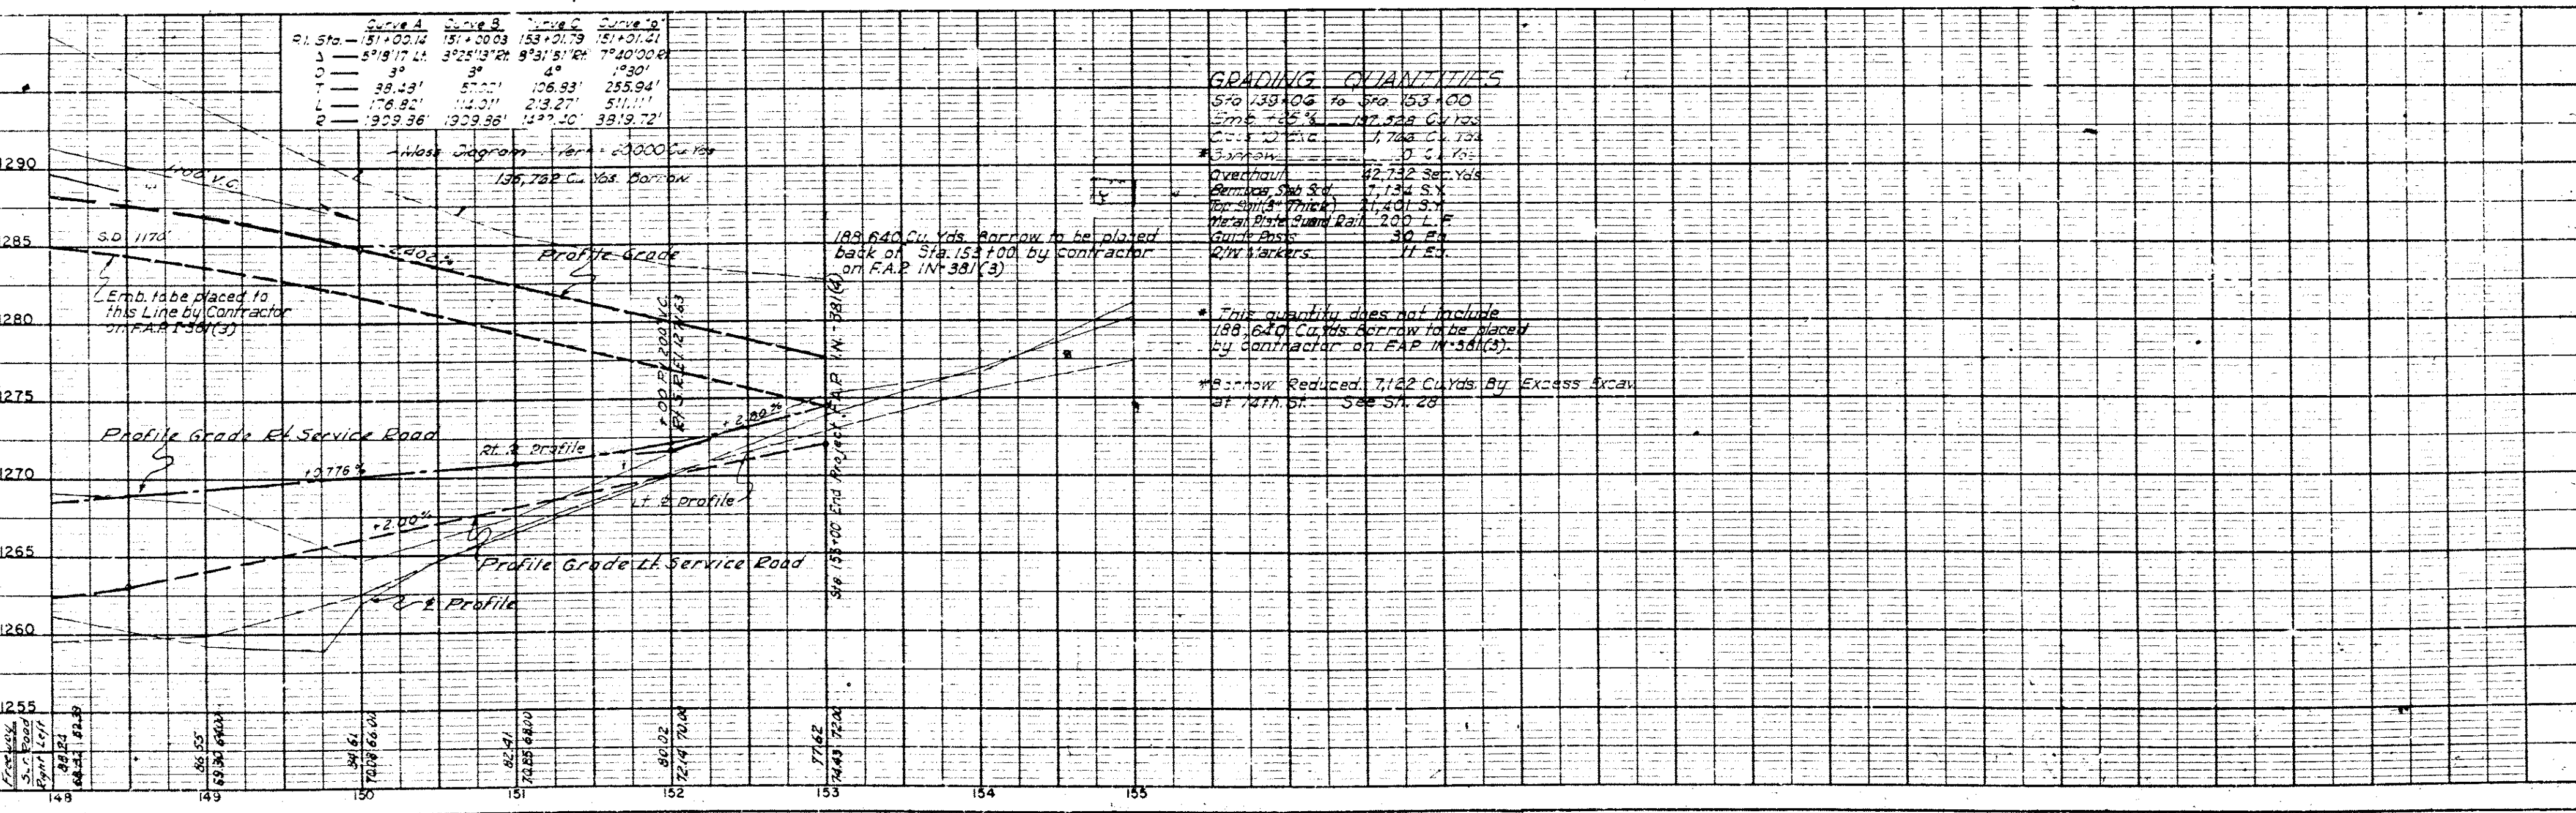
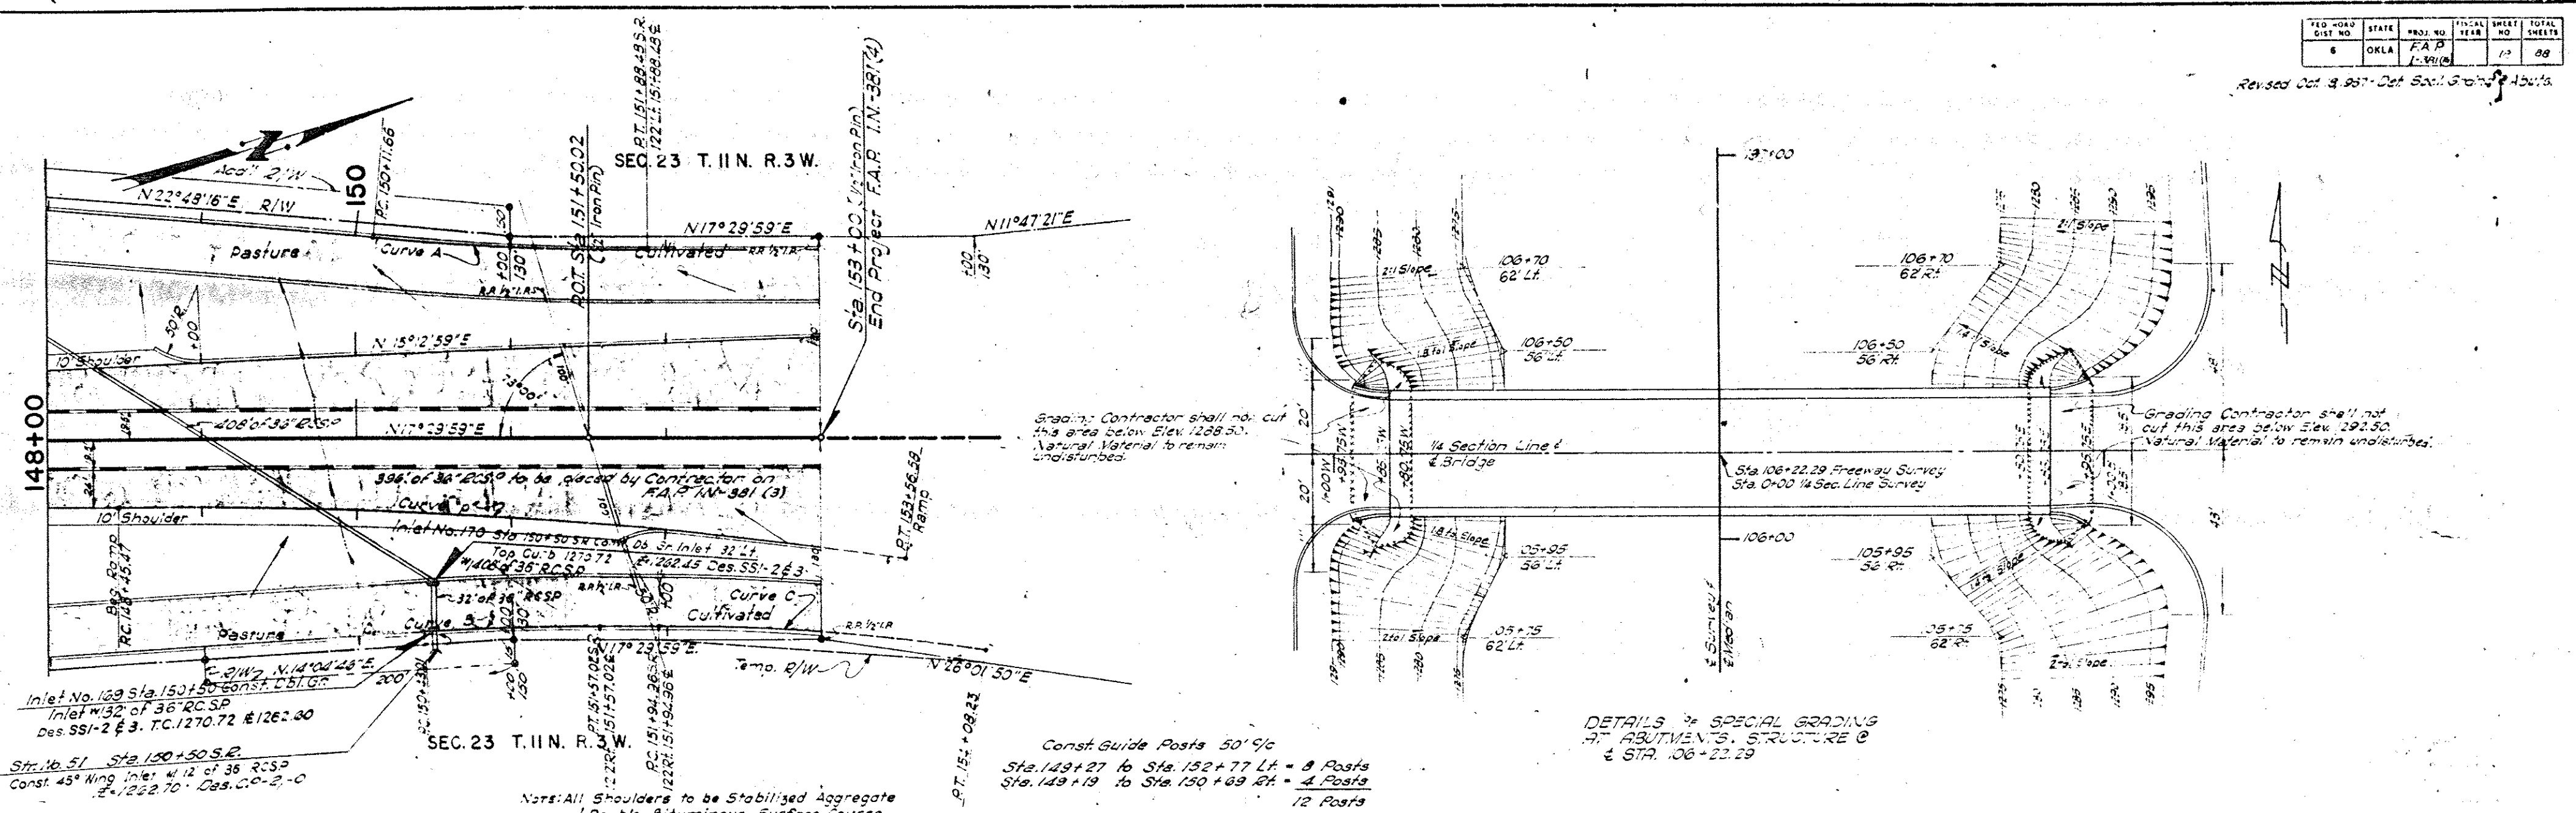


PLATE 1-PLAN-PROFILE S. P. R. STANDARD

ENGINEERS: BENTZON CO., Chicago, Ill. Inc.

F.A. PROJECT NO. 1-191(3) SHEET NO. 13

SUMMARY OF PAY QUANTITIES - BRIDGES

PAY QUANTITIES								
ITEM No.	ITEM	UNIT	PT. 1 STRUCTURE No. 1 40'-53'-40" Conc. Slab Span 37' Rdy. & 2-18" S.C's. & Sta. on & Survey 34+25.30	PT. 1 STRUCTURE No. 2 36'-62'-5'-36" Conc. Slab Span Lt. 37' Rdy. & 2-18" S.C's. & Sta. on & Survey 52+83.53	PT. 1 STRUCTURE No. 3 36'-62'-5'-36" Conc. Slab Span Rt. 37' Rdy. & 2-18" S.C's. & Sta. on & Survey 52+83.53	PT. 1 STRUCTURE No. 4 36'-62'-5'-36" Conc. Slab Span Lt. 37' Rdy. & 2-18" S.C's. & Sta. on & Survey 27+00	PT. 1 STRUCTURE No. 5 36'-62'-5'-36" Conc. Slab Span Rt. 37' Rdy. & 2-18" S.C's. & Sta. on & Survey 27+00	PT. 1 STRUCTURE No. 6 30'-55'-55'-30" Conc. Slab Span 28' Rdy. & 2-18" S.C's. & Sta. on & Survey 53+36.10
202.06d	Class "D" Excavation	C.Y.						1,400 **
308.06a	4" Sand Cushion	S.Y.						1,309
414.06c	Approach Slabs	S.Y.						1,309
501.06b	Substructure Excavation-Common	C.Y.	305	180	350	350	360	135
501.06c	Substructure Excavation-Rock	C.Y.	27	104	88	48	19	73.7
505.06	Steel Handrailing (Alt. No. 1)	L.F.	283.5	271.5	271.5	271.5	271.5	3'2.5
509.06a	Class "A" Concrete	C.Y.	142.4	142.4	129	126.8	124.8	134.7
509.06a	Class "A" Conc. in Pier & Abut. Bases	C.Y.	33	46	46	46	46	36.9
509.06b	Class "AA" Concrete	C.Y.	567	576.1	576.1	576.1	576.1	433.3
511.06	Reinforcing Steel	Lbs.	114,740	89,430	90,350	89,990	89,660	87,025
513.06a	Corrugated Galv. Metal Pipe, 15"	L.F.						
514.06d	Reinforced Concrete Piling	L.F.	430	78	440	484	484	
611.06h	Inlet Frame & Grate	Ea.						9
624.06a	6" Black Traffic Stripe	L.F.	280	272	272	272	272	171.5
Special	4" Concrete Slope Wall	S.Y.	353.3	320.8	328	322	325.8	
Special	Aluminum Handrailing (Alt. No. 2)	L.F.	283.5	271.5	271.5	271.5	271.5	342.5

* Equation;
88+82.50 Bk.
12+01.69 Fwd.
** Non-Participating Item


NOTE: Contractor shall submit bids on both types of Handrailing. Type of rail will be determined by bids received.
Steel Handrailing will be listed in the proposal as Alternate No. 1 and Aluminum Handrailing as Alternate No. 2.

See special provision for maintenance of traffic and sequence of operations on Roadway and Bridges on and within the limits of Federal Aid Project No. 1-381(4) Rdy.

PAY QUANTITIES								
ITEM No.	ITEM	UNIT	PT. 2 STRUCTURE No. 7 35'-45'-56'-45'-35" T-Beam Span Lt. 38' Rdy. & 2-18" S.C's. & Sta. on & Survey 79+91.92	PT. 2 STRUCTURE No. 8 35'-45'-56'-45'-35" T-Beam Span Rt. 38' Rdy. & 2-18" S.C's. & Sta. on & Survey 79+69.74	PT. 1 STRUCTURE No. 9 30'-55'-55'-30" Conc. Slab Span 28' Rdy. & 2-18" S.C's. & Sta. on & Survey 106+22.29	PT. 1 STRUCTURE No. 10 22'-66'-42" Conc. Slab Span Lt. 37' Rdy. & 2-18" S.C's. & Sta. on & Survey 132+30.25	PT. 1 STRUCTURE No. 11 42'-66'-42" Conc. Slab Span Rt. 37' Rdy. & 2-18" S.C's. & Sta. on & Survey 133+10.03	PT. 2 STRUCTURE No. 12 40'-74'-92'-4" Conc. Slab Span 30' Rdy. & 2-18" S.C's. & Sta. on & Survey 43+22.30
202.06d	Class "D" Excavation	C.Y.						800 **
308.06a	4" Sand Cushion	S.Y.						893.4
414.06c	Approach Slabs	S.Y.						893.4
501.06b	Substructure Excavation-Common	C.Y.	600	550	23	575	465	1,520
501.06c	Substructure Excavation-Rock	C.Y.	41	50	83	44	39	87
505.06	Steel Handrailing (Alt. No. 1)	L.F.	274.92	274.92	342.5	305	305	355.5
506.06	Structural Steel	Lbs.	295,675	295,675				308,005
509.06a	Class "A" Concrete	C.Y.	274.4	272.9	109	109.2	137.4	345.2
509.06a	Class "A" Conc. in Pier & Abut. Bases	C.Y.	56.4	56.4	29.5	52.2	52.2	79.2
509.06b	Class "AA" Concrete	C.Y.	253.1	253.1	433.3	700.3	700.3	257
511.06	Reinforcing Steel	Lbs.	82,785	82,600	84,910	102,550	102,550	115,505
513.06a	Corrugated Galv. Metal Pipe, 15"	L.F.						
514.06d	Reinforced Concrete Piling	L.F.	378	369		561	583	670
611.06h	Inlet Frame & Grate	Ea.						
624.06a	6" Black Traffic Stripe	L.F.	547	547	171.5	303.5	303.5	324.5
Special	4" Concrete Slope Wall	S.Y.	335.6	335.6		374.2	373.5	
Special	Aluminum Handrailing (Alt. No. 2)	L.F.	274.92	274.92	342.5	305	305	355.5
514.06a	1-16" Test Pile	Ea.						2
513.06a	48" Corrugated Galv. Metal Pipe***	L.F.						2

*** Refer to Sn. No. 17 for location of this item. See Special Provisions.

** Non-Participating Item

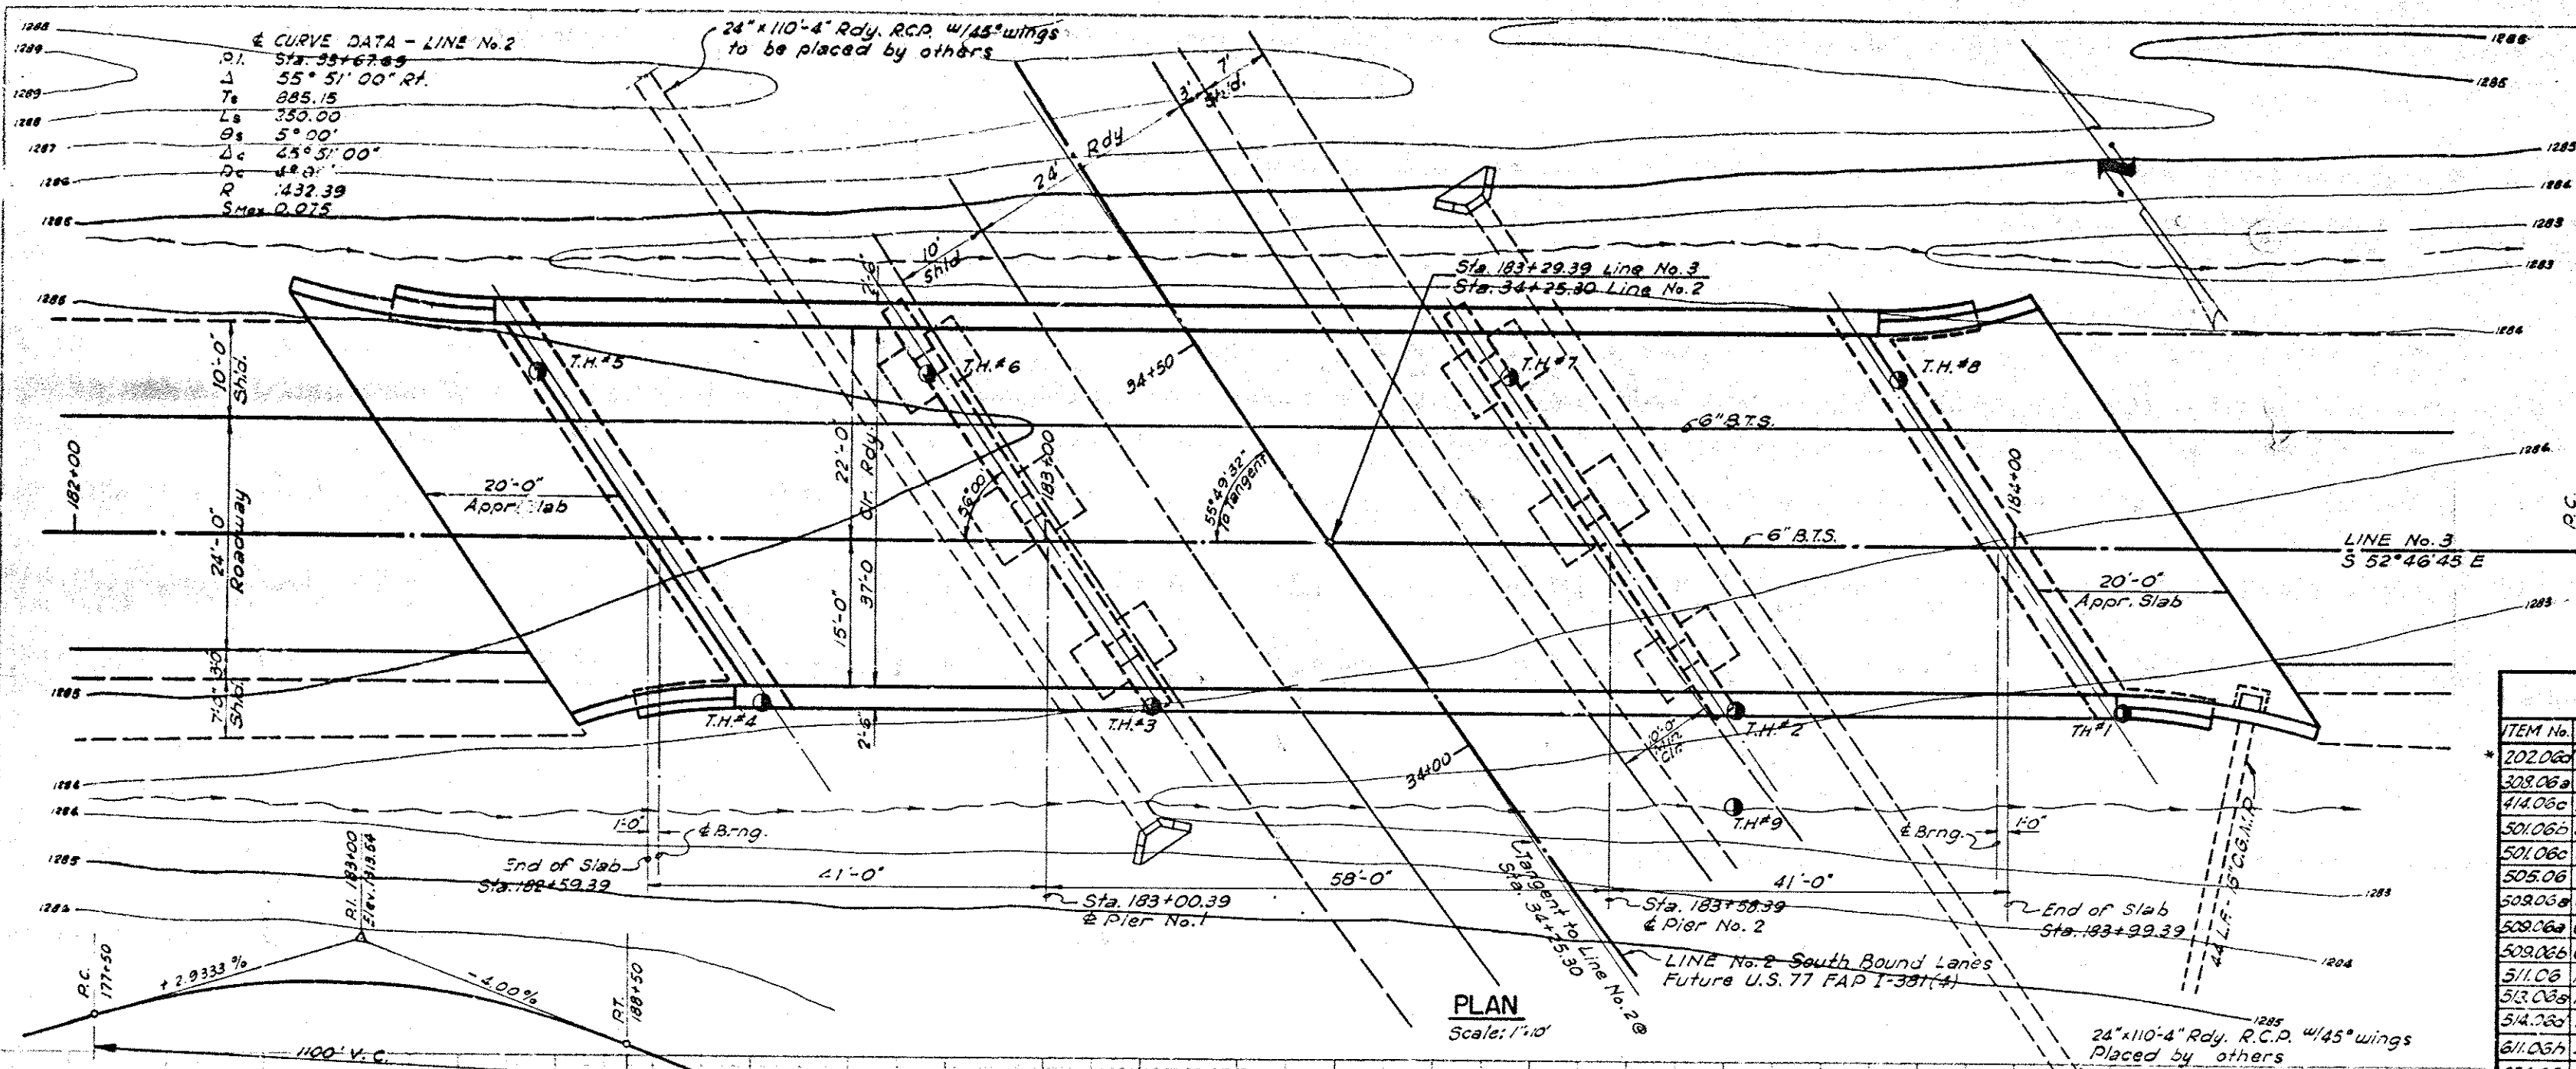


VERTICAL CURVE DATA

3.M. Top of R.W. Marker 50' Rt.
Sta 177+37.9 - Line 4 - Elev. 1288.58
3.M. East End of 1st Step - White Cottage
146' Rt. - Sta 20+34 - Line 1 - Elev. 1268.49

140'-0" Bridge Length
End of Slab to End of Slab

Sta. 183+99.39
End of Slab

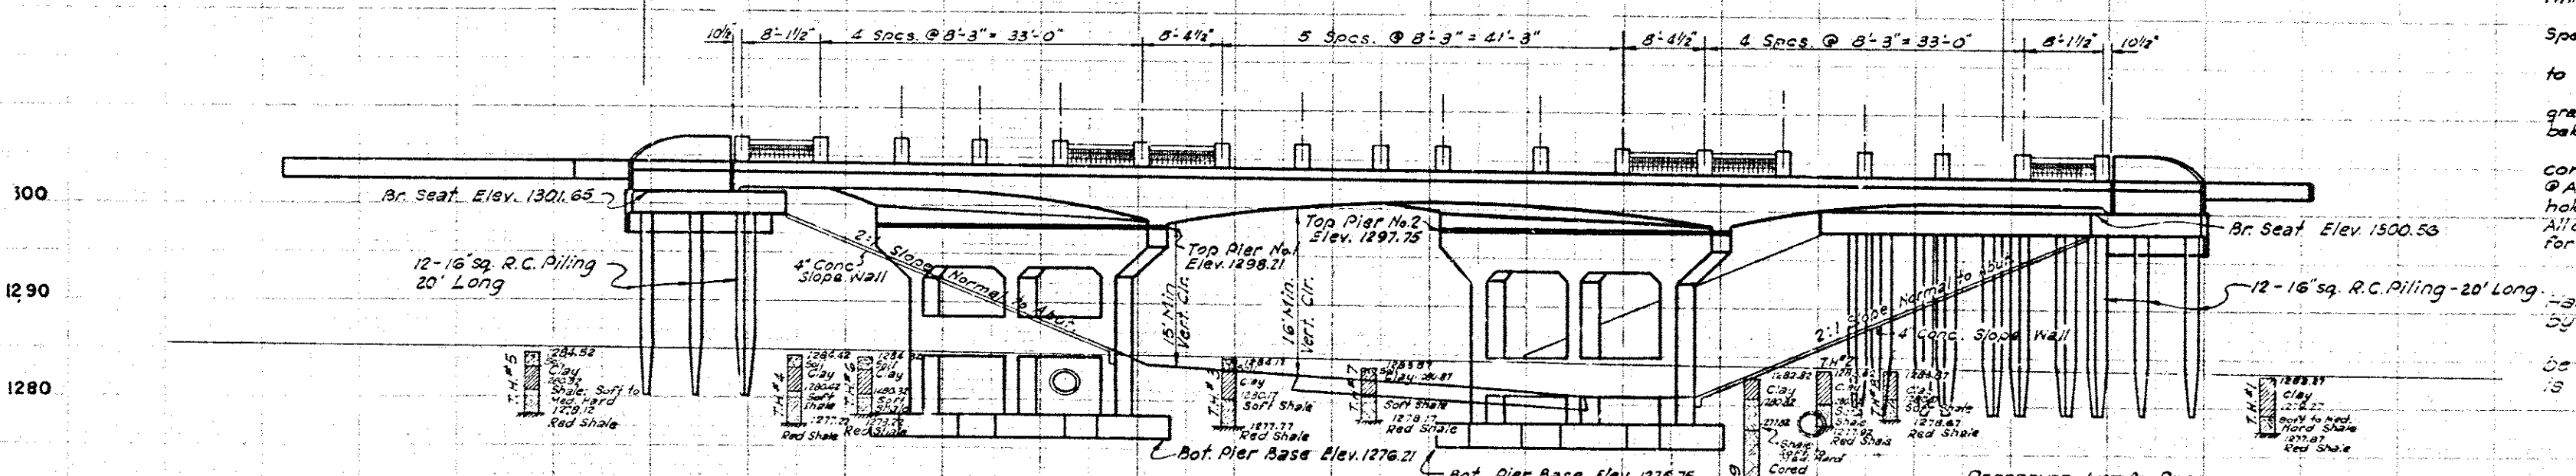

GENERAL ELEVATION
Scale: 1" = 10'

NO.	DESCRIPTION	BY	DATE
1	Rev. Summary of Plan Sheet 23	DES	2-6-55
2			
3			
4			
5			
6			
7			
8			
9			
10			

SPECIAL PROVISIONS
See Special Provisions included in the Proposal
For Curing Concrete with Membrane Curing
Compound for Bridge Structures Including
Parapet Walls, Retaining Walls & Railing
414-6(a) Rev. 7-27-53.
Equipment for Driving Piles 514-1 (a).
Reinforcing Steel (AISI Steel) 723-1(a) Rev. 2-21-57.
Black Traffic Stripes or Black Traffic
Stripes Arrow 624-1(a) Rev. 11-18-55.
Neoprene Rubber for bearing devices.

REFERENCE LIST OF DETAILS:-
DETAILS OF ABUTMENTS - SHEET # 21
DETAILS OF PIERS - SHEET # 22
DETAILS OF SUPERSTR. - SHEETS # 23 & 24
DETAILS OF SLAB ELEV. - SHEET # 25
DETAILS OF APPROX. SLABS - SHEET # 26
DETAILS OF HANDRAILING - SHEET # 30 & 31
DETAILS OF PILING - SHEET # 27

DESIGN DATA

Design Live Load H20-S16-53; PPM 20-4
Concrete 1,000 p.s.i.
Reinforcing Steel 18,000 p.s.i.
Foundation Load:
Abutments 23.2 T/pile
Piers: Direct Load 3.9 T/sq. ft.

SUMMARY OF QUANTITIES

ITEM No.	ITEM	UNIT	Abuts	Piers	Super-struct	Bridge	Rdy.
202.00	Class "D" Excavation	C.Y.					200
308.00	4" Sand Cushion	S.Y.					223.6
414.00	Approach Slabs	S.Y.					223.6
501.00	Substr. Excav. - Common	C.Y.	190	115		305	
501.00	Substr. Excav. - Rock	C.Y.		27		27	
505.00	Steel Handrailing	L.F.			283.5		
508.00	Class "A" Concrete	C.Y.	62.0	80.4		42.4	0.6
509.00	Class "A" Conc. in Pier Bases	C.Y.		33.0		33.0	
509.00	Class "A" Conc. in Pier Bases	C.Y.			587.0	587.0	
511.00	Reinforcing Steel	Lbs.	8770	3,137	75,760	97,710	75
513.00	1/2" C.G.M. Pipe	L.F.					44
514.00	16" R.C. Piling	L.F.	480			480	
611.00	Inlet Frame & Grate	Ea.					1
624.00	6" Black Traffic Stripes	L.F.			280	280	80
	Special 4" Concrete Slope Wall	S.Y.					353.3
	Special Aluminum Handrailing	L.F.			283.5	283.5	


GENERAL NOTES
All construction materials shall be in accordance with the Oklahoma Standard Specifications of 1954 & Special Provisions.
All exposed concrete surfaces shall have a carborundum finish.
All reinforcing steel bars shall conform to A.S.T.M. Specifications A-305-49.
Piling shall be driven using loads of sufficient strength to control piles.
Piling shall be driven to practical refusal if above grade or to a minimum bearing of 50 tons if at or below grade.
All abutment piling shall be driven through the compacted fill. 12" x 12" Pilot holes shall be drilled to Elev. 1283.00 @ Abut. No. 1 and to Elev. 1282.00 @ Abut. No. 2. Then 8" x 8" Pilot holes to Elev. 1280.5 @ Abut. No. 1 and to Elev. 1279.5 @ Abut. No. 2. All cast of Pilot holes shall be included in the unit price bid for 12" R.C. Piling.
Contractor shall submit bids on both types of handrailing type of rail used, will be determined by bids received.
Pier footing elevations shall not be raised and shall be lowered only if firm footing foundation material is not found at plan elevation.

SKREW 56'-00' RT. F.W.D.

RECORD	
ITEM	BY DATE
DESIGN	
DETAIL	
TRACED	J.S.
CHECKED	2-22-55
APPR'D	
SQUAD	SENHAM


STR NO 1
GENERAL ELEVATION, PLAN & SUMMARY OF QUANTITIES
40'-58'-40' CONC. SLAB SPANS
37' RDY & 2-18" S.C.'s
@ STA ON & SURVEY 34+25.30
FA. PROJ. I- 381 (16) PT-1

FED. ROAD DIST. NO.	STATE	PROJ. NO.	SHEET NO.	TOTAL SHEETS
6	OKLA.	I-381 (16) PT-1	21	88

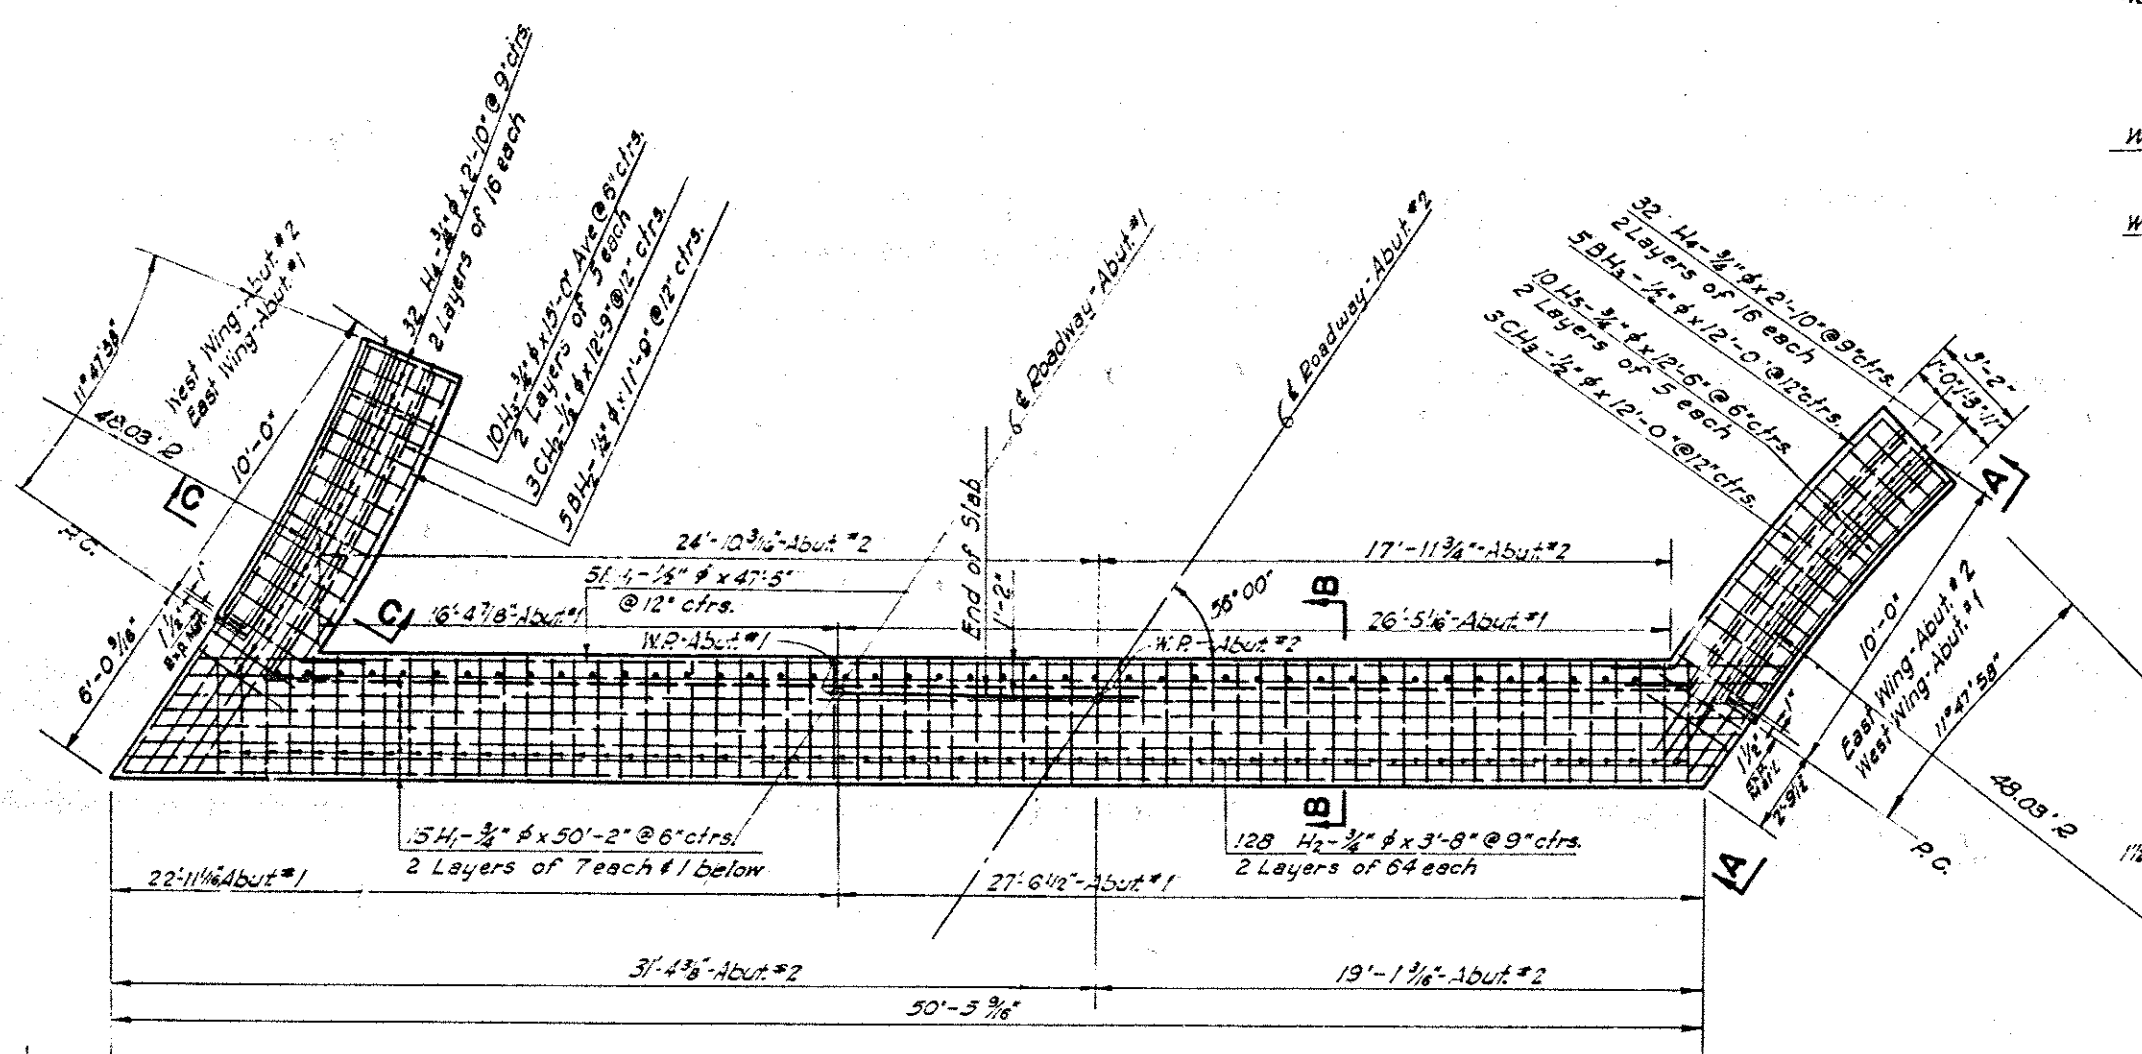


PLAN


For Abut. No. 2 - Abut. No. 1 Similar

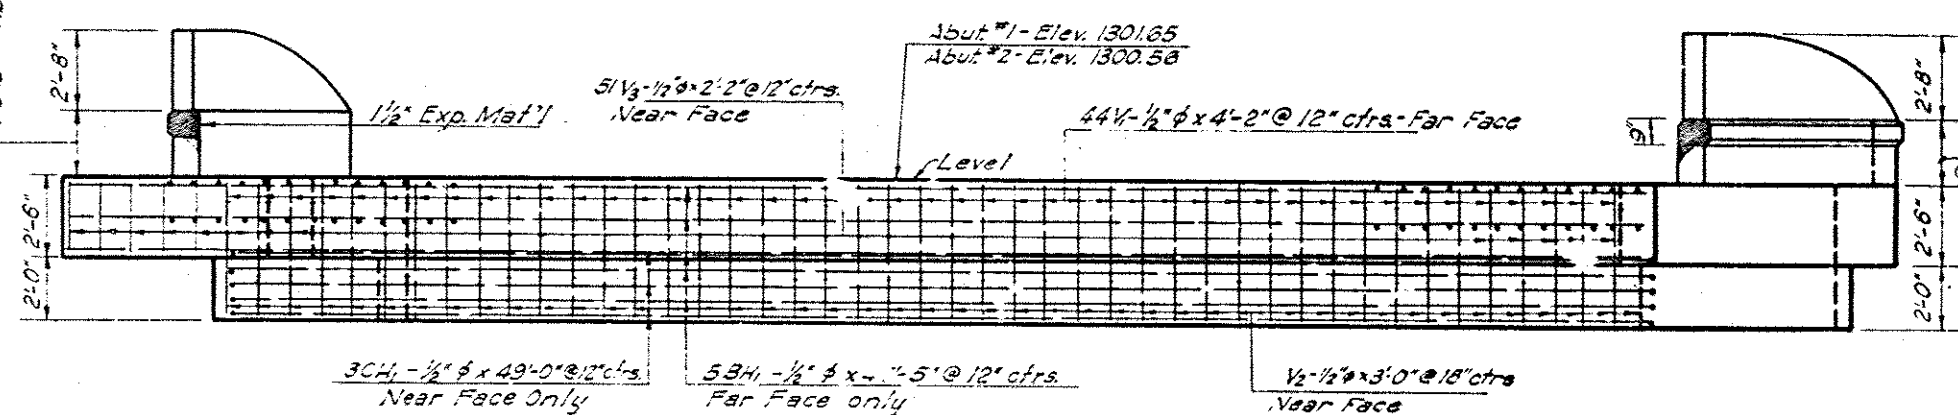

ELEVATION

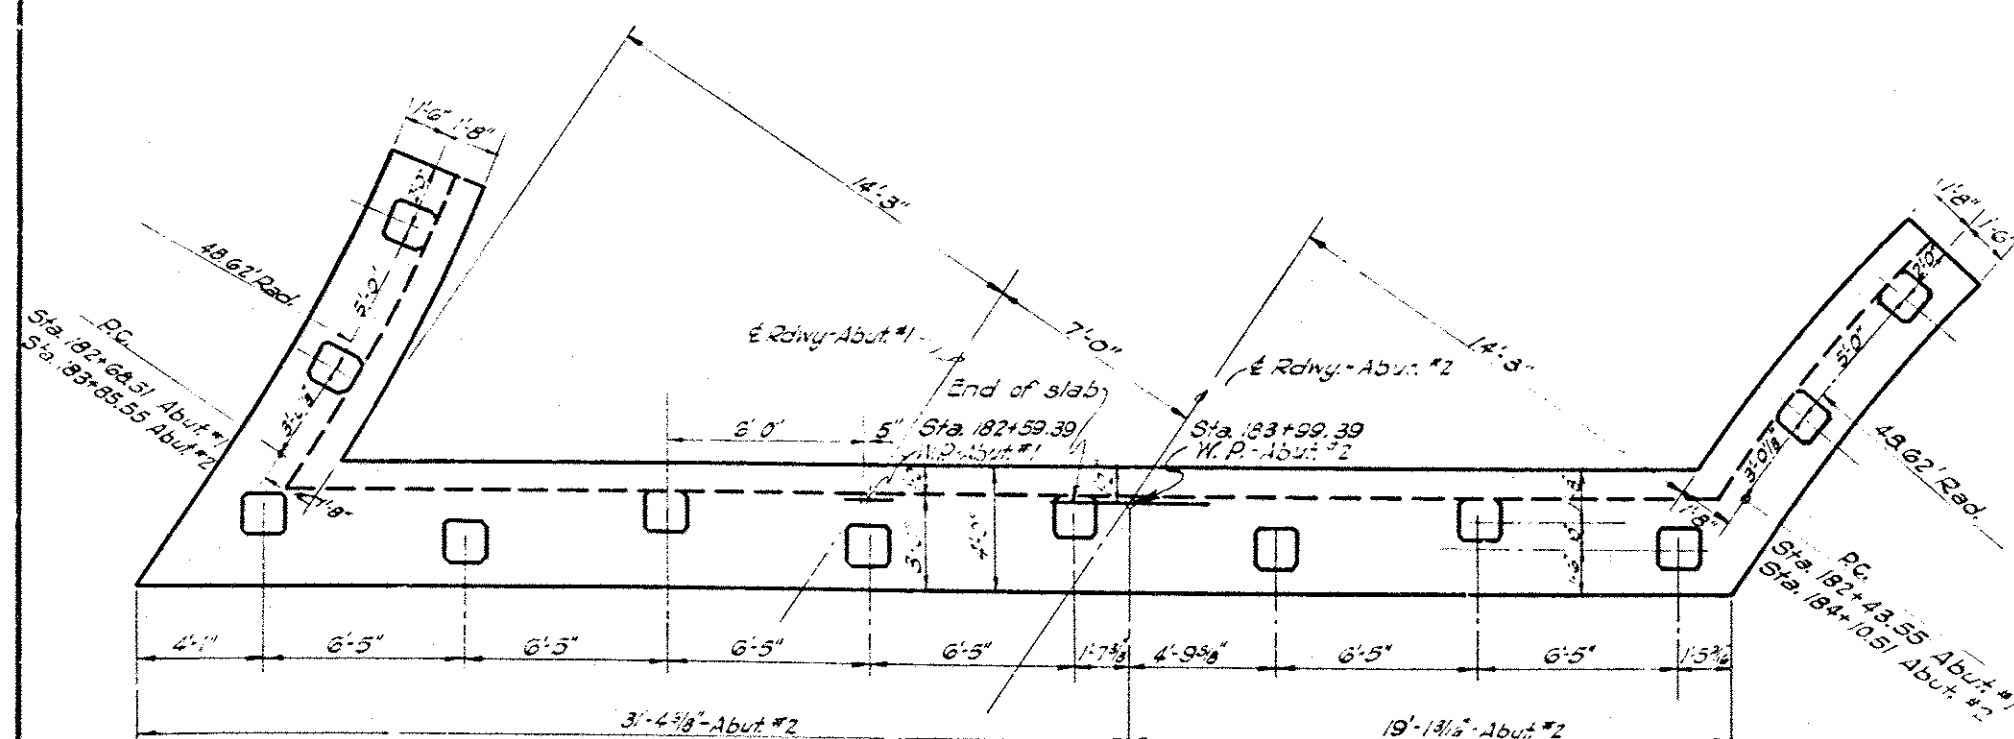

PILE SPACING PLAN

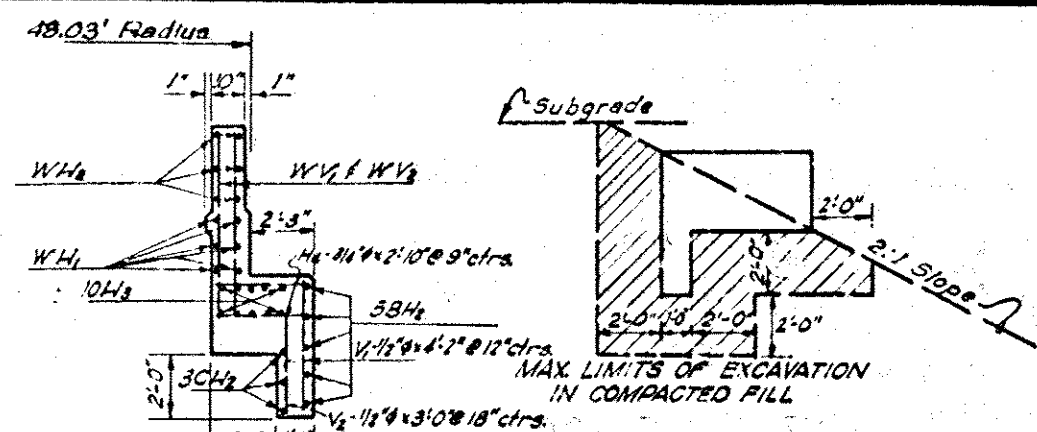


SECTION C-C

Abutment shall be back filled & tamped with a mechanical tamper (Type & weight to be approved by the engineer) by the bridge contractor after abutment is completed. All cost of backfill shall be included in the unit price bid per C.R. for subgrade excels common.


Contractor may excavate to the neat lines of the abutment, and if in satisfactory condition to the Resident Engineer he may pour concrete against the compacted fill. If necessary contractor shall use forms on the back vertical face of the abutment. Remove the same after concrete is set. H₃-3/4 x 12'-6" (BEND IN FIELD)

EXCAVATION DETAILS


WING WALL DETAIL

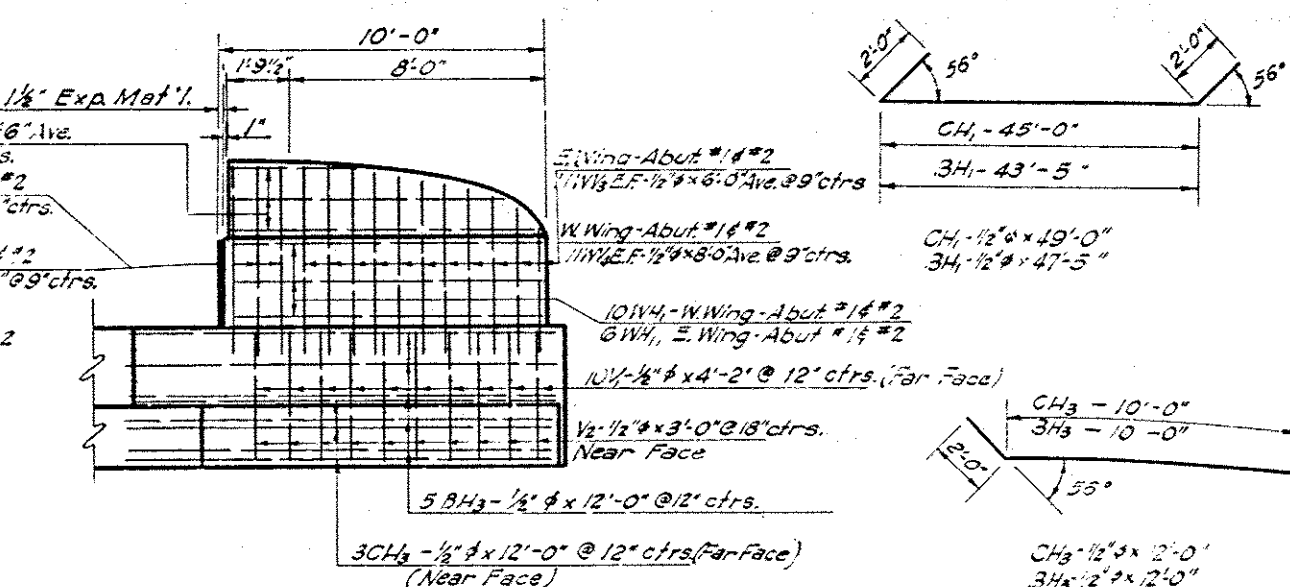

ELEVATION A-A

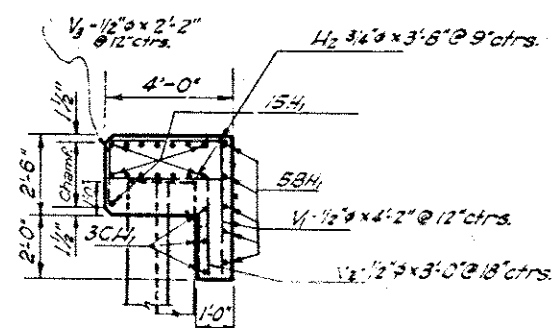

SECTION B-B

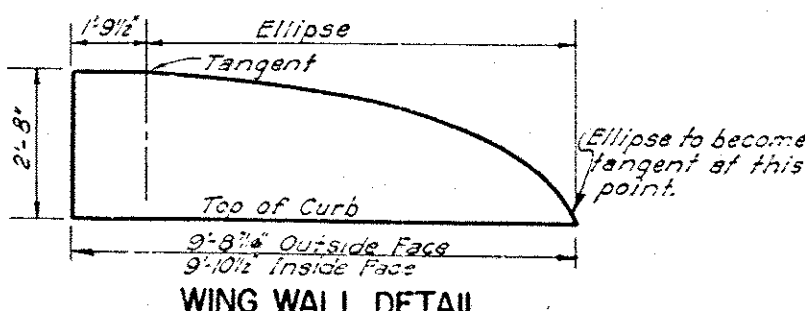

WING WALL DETAIL

BAR LIST-ONE ABUT.

Mark	No.	Size	Form	Length
H ₁	15	3/4"	Str.	50'-0"
H ₂	128	3/4"	Str.	3'-8"
H ₃	10	3/4"	Bnt.	15'-0" Ave.
H ₄	64	3/4"	Str.	2'-10"
H ₅	10	3/4"	Bnt.	12'-0"
BH ₁	5	1/2"	Bnt.	47'-5"
BH ₂	5	1/2"	Bnt.	11'-9"
BH ₃	5	1/2"	Bnt.	12'-0"
CH ₁	3	1/2"	Bnt.	49'-0"
CH ₂	3	1/2"	Bnt.	12'-9"
CH ₃	3	1/2"	Bnt.	12'-0"
V ₁	64	1/2"	Str.	4'-2"
V ₂	45	1/2"	Str.	3'-0"
V ₃	51	1/2"	Str.	2'-2"
WH ₁	16	1/2"	Str.	9'-6"
1-1/4"	12	1/2"	Str.	1'-6" Ave.
WV ₁	6	1/2"	Str.	6'-8"
WV ₂	6	1/2"	Str.	8'-4"
WV ₃	22	1/2"	Str.	6'-0" Ave.
WV ₄	22	1/2"	Str.	8'-0" Ave.
P	24	1/2"	Bnt.	3'-8"
K	48	3/4"	Bnt.	5'-3"

QUANTITIES-ONE ABUTMENT



C358-1 Concrete	C.Y.	31.3
Reinforcing Steel	LBS.	4,395
Subgrade Excels. Common	C.Y.	95

GENERAL NOTES
All construction & materials shall be in accordance with the Oklahoma Standard Specifications of 1954 & Special Provisions. All reinforcing steel bars shall conform to ASTM Specs. A-36-49. All exposed concrete edges shall have a 1/4" chamfer unless otherwise shown or noted. For details of Piling & P.H. bars, refer to Std. Dwg. CSD-3.

REVISIONS			RECORD		OKLAHOMA STATE HIGHWAY COMMISSION	
NO.	DESCRIPTION	BY DATE	ITEM	BY DATE	OKLAHOMA CITY, OKLAHOMA	
			DESIGN			
			DETAIL			
			TRACED			
			CHECKED			
			APPROVED			
			SQUAD			

STR. NO. 1
DETAILS OF ABUTMENTS
@ STA. ON @ SURVEY 34+25.30
FA. PROJ. I- 381 (16) PT-1


FED. ROAD DIST. NO.	STATE	PROJ. NO.	SHEET NO.	TOTAL SHEETS
6	OKLA.	I-381(16)PT-1	23	88

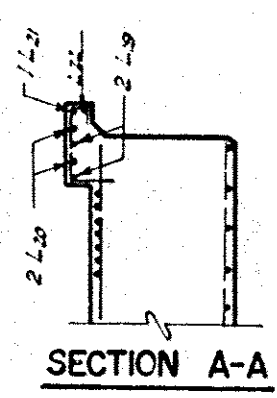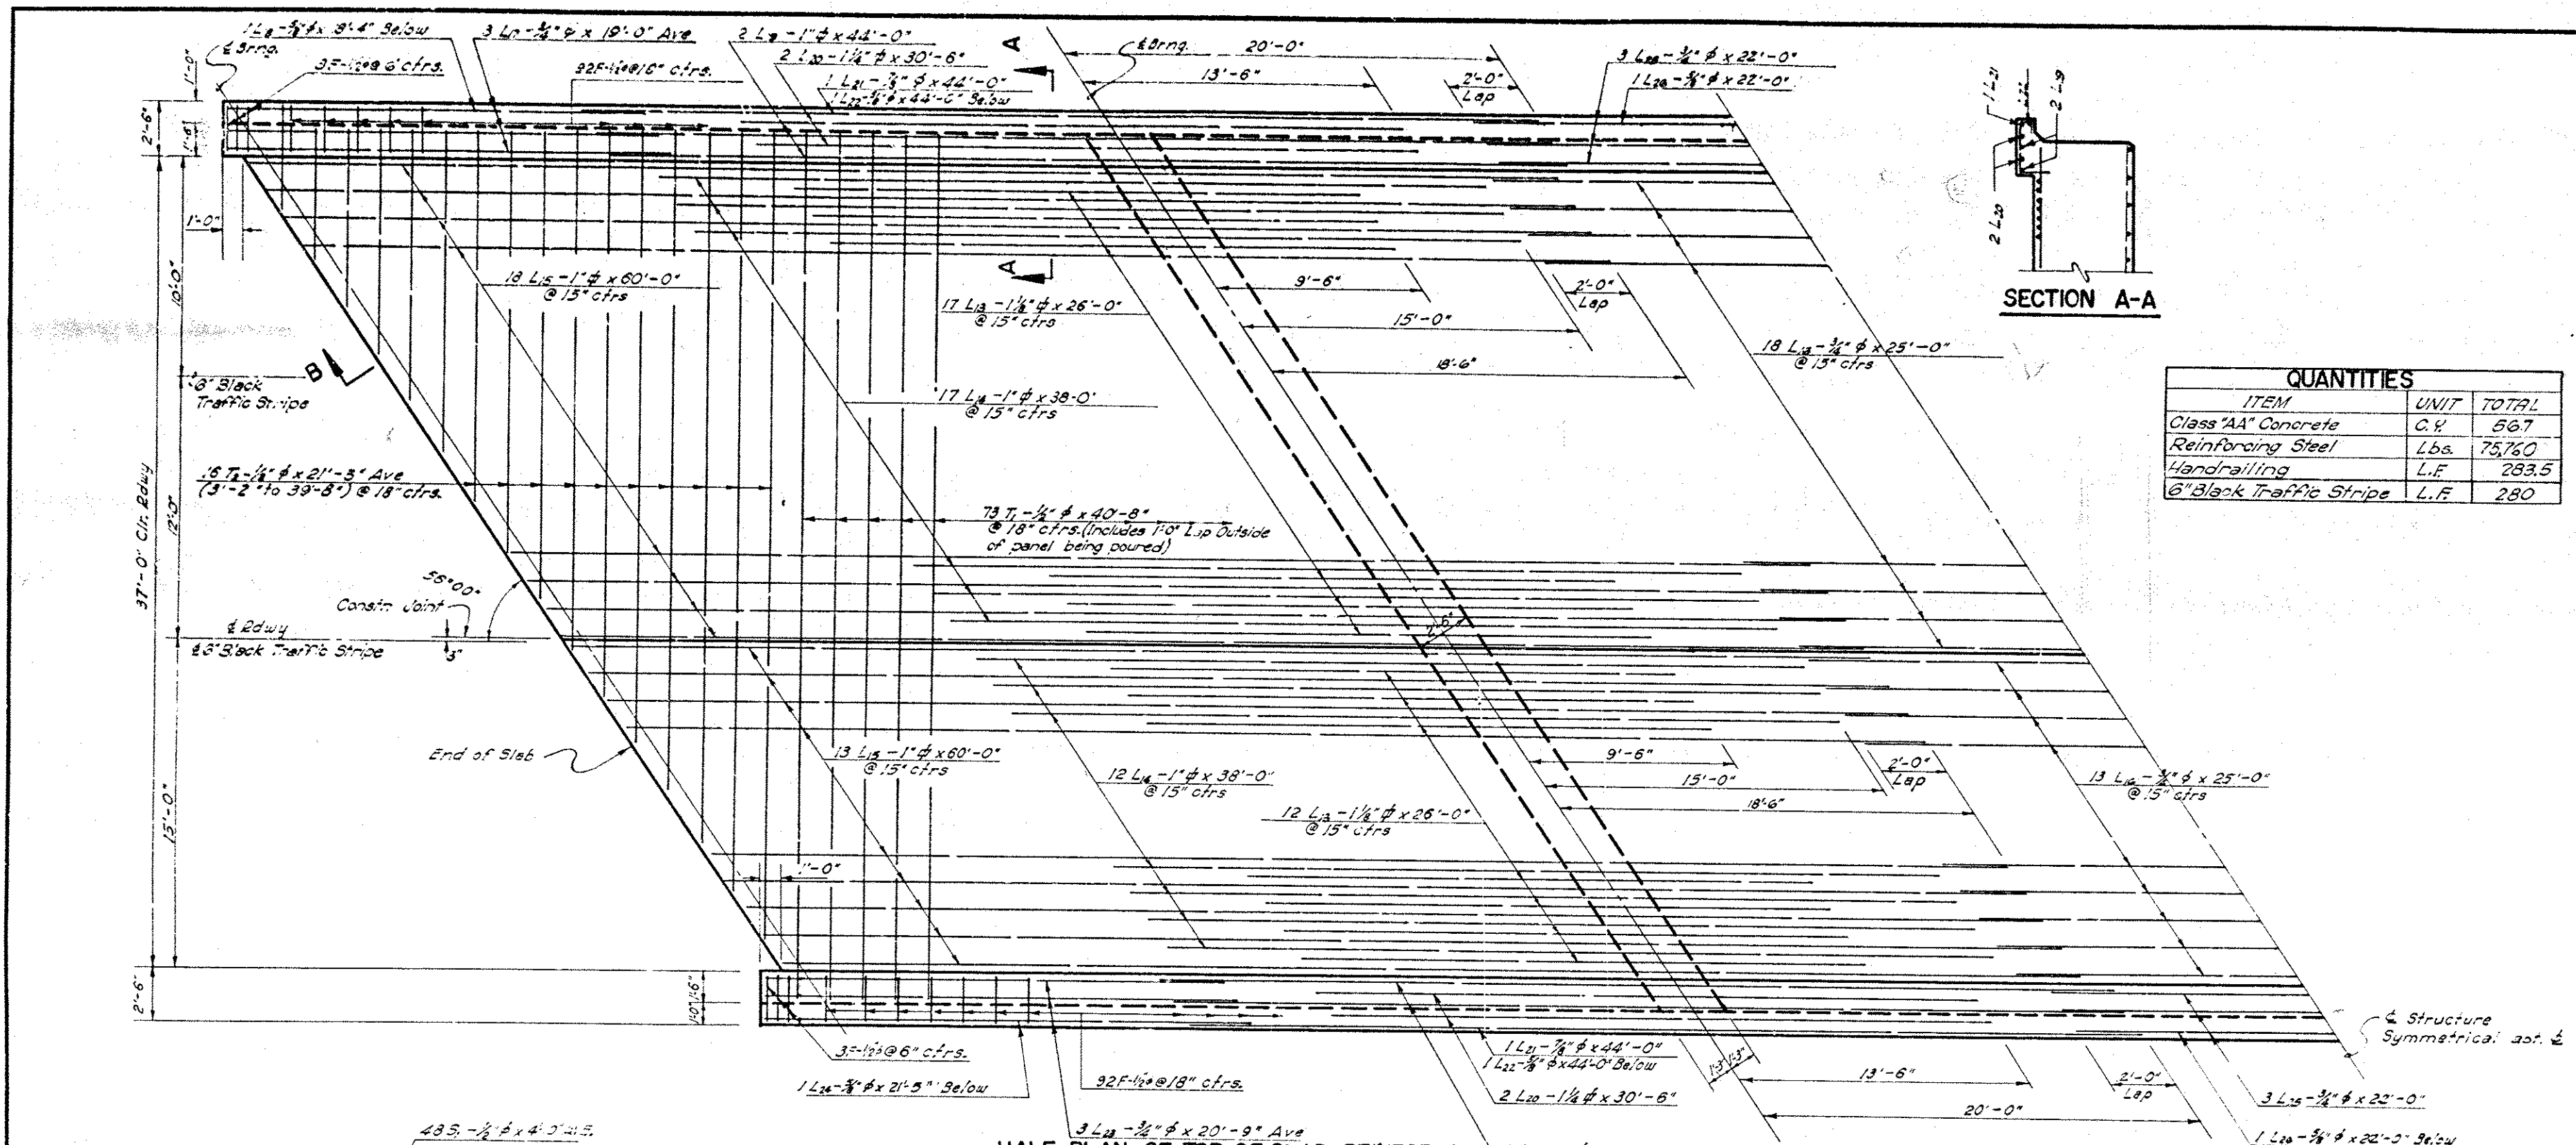

QUANTITIES		
ITEM	UNIT	TOTAL
Class AA Concrete	C.Y.	56.7
Reinforcing Steel	Lbs.	75,760
Handrailing	L.F.	283.5
6" Black Traffic Stripe	L.F.	280

Mark	No.	Size	Form	Length
L1	58	1"φ	Str.	42'-0"
L2	38	7/8"φ	"	25'-6"
L3	58	1"φ	"	22'-0"
L4	4	1"φ	"	25'-5 1/2" Ave.
L5	4	1"φ	"	41'-11" Ave.
L6	4	1"φ	"	28'-3" Ave.
L7	4	1"φ	"	43'-3" Ave.
L8	31	1 1/8"φ	"	58'-6"
L9	29	1 1/8"φ	"	37'-0"
L10	29	1 1/8"φ	"	25'-0"
L11	4	1 1/2"φ	"	34'-0"
L12	4	1"φ	"	60'-0"
L13	58	1 1/8"φ	"	28'-0"
L14	58	1"φ	"	38'-0"
L15	62	1"φ	"	60'-0"
L16	31	3/4"φ	"	25'-0"
L17	6	3/4"φ	"	19'-0" Ave.
L18	2	5/8"φ	"	18'-4"
L19	8	1"φ	"	14'-0"
L20	8	1 1/4"φ	"	30'-6"
L21	4	3/4"φ	"	44'-0"
L22	2	5/8"φ	"	14'-0"
L23	6	3/4"φ	"	20'-9 1/2" Ave.
L24	2	5/8"φ	"	21'-5"
L25	6	3/4"φ	"	22'-0"
L26	2	5/8"φ	"	22'-0"
T1	73	1 1/2"φ	"	40'-8"
T2	32	1 1/2"φ	"	3'-5" Ave.
F	196	1 1/2"φ	Str.	1'-8"
B1	42	5/8"φ	Str.	40'-9"
B2	70	5/8"φ	Str.	40'-9"
B3	40	5/8"φ	Str.	21'-7" Ave.
S1	96	1 1/2"φ	Str.	2'-0" Ave.
S2	96	1 1/2"φ	Str.	7'-2" Ave.
H	10	1"φ	Str.	17'-11"

HALF PLAN OF TOP OF SLAB REINFORCING

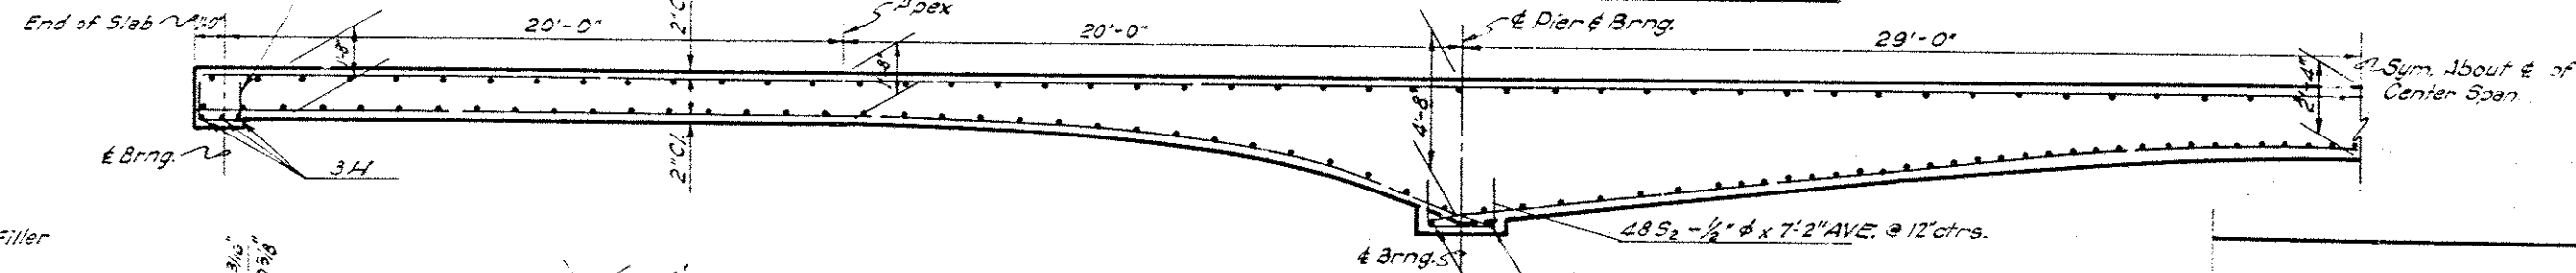

HALF LONGITUDINAL SECTION

GENERAL NOTES

Detailed plans of falsework & forms shall be submitted to the Highway Commission & be approved by the Chief Engineer before any concrete is poured. Falsework & forms must be in place for the entire depth of one unit before any concrete in that unit is poured. All forms shall be lined with an approved form lining, 1/2" ply, 1/4" Masonite, or similar material. The form lining must be full size commercial panels, & joints shall line up in so far as is practical. No scrap or odd sized pieces shall be used.

Provisions shall be made for adjustments of forms to correct any deformation which may occur during concrete operations.


Concrete mixer shall be of sufficient capacity to pour all concrete as indicated by the construction joints in one continuous pour. A standby mixer shall be provided at the bridge site for emergency use, unless transit mixed concrete is used.

No construction joints other than those shown on the plans will be permitted.


Brickwork on the underside of the deck will not be required if a smooth & uniform finish, acceptable to the Engineer, is otherwise obtained.

A standby vibrator shall be provided at the site to take the place of any working vibrator breaking down.


Reinf. in bottom of slab shall be supported on approved metal slab spacers. Steel in top of slab shall be supported on approved metal high chairs of approx. 4" ctrs.

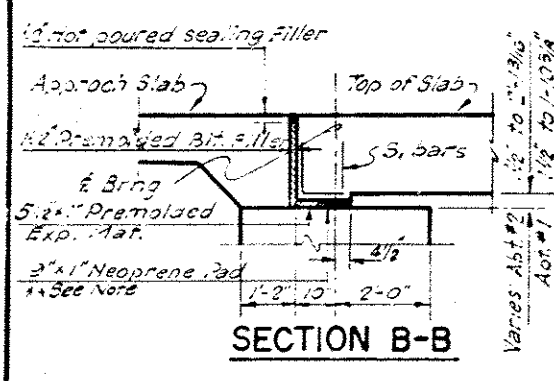

SECTION B-B

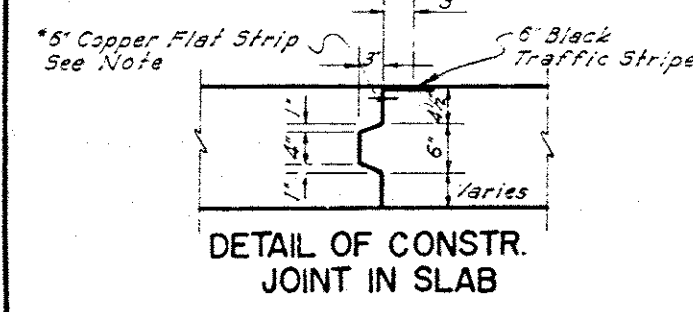


DETAIL OF CONSTR. JOINT IN SLAB

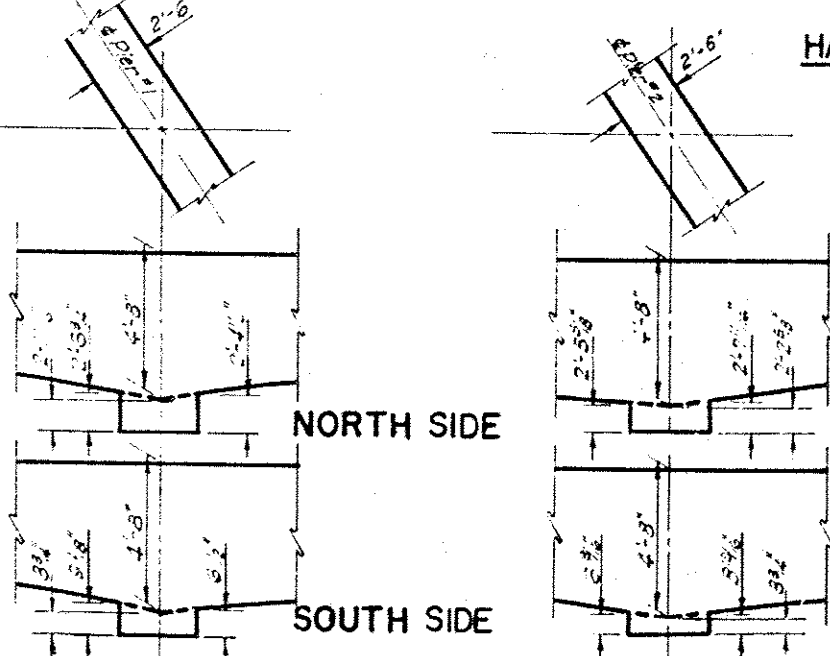


NORTH SIDE

SOUTH SIDE

DETAIL OF SLAB HAUNCHES

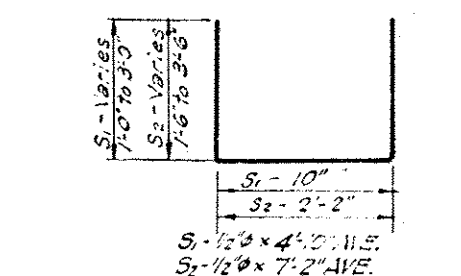

*COPPER STRIP NOTE:
A 20 oz. Copper Waterstop shall be installed full length of the Constr. joint. All cost of waterstop shall be included in the unit price bid per Cu. Yd. for Class "AA" Concrete.

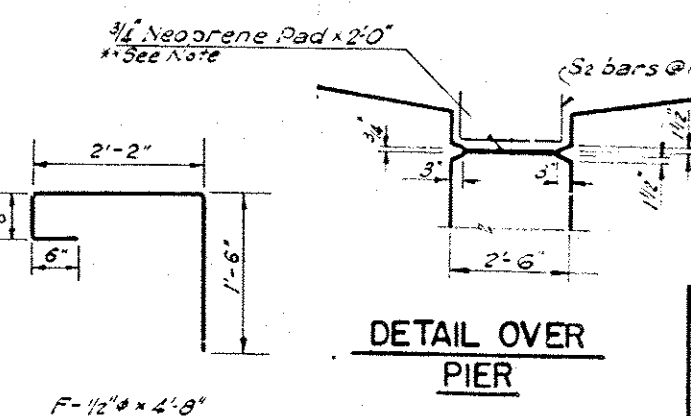

DETAIL OVER PIER



REVISIONS			RECORD		
NO.	DESCRIPTION	BY	DATE	ITEM	BY
1	Rev. 5/2/57	S	5-2-57	DESIGN	
				DETAIL	
				TRACED	10/5
				CHECKED	2/2/57
				APPROVED	
				SQUAD	3/2/57

OKLAHOMA STATE HIGHWAY COMMISSION	
OKLAHOMA CITY, OKLAHOMA	
STR. NO. 1	
DETAILS OF SUPERSTRUCTURE	
ON & SURVEY 34+25.30	
FA. PROJ. I-381(16)PT-1	


[illegible][illegible]

GENERAL NOTE:
Refer to Identical General Note
on Index Sheet No. 23

REVISIONS			RECORD		OKLAHOMA STATE HIGHWAY COMMISSION OKLAHOMA CITY, OKLAHOMA
NO.	DESCRIPTION	BY DATE	ITEM	BY DATE	
			DESIGN		STR. NO. 1 DETAILS OF SUPERSTRUCTURE @ STA ON @ SURVEY 34 + 25.30 F.A. PROJ. I-381 (16)PT.-
			DETAIL		
			TRACED	KDS	
			CHECKED	222/10/57	
			APPROVED		
			SQUAD:	30 MAY	

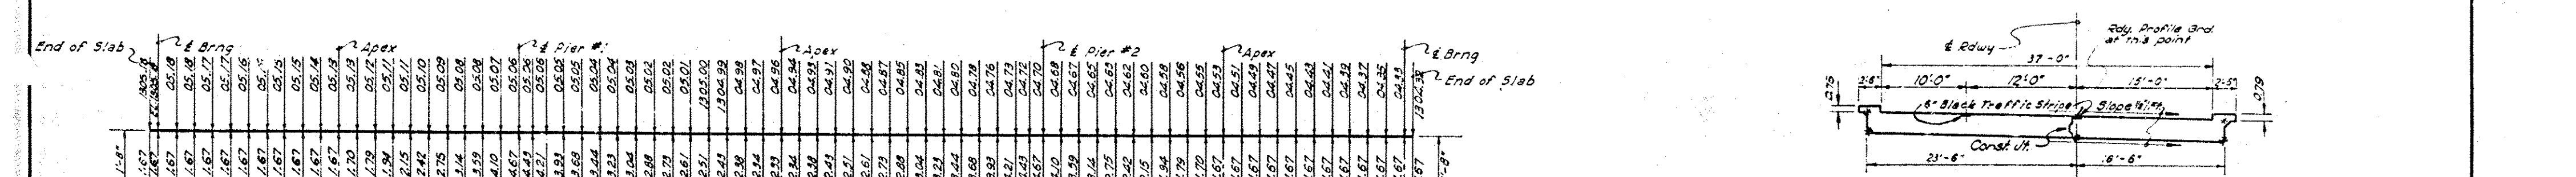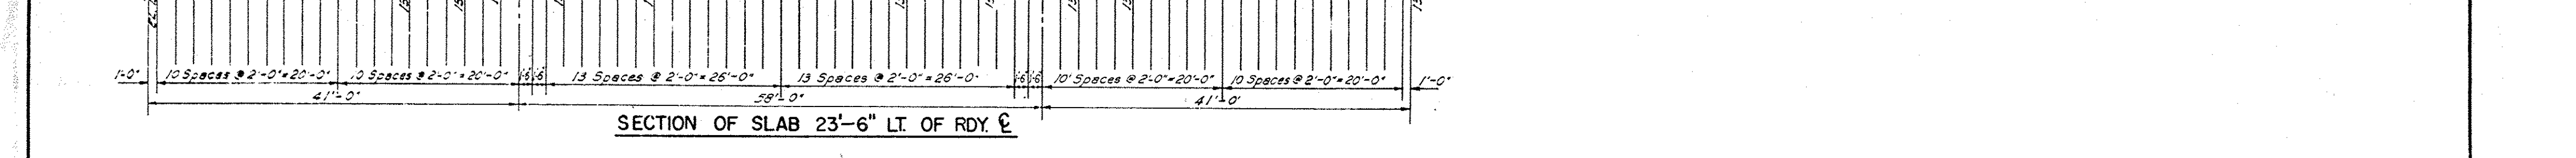


* Points of Elevation
Note: For Top of Curb Elev add 0.75' to top of Slab Elev at High side curb.
add 0.75' " " Low "
Note: Elevations & dimensions shown above are for forming
Sufficient top of bridge floor. Anticipated deflections
due to dead load have been considered & no other allowance
for these deflections shall be made.

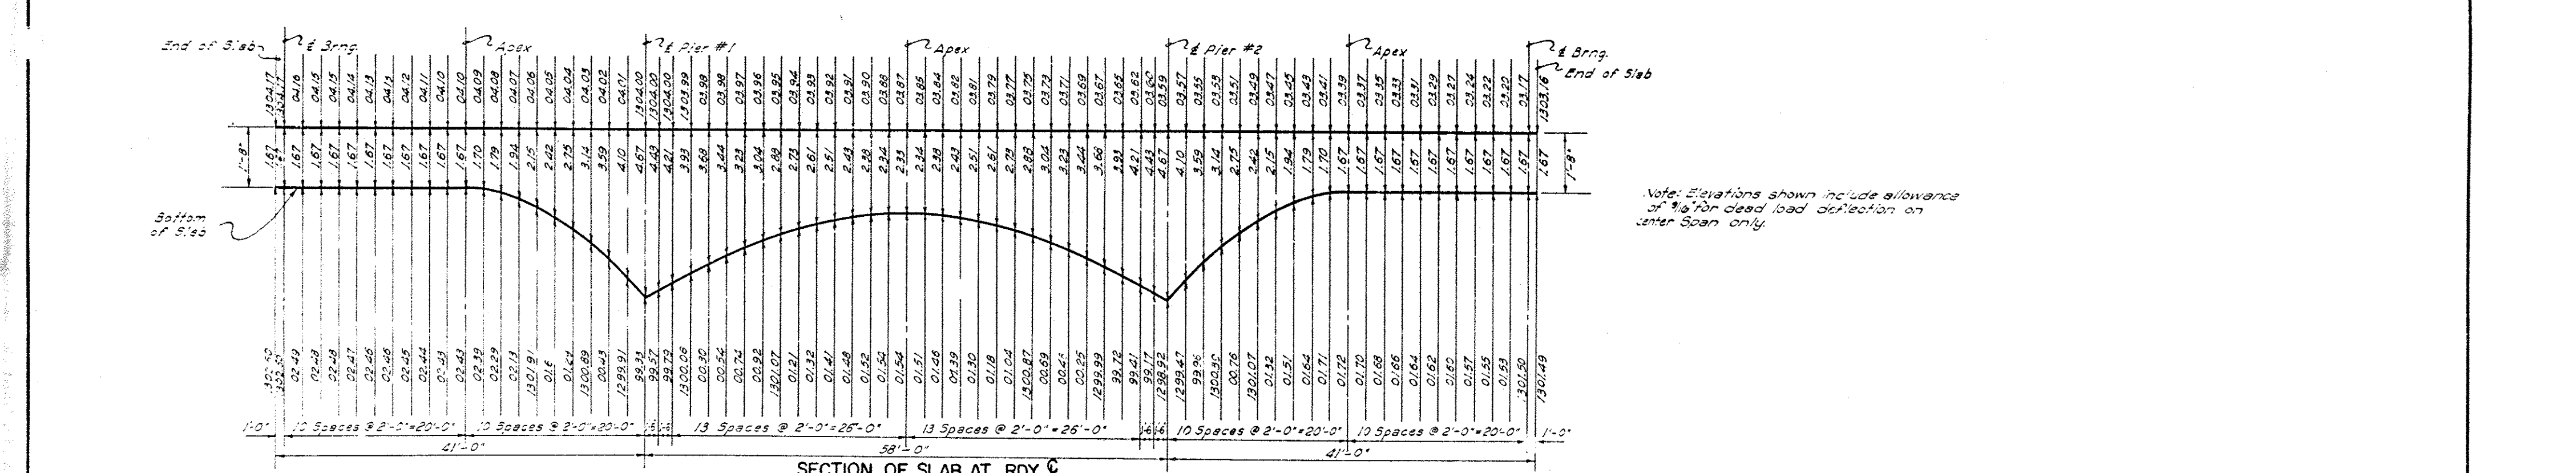

Bottom of Sill

Note: Elevations shown include allowance of $\frac{1}{16}$ " for dead load deflection on center span only.

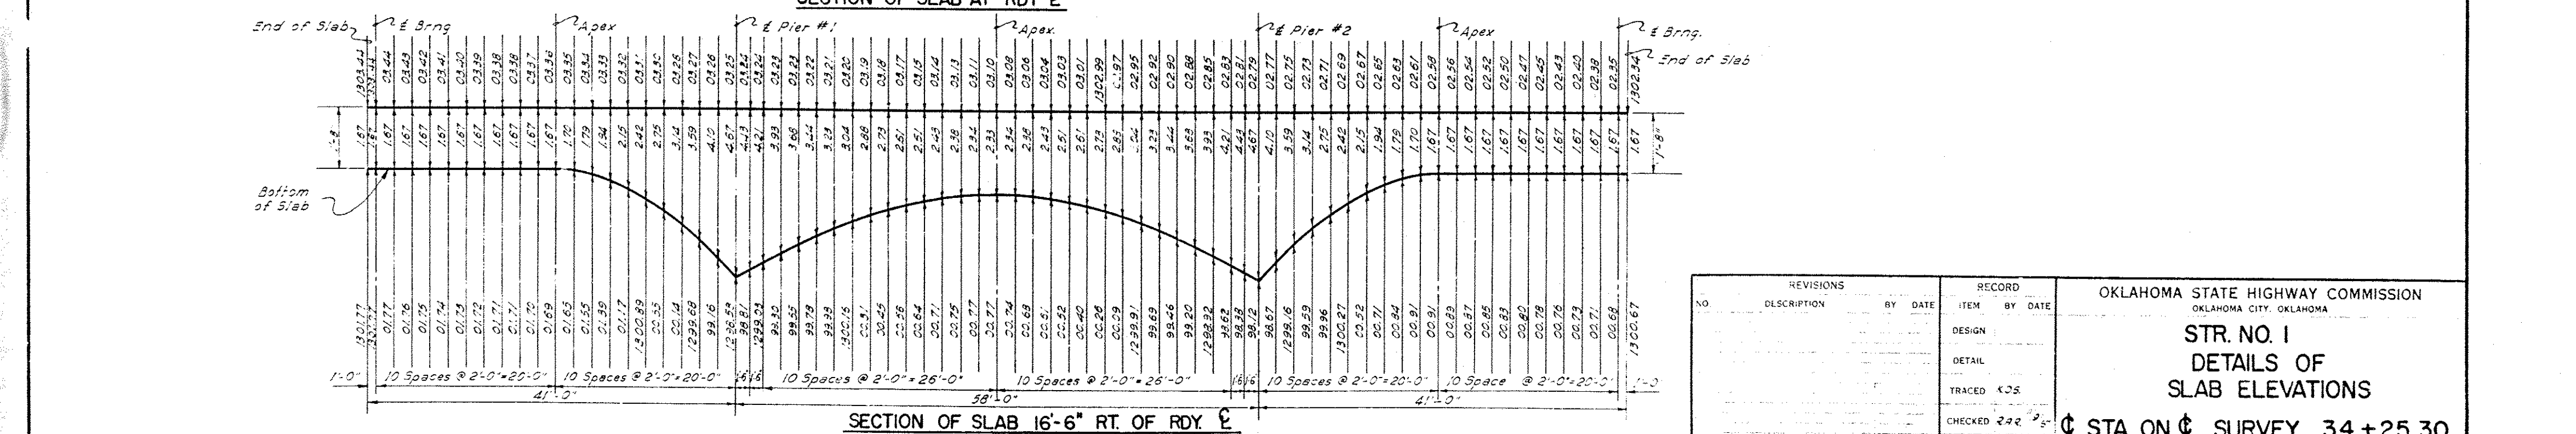[illegible]

DESIGN DATA

LL: H20-S6; FPM 20-4
Concrete 12000 psi
Reinforcing Steel 18000 psi
Foundation Load 3750
Piers: Direct Load 3750

SUMMARY OF QUANTITIES

ITEM No.	ITEM	UNIT	Abuts	Piers	Support Bridge	Rdy.
202.00	Class "D" Excavation	C.Y.				200
308.00	4" Sand Cushion	S.Y.				180.8
414.00	Approach Slabs	S.Y.				180.2
501.00	Substr. Excav. - Common	C.Y.	180		180	
521.00	Substr. Excav. - Rock	C.Y.		104	104	
525.00	Steel Handrailing	L.F.		271.5	271.5	
509.00	Class "A" Concrete	C.Y.	570	63.4	23.4	1.2
509.00	Class "A" Conc. in Pier Bases	C.Y.		40	40	
509.00	Class "A" Concrete	C.Y.			376.1	
511.00	Reinforcing Steel	Lbs.	7800	4980	8940	60
53.00	5" C.G.M. Pipe	L.F.			84	
540.00	6" R.C. Piling	L.F.	308		308	
510.00	Inlet Frame & Grate	Sq.			2	
542.00	6" Black Traffic Stripe	L.F.		272	272	30
500.00	Special 4" Concrete Slope Wall	S.Y.			320.8	
500.00	Special 4" Concrete Handrailing	L.F.		271.5	271.5	

* Non-Permeating Item

GENERAL NOTES

Plan showing elevations shall be in accordance with the Oklahoma Standard Specifications of 1951 & Special Provisions.

All construction & materials shall be in accordance with the Oklahoma Standard Specifications of 1951 & Special Provisions.

All exposed concrete surfaces shall have a Carborundum Finish.

All reinforcing steel bars shall conform to A.S.T.M. Specifications A-305-49.

Piling shall be driven using leads of sufficient strength to control piles.

Piling shall be driven to practical refusal if above grade or to a minimum bearing of 50 tons if at or below grade.

All Piling shall be driven through the compacted fill 12" Pilot holes shall be drilled to Elev. 1287.00 @ Abut. No. 1 and Abut. No. 2. Then 8" Pilot holes to Elev. 1285.00 @ Abut. No. 1 and Abut. No. 2. All cost of Pilot holes shall be included in the unit price bid for 16" R.C. Piling.

Contractor shall submit bids on both types of handrailing. Type of rail used will be determined by bids received.

RECORD	OKLAHOMA STATE HIGHWAY COMMISSION
ITEM	BY DATE
DESIGN	
DETAIL	
TRACED	
CHECKED	
APPRD	
SQUAD	38144M

OKLAHOMA CITY, OKLA.
STR. No. 2
GENERAL ELEV., PLAN &
SUMMARY OF QUANTITIES
36'-62.5'-36' CONC. SLAB SPANS
37' RDY. & 2-18" S.C.'s
CL STA. ON CL SURVEY 52+83.53
FA. PROJ. I- 381 (16) PT-1

PLAN

Scale: 1" = 10'

GENERAL ELEVATION

Scale: 1" = 10'

VERTICAL CURVE DATA

B.M. R.R. Spike in Telephone Pole 130 Rt.
Sta. 52+27 Elev. 1281.57
B.M. - R.R. Spike in Tel. Pole 33 Rt.
Sta. 55+81 Elev. 1280.09

SPECIAL PROVISIONS


See Special Provisions Included in the Proposal for Curing Compd. with Membrane Curing Compound for Bridge Structures including Parapet walls, Retaining walls & Fencing 414-6(a) Rev. 7-27-55.

Equipment for Driving Piles 512-1(a) Reinforcing Steel (Ave Steel) 723-1(a) Rev. 2-21-57
Back Traffic Stripe on Black Traffic Stripe of Thruway 504-1(a) Rev. 10-9-55
Leads for Driving Piles




NO.	DESCRIPTION	BY	DATE
1	As per 504-1(a)	SPS	12/22/55
2			
3			
4			
5			
6			
7			
8			
9			
10			

REFERENCE LIST & INDEX

DETAILS OF ABUTMENTS 5-2277.21
DETAILS OF PIERS 5-2277.31
DETAILS OF SUPERST. 5-2277.35
DETAILS OF SLAB ELEV. 5-2277.39
DETAILS OF 10" SLABS 5-2277.43
DETAILS OF HANDR. LING. 5-2277.47
DETAILS OF PILING 5-2277.51



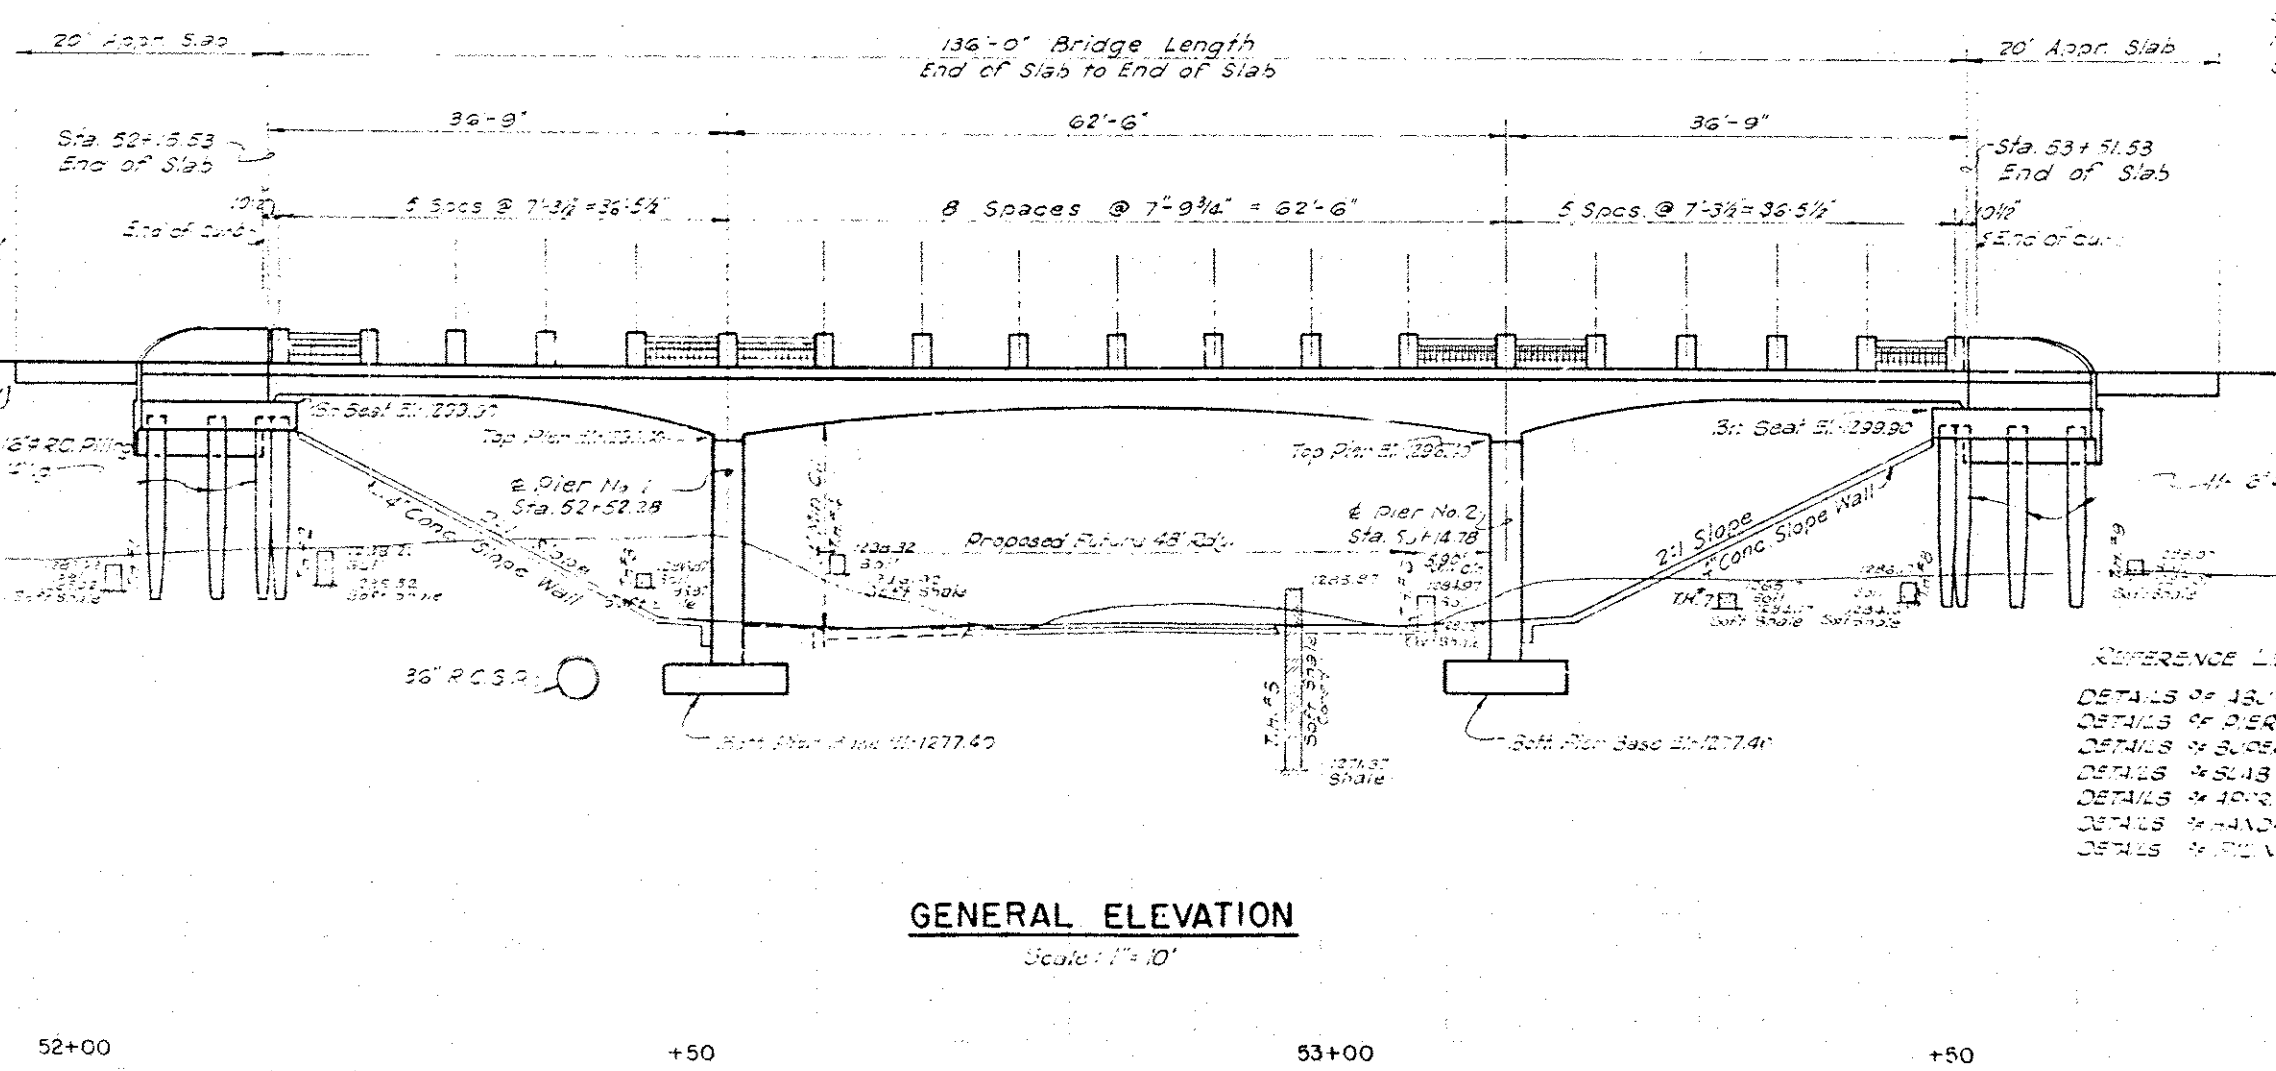


SEC. ROAD DIST. NO.	STATE	PROJ. NO.	SHEET NO.	TOTAL SHEETS
5	OKLA.	1-381(16)PT-1	34	88

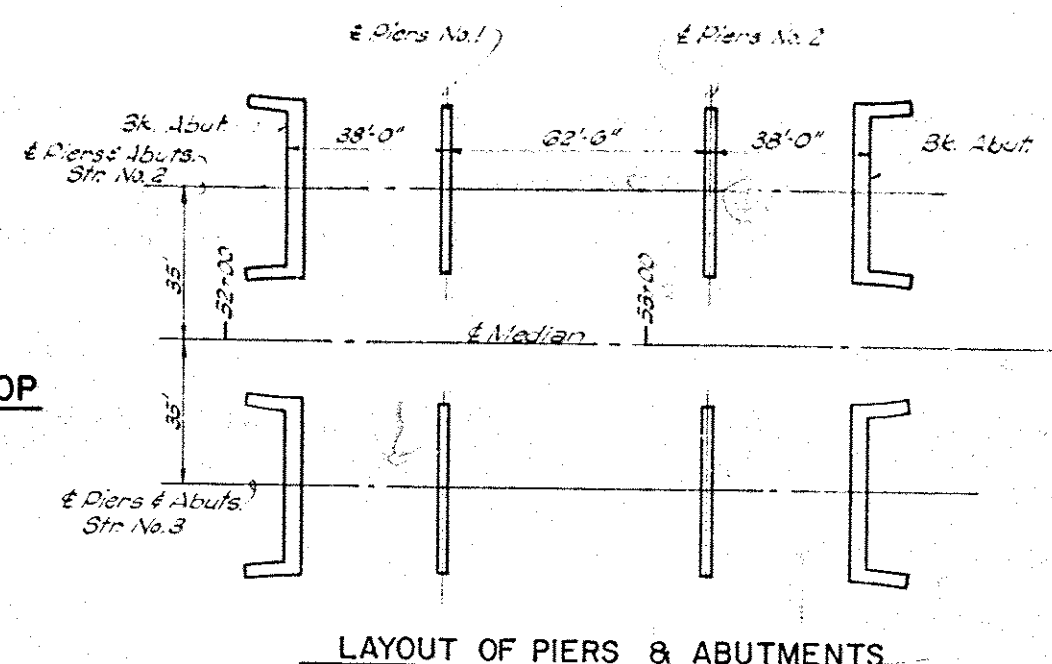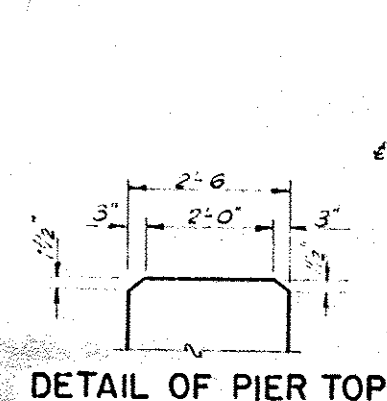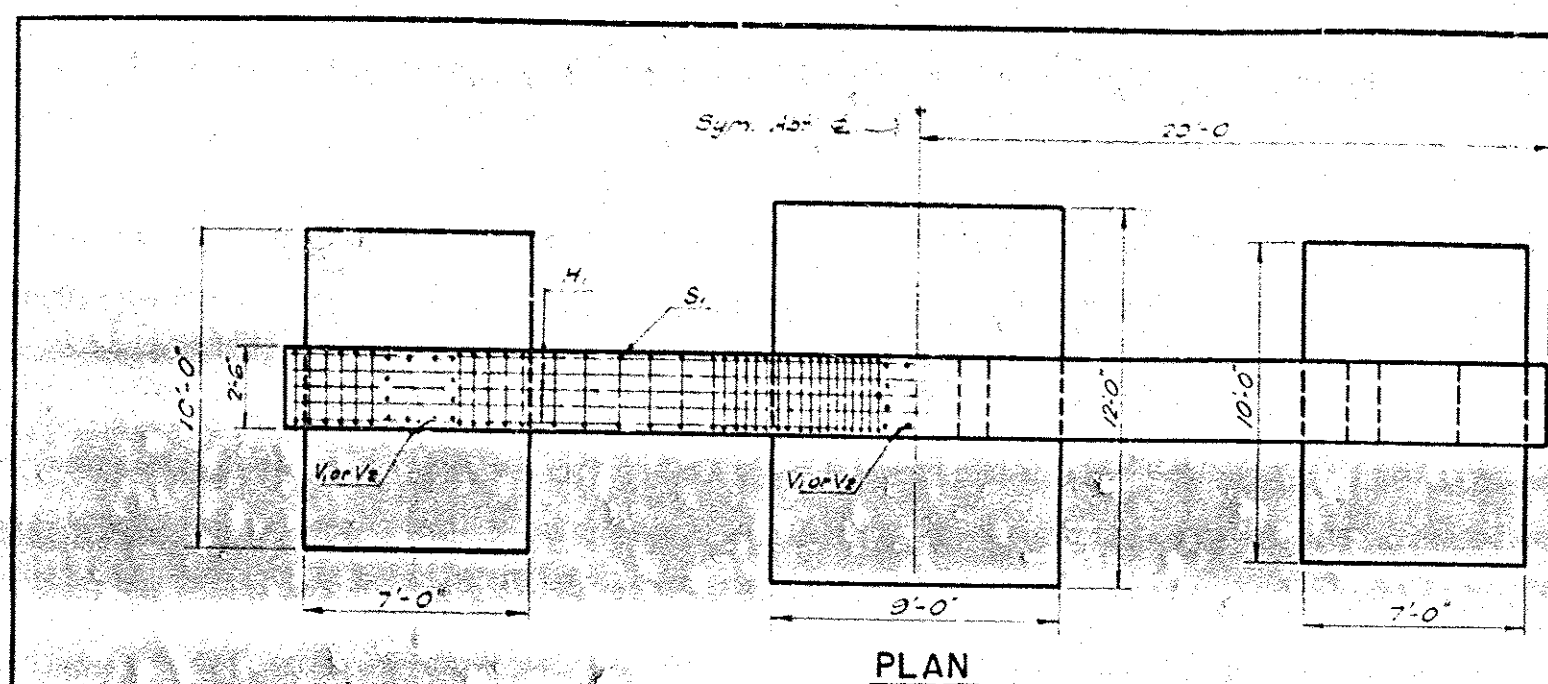

Mark	No.	Size	Form	Length
H ₁	5	1"φ	Bnt	42'-2"
H ₂	5	1"φ	Str	13'-0"
H ₃	2	1"φ	Str	33'-6"
H ₄	4	1"φ	Str	33'-6"
H ₅	4	1"φ	Str	39'-0"
BH ₁	16	1/2"φ	Bnt	4'-0"
BH ₂	8	1/2"φ	Bnt	6'-0"
WH ₁	4	1/2"φ	Str	31'-3"
WH ₂	6	3/4"φ	Str	32'-0"
WH ₃	18	1/2"φ	Bnt	12'-5"
S ₁	56	5/8"φ	Bnt	12'-6"
S ₂	12	1/2"φ	Bnt	11'-3"
D	36	1"φ	Str	5'-0"
F	22	3/4"φ	Str	6'-0"
F ₂	28	1/2"φ	Str	9'-0"
F ₃	18	1/2"φ	Str	8'-0"
F ₄	21	1"φ	Str	11'-6"

Str. # 2	Str. # 3				
V			36	1"φ	Str. 15'-0"
	1/2		36	1"φ	Str. 19'-10"
W			36	1/2"φ	Bnt. 5'-9"
	1/2		48	1/2"φ	Bnt. 3'-9"

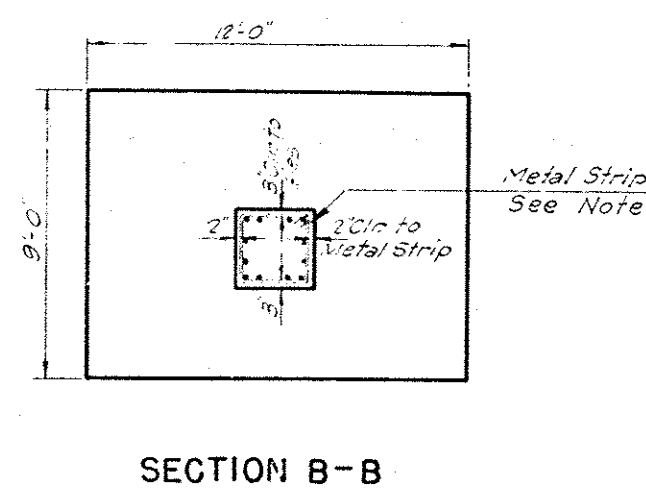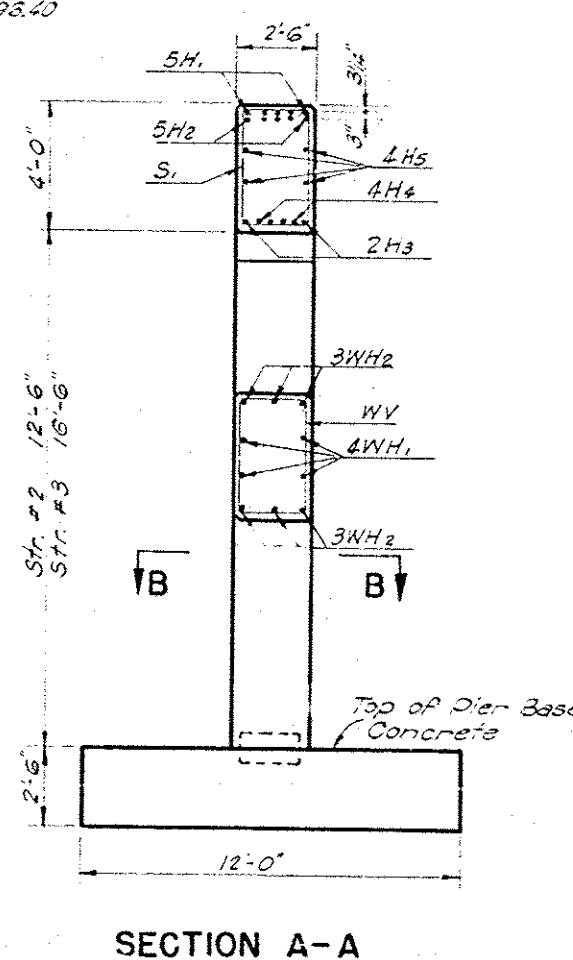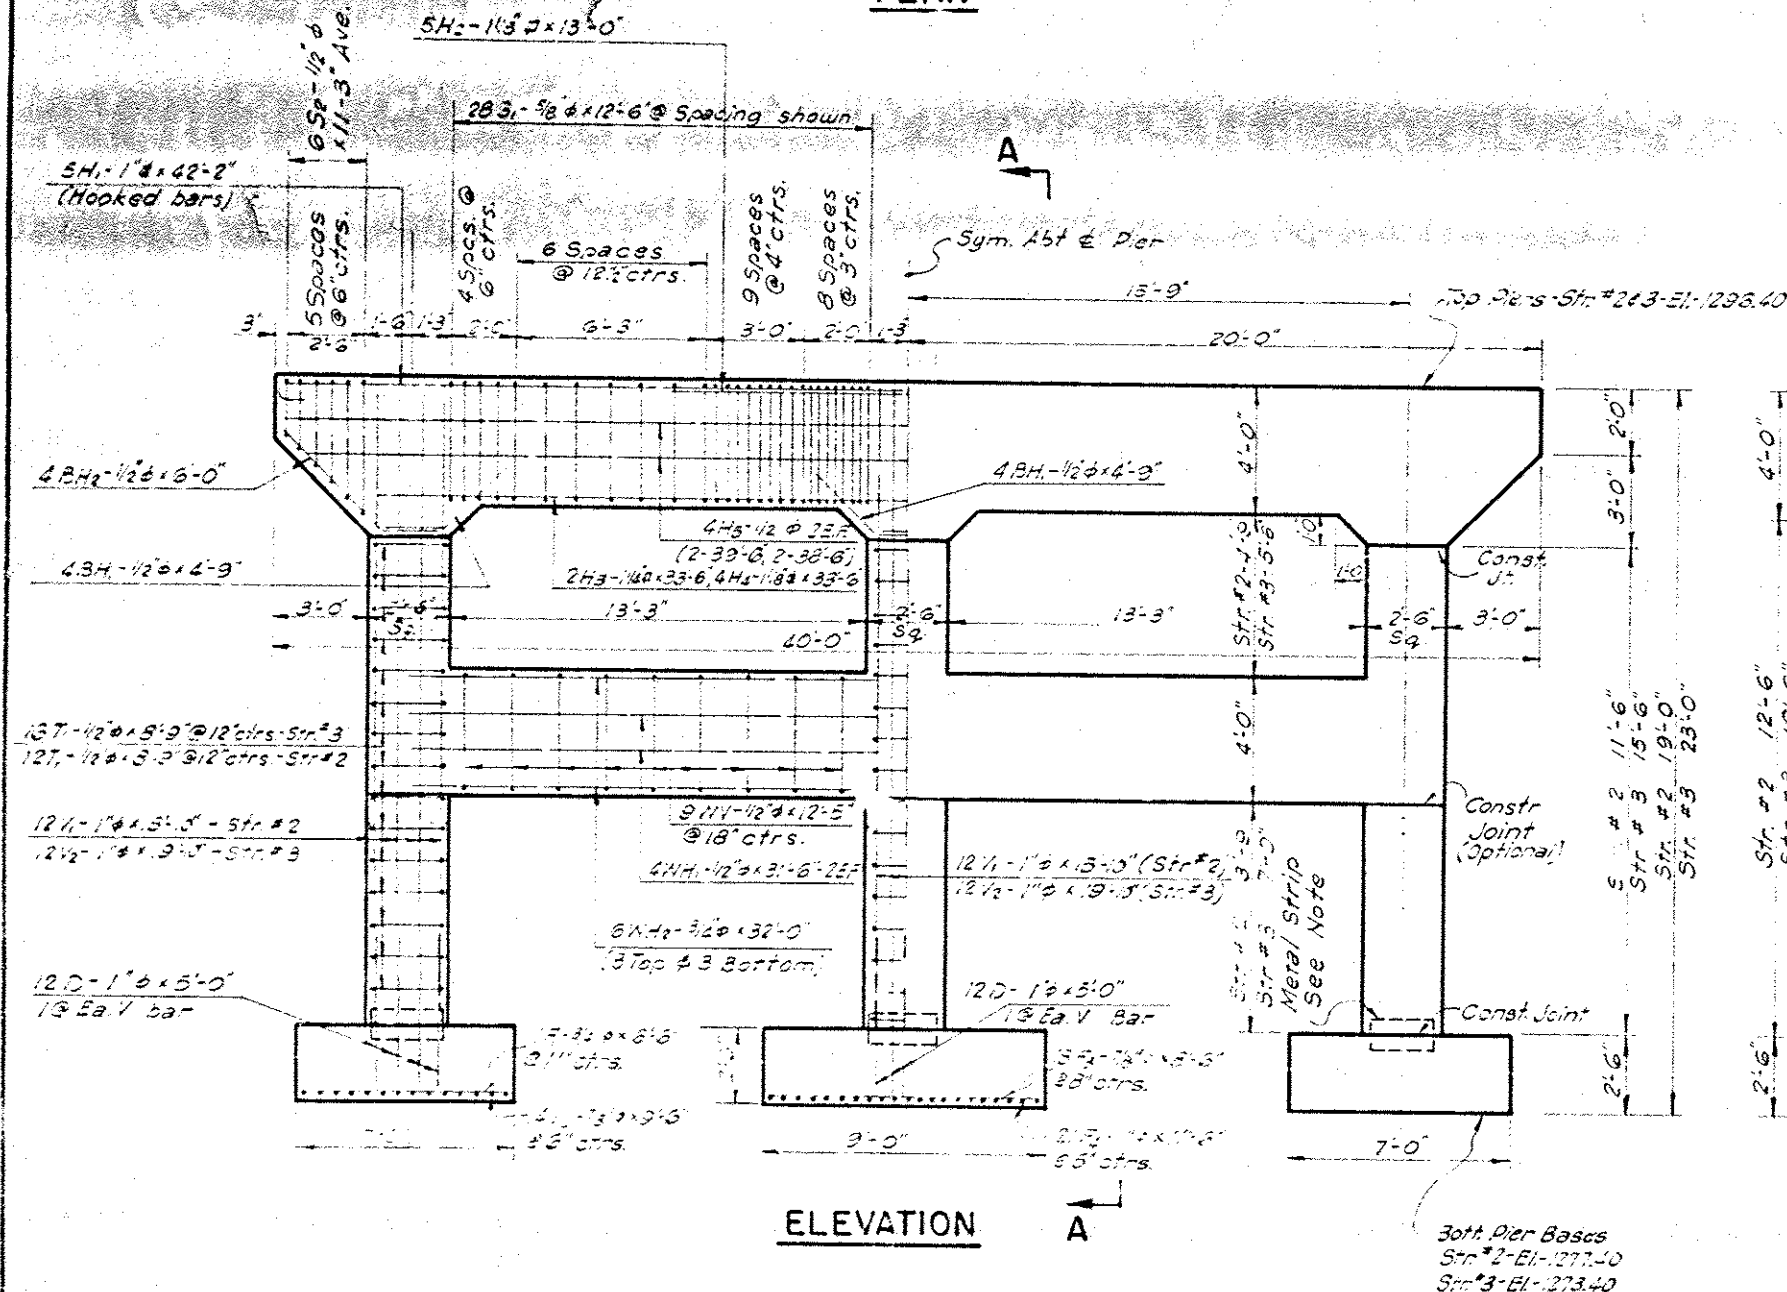


NOTES:
 All reinforcing steel bars shall conform to ASTM specifications A-305-49.
 All exposed edges shall have a 1/2" chamfer unless otherwise noted.
 All concrete shall be poured dry.
 NOTE: METAL STRIP & PIER BASE CONCRETE
 Refer to identical notes on Detail of Piers, Deck Sheet #20.


QUANTITIES-ONE PIER					
ITEM	UNIT	Str. No. 2	Str. No. 3	Str. No. 4	Str. No. 5
Reinforcing Steel	lbs.	7,400	7,400	7,400	7,400
Class A Concrete	C.Y.	33.0	33.0	33.0	33.0
Class A Concrete Pier Bases	C.Y.	23.0	23.0	23.0	23.0
Substr. Excav. - Common	C.Y.	0	0	0	0
Substr. Excav. - Rock	C.Y.	52	52	52	52

RECORD		OKLAHOMA STATE HIGHWAY COMMISSION OKLAHOMA CITY, OKLAHOMA	
DATE	BY	STR. NO. 2 & NO. 3 DETAILS OF PIERS	
DESIGN	DATE	@ STA. ON @ SURVEY 52+83.53	
TRACED	DATE	FA. PROJ. 1-381 (16) PT-1	
CHECKED	DATE		
APPROVED	DATE		
SOUND	DATE		


FED. ROAD DIST. NO.	STATE	PROJECT NO.	SHEET NO.	TOTAL SHEETS
6	OKLA.	I-381(16)PT-1	36	88

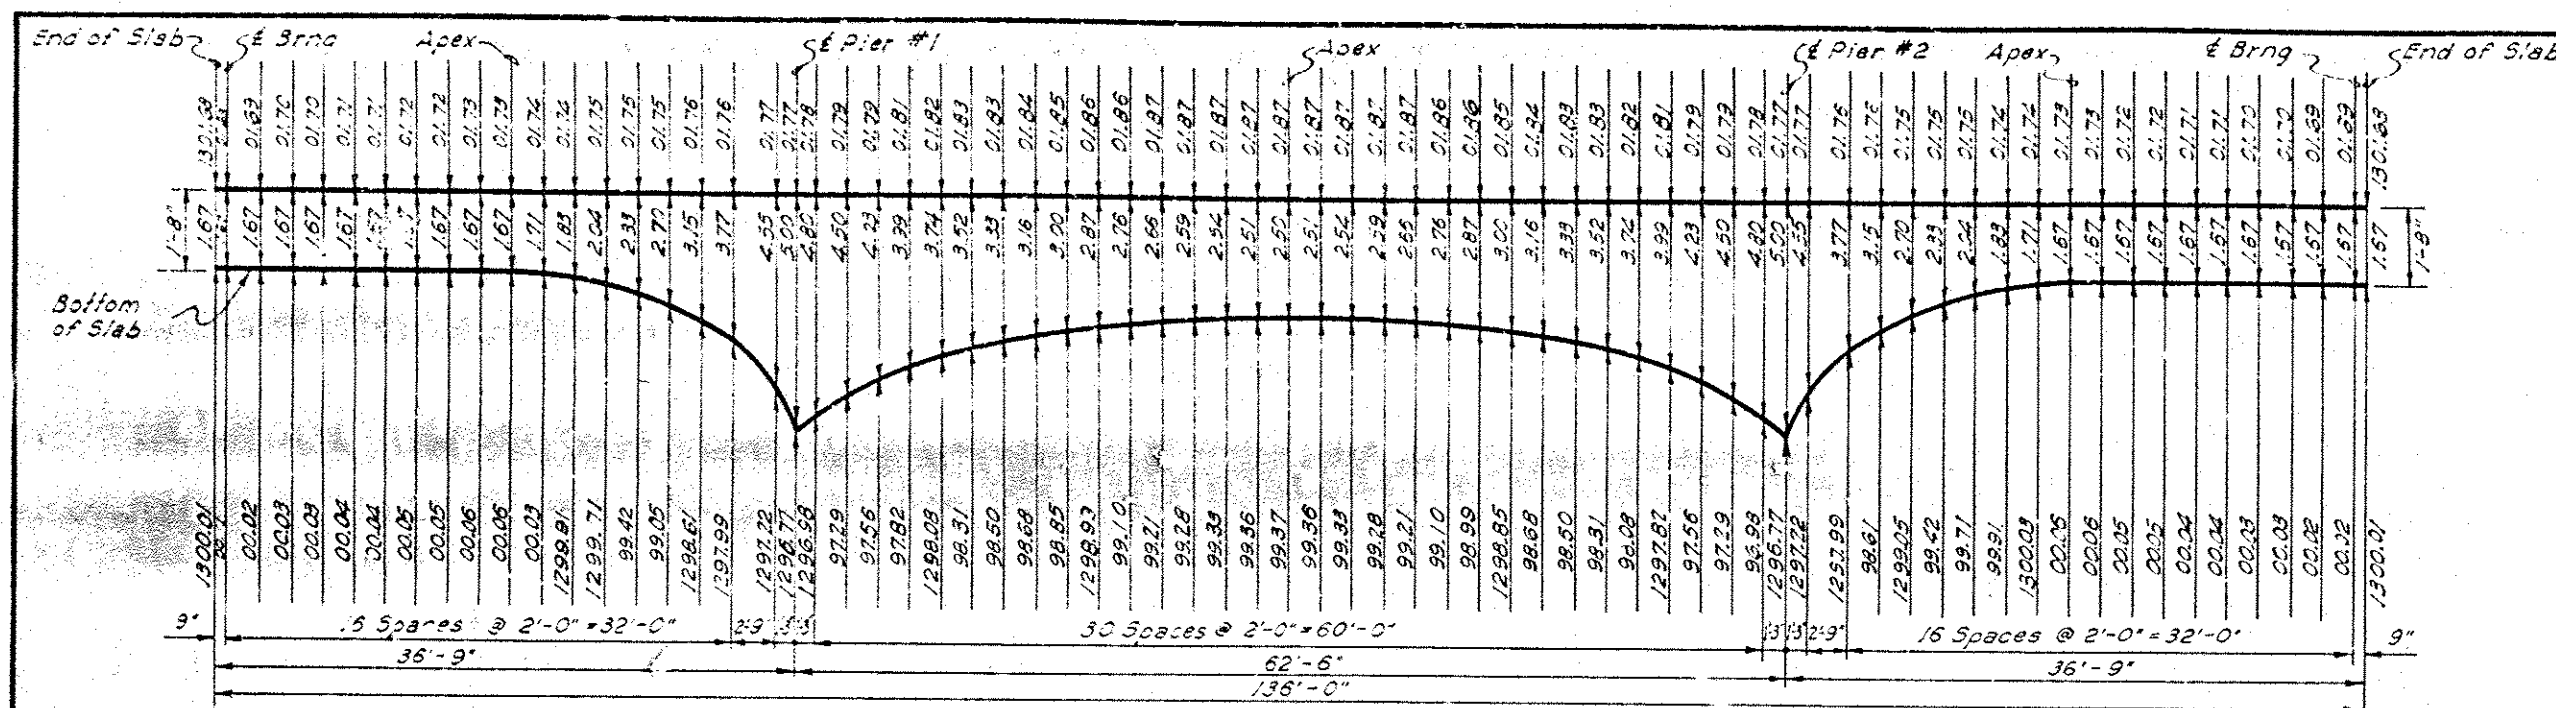


PROFILE OF SLAB 55.0' RT & LT. ∇ SURVEY

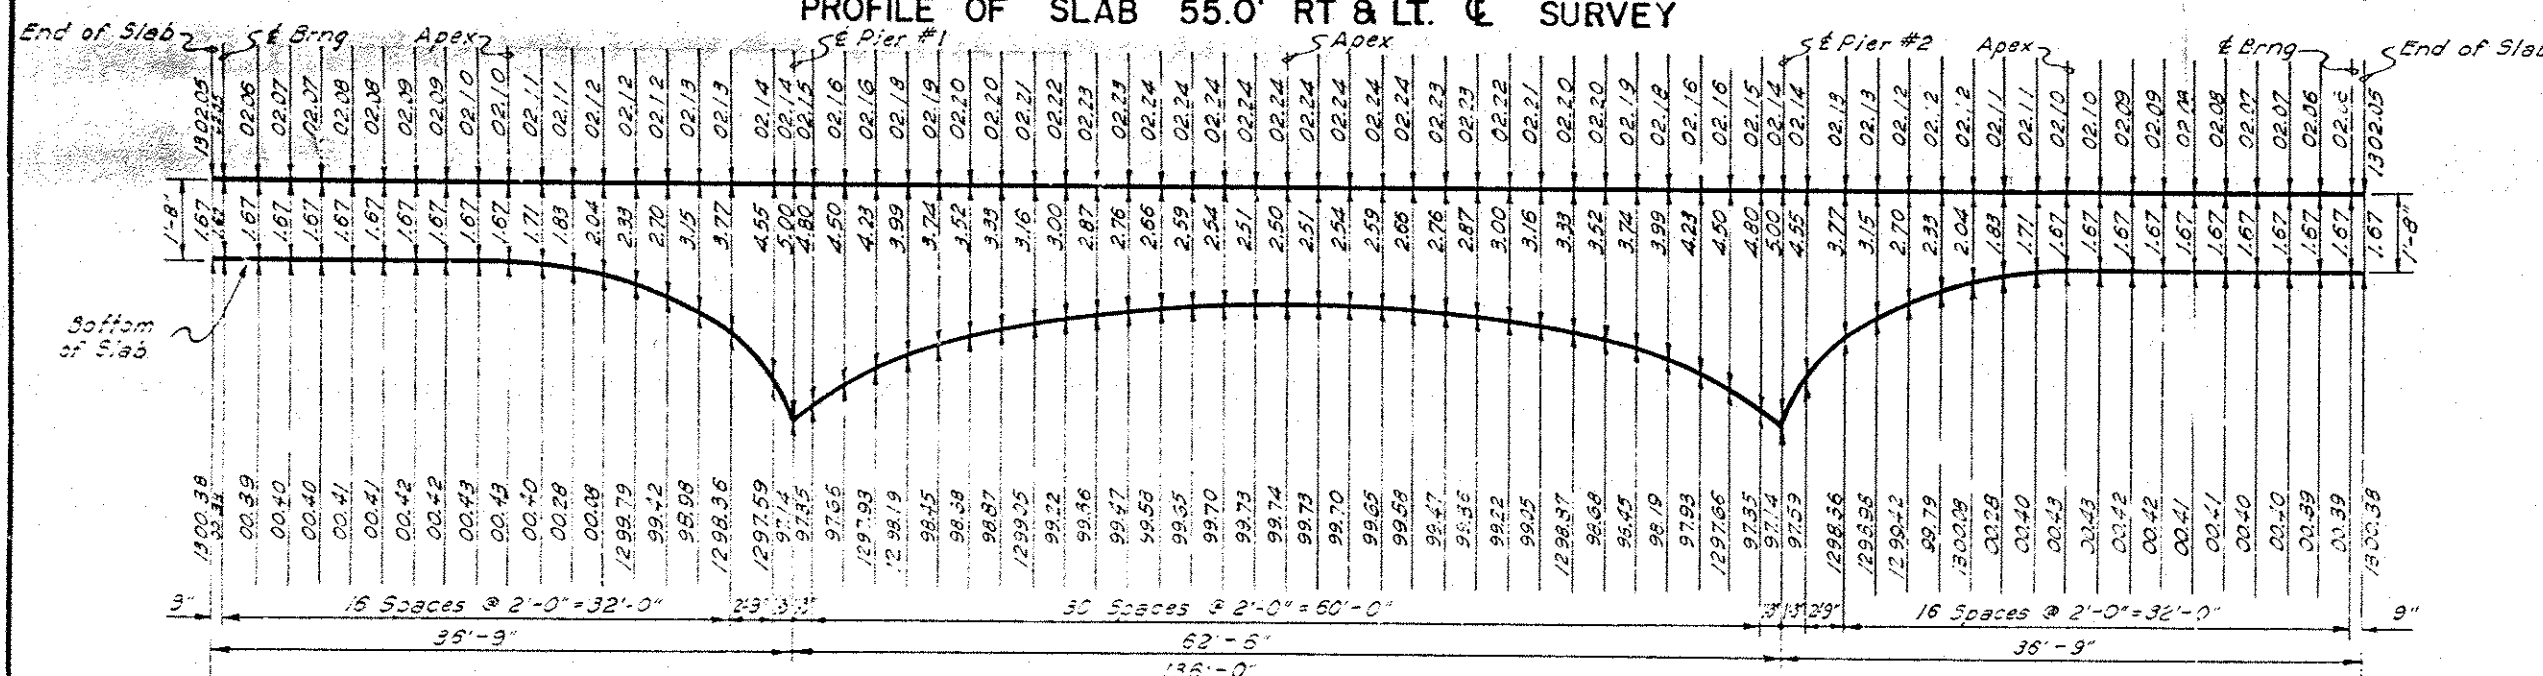

PROFILE OF SLAB 31.5' RT. & LT. ∇ SURVEY

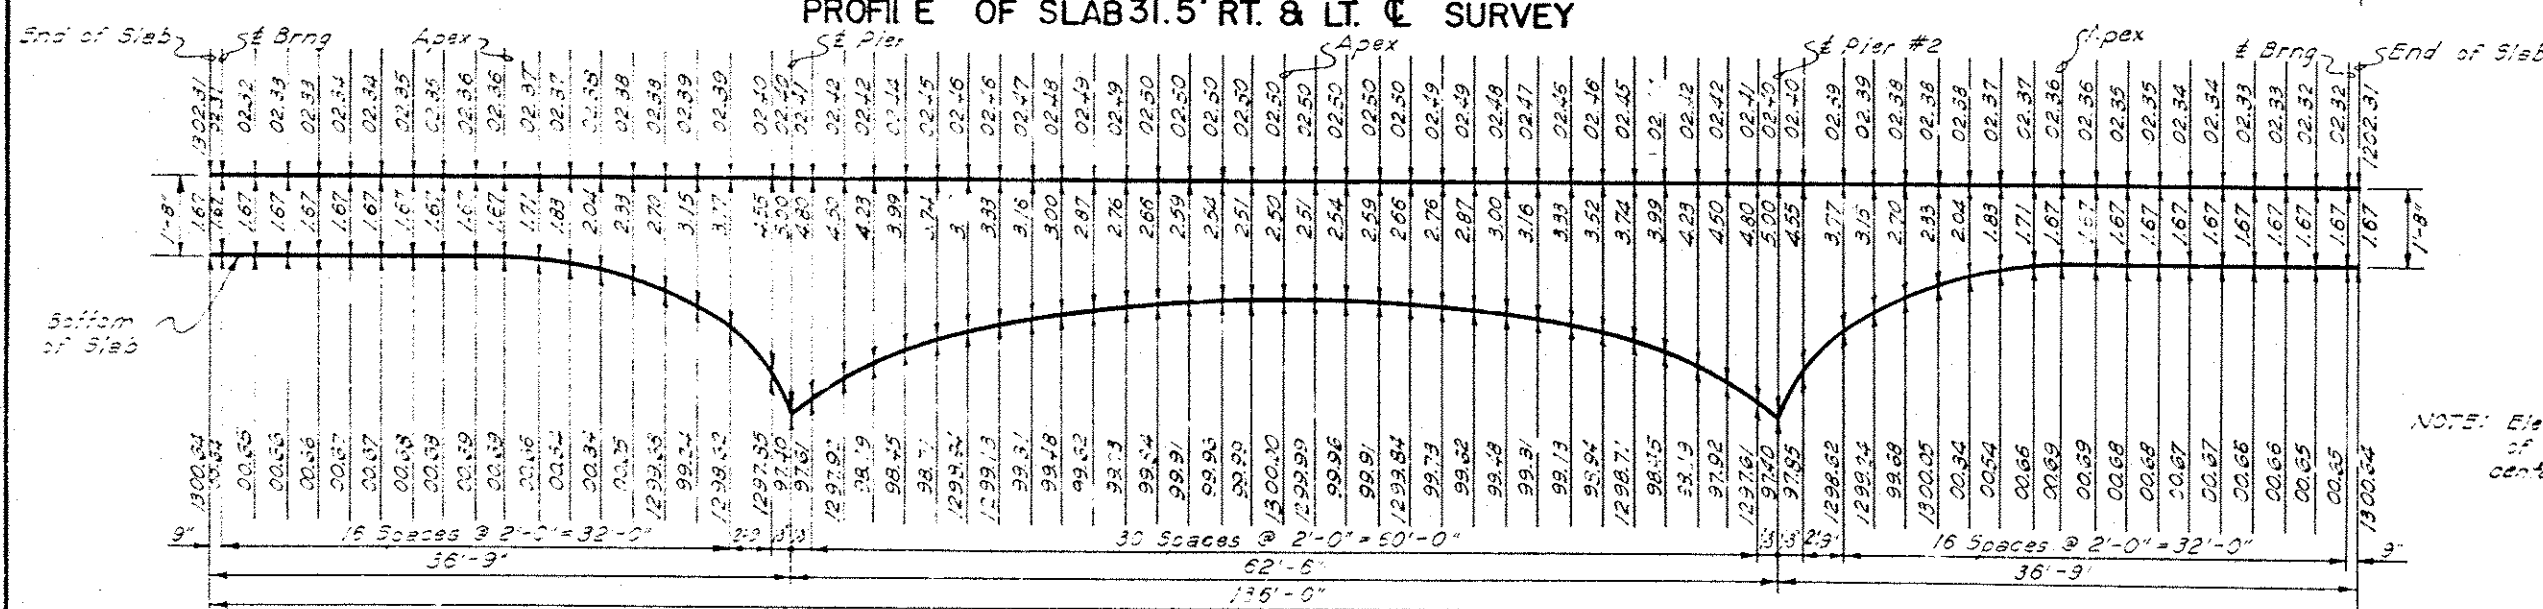

PROFILE OF SLAB 15.0' RT & LT. ∇ SURVEY

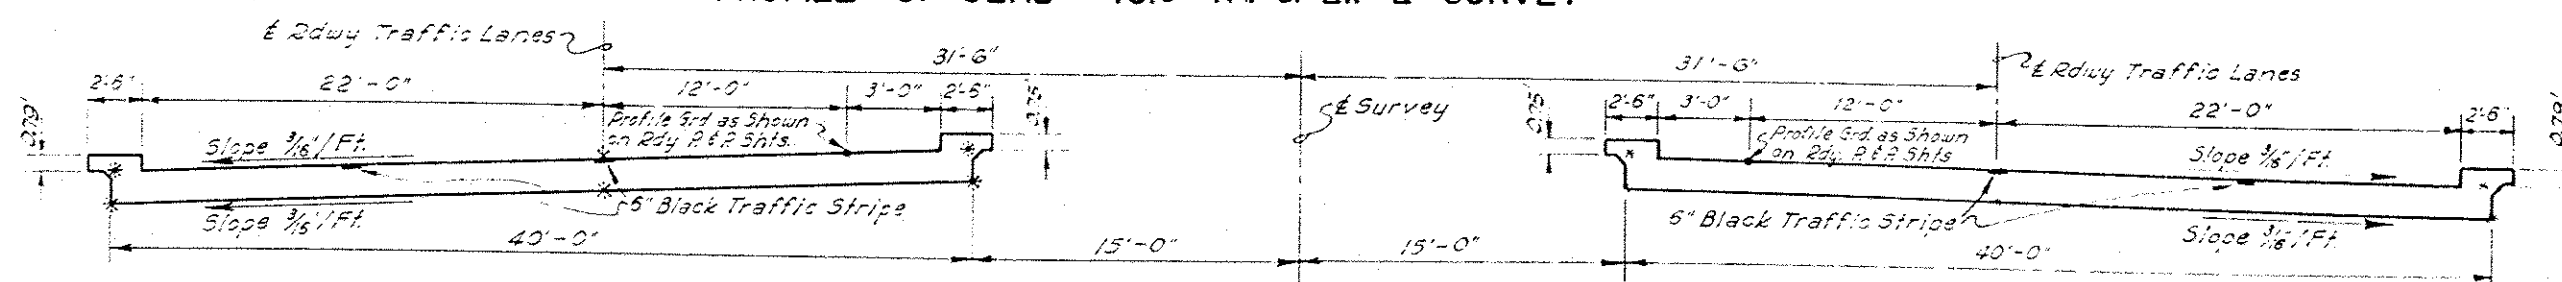

* Points of Elevation

NOTE: For top of Curb Elevation add 0.75' to top of Slab Elevation, at Median Curb, and 0.79' " Outside

NOTE: Elevations & Dimensions shown above are for forming Soffit Curves & top of Bridge Floor. Anticipated deflections due to dead load have been considered & no other allowance for these deflections shall be made.

NOTE: Elevations shown include allowance of 1" for dead load deflection on center-span only.

REVISIONS			RECORD		OKLAHOMA STATE HIGHWAY COMMISSION	
NO.	DESCRIPTION	BY DATE	ITEM	BY DATE	OKLAHOMA CITY, OKLAHOMA	
			DESIGN		STRUCTURES NO. 2 & 3	
			DETAIL		DETAILS OF SLAB	
			TRACED	4-25	ELEVATIONS	
			CHECKED	2-22-55	∇ STA ON ∇ SURVEY 52+83.53	
			APPROVED		F.A. PROJ. I-381(16)PT-1	
			SQUAD	52-4M		

DESIGN DATA

LL: H20-S16-S3; AD11.10-4
Concrete 10,000 psi
Reinforcing Steel 60,000 psi
Foundation Loads 137 psi
Piers: Direct Load 37 psi

SUMMARY OF QUANTITIES

ITEM No.	ITEM	UNIT	Abuts.	Piers	Super-structure	Bridge Rdwy.
202.00a	Class "D" Excavation	CY				20.0
303.00a	4" Sand Cushion	Sq Yd				30.8
444.00a	Approach Slabs	Sq Yd				30.8
501.00a	Substrn Excav - Common	CY	30	170		350
501.00a	Substrn Excav - Rock	CY		48		48
505.00a	Steel Handrailing	Lf			271.5	271.5
509.00a	Class "A" Concrete	CY	57.0	69.9		126.9
509.00a	Class "A" Conc. in Pier Bases	CY		46		46
509.00a	Class "A" Concrete	CY			57.1	57.1
511.00a	Reinforcing Steel	Lbs	7,600	6,520	39,950	54,070
543.00a	15" C.S.M. Pipe	Lf				36
543.00a	16" R.C. Piling	Lf				484
543.00a	Inlet Frame & Gate	Sq Ft				1
544.00a	8" Black Traffic Stripe	Lf			272	272
Special	4" Concrete Slope Wall	Sq Yd				302
Special	4" Aluminum Handrailing	Lf			271.5	271.5

GENERAL NOTES

All construction & materials shall be in accordance with the Oklahoma Standard Specifications of 1954 & Special Provisions.

All exposed concrete surfaces shall have a Carborundum finish.

All reinforcing steel bars shall conform to ASTM Specifications A-305-49.

Piling shall be driven using leads of sufficient strength to control piles.

Piling shall be driven to practical refusal if above grade or to a minimum bearing of 50 tons if at or below grade.

All Abutment Piling shall be driven through the compacted fill. 12" Pilot holes shall be drilled to Elev. 1314.00 @ Abut. No. 1 and Elev. 1314.50 @ Abut. No. 2. Then 8" Pilot holes to Elev. 1311.50 @ Abut. No. 1 and to Elev. 1312.00 @ Abut. No. 2. All cost of Pilot holes shall be included in the unit price bid for 16" R.C. Piling.

Contractor shall submit bids on both types of Handrailing. Type of rail used will be determined by bids received.

Drilling elevations shall be on natural and shall be shown on foundation materials 15' or round at each station.

RECORD		OKLAHOMA STATE HIGHWAY COMMISSION	
ITEM	BY DATE	OKLAHOMA CITY, OKLAHOMA	
DESIGN		STR. NO. 4	
DETAIL		GENERAL ELEVATION, PLAN	
TRACED	1/5	8' & SUMMARY OF QUANTITIES	
CHECKED	2/2	36'-62.5'-36' CONC. SLAB SPANS	
APPROVED		37' RDY. & 2-18" S.C.'s	
SQUAD	3/2	CL STA. ON CL SURVEY 27+00	
		F.A. PROJ. 1-381 (16) PT.-1	

PLAN

Scale: 1"=40'

GENERAL ELEVATION


Scale: 1"=10'

B.M. R.R. Spike in Power Pole to Rt.
Sta. 26+77. Elev. 1317.00
B.M. R.R. Spike in Power Pole to Lt.
Sta. 27+39. Elev. 1332.36

LIST OF THE SPECIAL PROVISION
See Special Provisions included
in the Proposal for Curing Conc.
with Membrane Curing Compound
for Bridge structures including
Parapet walls, Retaining walls
& Railing 4-14-6 (Rev. 7-27-55)
Locomotion for bearing devices
Equipment for Driving Piles
5-14-1 (a) Reinforcing Steel (Axle steel)
7-23-1 (a) Rev. 2-21-57
Black Traffic Stripes on Black Traffic
Stripes Arrow 3-31-1 (a) Rev. 10-8-55


REVISION		
NO.	DESCRIPTION	BY DATE
1	As per Encl. 3	2-15-58

REFERENCE LIST - 0125-
DETAILS OF ABUTMENTS - SHEET 133
DETAILS OF PIERS - SHEET 134
DETAILS OF SUPERSTRUCTURE - SHEET 135
DETAILS OF SUBSTRUCTURE - SHEET 136
DETAILS OF JOINTS - SHEET 137
DETAILS OF HANDRAILING - SHEET 138
DETAILS OF PILING - SHEET 139

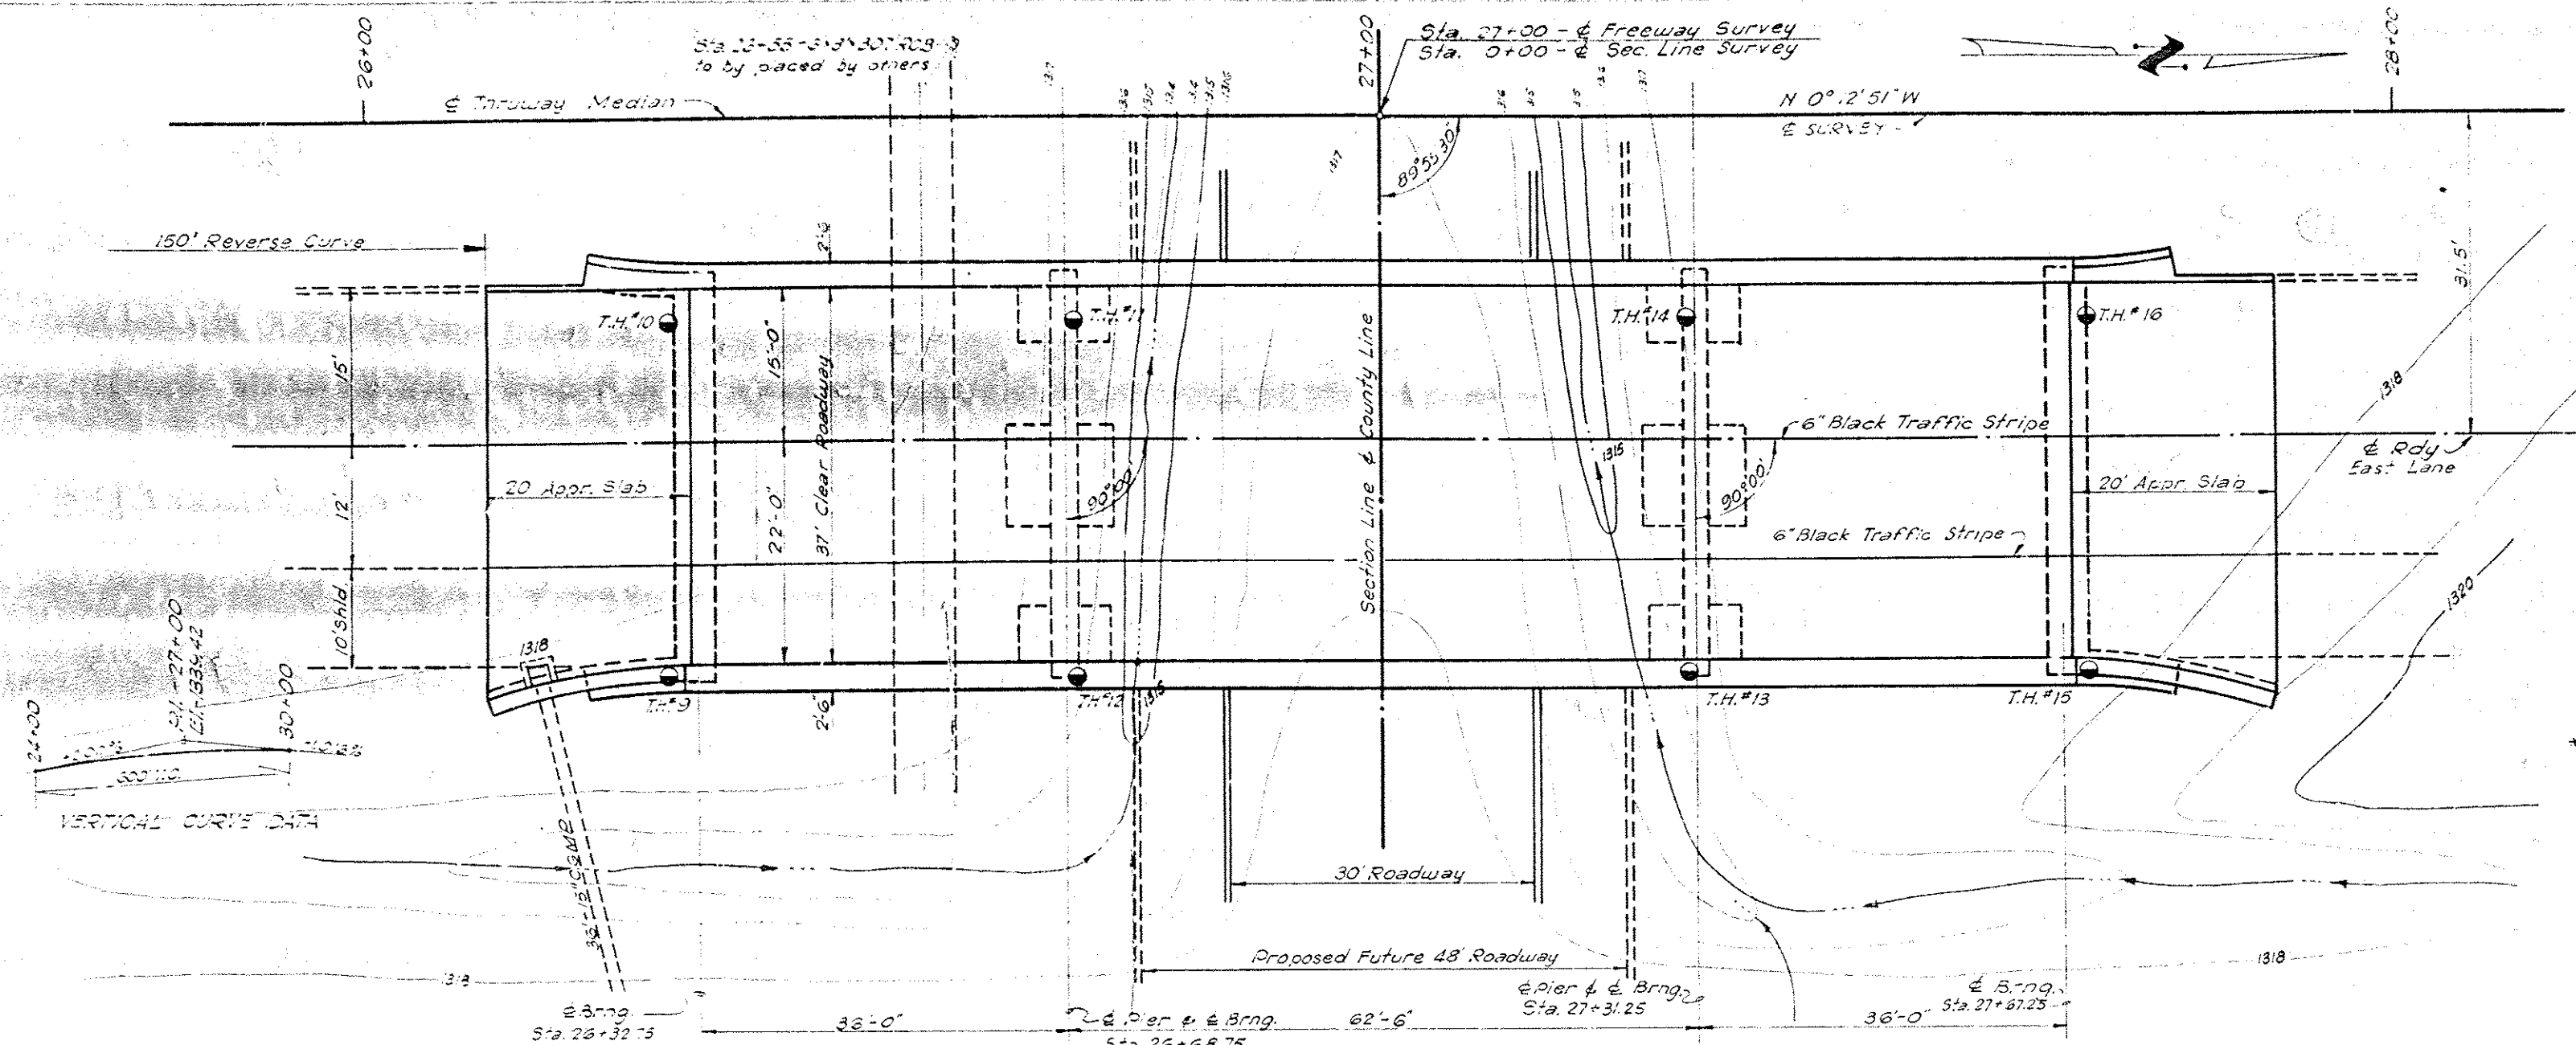

PLAN
Scale: 1\"/>

B.M. R.R. Spike in Power Pole to Rt.
Sta. 26+71 Elev. 1317.00
B.M. R.R. Spike in Power Pole 64 ft.
Sta. 27+39 Elev. 1332.36

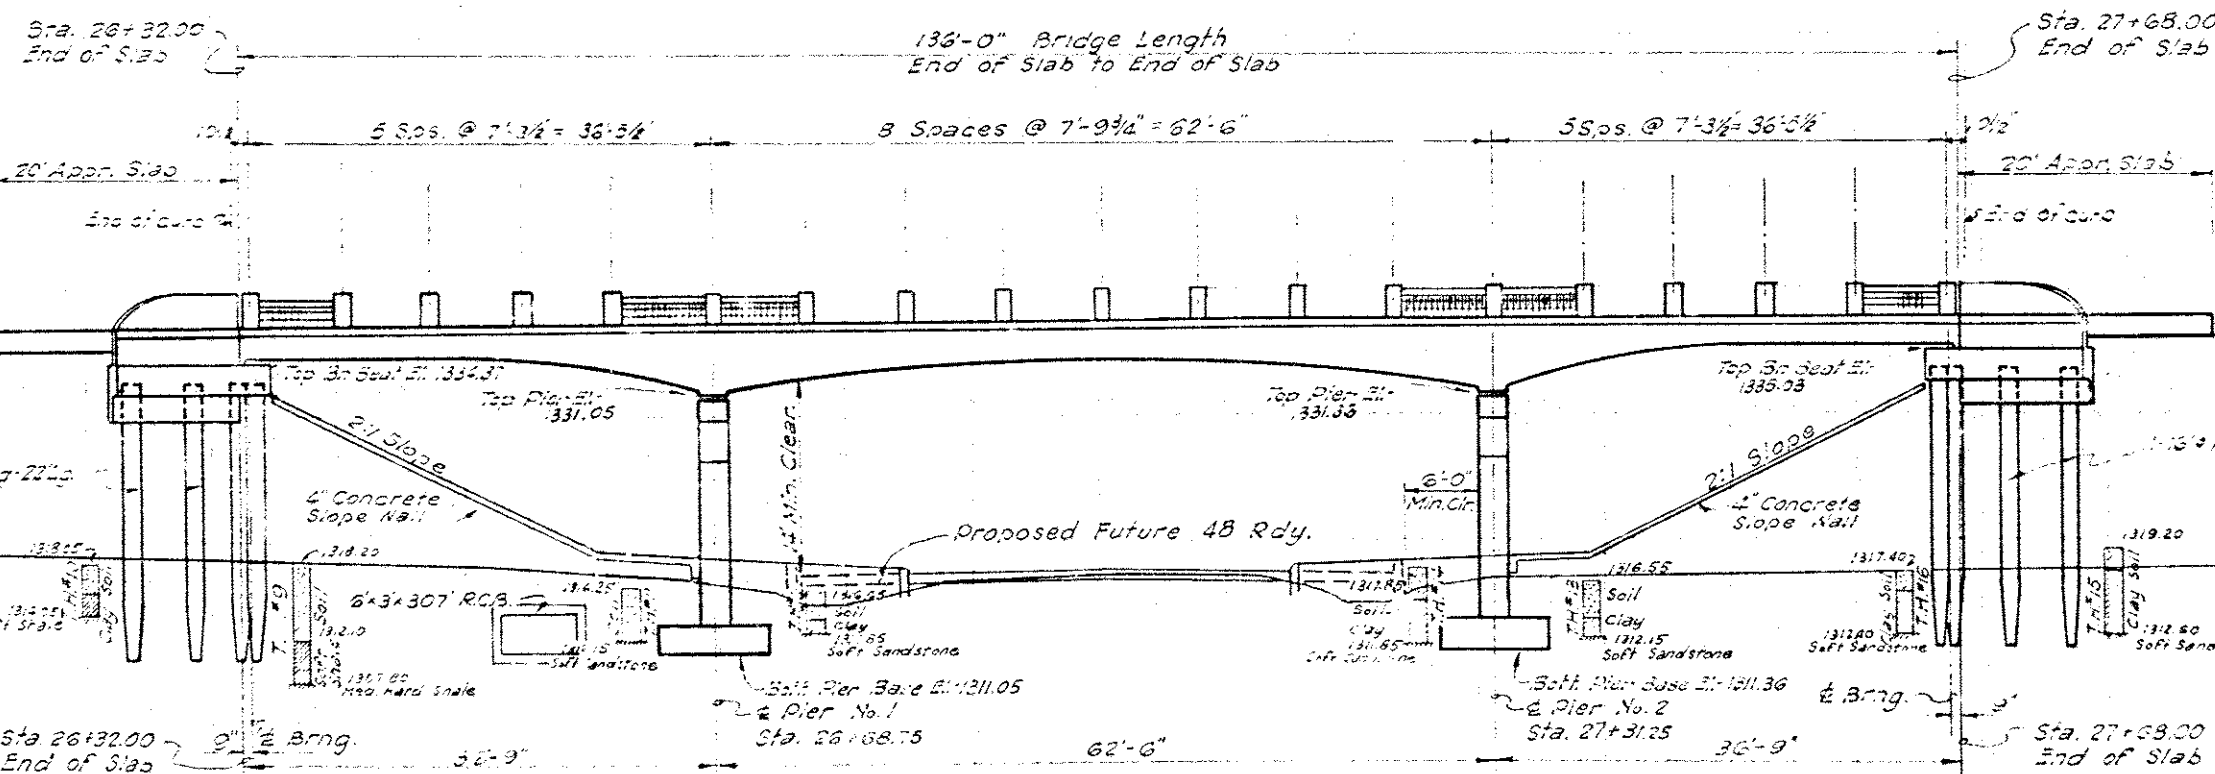

GENERAL ELEVATION
Scale: 1\"/>

LIST OF THE SPECIAL PROVISIONS
See Special Provision included
in the Proposal For Curing Conc.
with Membrane Curing Compound
For Bridge structures including
Parapet walls, Retaining walls,
Railing 4-1-6 (30) Rev 7-27-55,
Access to Substructure devices,
Equipment For Driving Piles
5-4-1(a) Reinforcing Steel
(Axle Steel) 7-23-1(a) Rev 2-21-57
Black Traffic Stripe or Black Traffic
Stripe Arrow 6-24-13 Rev 10-13-55

NO.	REVISION	DESCRIPTION	BY	DATE
1	1	1	1	1
2	2	2	2	2
3	3	3	3	3
4	4	4	4	4
5	5	5	5	5
6	6	6	6	6
7	7	7	7	7
8	8	8	8	8
9	9	9	9	9
10	10	10	10	10

REFERENCE LIST & DINGS:-
DETAILS OF ABUTMENTS SHEET 23
DETAILS OF PIERS SHEET 24
DETAILS OF SUPERSTRUCTURE SHEET 25
DETAILS OF SLAB ELEVATION SHEET 26
DETAILS OF JOINT DETAILS SHEET 27
DETAILS OF HANDRAILING SHEET 28
DETAILS OF PILING SHEET 29

DESIGN DATA

LL 420.5-5.53; 221.20-4
Concrete 1,000 psi
Reinforcing Steel 60,000 psi
Foundation Loads 137 psi
Piers Direct Load 37.4

SUMMARY OF QUANTITIES

ITEM No.	ITEM	UNIT	Abut.	Piers	Substructure	Bridge	Rdy.
202.08a	Class "D" Excavation	CY					200
308.08a	4" Sand Cushion	SF					190.8
44.08a	Approach Slabs	SF					190.8
501.08a	Substr. Excav. Common	CY	180	20			360
501.08a	Substr. Excav. Rock	CY	9				9
605.08	Steel Handrailing	LF			27.5		27.5
502.08a	Class "A" Concrete	CY	570	278			27.9
502.08a	Class "A" Conc. in Pier Bases	CY		46			46
509.08a	Class "A" Concrete	CY			513	153.1	
511.08	Reinforcing Steel	TON	1600	5.20	663.0	39.63	75
608.08a	18" C.S.M. Pipe	LF					36
514.08a	8" x 20" Piling	LF	434				434
311.08a	Trailer Frame & Slogs	EA					1
514.08a	Black Traffic Stripe	LF			27.5	27.5	30
508.08	Special 4" Concrete Slope Wall	SF					625.8
508.08	Special Aluminum Handrailing	LF			27.5	27.5	

* Non-Contingency Item GENERAL NOTES

All construction & materials shall be in accordance with the Oklahoma Standard Specifications or 1954 & Special Provisions.

All exposed concrete surfaces shall have a Carborundum finish.

All reinforcing steel bars shall conform to ASTM Specifications A-305-49.

Piling shall be driven using leads of sufficient strength to control piling.

Piling shall be driven to practical refusal if above grade or to a minimum bearing of 50 tons if at or below grade.

All Abutment Piling shall be driven through the compacted fill 12" Pilot holes shall be drilled to Elev. 1314.00 @ Abut. No. 1 and Elev. 1314.50 @ Abut. No. 2. Then 8" Pilot holes to Elev. 1311.50 @ Abut. No. 1 and Elev. 1312.00 @ Abut. No. 2. All cost of Pilot holes shall be included in the unit price bid for 18" R.C. Piling.

Construction shall submit bids on both types of handrailing. Type of rail used, will be determined by close inspection.

Contingency provisions shall not be based and shall be allowed only if firm foundation materials are not found at plan location.

RECORD	OKLAHOMA STATE HIGHWAY COMMISSION
ITEM	BY DATE
DESIGN	
DETAIL	
TRACED	5
CHECKED	222
APPROVED	
SQUAD	35 V-41

STR. NO. 5
GENERAL ELEVATION, PLAN
& SUMMARY OF QUANTITIES
36'-62.5'-36' CONC. SLAB SPANS
37' RDY. & 2-18" S.C.s
CL STA. ON CL SURVEY 27+00
F.A. PROJ. I-381 (16) PT-1

FED. ROAD DIST. NO.	STATE	PROJ. NO.	SHEET NO.	TOTAL SHEETS
6	OKLA.	I-381(6) PT.	40	88

BAR LIST-ONE PIER

Mark	No.	Size	Form	Length
H1	5	1"Ø	Bnt.	42'-2"
H2	5	1 1/8"	Str.	13'-0"
H3	2	1 1/8"	Str.	33'-6"
H4	4	1 1/8"	Str.	33'-6"
H5	4	1 1/8"	Str.	39'-0"
BH1	16	1/2"	Bnt.	4'-9"
BH2	8	1/2"	Bnt.	6'-0"
WH1	4	1/2"	Str.	31'-6"
NH2	6	3/4"	Str.	32'-0"
WV	18	1/2"	Bnt.	12'-5"
S1	56	5/8"	Bnt.	12'-6"
S2	12	1/2"	Bnt.	11'-3 1/2"
D	36	1/2"	Str.	5'-0"
F1	22	3/4"	Str.	6'-6"
F2	28	3/4"	Str.	9'-6"
F3	18	1/2"	Str.	8'-6"
F4	21	1/2"	Str.	11'-6"

STR #4	STR #5				
V1	V2	36	1 1/8"	Str.	18'-2"
T1	T2	36	1 1/8"	Str.	18'-10"
		42	1 1/8"	Bnt.	8'-9"
		30	1/2"	Bnt.	8'-9"

QUANTITIES












ITEM	UNIT	Str. No. 4	Str. No. 5
		Pier No. 1	Pier No. 2
Reinforcing Steel	Lbs	7750	7500
Class "A" Concrete	C.Y.	32.9	32.9
Class "A" Conc. in Pier Base	C.Y.	23.0	23.0
Substr. Excav. - Common	C.Y.	50	50
Substr. Excav. - Rock	C.Y.	3	3

NOTES:

1. Reinforcing steel bars shall conform to ASTM A615 Grade 60.
2. Excess lap splices shall have a minimum lap length as noted.
3. Concrete shall be poured dry.

NOTES: METAL STRIP PER BASE CONCRETE


Refer to Section Notes on Details of Reinforcing Steel #22

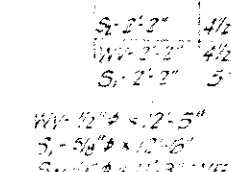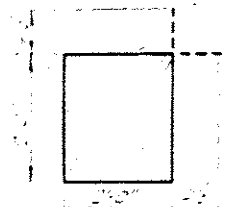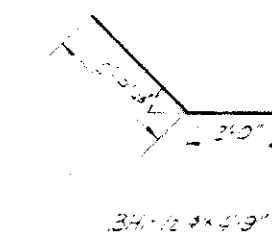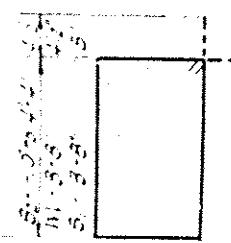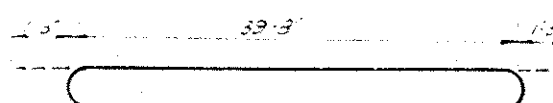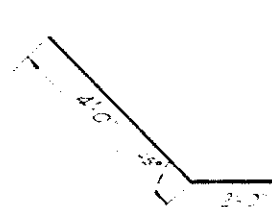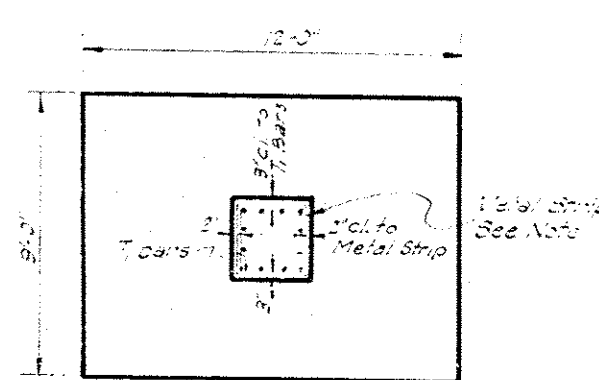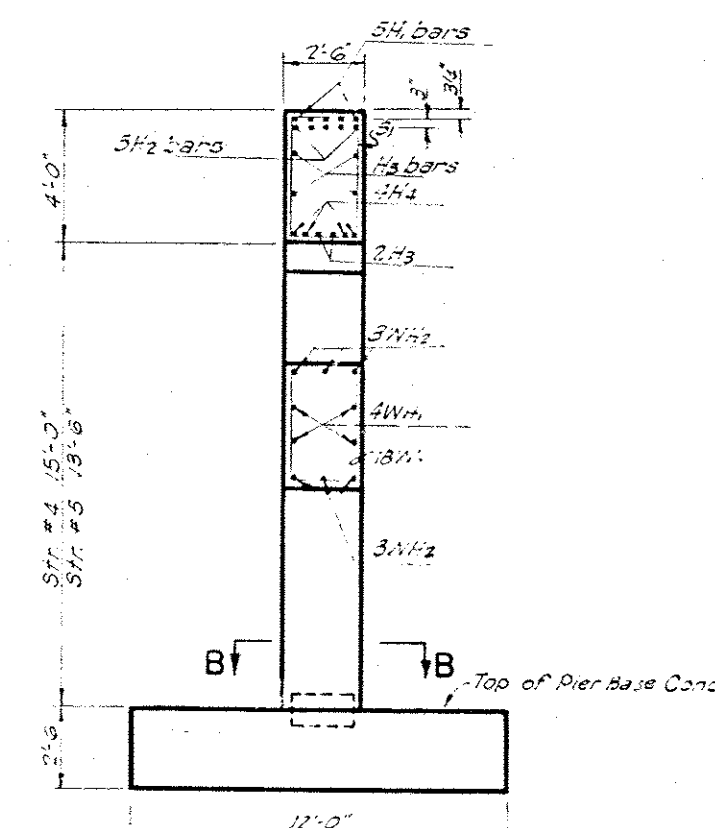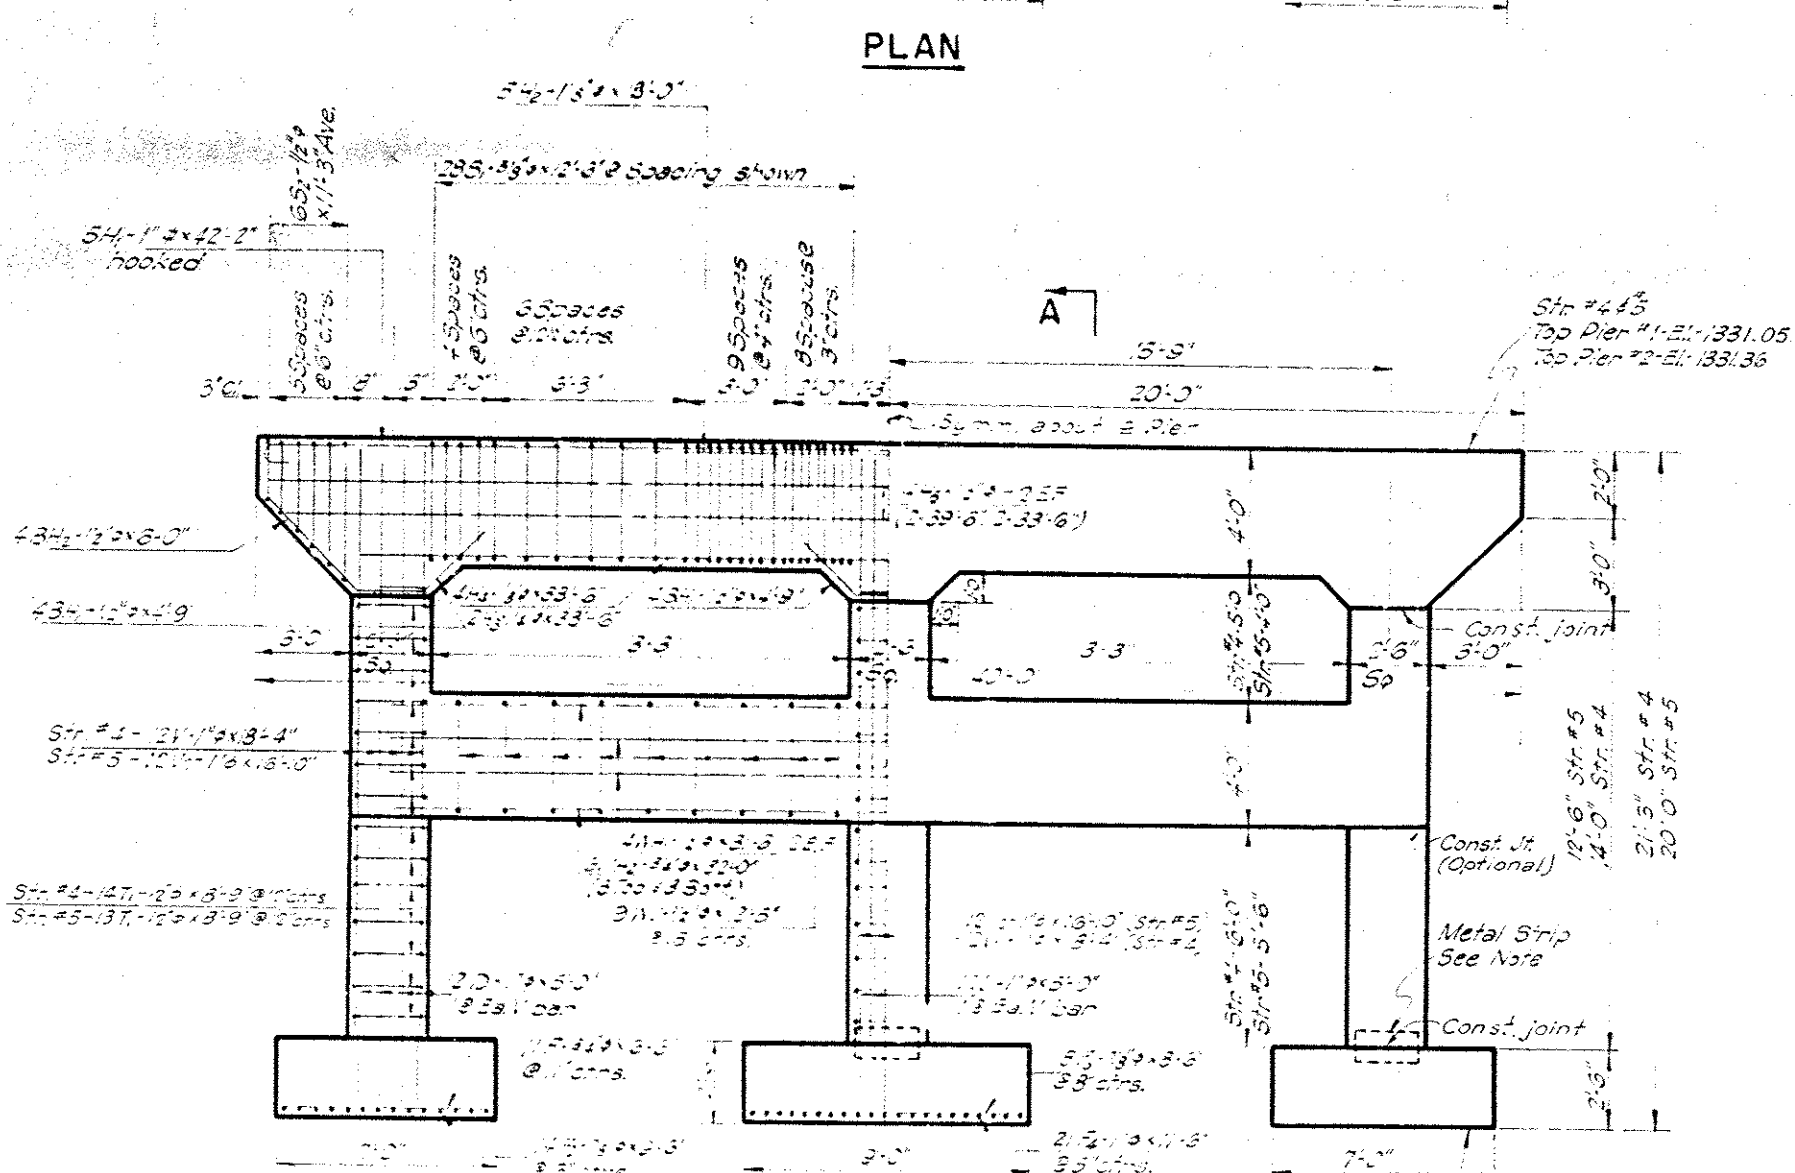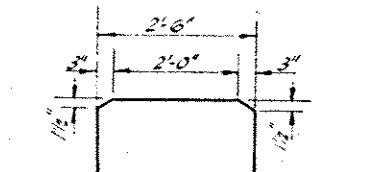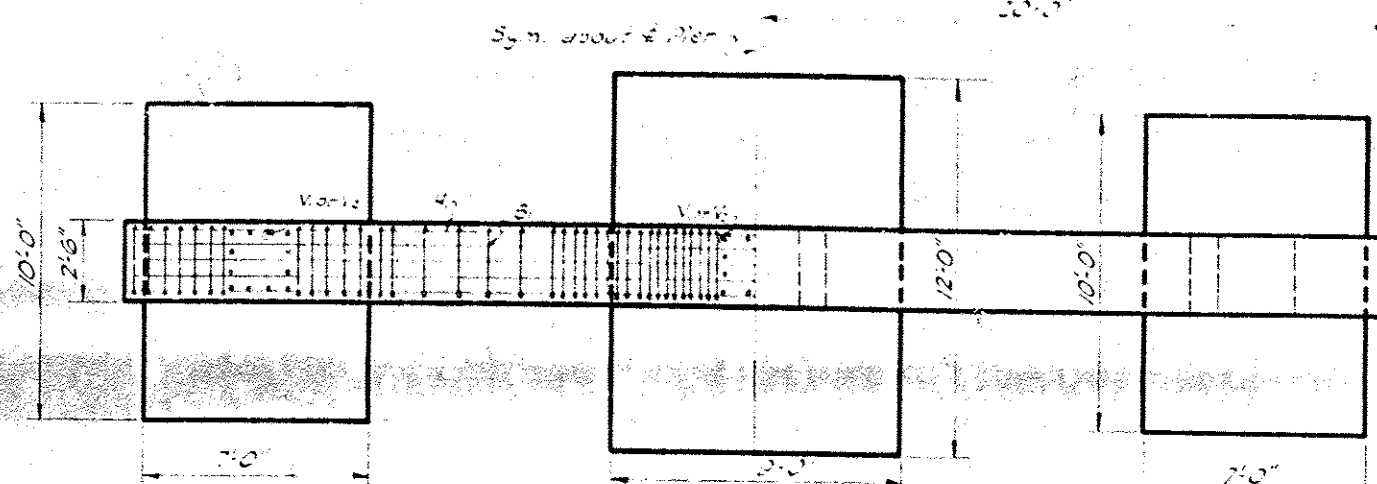

REVISIONS	RECORD	OKLAHOMA STATE HIGHWAY COMMISSION
NO. DESCRIPTION BY DATE	ITEM BY DATE	OKLAHOMA CITY, OKLAHOMA
DESIGN	DESIGN	
DETAIL	DETAIL	
TRACED	TRACED	
CHECKED	CHECKED	
APPROVED	APPROVED	
SQUAD	SQUAD	

DESIGN DATA

Concrete	1000 p.s.i
Reinforcing Steel	18,000 p.s.i.
Design Live Load	H-20-53
Foundation Loads:	
Abutments	2.61 T/Sq.Ft.
Piers Direct Load	3.93 T/Sq.Ft.

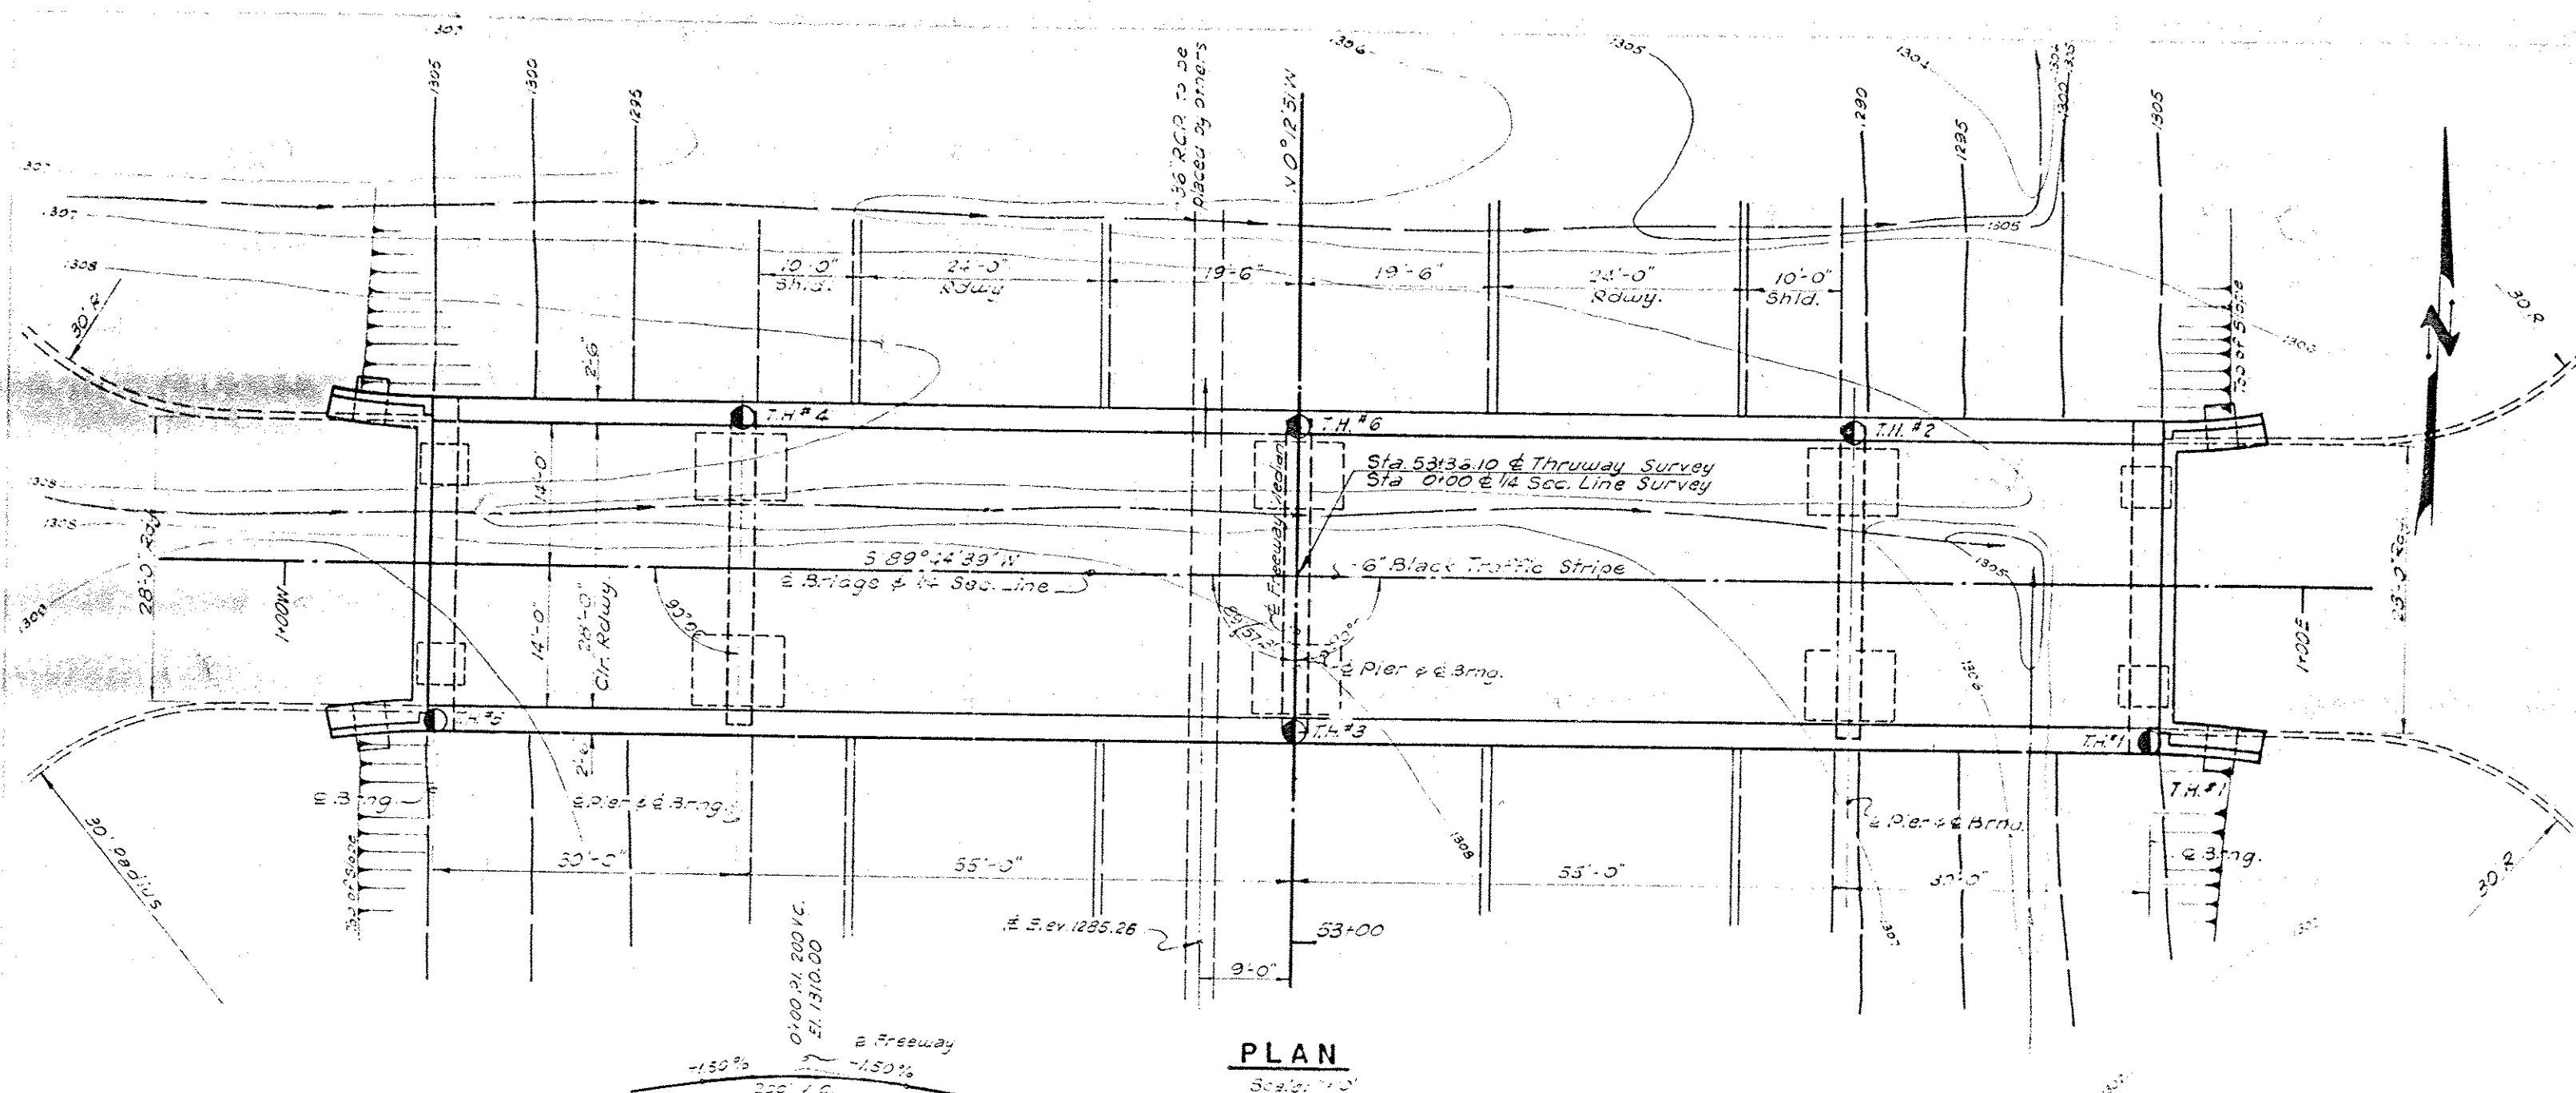

PLAN

Sept. 1900

[illegible]

GENERAL NOTES


All construction & Materials shall be in accordance with the Oklahoma Standard Specifications or 1954 & Special Provisions.

All exposed concrete surfaces shall have a carbonaceous finish.

All reinforcing steel bars shall conform to ASTM specifications A-305-49.

Contractor shall submit bids on both types of handrailing. Type of rail used will be determined by bids received.

For floating elevations that are not observed and cannot be lowered, only in firm floating elevations made at a not-firmest or other elevation.

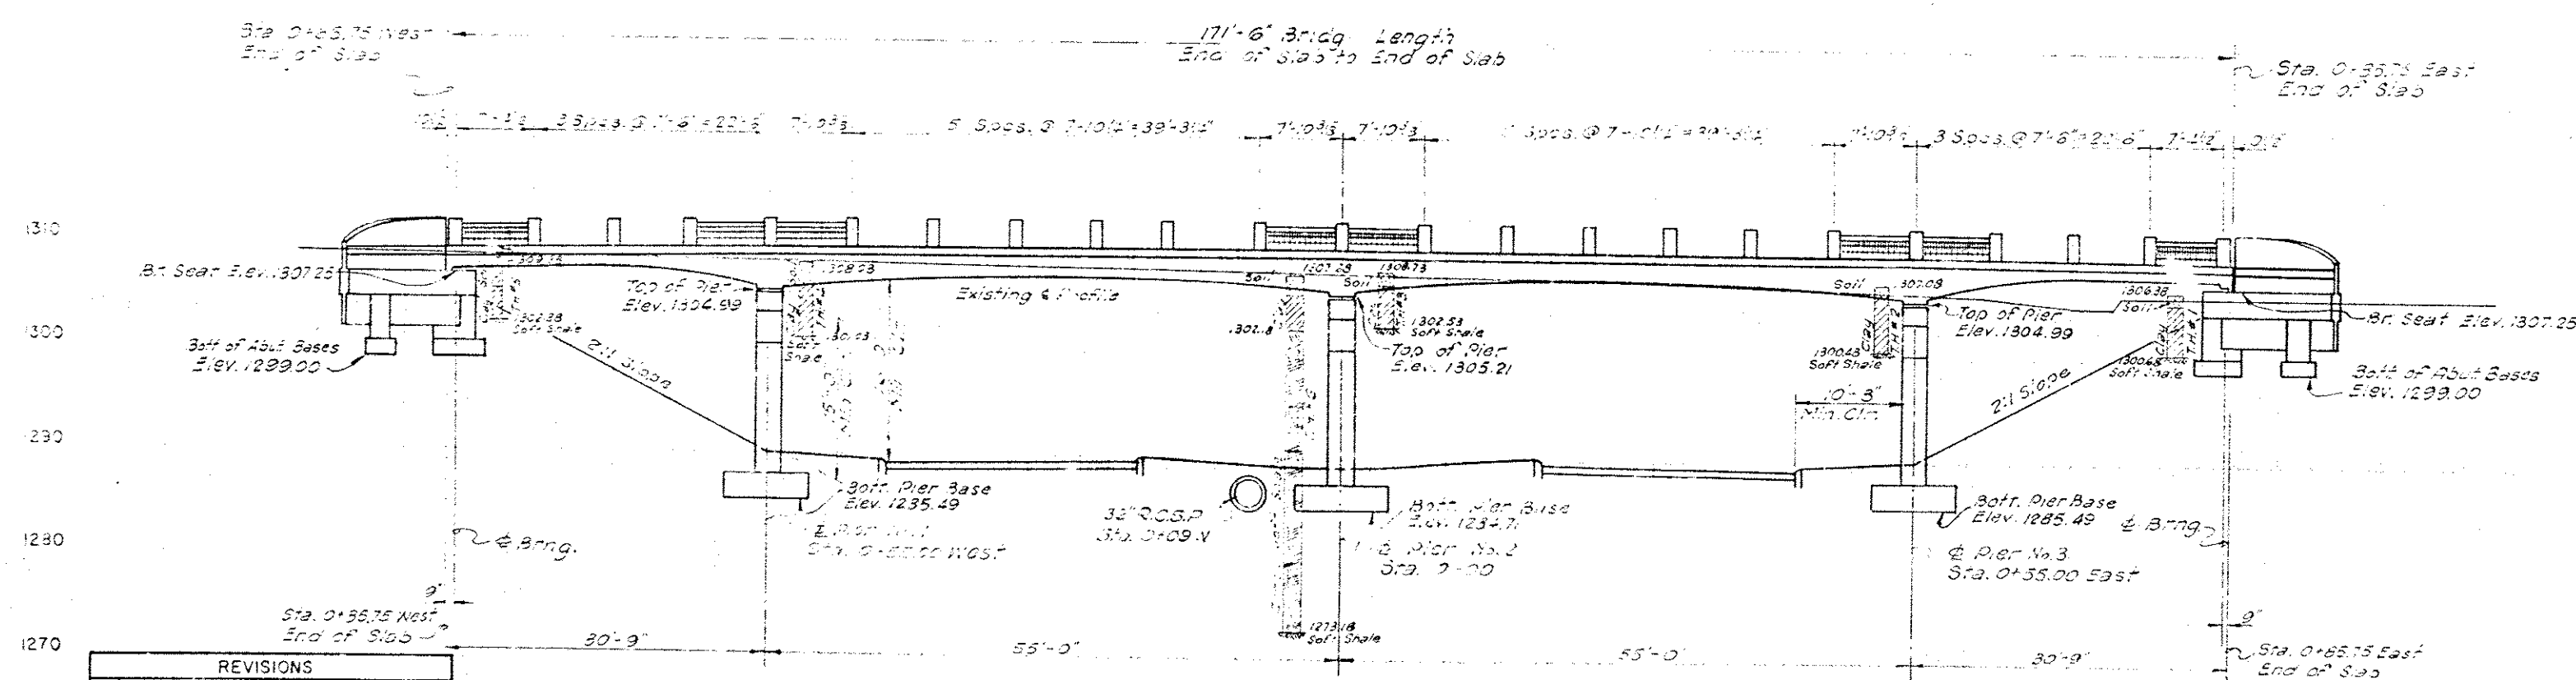

GENERAL ELEVATION

Dr. J. H. H. H.

[illegible]

SPECIAL PROVISIONS

See Special Provisions included in the
Proposal For Curing Concrete with
Membrane Curing Compound For
Bridge Structures Including Parapet
Walls, Retaining Walls & Railing
A14-6(ac) Rev. 7-27-55

Neoprene rubber for bearing devices.

514-1(a) Reinforcing Steel (Axle Steel)

723-1(a) Rev. 2-21-57

Black Traffic Stripe or Black Traffic
Stripe Array 624-661 Rev 12-12-55

ON THE H.T. 51X. 624-1(a). Rev. 10-18-55
+ 50 W





REFERENCE LIST - 2- DWG-1

DETAILS	* ASSEMBLYS	-----SHEET# 18
DETAILS	* PIER	-----SHEET# 19
DETAILS	* SUPERSET	-----SHEET# 20
DETAILS	* SLAB FLEX	-----SHEET# 21
DETAILS	* HANDWORKING	-----SHEET# 22

RECORD			OKLAHOMA STATE HIGHWAY COMMISSION
ITEM	BY	DATE	OKLAHOMA CITY, OKLA.
DESIGN			STR. No. 6
DETAIL			GENERAL ELEV. PLAN &
TRACED	JS		SUMMARY OF QUANTITIES
CHECKED	RS	2-25	30'-55'-55'-30' CONC. SLAB SPANS
APPR'D			28' RDY & 2-18" S.C.'s
SQUAD:	BRUNHAM		Q STA. ON Q SURVEY 53+36.10
			FA. PROJ. 1-381 (16) PT-1

PIED ROAD DIST. NO.	STATE	PROJ. NO.	SHEET NO.	TOTAL SHEETS
6	OKLA.	1-381(16)PT-1	43	86


BAR LIST				
Mark	No.	Size	Form	Length
BH	33	1/2"	Bnt	12'-5"
BH	6	1/2"	Str	32'-6"
BH	18	1/2"	Str	10'-5"
BH	12	3/4"	Str	12'-6"
BH	56	1/2"	Bnt	13'-5"
CH	2	1"	Str	31'-0"
CH	2	1"	Str	31'-0"
CH	4	1"	Str	31'-0"
CH	4	1"	Bnt	3'-2"
CH	8	1/2"	Bnt	13'-2"
CV	36	3/4"	Str	6'-0"
CV	6	1/2"	Str	13'-5"
CV	6	1/2"	Str	9'-5"
F	10	1/2"	Str	4'-6"
F	12	1/2"	Str	3'-6"
F	8	1/2"	Str	4'-0"
F	10	1/2"	Str	2'-6"
WV	12	1/2"	Str	6'-0"
WV	44	1/2"	Str	5'-6" Ave.
WH	12	1/2"	Str	9'-6"
WH	2	1/2"	Str	7'-6" Ave.
WV	4	1/2"	Str	3'-0"
WV	6	1/2"	Bnt	4'-3"

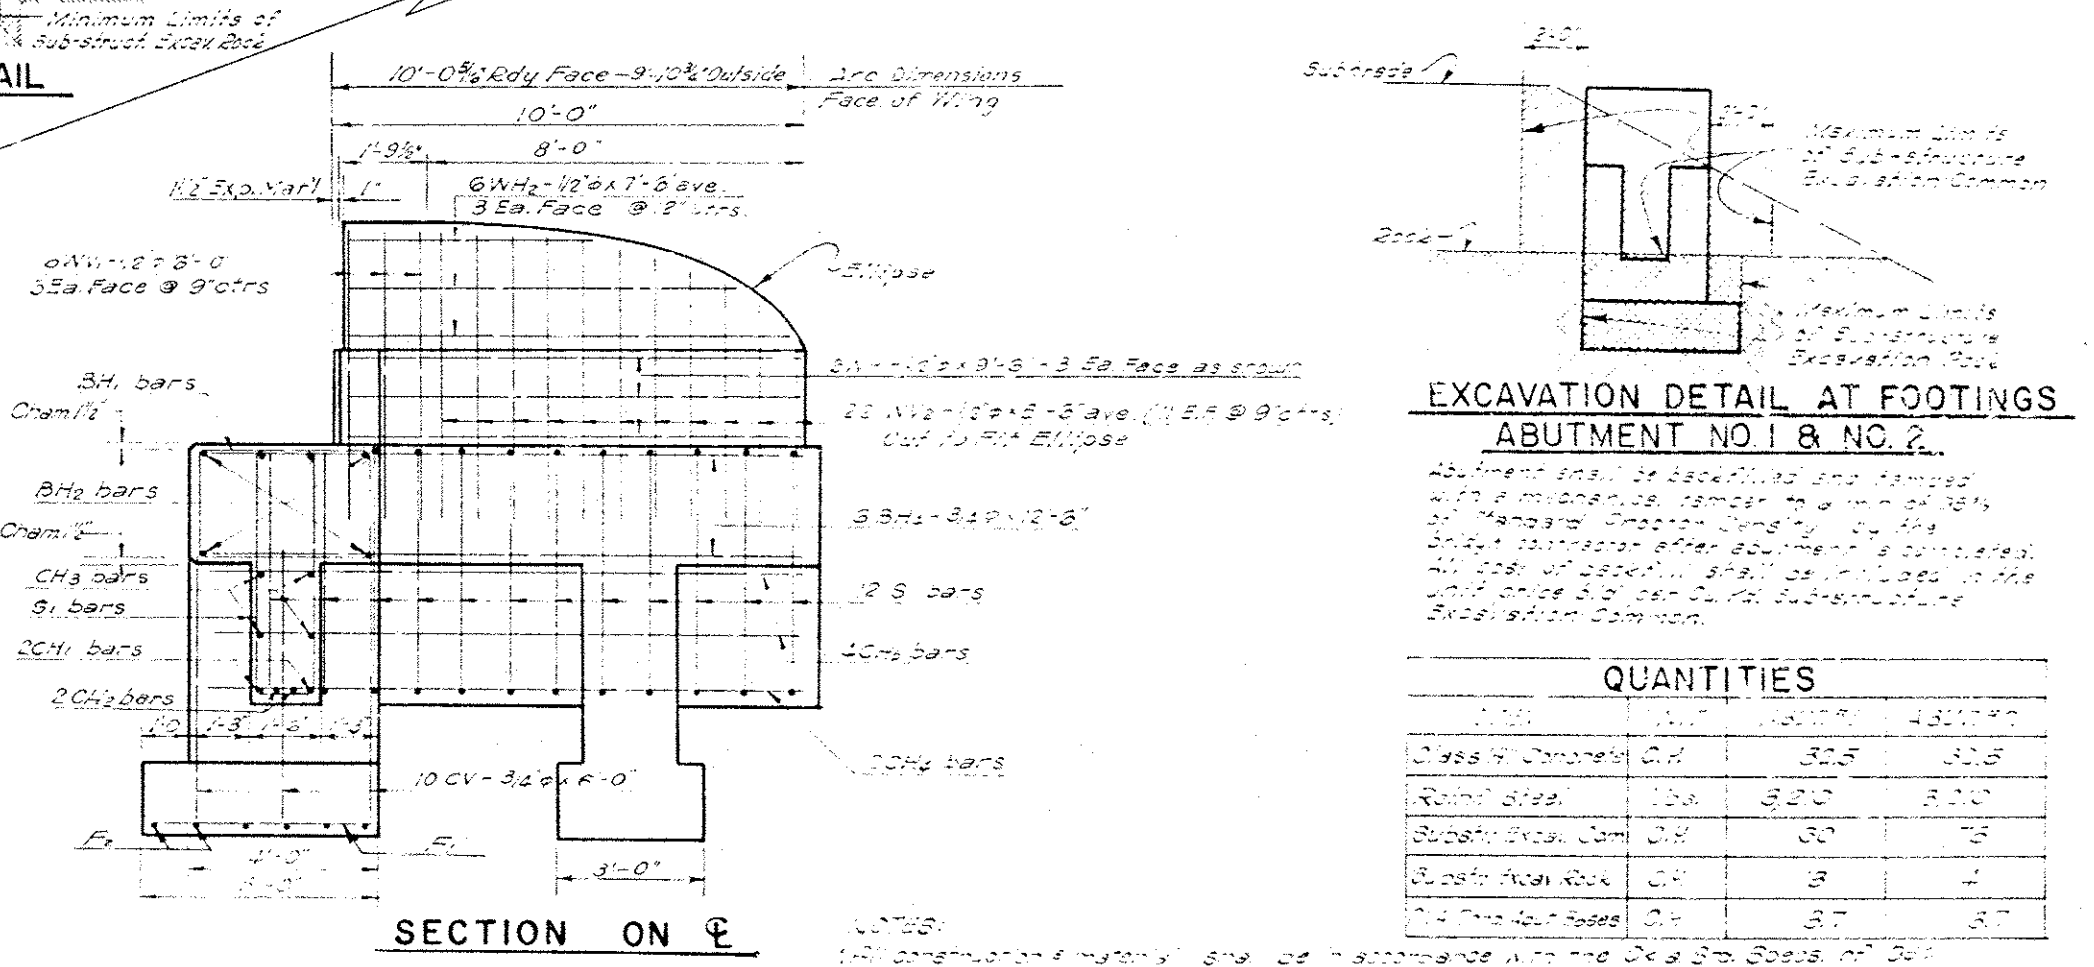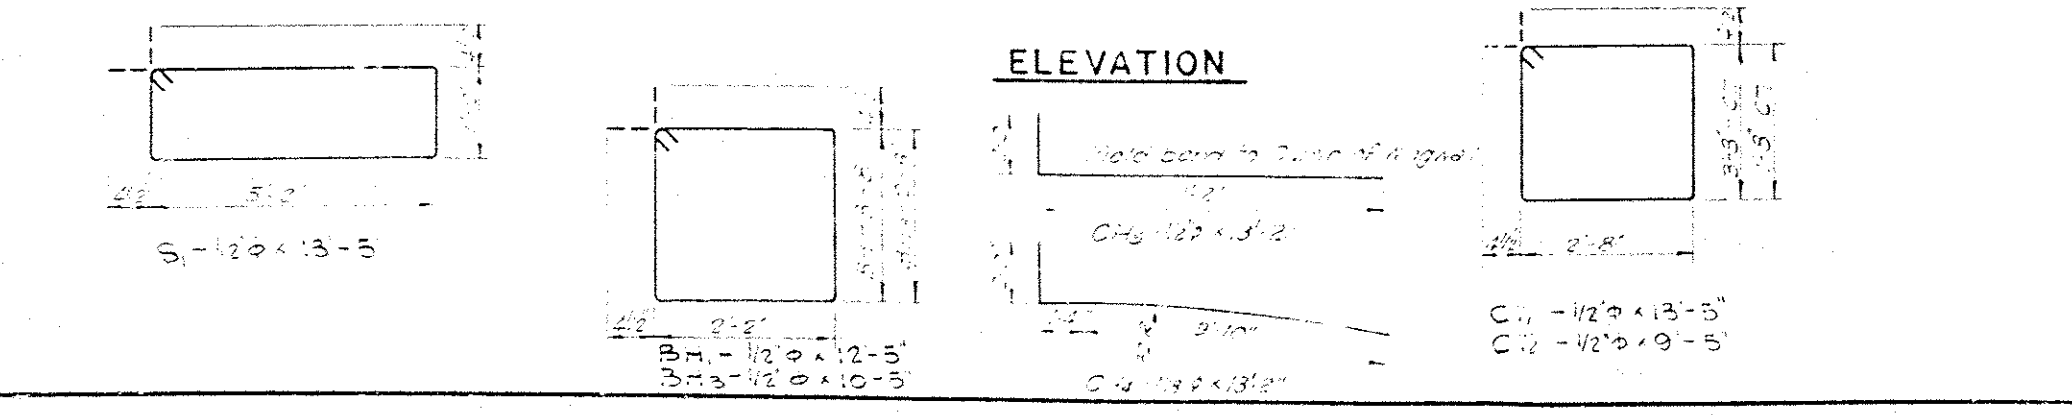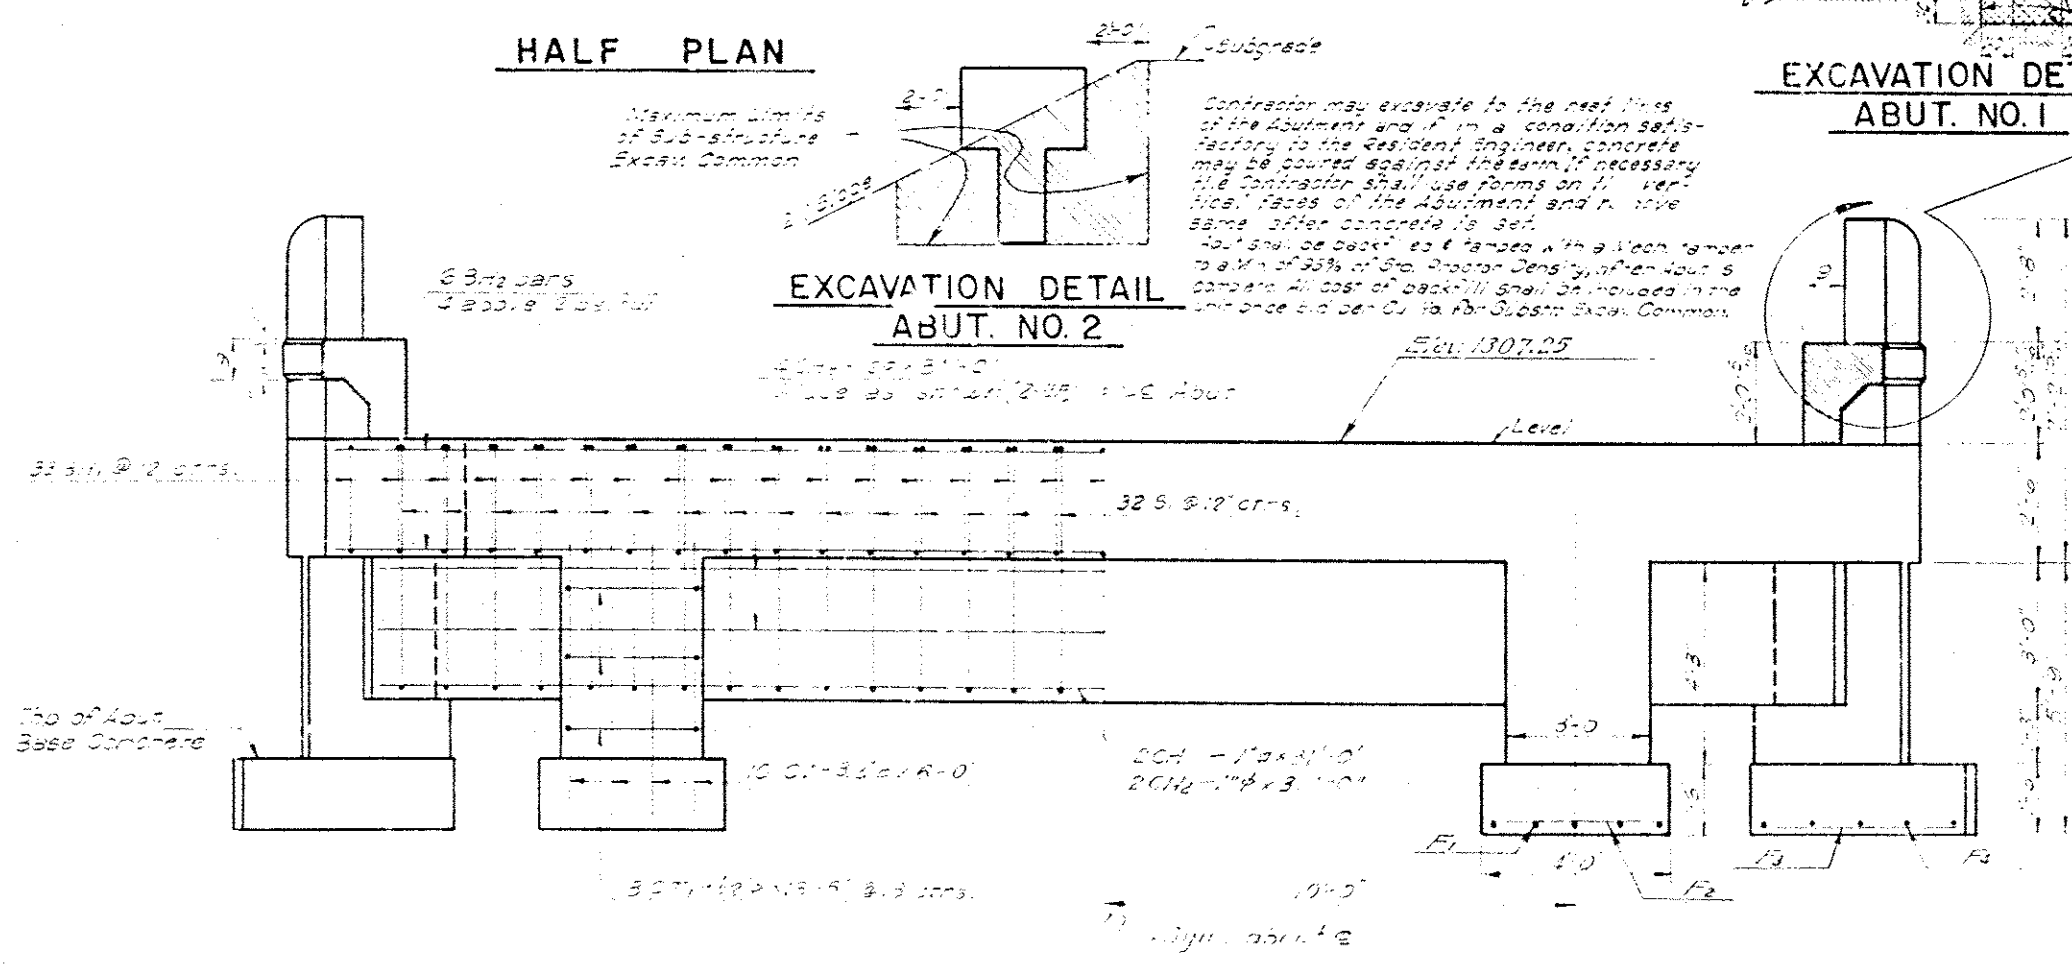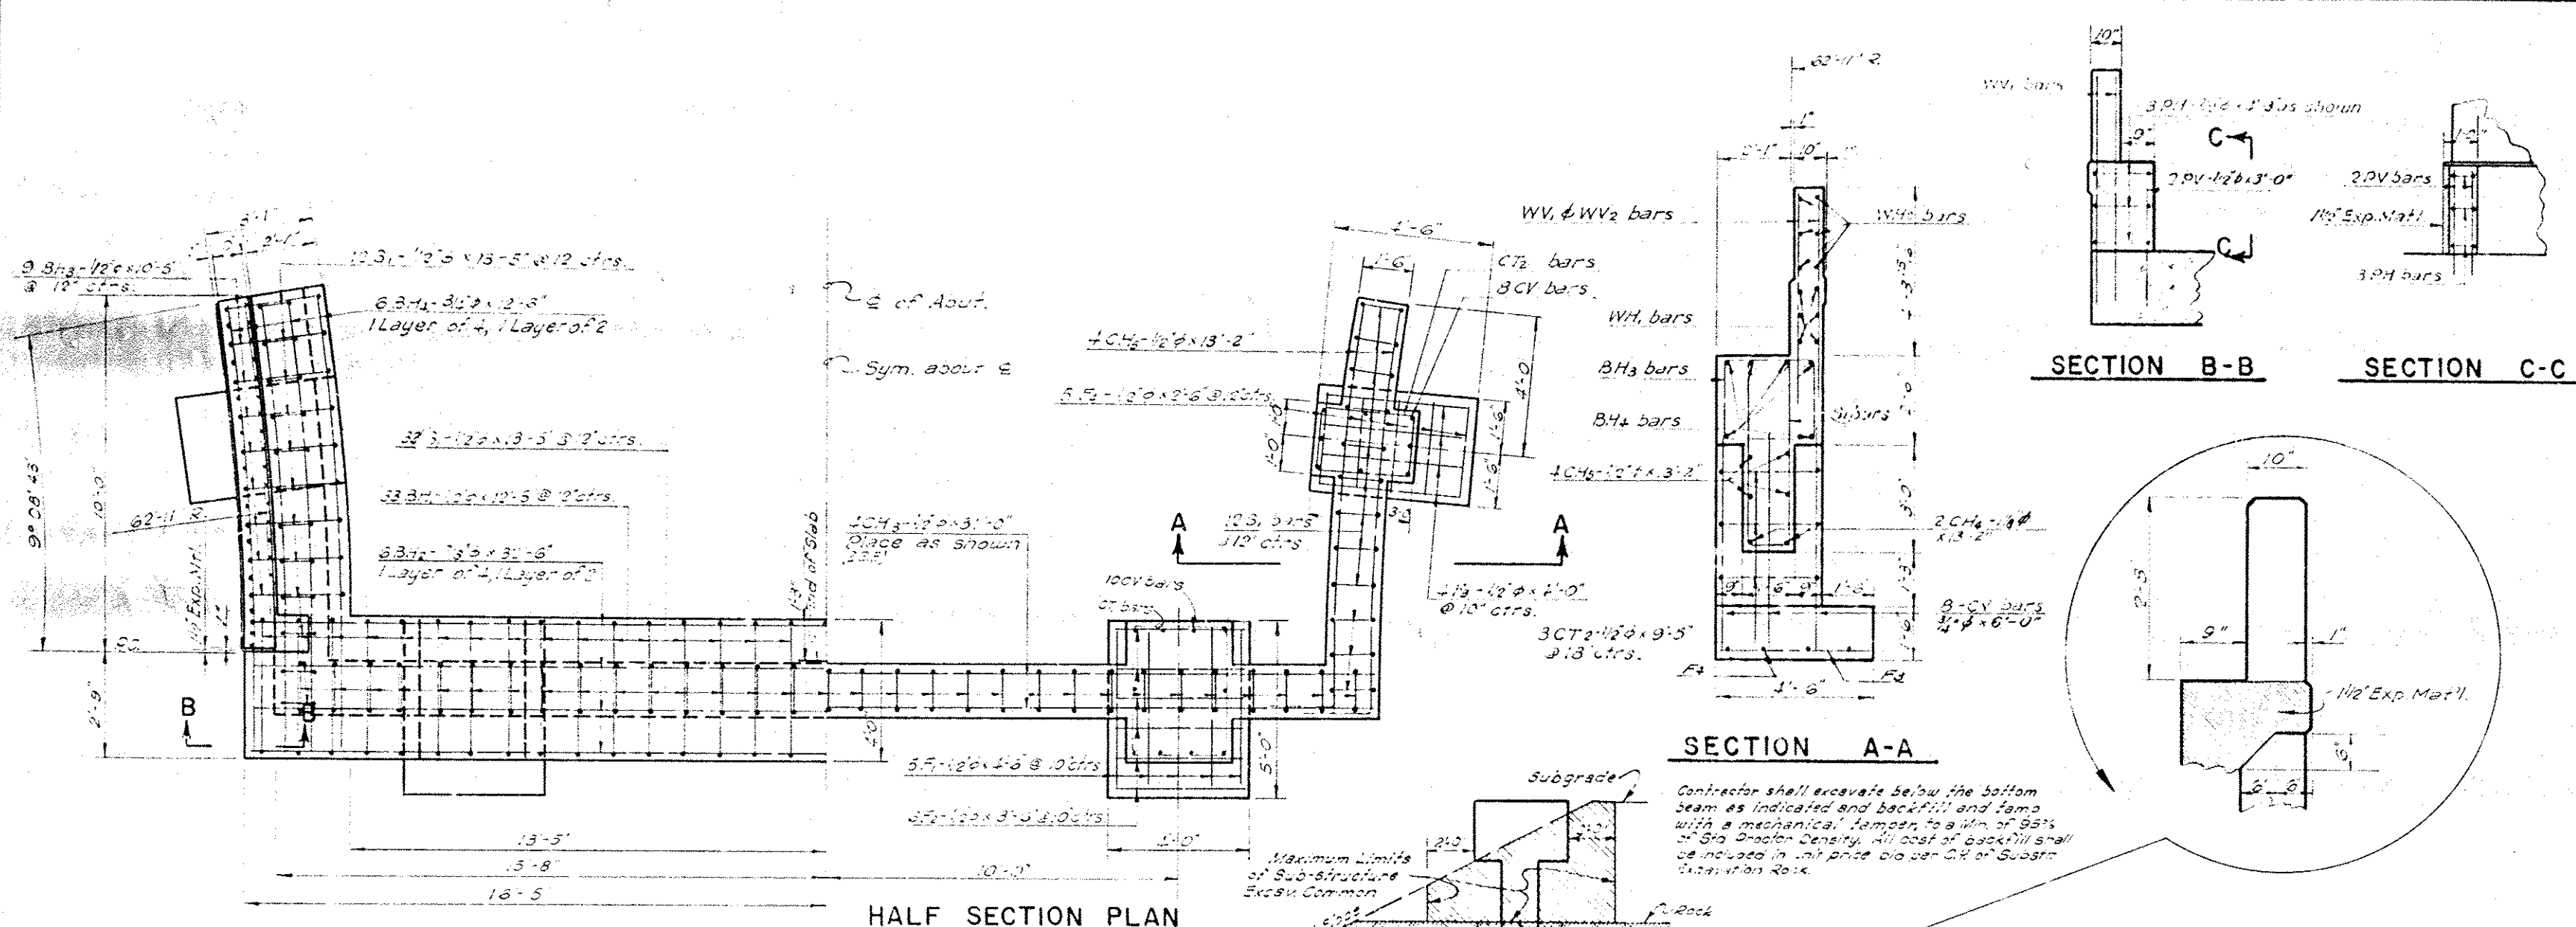


QUANTITIES				
ITEM	UNIT	AMOUNT	4301770	
Class 4 Concrete	CY	32.5	32.5	
Reinforcing Steel	TON	3.20	3.20	
Subgrade Excav. Com.	CY	30	30	
Subgrade Backfill	CY	3	3	
Subgrade Excav. Com.	CY	3.7	3.7	

DESIGN		REVISION		OKLAHOMA STATE HIGHWAY COMMISSION OKLAHOMA CITY, OKLAHOMA STR. NO. 6 DETAILS OF ABUTMENTS ON STA. ON E SURVEY 53+36.10 FA PROJ. 1-381 (16)PT-1
DESIGNED BY	DATE	REVISION NO.	DATE	
CHECKED BY	DATE	REVISION NO.	DATE	
APPROVED BY	DATE	REVISION NO.	DATE	
APPROVED BY	DATE	REVISION NO.	DATE	


PROJECT NO.	SHEET NO.	TOTAL SHEETS
6	44	88

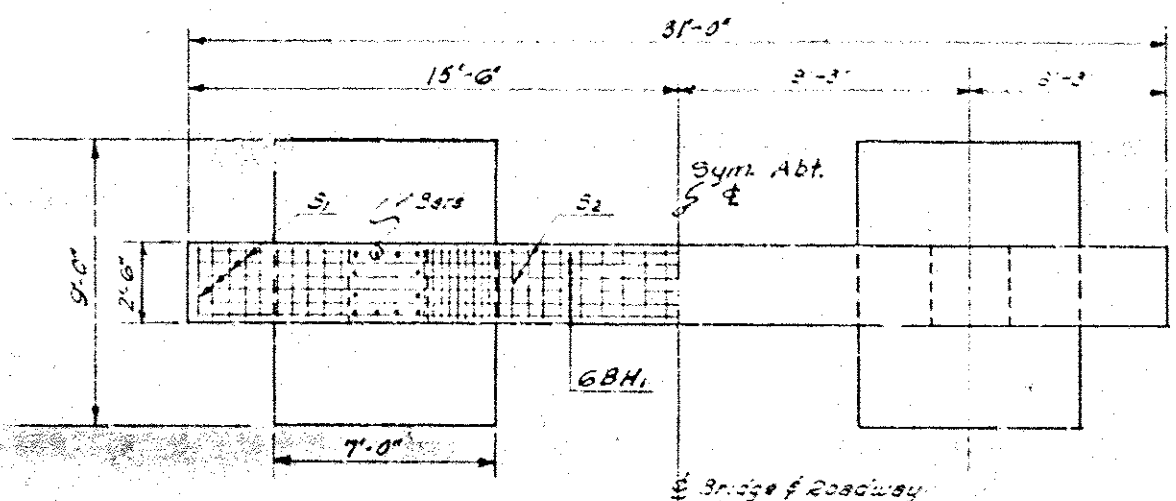

PLAN
PIER NO. 2

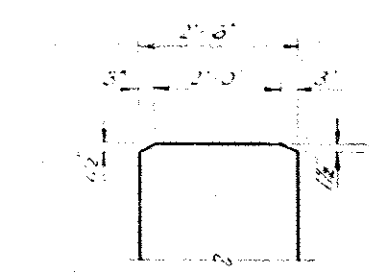


DETAIL OF PIER TOP

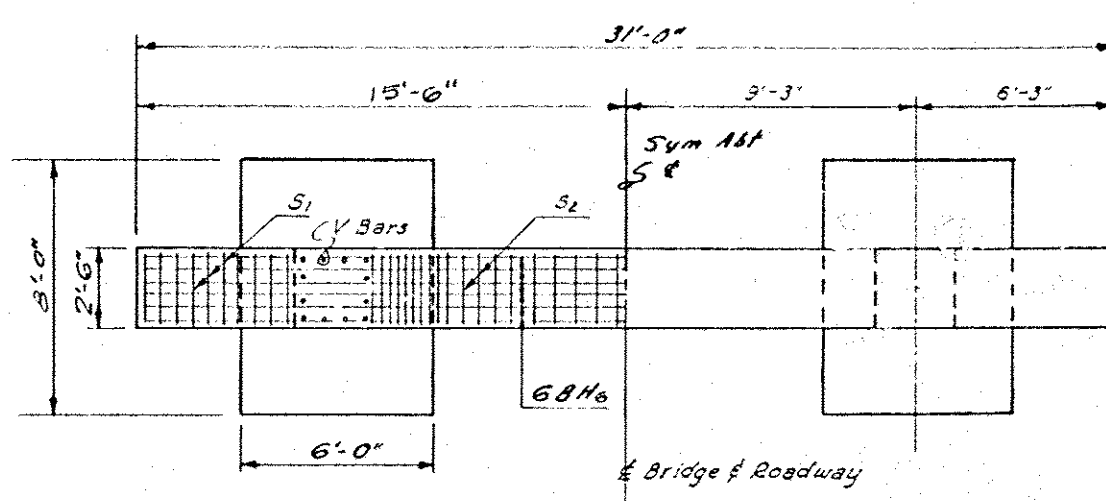


PLAN
PIER NO. 1 & 3

QUANTITIES				
ITEM	UNIT	PIER 1	PIER 2	PIER 3
Class A Concrete	CY	23.1	23.5	23.1
Class A Concrete Pier Bases	CY	3.9	4.7	3.9
Reinforcing Steel	Lbs.	3,200	4,750	3,700
Substr. Excess Rock	CY	17.8	21.1	17.8


BAR LIST				BAR LIST			
PIER NO. 1 OR NO. 3	Mark	Size	Form	PIER NO. 2	Mark	Size	Form
	3H6	6	3ft		3H1	6	3ft
	3H2	4	2ft		3H2	4	2ft
	3H3	8	11ft		3H3	8	11ft
	3H4	8	12ft		3H4	8	12ft
	3H5	8	12ft		3H5	8	12ft
	S1	20	5ft		S1	20	5ft
	S2	21	5ft		S2	21	5ft
	T	21	5ft		T	21	5ft
	W	24	5ft		W	24	5ft
	W4	6	3ft		W4	6	3ft
	WV	11	12ft		WV	11	12ft

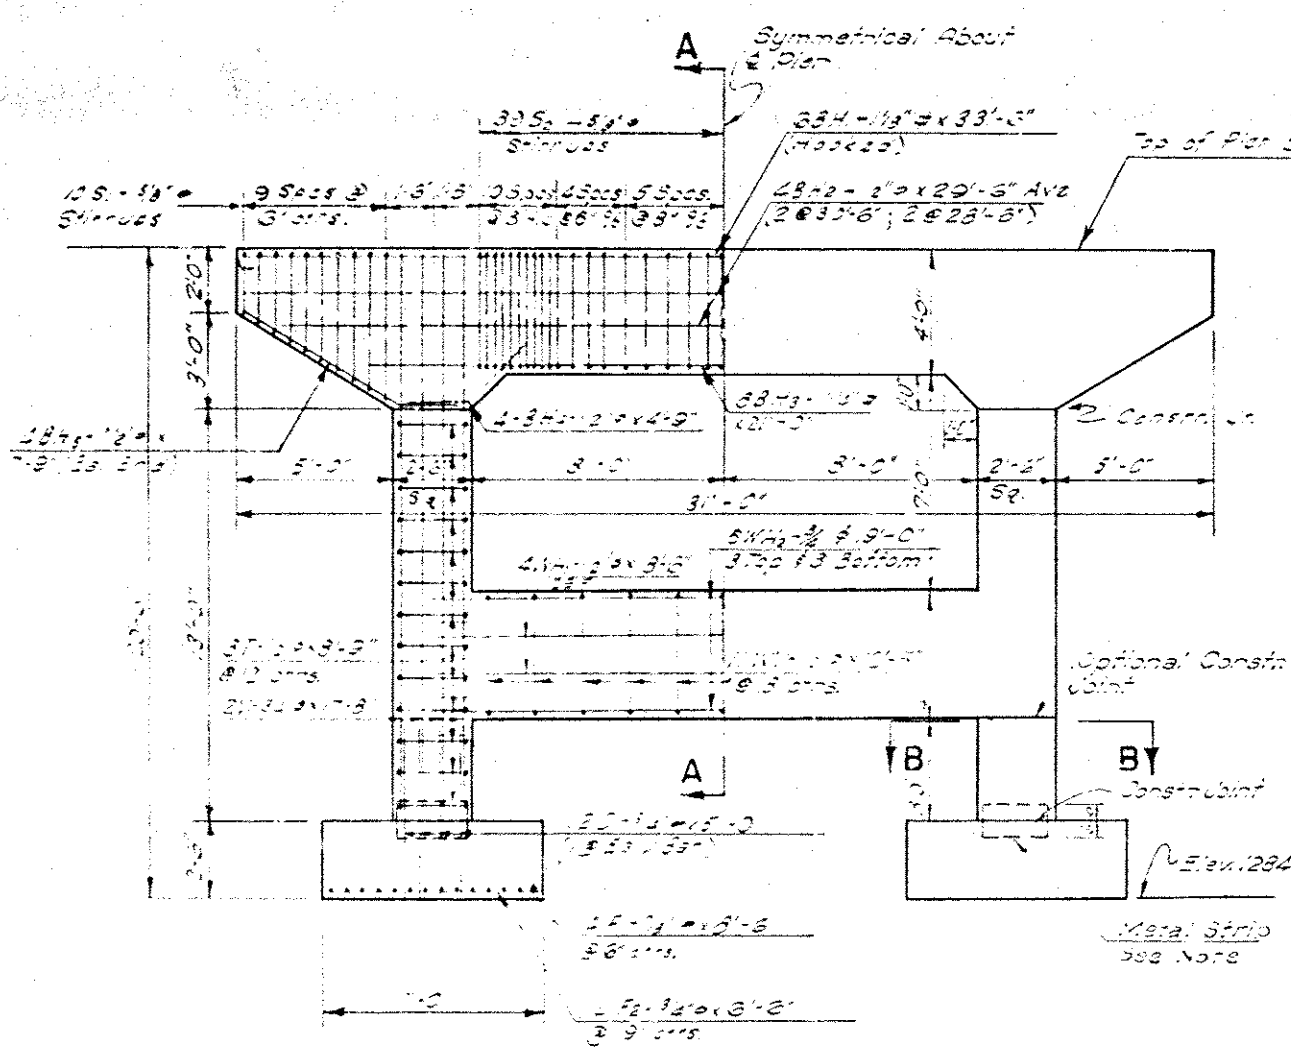


ELEVATION - PIER NO. 2

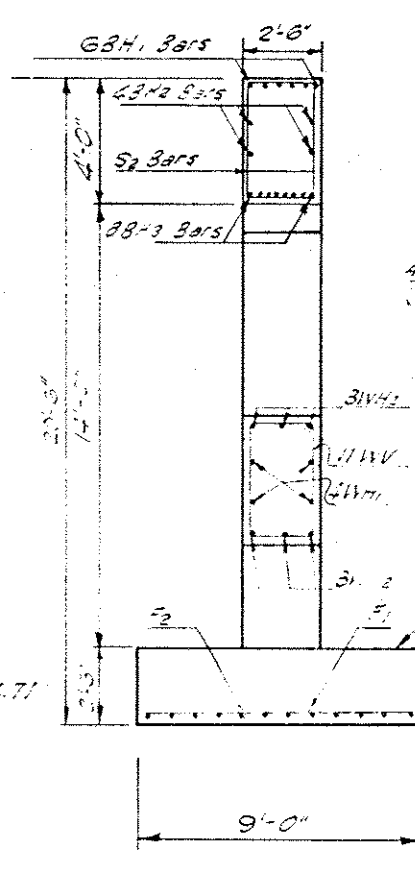


SECTION A-A

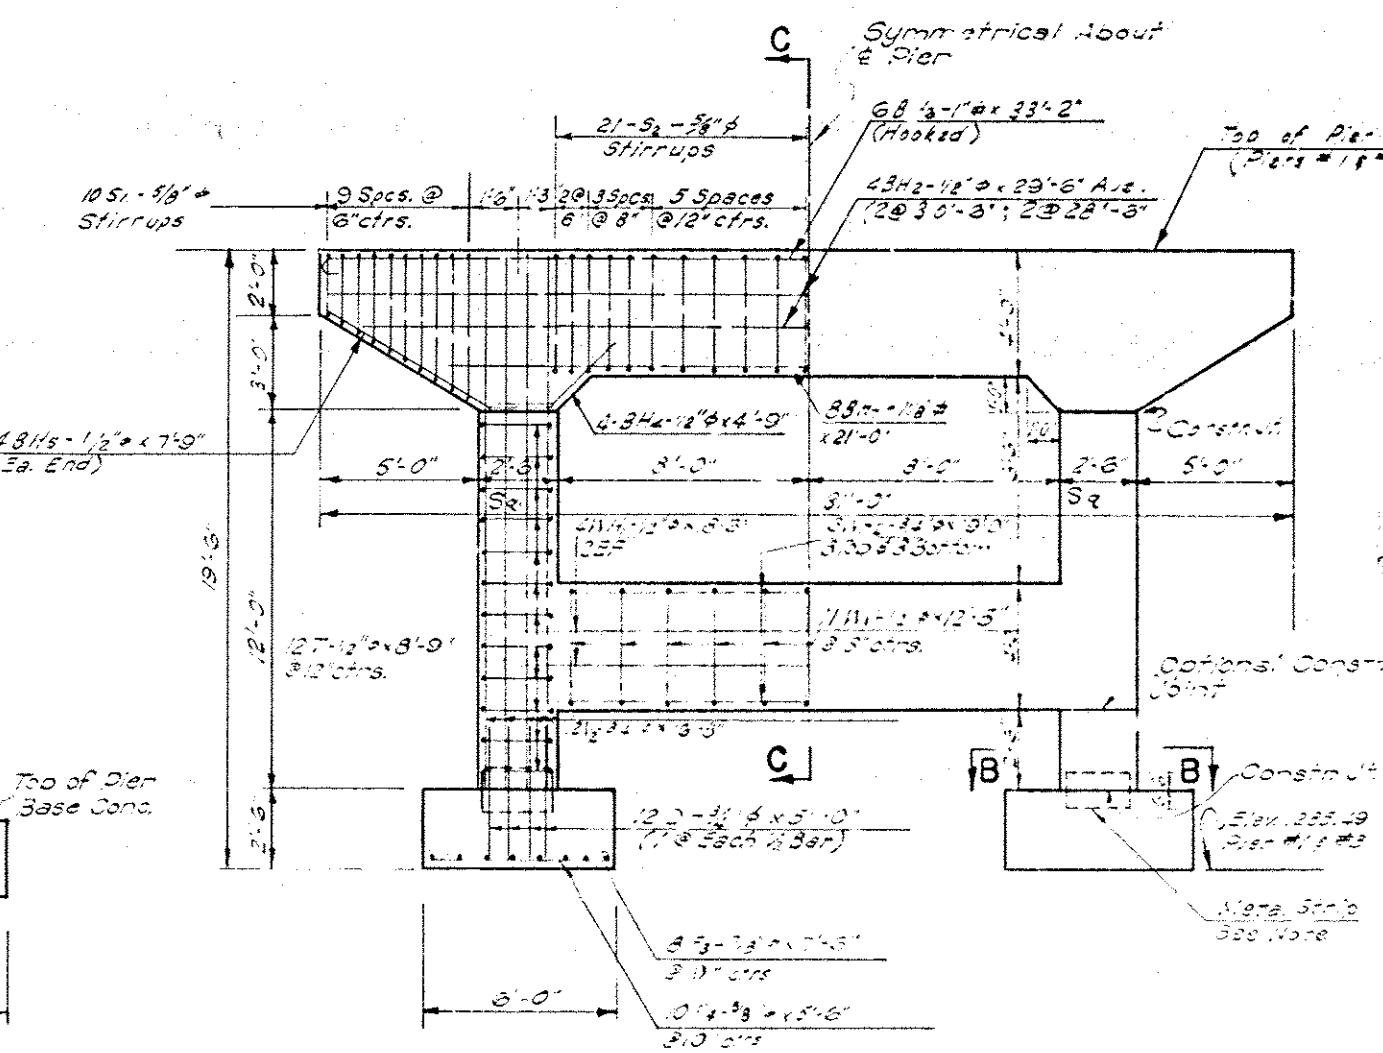



ELEVATION - PIERS NO. 1 & 3

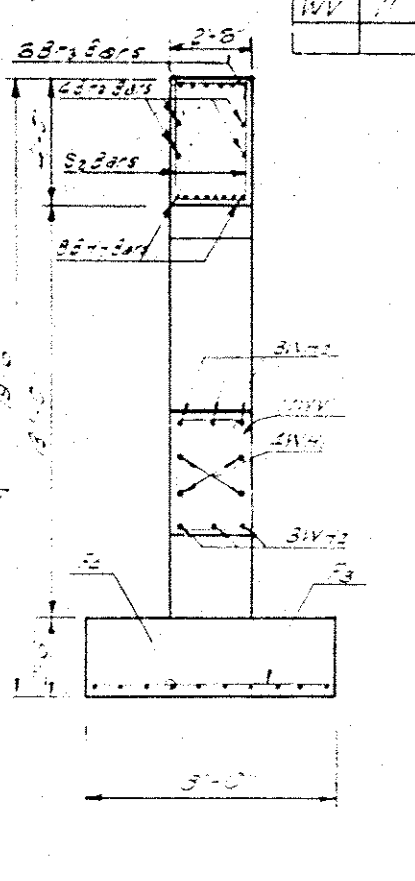

SECTION C-C

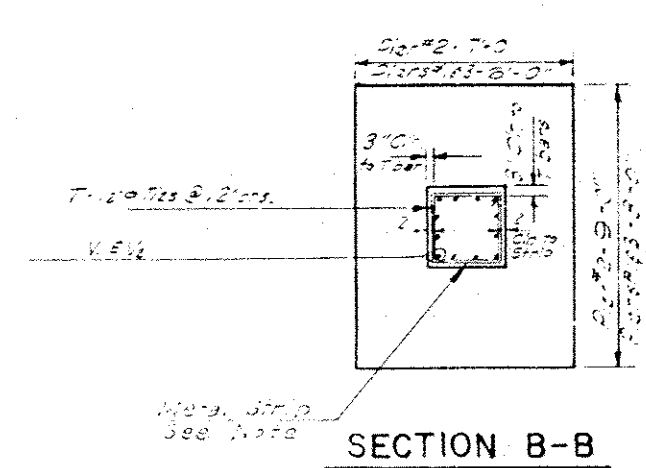

SECTION B-B

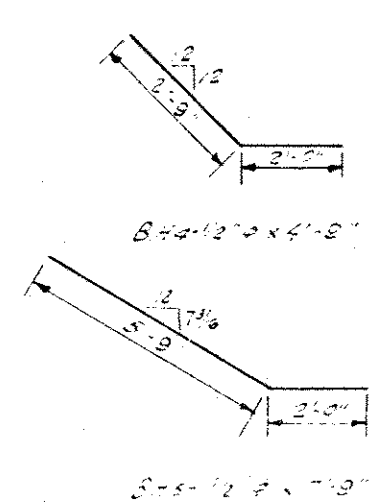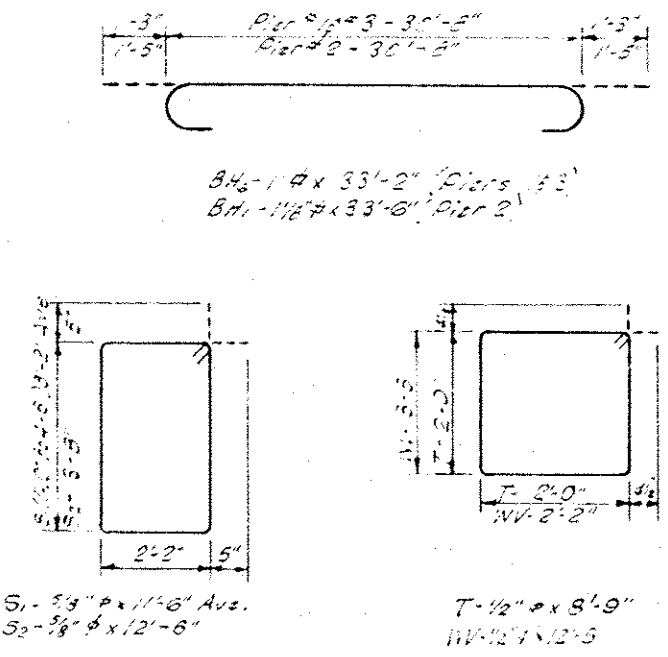

NOTES:
1. Reinforcing steel shall conform to ASTM A615 Grade 60.
2. Excess rock shall be removed and replaced with concrete.
3. Concrete shall be placed in layers.
4. Metal strip shall be used for base concrete.
5. Refer to construction notes on Plans for details.
6. See Sheet No. 22.

DESIGN		RECORD		OKLAHOMA STATE HIGHWAY COMMISSION	
NO.	DATE	BY	DATE	OKLAHOMA CITY, OKLAHOMA	
DESIGN		RECORD		STR NO. 6	
DETAIL		RECORD		DETAILS OF PIERS	
CHECKED		RECORD		ON SURVEY 53+36.10	
APPROVED		RECORD		FA PROJ 1-381 (16) PT.-1	

Hand-drawn cross-sections of a bridge deck, labeled SECTION C-C and SECTION D-D.

SECTION C-C (Top View):

- Top surface: 6" Black Traffic Strip, Slope 1/8" / ft.
- Below traffic strip: 1/2" concrete layer.
- Width: 30" c/s.
- Labels: F.Bars, T.I., 2 Constr. Jt.
- Note: Sym about & except as shown.

SECTION D-D (Side View):

- Side surface: 6" Black Traffic Strip, Slope 1/8" / ft.
- Below traffic strip: 1/2" concrete layer.
- Width: 30" c/s.
- Labels: T.I., 2 Constr. Jt.

Notes:

- This Section Shown by Heavy Lines shall have a concrete finish.
- 1/2" x 30" x 1/2" c/s.

Detailed plans of falsework and forms shall be submitted to the Highway Commission and be approved by the Chief Engineer before any concrete is poured. Falsework and forms must be in place for the entire track of one unit before any concrete in that unit is poured. All forms shall be lined within approved form lining (Plywood, Masonite or similar material). The form lining material shall be full sized commercial panels and joints shall line up in so far as practical. No scrap or odd sized pieces shall be used.

Provisions shall be made for adjustment of forms to correct any deformation which may occur during concrete operations. Adequate provisions shall be made for making adjustments to forms during pouring operations.

The concrete mixer shall have sufficient capacity to pour all concrete as indicated by the construction joints in a continuous pour. A standby mixer shall be provided at the bridge site for emergency use unless transit mixed concrete is used.

No construction joints other than those shown on the plans will be allowed.

All exposed concrete edges shall have a 3" chamfer unless otherwise shown or noted. Smoothing of the undersides of the deck will not be required if a smooth and uniform finish acceptable to the Engineer is otherwise obtained.

A standby vibrator shall be provided at the site to vibrate the edges of any working vibrator breaking down.

All reinforcing steel bars shall conform to ASTM Spec A615-69.

The Contractor may at his option, and at no expense to the State, cut all reinforcement bars to allow for full 6" outside construction joint of the cast-in-place concrete.

Reinforcement in bottom of slab shall be supported on approved material so spacers. Steel in top of slab shall be supported on approved material high chairs at appropriate locations.

QUANTITIES		
Item	Unit	To-Go
Class 'AA' Concrete	Cu.Yd.	133.2
Reinforcing Steel	Wt.	69.29
Handrailing	L.F.	80.25
6" Black Plastic Sizing	L.F.	171.2

BAR LIST									
Mark	No.	Size	Form	Length	Mark	No.	Size	Form	Length
L ₁	16	3/4"	Sfr	19'0"	L ₁₅	20	1 1/2"	Sfr	28'0"
L ₂	11	3/4"	Sfr	31'5"	L ₁₆	12	1 1/2"	Sfr	30'0"
L ₃	68	3/4"	Sfr	35'2"	T ₁	45	3/4"	Sfr	30'0"
L ₄	16	1 1/4"	Sfr	10'7"	T ₂	130	1 1/2"	Sfr	30'0"
L ₅	52	3/4"	Sfr	43'6"	T ₃	60	3/8"	Sfr	2'0"
L ₆	16	3/8"	Sfr	17'0"	S ₁	105	1 1/2"	100%	2'0"
L ₇	12	3/4"	Sfr	31'5"	S ₂	105	1 1/2"	30%	2'0"
L ₈	46	1" B	Sfr	31'6"	F	130	1 1/2"	P	4'0"
L ₉	44	1" B	Sfr	36'8"					
L ₁₀	3	1" B	Sfr	21'4"					
L ₁₁	3	1 1/2"	Sfr	17'0"					
L ₁₂	46	1 1/2"	Sfr	28'0"					
L ₁₃	27	1 1/2"	Sfr	36'0"					
L ₁₄	50	3/4"	Sfr	27'0"					

OKLAHOMA STATE HIGHWAY COMMISSION
OKLAHOMA CITY, OKLAHOMA

DETAILS OF SUPERSTRUCTURE

STR. NO. 6

☒ STA ON ☒ SURVEY 53+36.10

STR. NO 9

☒ STA ON ☒ SURVEY 106+22.29

F.A. PROJ 1- 381 (16)PT

[illegible]

4.0'

4.0'

Slope 1:5

Slope 1:5

Slope 1:5

Slope 1:5

4.0'

4.0'

4.0' is given on right side of center point

9' 6"

1'

Notes: 1) for Top of Cur'd Elev. said 0.79' to top of Slab Elev.

OKLAHOMA STATE HIGHWAY COMMISSION OKLAHOMA CITY, OKLAHOMA STRUCTURE No. 6 DETAIL OF SLAB ELEVATIONS @ STA. ON @ SURVEY 53+36.10 F.A. PROJ. 1-381 (16) PT.-1	RECEIVED FILED BY DATE DESIGNED CHECKED TRACED (DATE) CHECKED X 44 APPROVED DATED 3-29-44
---	--

DESIGN DATA

Concrete 4000 psi
 Reinf. Steel 60,000 psi
 Design Live Load HS20-44
 Foundation Loads 25.4 Ton/pile
 Abutments 3.2 Ton/pile

SUMMARY OF QUANTITIES

ITEM	ITEM	UNIT	Abut.	Piers	Spurs	Bridge	Qty.
202.06d	Class 'D' Excavation	C.Y.					200
302.06a	4" Sand Cushion	S.Y.					175.8
14.06d	Approach Slabs	S.Y.					175.8
501.06a	Substr. Excav. - Common	C.Y.	60	420			500
501.06a	Substr. Excav. - Rock	C.Y.					21
505.06	Steel - Handling	L.F.				214.91	214.91
505.06	Structural Steel	Lbs.				1353.5	1353.5
509.06a	Class 'A' Concrete	C.Y.				103.2	103.2
509.06a	Class 'A' Conc. in Pier Bases	C.Y.				63.4	63.4
509.06a	Class 'A' Concrete	C.Y.				128.8	128.8
51.06	Reinforcing Steel	Lbs.	3355	13470		3401	3401
51.06	Reinforcing Steel	L.F.	678			819	819
51.06	Reinforcing Steel	L.F.				64	64
51.06	Reinforcing Steel	L.F.				355.6	355.6
51.06	Reinforcing Steel	L.F.				112.2	112.2

GENERAL NOTES

- All construction materials shall be in accordance with Oklahoma Standard Specifications for Highway Construction.
 - All exposed concrete surfaces shall have a sandblasted finish.
 - Reinforcing steel bars shall conform to ASTM Specification A615-49.
 - Bars shall be bent using cold bending equipment to control dimensions.
 - Bars shall be bent in accordance with the following table:
- | Bar Size | Minimum Bend Radius |
|-----------------|---------------------|
| 1/2" - 3/4" | 12" (12D) |
| 7/8" - 1" | 16" (16D) |
| 1 1/8" - 1 1/2" | 20" (20D) |
| 1 3/4" - 2" | 24" (24D) |
- Reinforcing steel shall be bent in accordance with the above table.
 - Bars shall be bent in accordance with the following table:
- | Bar Size | Minimum Bend Radius |
|-----------------|---------------------|
| 1/2" - 3/4" | 12" (12D) |
| 7/8" - 1" | 16" (16D) |
| 1 1/8" - 1 1/2" | 20" (20D) |
| 1 3/4" - 2" | 24" (24D) |

REFERENCE LIST OF CHANGES

- DETAILS OF ABUTMENTS 3-25-55
- DETAILS OF PIERS 3-25-55
- DETAILS OF SUPERSTRUCTURE 3-25-55
- DETAILS OF APPROACH SLABS 3-25-55
- DETAILS OF HANDRAILING 3-25-55

SKREW 80°-00' RT. FWD.

OKLAHOMA STATE HIGHWAY COMMISSION
 STR. NO. 7
 GENERAL ELEVATION, PLAN
 & SUMMARY OF QUANTITIES
 35'-45'-56'-56'-45'-35'-I-BM. SPANS
 38' RDY. & 1'-18" S.C. & 1'-4" MEDIAN
 STA. ON C SURVEY 79+81.92
 FA. PROJ. I-381 (16) PT.-2






GENERAL ELEVATION

Scale: 1" = 20'

- 1320 See General Provisions for details of concrete construction.
- 1290 Reinforcing steel shall be bent in accordance with the following table:
- 1270 Reinforcing steel shall be bent in accordance with the following table:
- 1260 Reinforcing steel shall be bent in accordance with the following table:



REVISION	DESCRIPTION	BY	DATE
1	As per design	J. P.	1-19-55

NO. ROAD DIST. NO.	STATE	PROJ. NO.	SHEET NO.	TOTAL SHEETS
6	OKLA.	79+81.92	49	53

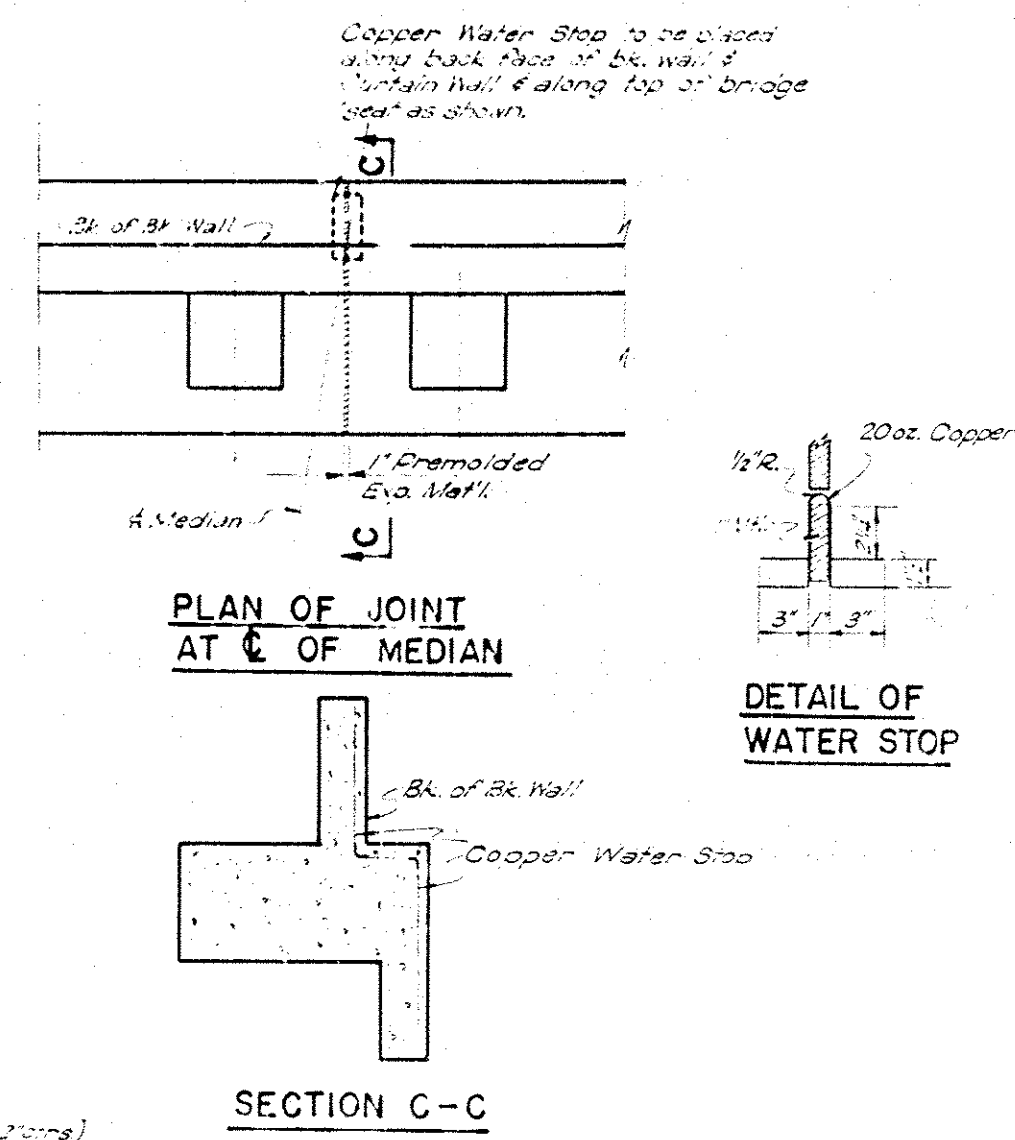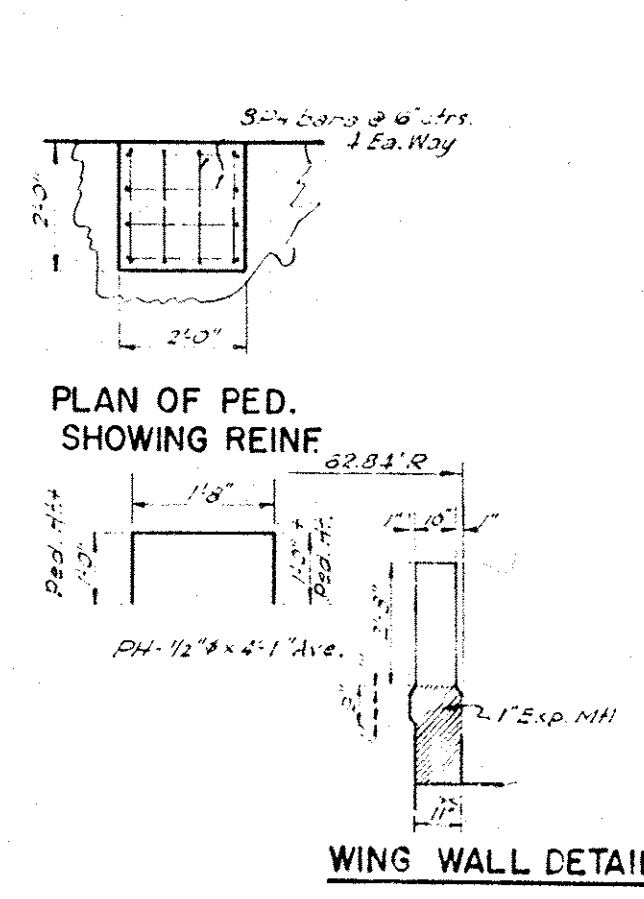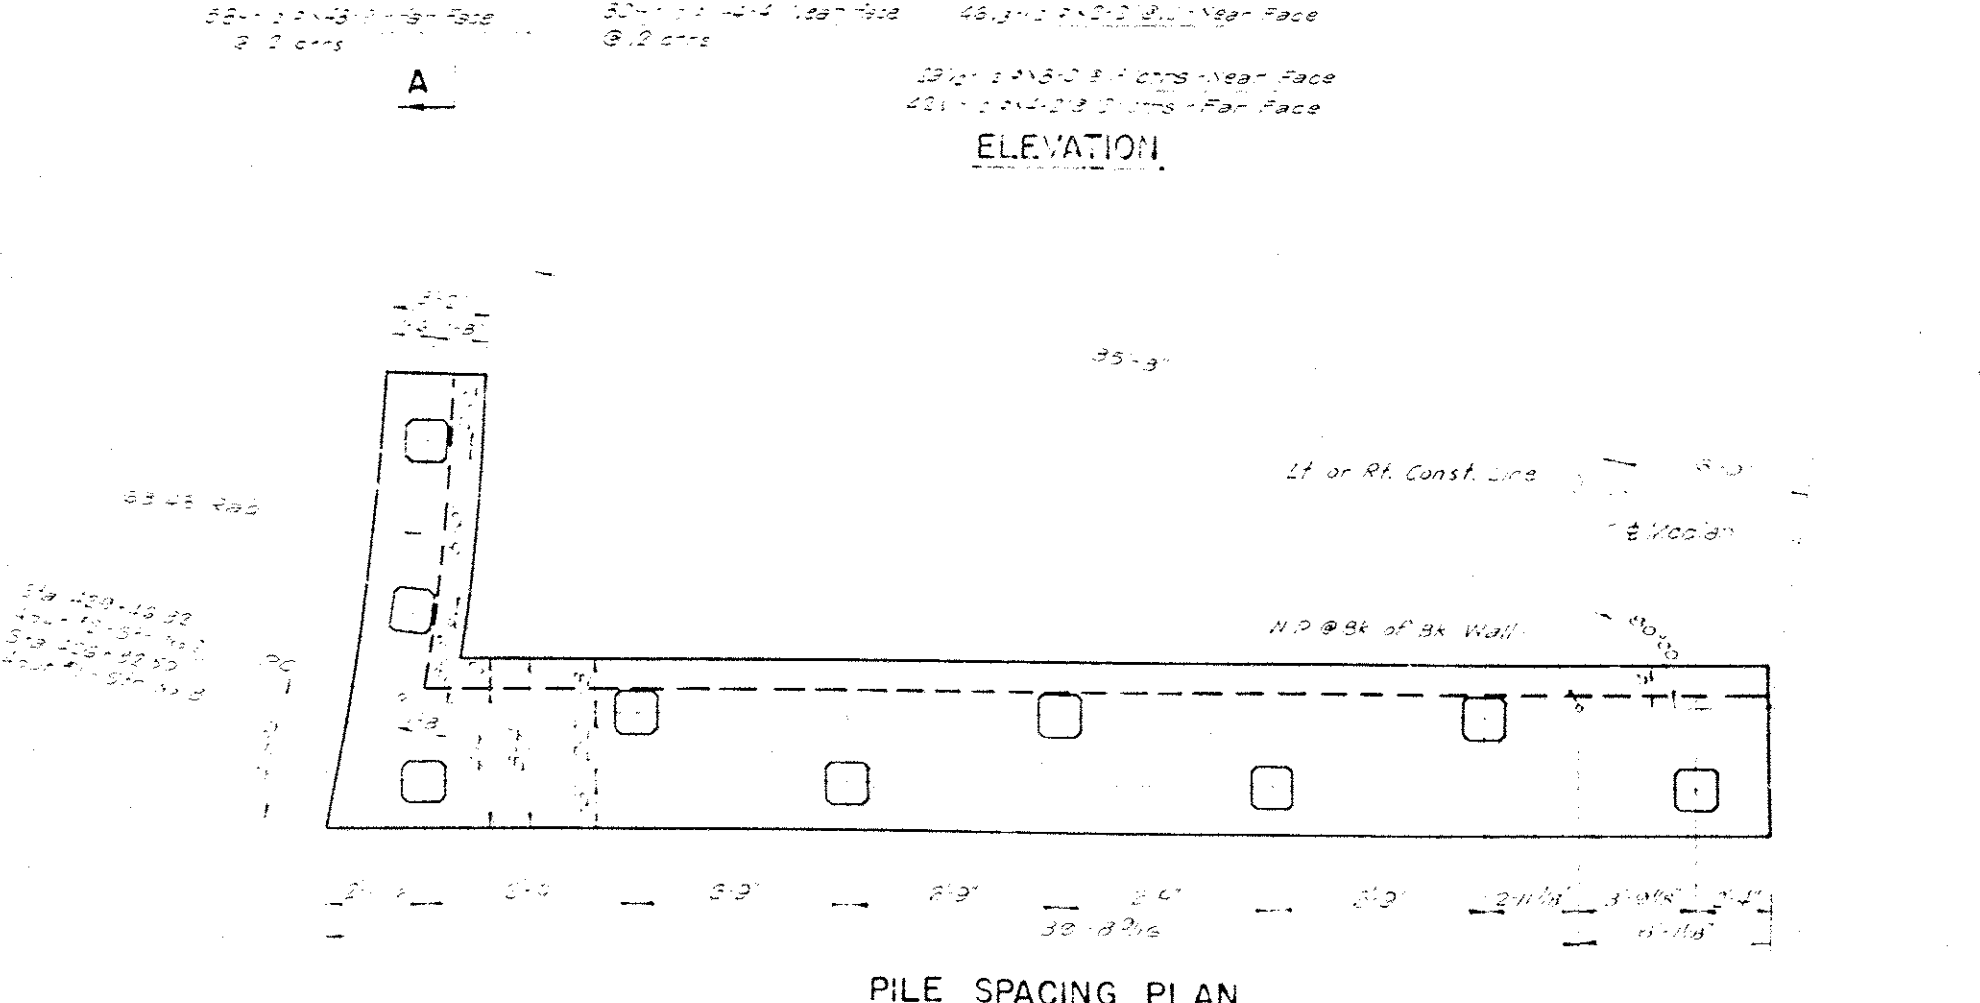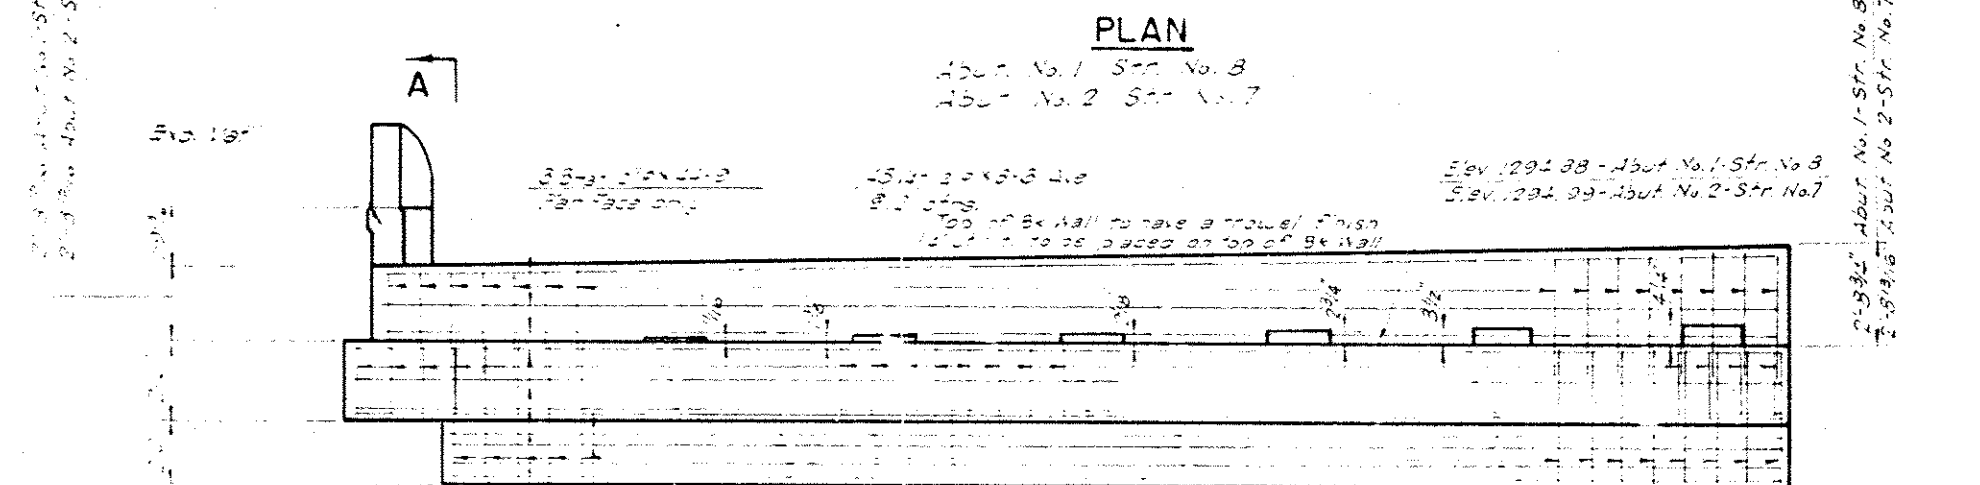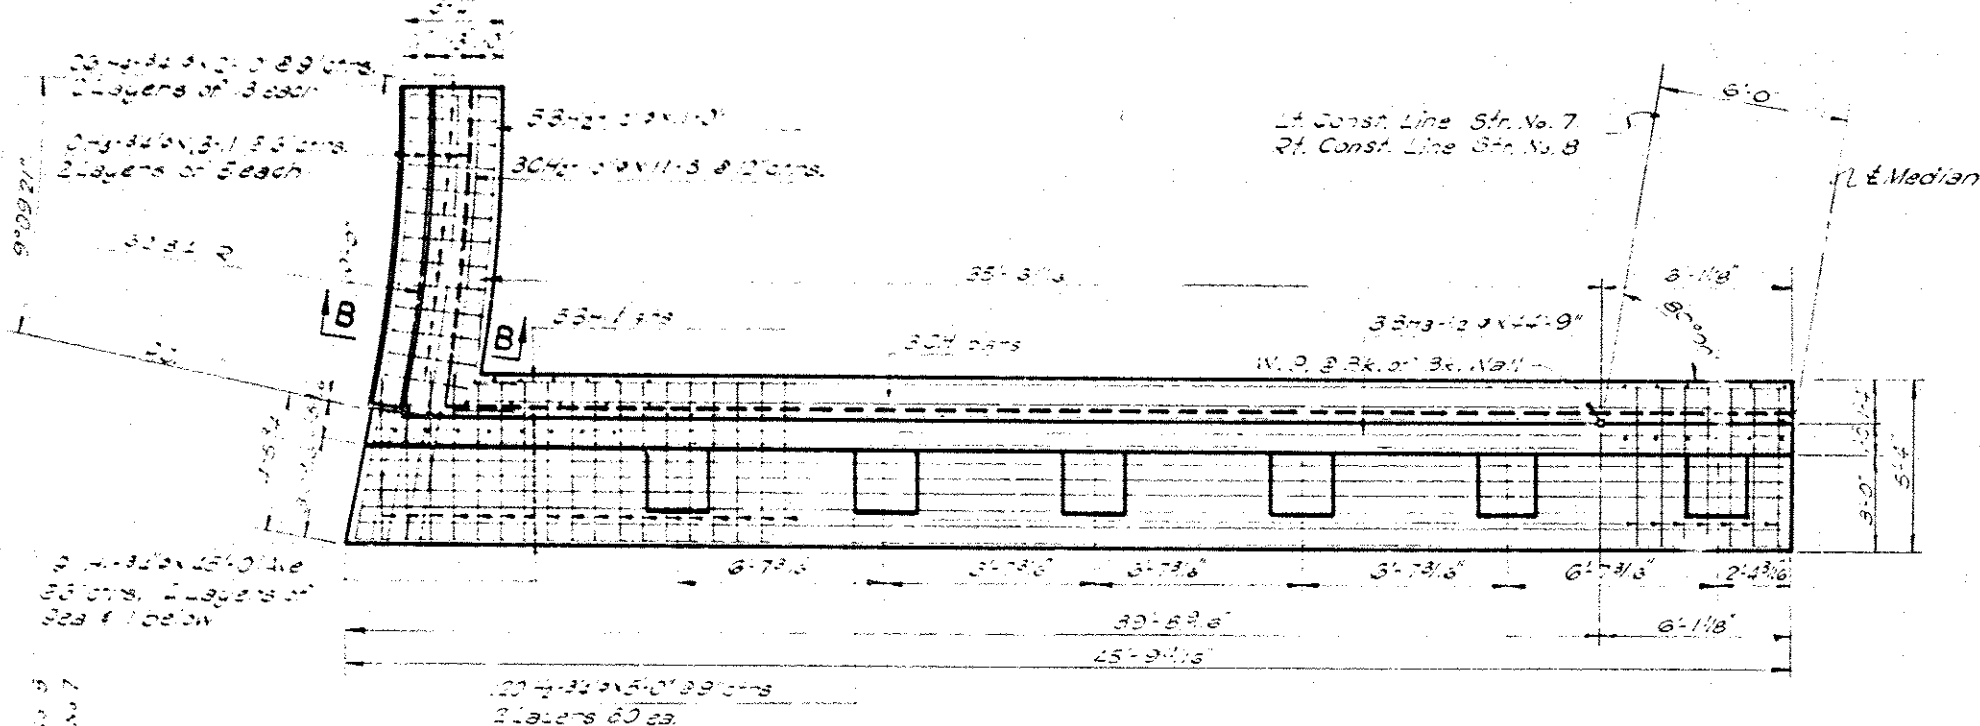

BAR LIST-ONE ABUT.				
Bar	No.	Size	Form	Length
1	9	3/4"	Str.	45'-0"
2	120	3/4"	Str.	5'-0"
3	10	3/4"	Str.	3'-0"
4	20	3/4"	Str.	3'-0"
5	32	3/4"	Str.	4'-0"
6	38	3/4"	Str.	3'-0"
7	48	3/4"	Str.	2'-0"
8	48	3/4"	Str.	3'-0"
9	5	3/4"	Str.	13'-9"
10	5	3/4"	Str.	11'-0"
11	3	3/4"	Str.	14'-0"
12	3	3/4"	Str.	14'-0"
QUANTITIES-ONE ABUTMENT		
Concrete	100	100
Reinforcing Steel	100	100
Grout	100	100

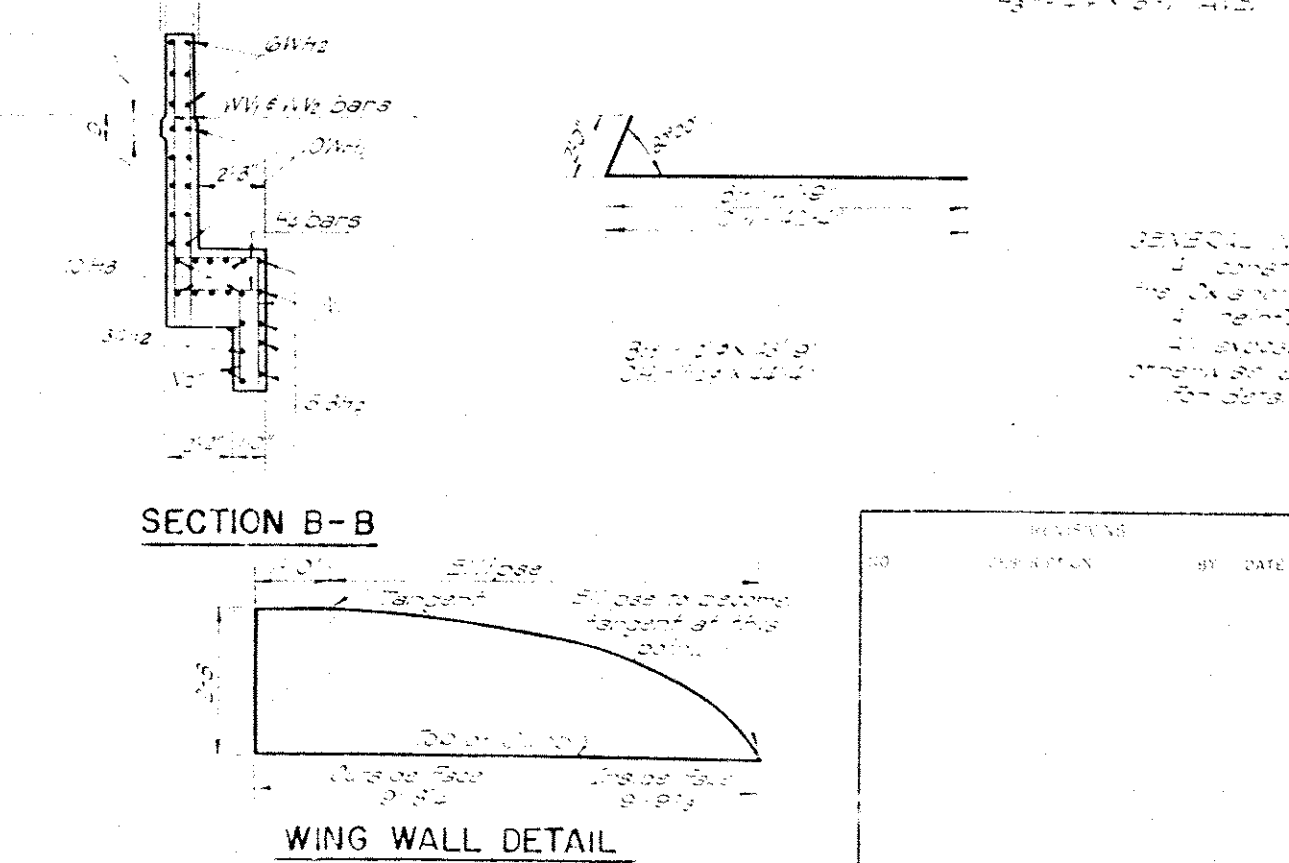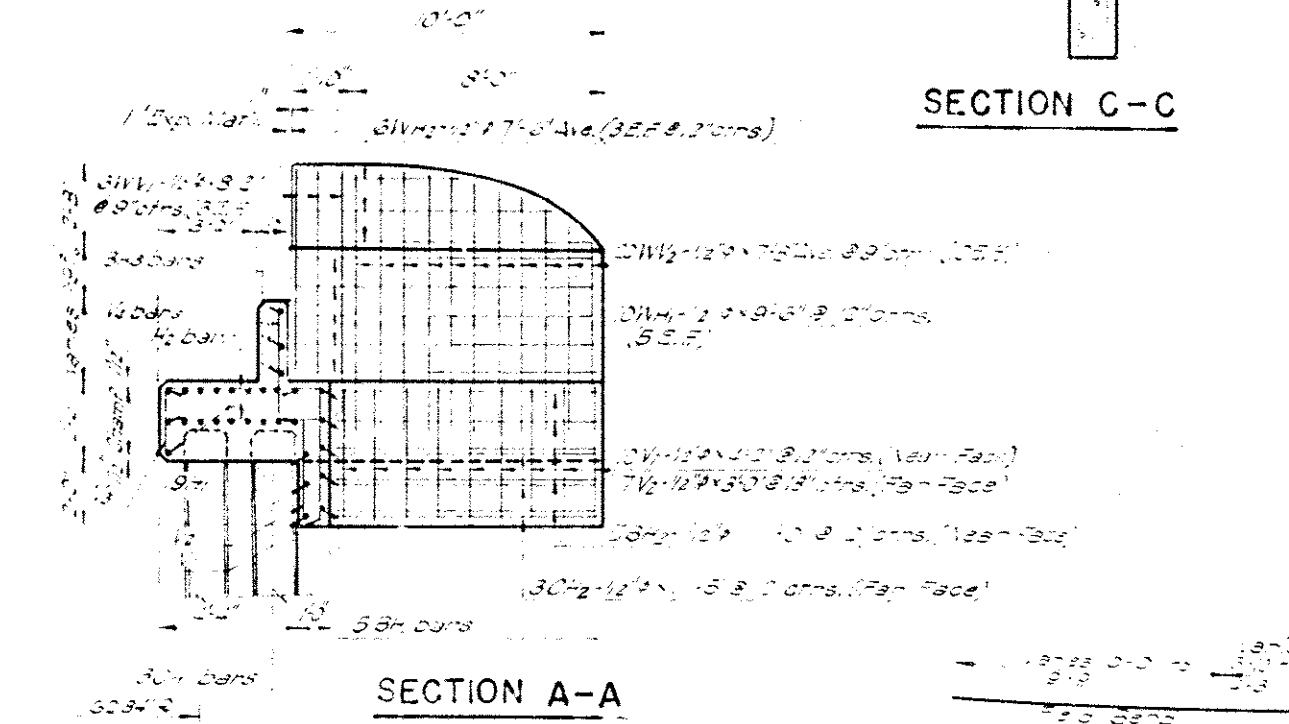


GENERAL NOTES:
1. Construction of abutments and wing walls shall conform to the specifications of the Oklahoma State Highway Commission.
2. The abutments and wing walls shall be constructed of concrete.
3. The abutments and wing walls shall be constructed of concrete.
4. The abutments and wing walls shall be constructed of concrete.
5. The abutments and wing walls shall be constructed of concrete.

REVISIONS		RECORD		OKLAHOMA STATE HIGHWAY COMMISSION	
NO.	DESCRIPTION	BY	DATE	ITEM	DATE
1	DESIGN			DESIGN	
2	DETAIL			DETAIL	
3	TRACED			TRACED	
4	CHECKED			CHECKED	
5	APPROVED			APPROVED	
6	DESIGNED			DESIGNED	


NOTE: Spacing same for all pier tops

* Pier Base Reinf. listed separately


BAR LIST - ONE PIER				
Mark No.	Size	Form	Length	
H1	4	1"Ø	Hooked	45'-4"
H2	3	1 1/8"	Hooked	12'-0"
H3	4	1 1/8"	Str.	33'-2"
H4	4	1 1/2"	Str.	42'-6"
H5	3	3/4"	Str.	8'-6"
BH1	20	1/2"	Bnt.	4'-9"
BH2	4	1/2"	Bnt.	6'-0"
WH1	4	1/2"	Str.	38'-9"
WH2	6	3/4"	Str.	39'-5"
WV	25	1/2"	Bnt.	12'-5"
S1	41	1/2"	Bnt.	12'-5"
S2	6	1/2"	Str.	11'-3"
D	36	3/4"	Bnt.	5'-0"
PH1	39	1/2"	Bnt.	3'-10"
PH2	24	1/2"	Bnt.	4'-10"
PH3	4	1 1/2"	Bnt.	3'-2"
PH4	42	1/2"	Bnt.	3'-10"
PH5	28	1/2"	Bnt.	4'-10"
PH6	24	1/2"	Bnt.	4'-10"
PH7	36	1/2"	Bnt.	4'-10"
PH8	36	1/2"	Bnt.	4'-10"
PH9	36	1/2"	Bnt.	4'-10"
PH50	36	1/2"	Bnt.	4'-10"

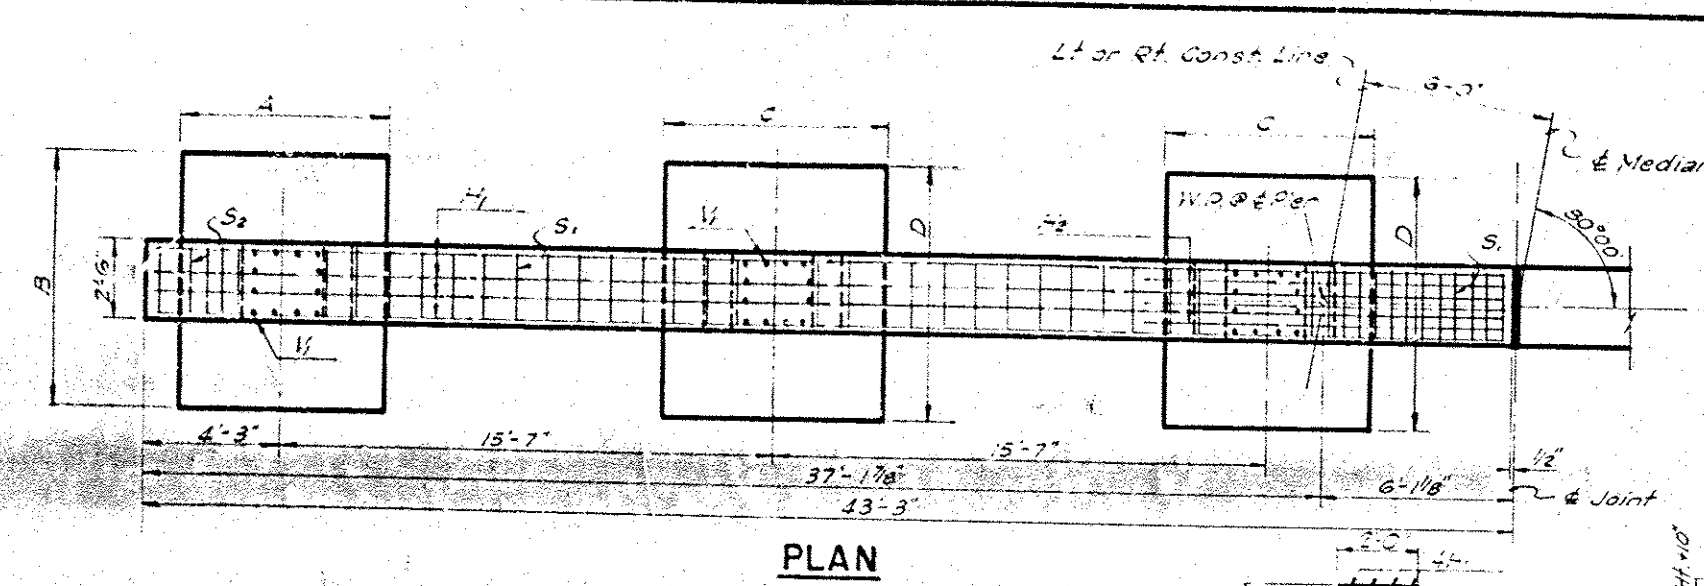

BRNG. PEDESTAL DETAIL

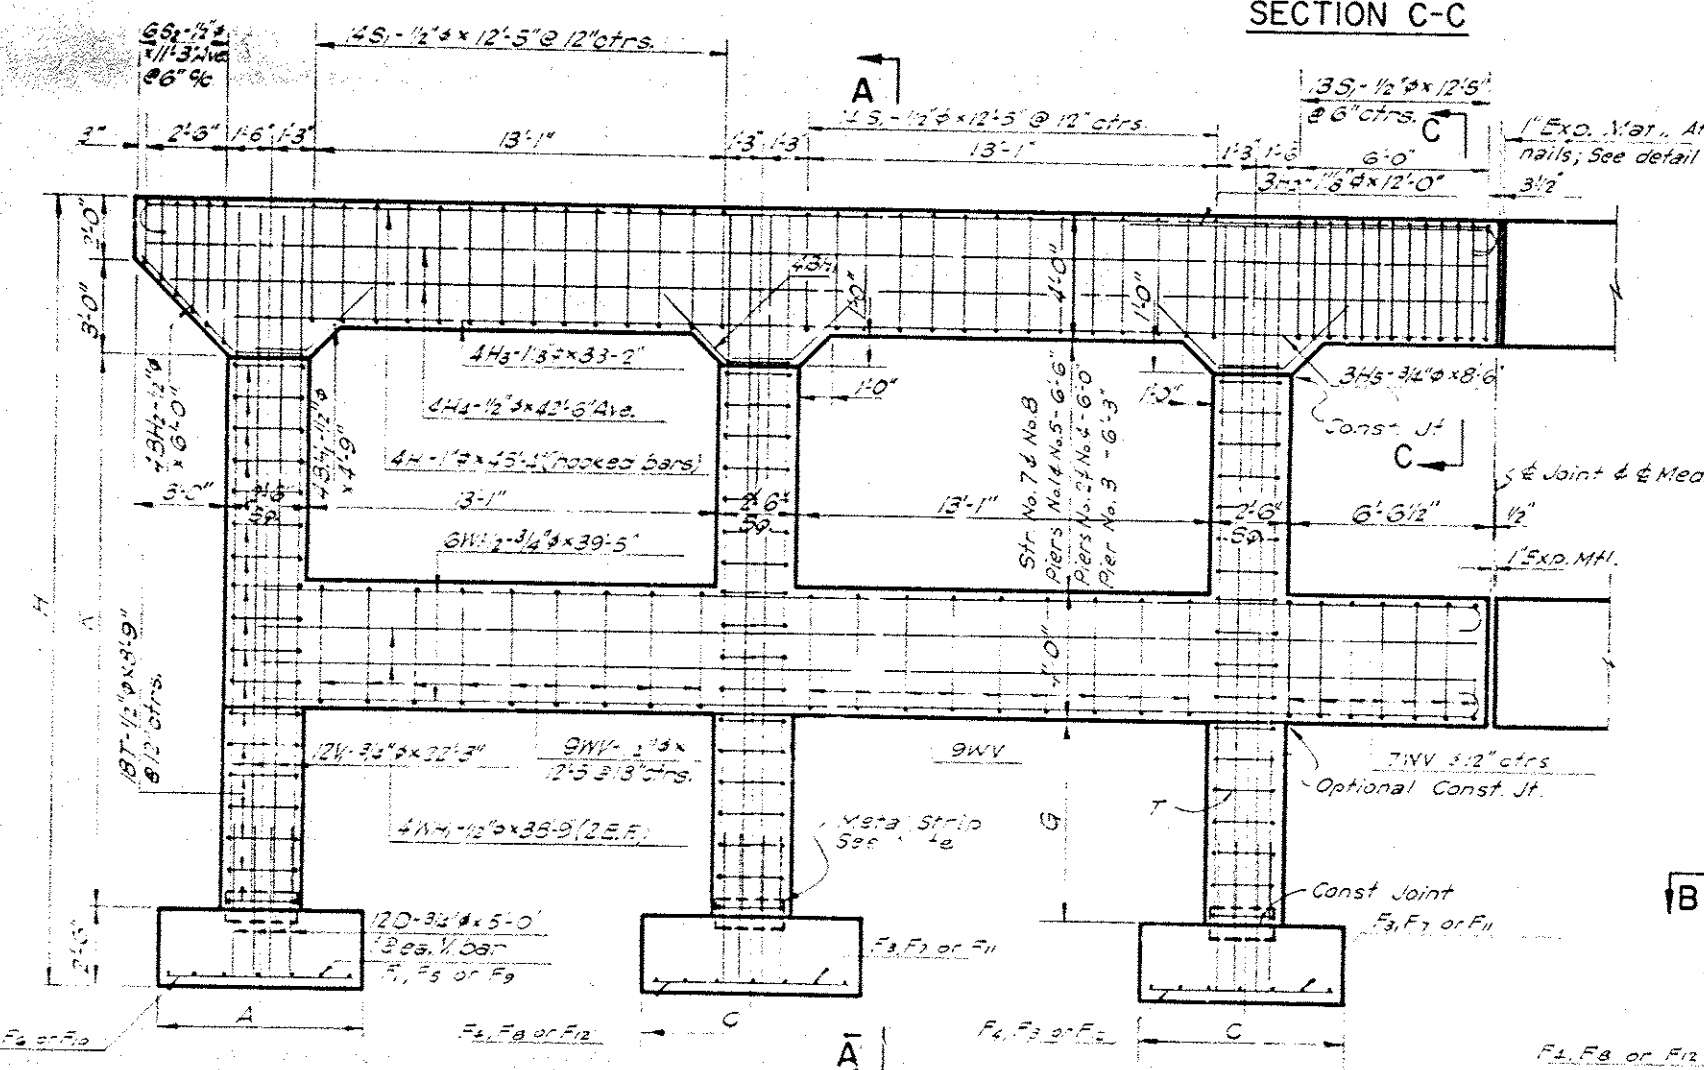


ELEVATION

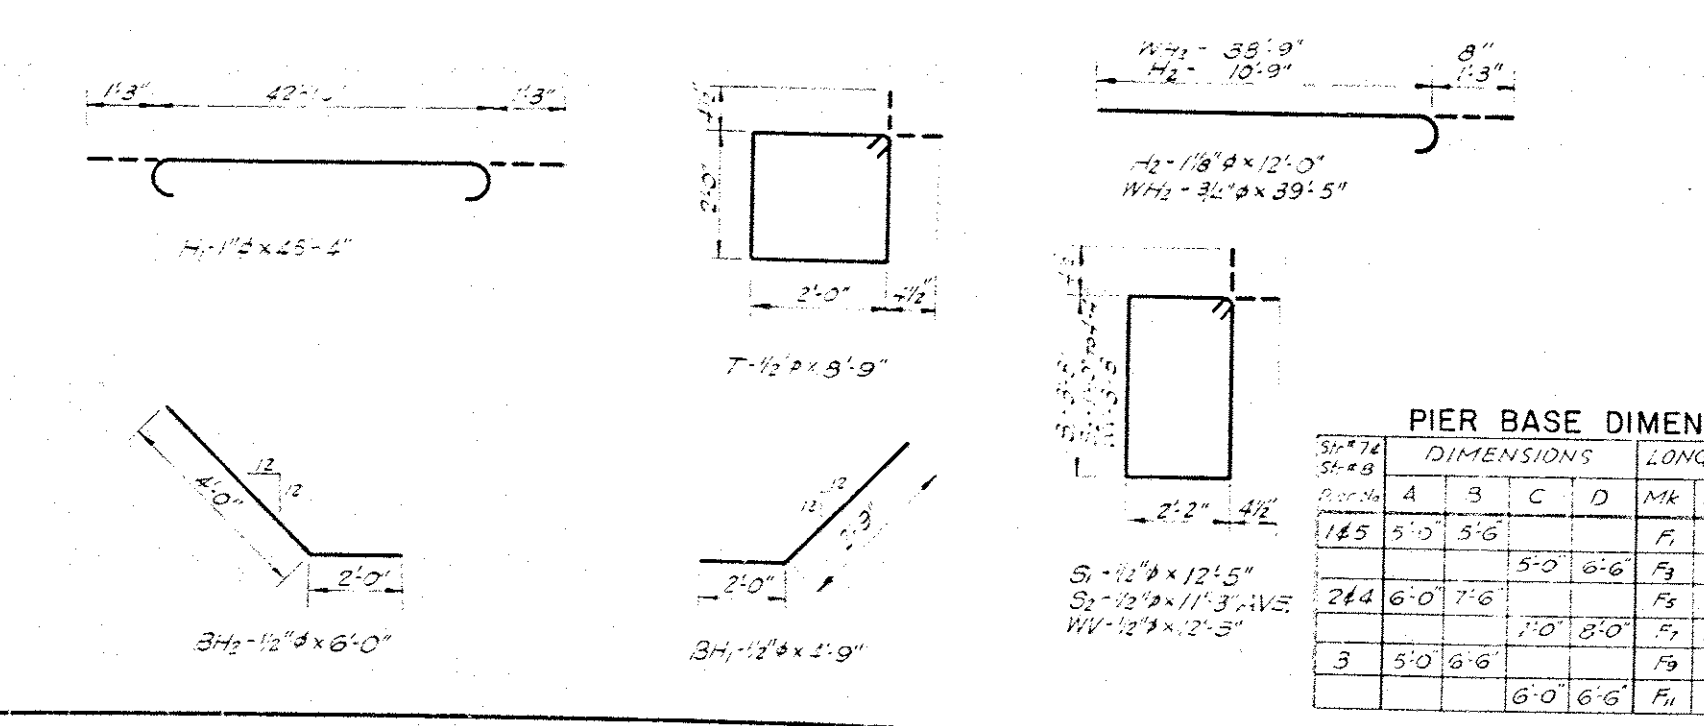

SECTION A-A

SECTION B-B

PIER BASE DIMENSIONS AND REINFORCING									
NO.	MARK	NO.	SIZE	SPAC.	LENGTH	NO.	MARK	NO.	SIZE
185	5'-0"	5'-0"	5'-0"	6'-0"	6'-0"	185	5'-0"	5'-0"	5'-0"
244	6'-0"	7'-6"	7'-6"	7'-6"	7'-6"	244	6'-0"	7'-6"	7'-6"
3	5'-0"	6'-6"	6'-6"	6'-6"	6'-6"	3	5'-0"	6'-6"	6'-6"

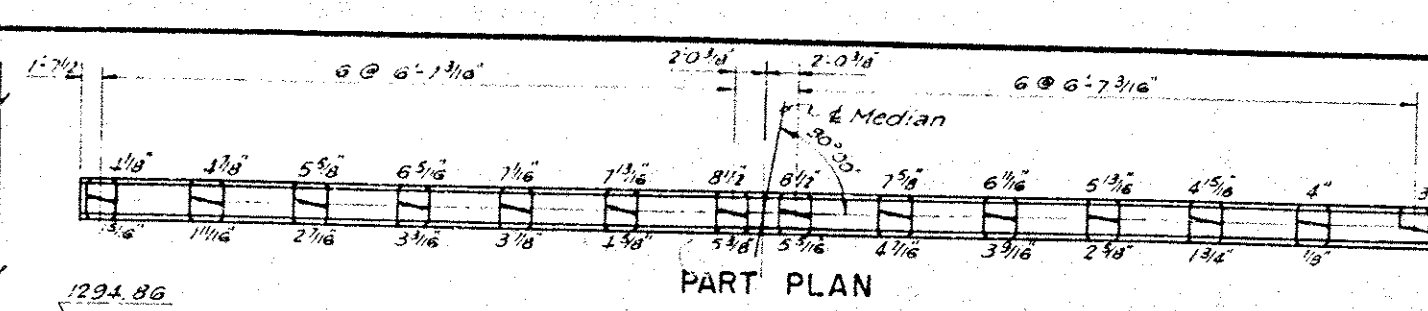

PART PLAN

PART ELEV.

PIER NO. 5 - STR. NO. 7

PIER NO. 5 - STR. NO. 8

PART PLAN

PART ELEV.

PIER NO. 4 - STR. NO. 7

PIER NO. 4 - STR. NO. 8

PART PLAN

PART ELEV.

PIER NO. 3 - STR. NO. 7

PIER NO. 3 - STR. NO. 8

PART PLAN

PART ELEV.

PIER NO. 2 - STR. NO. 7

PIER NO. 2 - STR. NO. 8

PART PLAN

PART ELEV.

PIER NO. 1 - STR. NO. 7

PIER NO. 1 - STR. NO. 8

PART PLAN

PART ELEV.

QUANTITIES - ONE PIER - STRUCTURE No. 7

PIER #1	PIER #2	PIER #3	PIER #4	PIER #5	UNIT	ITEM
4680	4910	4650	4860	4470	Lbs	Reinforcing Steel
408	418	408	408	395	CY	Class A Concrete
36	45	35	45	33	CY	Class A Concrete in Pier Bases
35	120	35	35	33	CY	Substr. Excav. - Common
9	10	7	9	9	CY	Substr. Excav. - Rock

QUANTITIES - ONE PIER - STRUCTURE No. 8

PIER #1	PIER #2	PIER #3	PIER #4	PIER #5	UNIT	ITEM
4680	4910	4650	4860	4470	Lbs	Reinforcing Steel
408	418	408	408	395	CY	Class A Concrete
36	45	35	45	33	CY	Class A Concrete in Pier Bases
35	120	35	35	33	CY	Substr. Excav. - Common
9	10	7	9	9	CY	Substr. Excav. - Rock

VERTICAL DIMENSIONS

NO.	MARK	NO.	SIZE	SPAC.	LENGTH	NO.	MARK	NO.	SIZE
1	2'-0"	3'-6"	7'-6"	7'-6"	7'-6"	1	2'-0"	3'-6"	7'-6"
2	2'-0"	3'-6"	7'-6"	7'-6"	7'-6"	2	2'-0"	3'-6"	7'-6"
3	2'-0"	3'-6"	7'-6"	7'-6"	7'-6"	3	2'-0"	3'-6"	7'-6"
4	2'-0"	3'-6"	7'-6"	7'-6"	7'-6"	4	2'-0"	3'-6"	7'-6"
5	2'-0"	3'-6"	7'-6"	7'-6"	7'-6"	5	2'-0"	3'-6"	7'-6"

REVISIONS

NO.	DESCRIPTION	BY	DATE
1	Revised from I-381(6)PT.2	BY	DATE
2	Revised from I-381(6)PT.2	BY	DATE

RECORD

ITEM	BY	DATE
DESIGN	BY	DATE
DETAIL	BY	DATE
TRACED	BY	DATE
CHECKED	BY	DATE
APPROVED	BY	DATE
SQUAD	BY	DATE

OKLAHOMA STATE HIGHWAY COMMISSION
OKLAHOMA CITY, OKLAHOMA

DETAILS OF PIERS

STR. NO. 7

STA. ON SURVEY 79+81.92



STR. NO. 8

STA. ON SURVEY 79+69.74


F.A. PROJ. I-381(6)PT.2

PROJECT NO. I-381(6)PT.2 SHEET NO. 49

FED. ROAD DIST. NO.	STATE	PROJ. NO.	SHEET NO.	TOTAL SHEETS
6	OKLA.	38(16)PT-2	52	53

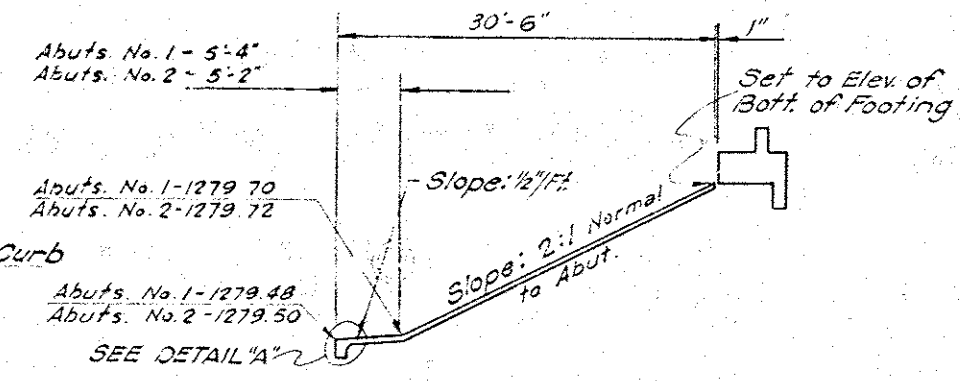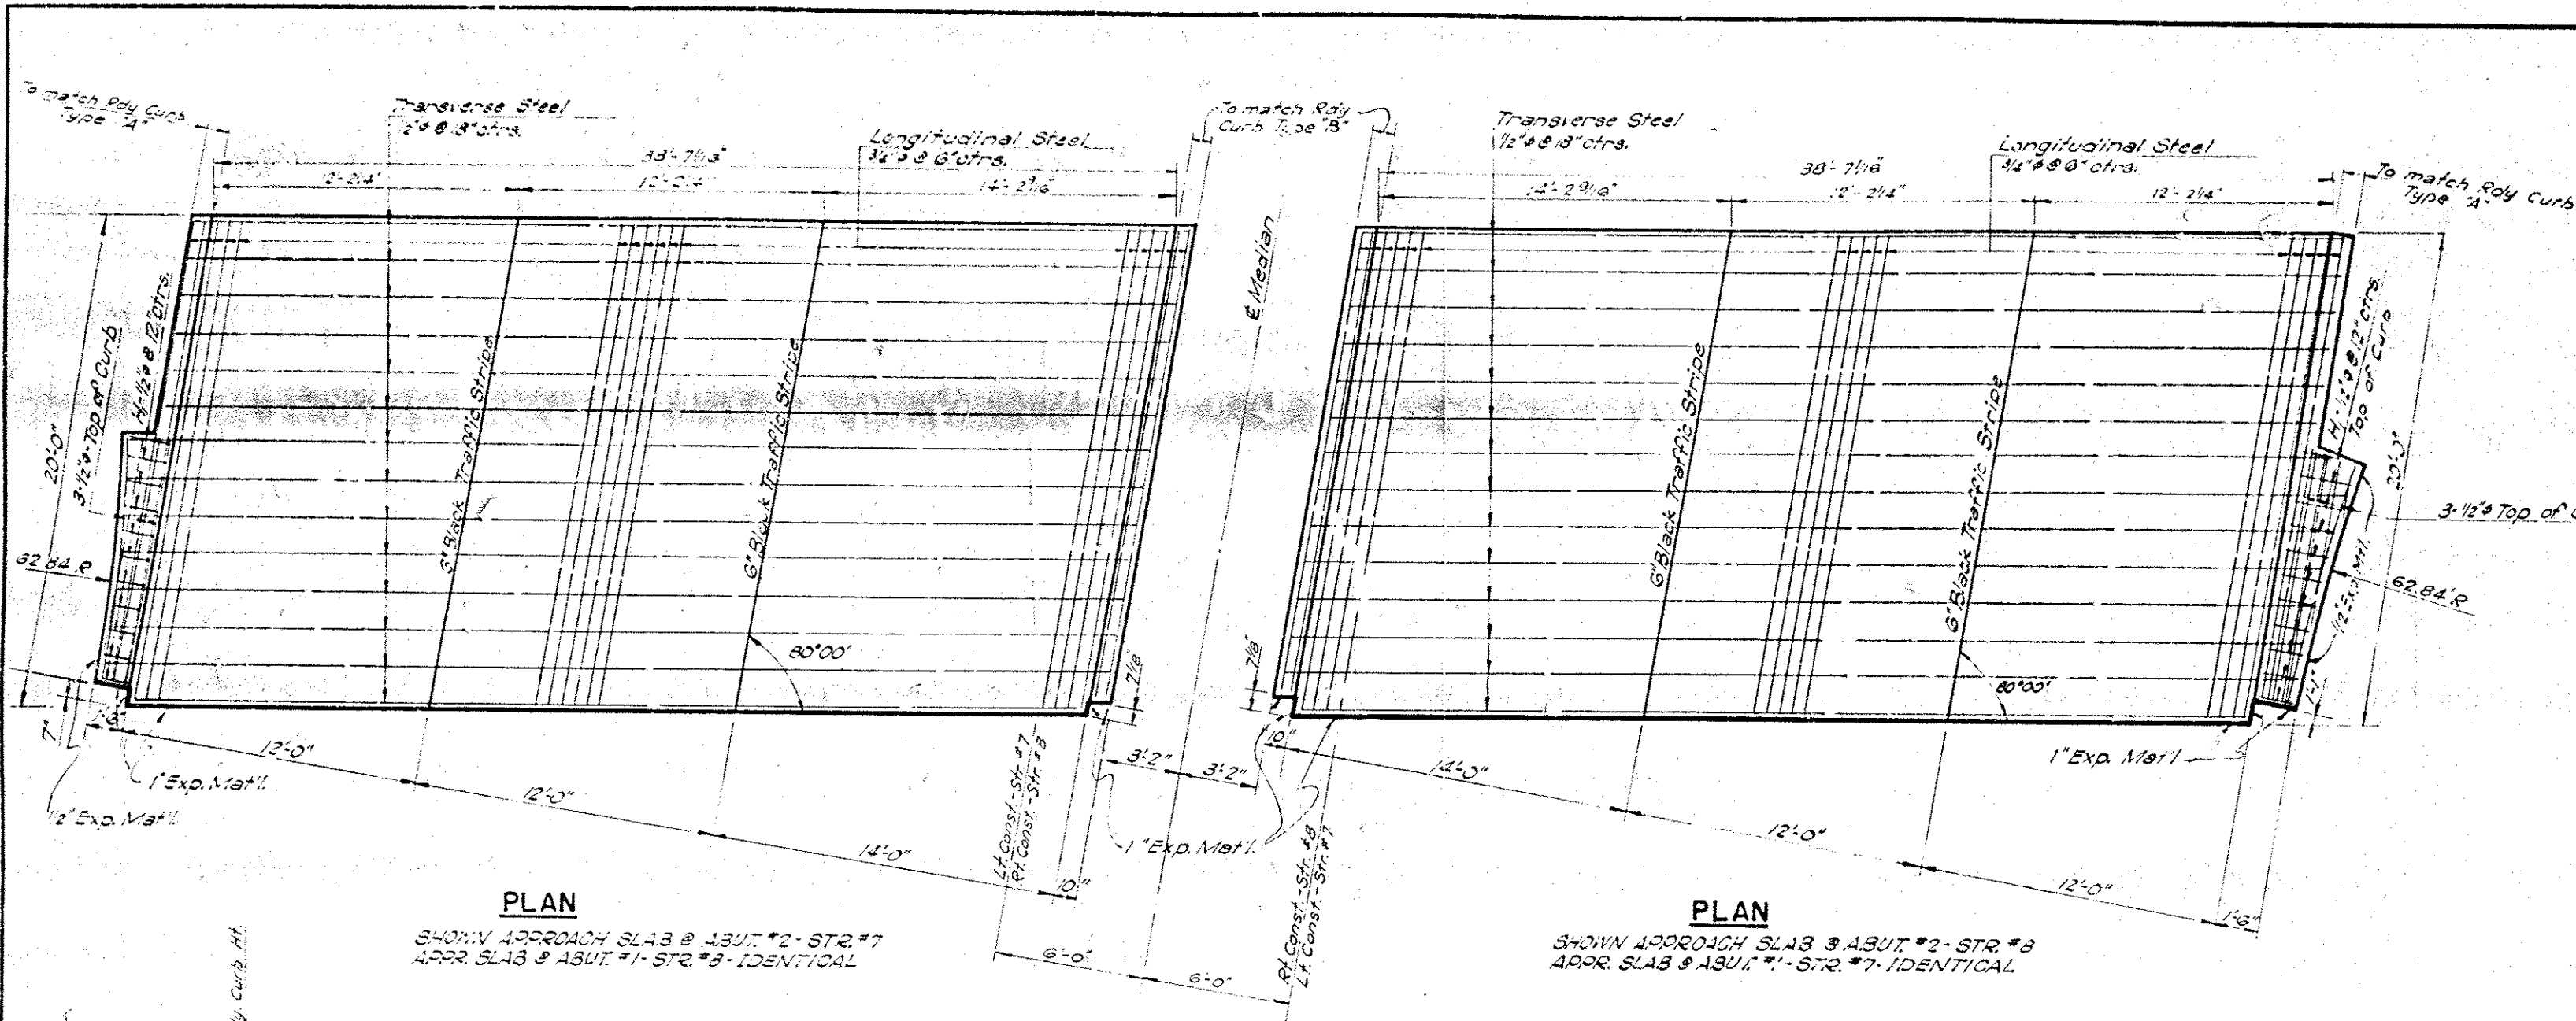

TYPICAL SECTION-CONC. SLOPE WALL

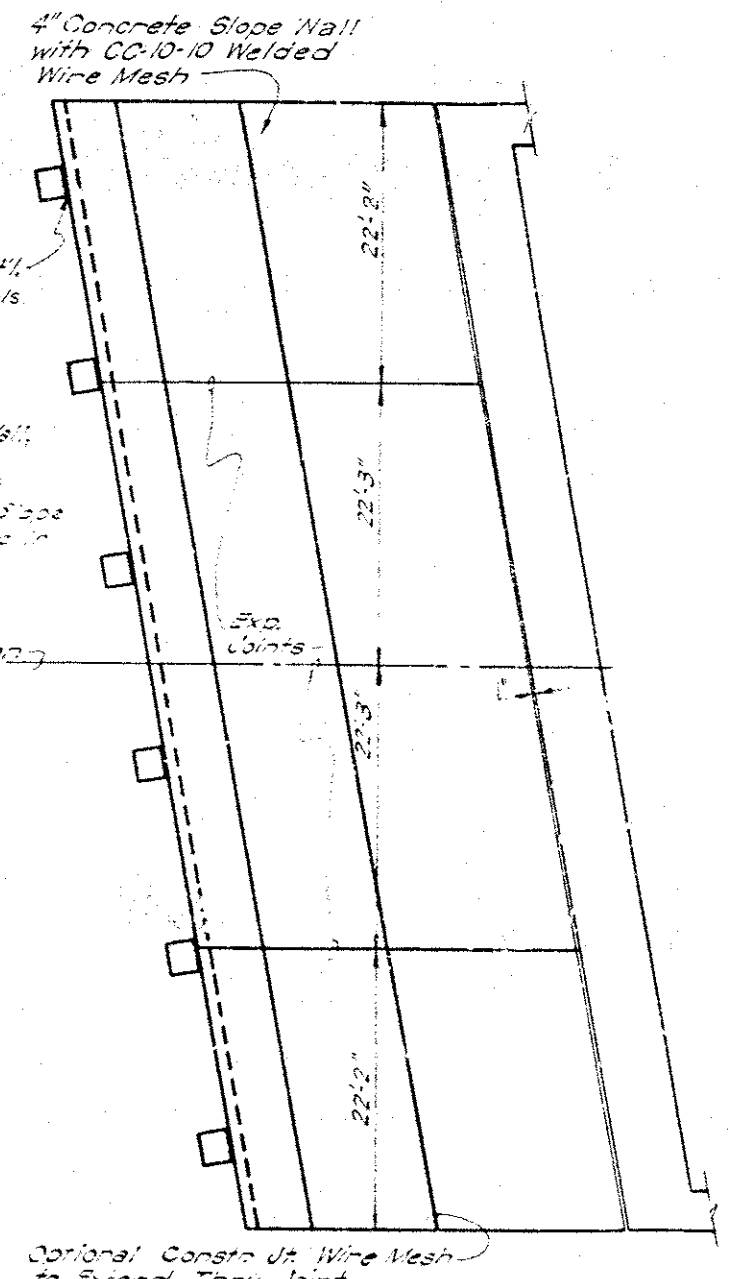

TYPICAL PLAN OF CONCRETE SLOPE WALL


PLAN
SHOWN APPROACH SLAB @ ABUT. #2-STR. #7
APPR. SLAB @ ABUT. #1-STR. #8-IDENTICAL

PLAN
SHOWN APPROACH SLAB @ ABUT. #2-STR. #8
APPR. SLAB @ ABUT. #1-STR. #7-IDENTICAL

END VIEW

QUANTITIES-ONE APPROACH SLAB		
ITEM	UNIT	TOTAL
Approach Slab	Sq.	53.2
Reinforcing Steel *	Lbs.	2890
6\" Black Traffic Strips	L.F.	40

*NOTE: Cost of Reinforcing Steel in Approach Slabs shall be included in the price bid per Sq. Yd. of Appr. Slab.
NOTE: Cost of curbs on Appr. Slabs shall be included in price bid per Sq. Yd. of Appr. Slab.

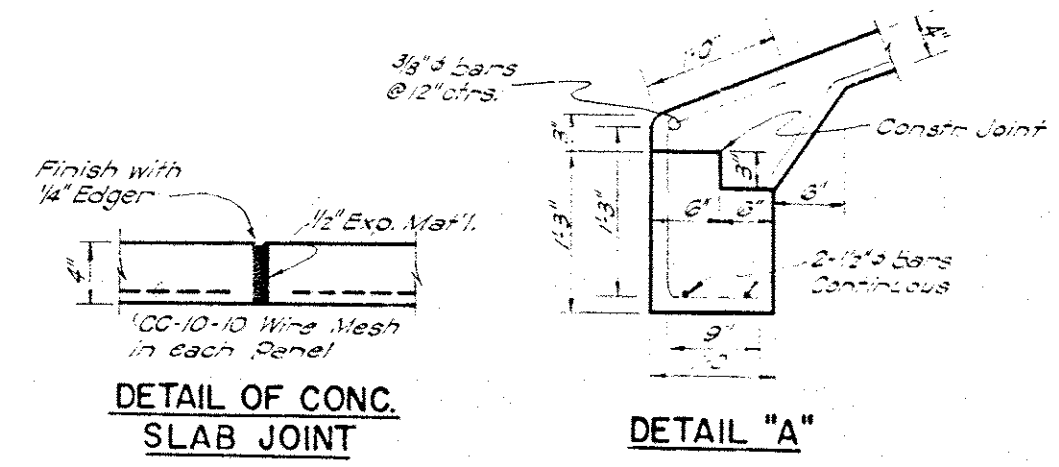

DETAIL OF CONC. SLAB JOINT

DETAIL "A"

REVISIONS			RECORD		OKLAHOMA STATE HIGHWAY COMMISSION OKLAHOMA CITY, OKLAHOMA	
NO.	DESCRIPTION	BY	DATE	ITEM	BY	DATE
				DESIGN		
				DETAIL		
				TRACED	DES	
				CHECKED	DES	
				APPROVED		
				SQUAD	BEV:AM	

DETAILS OF APPROACH SLABS

STR. NO. 7








CL STA. ON CL SURVEY 79+81.92

STR. NO. 8

CL STA. ON CL SURVEY 79+69.74

F.A. PROJ. I-38(16)PT-2

FED. ROAD DIST. NO.	STATE	PROJ. NO.	SHEET NO.	TOTAL SHEETS
6	OKLA.	381(16)PT.	55	59

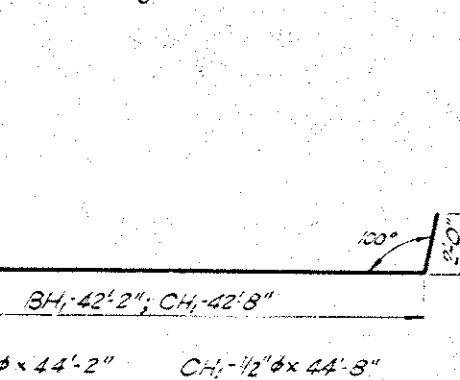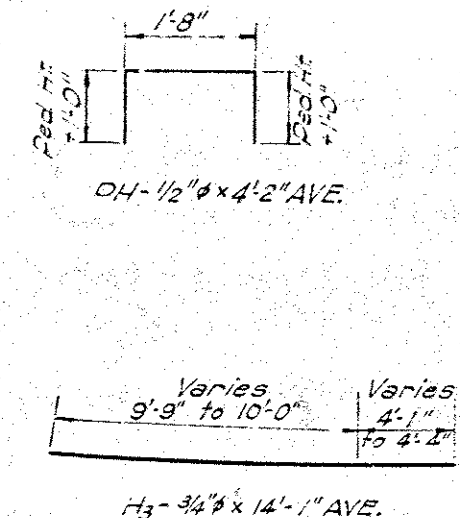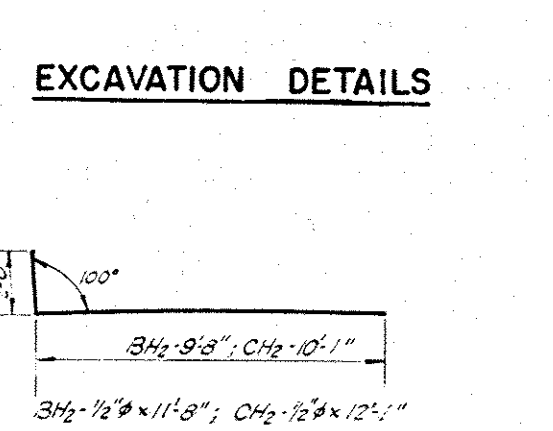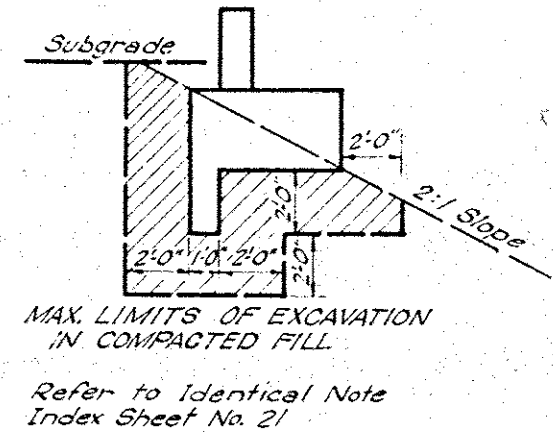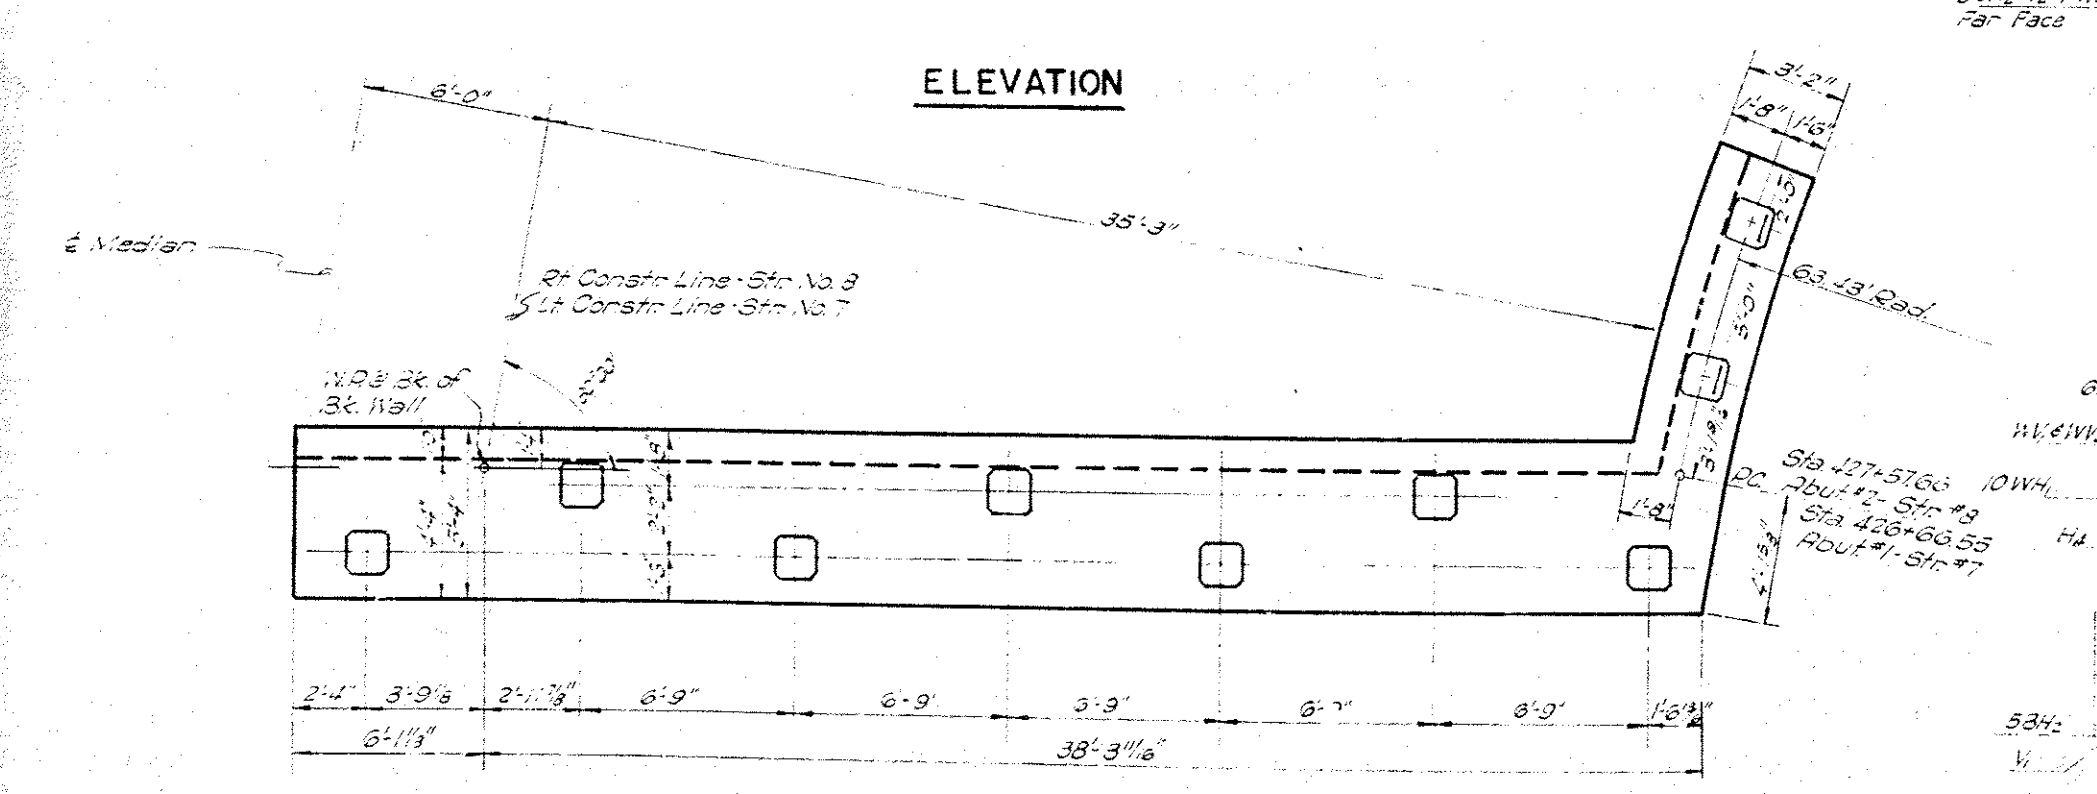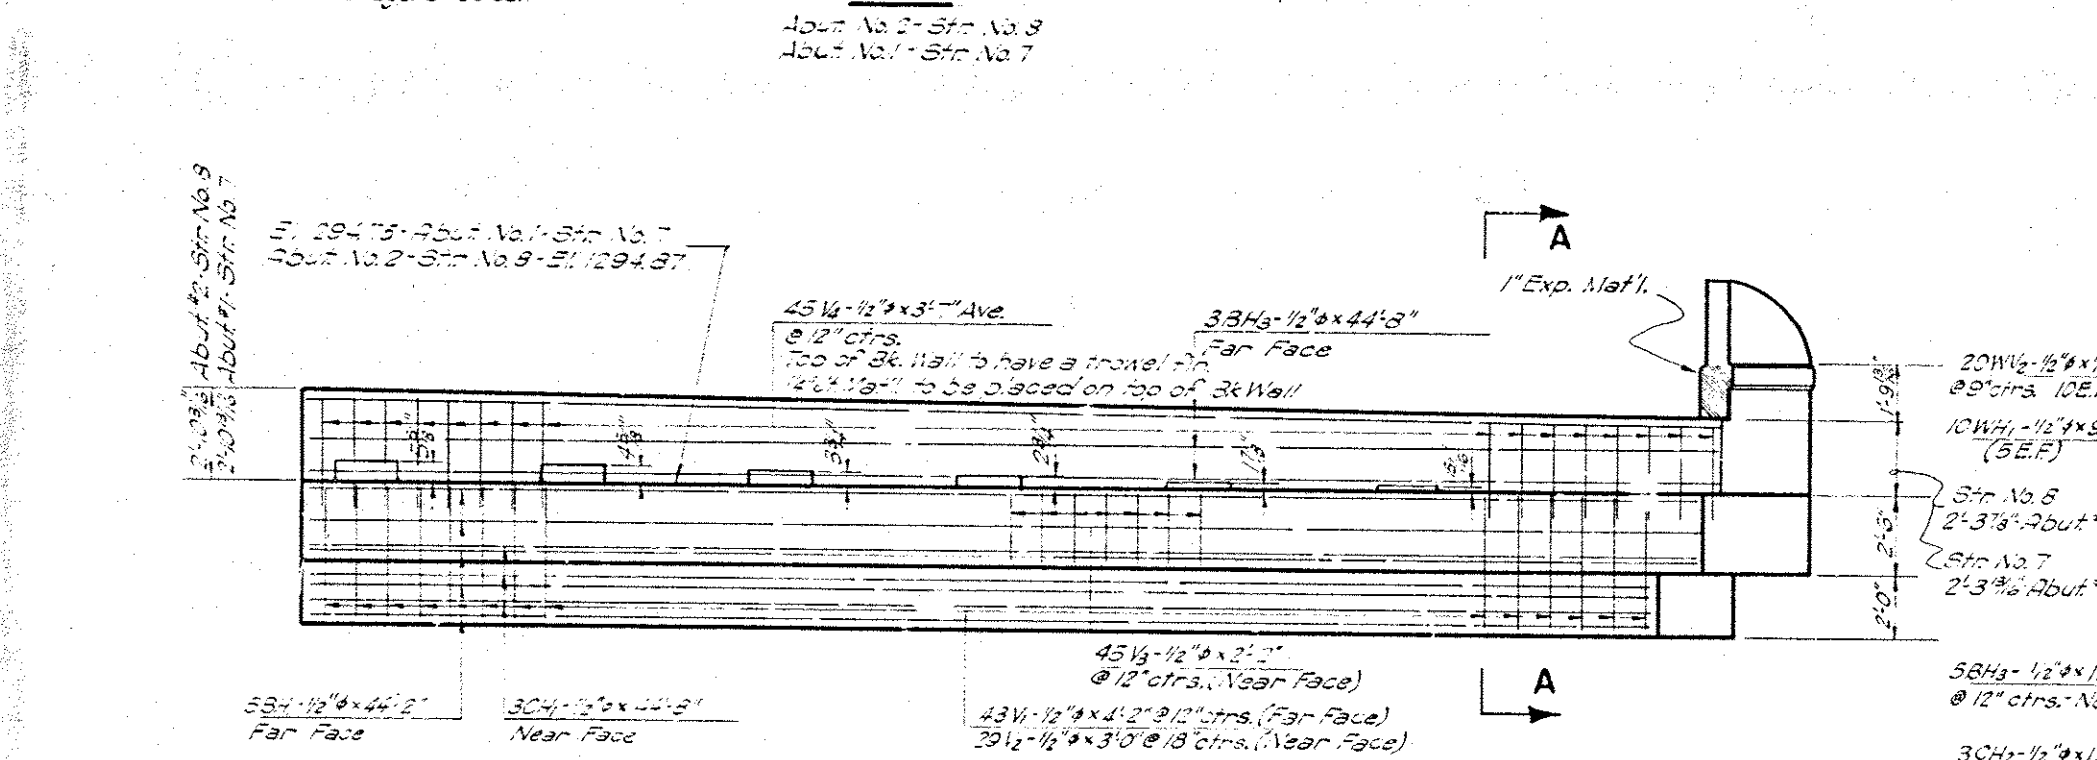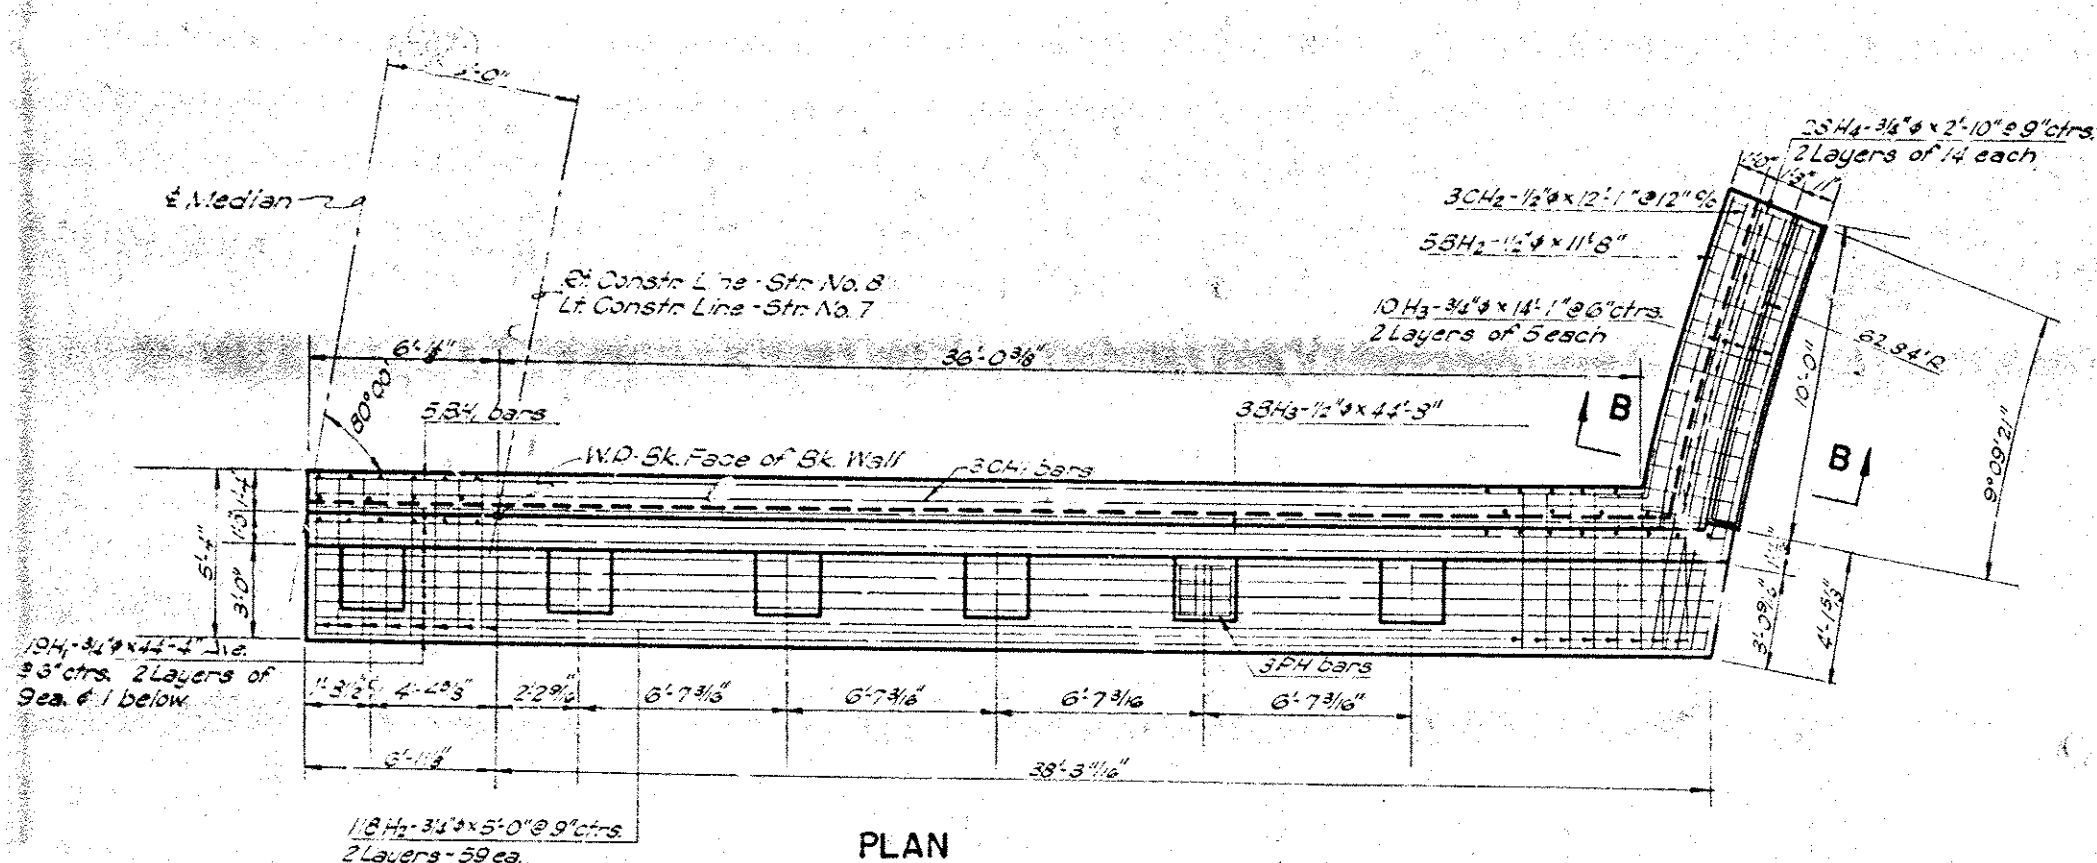

Mark	No.	Size	Form	Length
H1	19	3/4"	Str	44'-4 1/2"
H2	118	3/4"	Str	5'-0"
H3	10	3/4"	Str	14'-1 1/2"
H4	28	3/4"	Str	2'-10"
V1	53	1/2"	Str	1'-2"
V2	36	1/2"	Str	3'-0"
V3	45	1/2"	Str	2'-2"
V4	45	1/2"	Str	3'-7 1/2"
BH1	5	1/2"	Bnt	44'-2"
BH2	5	1/2"	Bnt	11'-8"
BH3	3	1/2"	Str	44'-8"
CH1	3	1/2"	Bnt	44'-8"
CH2	3	1/2"	Bnt	12'-1"
WH1	10	1/2"	Bnt	9'-6"
WH2	6	1/2"	Bnt	7'-6 1/2"
WW1	6	1/2"	Str	8'-2"
WW2	20	1/2"	Str	7'-9 1/2"
PH	48	1/2"	Bnt	4'-2 1/2"
P	18	1/2"	Bnt	3'-8"
H	36	3/4"	Bnt	3'-3"

QUANTITIES-ONE ABUTMENT			
ITEM	UNIT	QTY	PRICE
0.000000 Concrete	CY	35.3	
Rein. Steel	TON	4.170	
Subst. Excav. Common	CY	90	

REVISIONS:

1. Construction materials shall be in accordance with the Oklahoma Standard Specifications of 1954 & Special Provisions.

2. All reinforcing steel bars shall conform to A.S.T.M. Specs. A-305-29.


3. All exposed concrete edges shall have a 3/4" chamfer unless otherwise shown or noted.

4. For details of piling & P & H bars, refer to Std. Dwg. C-90-3.

REVISIONS				RECORD		OKLAHOMA STATE HIGHWAY COMMISSION	
NO	DESCRIPTION	BY	DATE	ITEM	BY	DATE	OKLAHOMA CITY, OKLAHOMA
				DESIGN			DETAILS OF ABUTMENTS ABUT. NO.1- STR. NO.7 ☞ STA. ON ☞ SURVEY 79+81.92 ABUT. NO.2- STR. NO.8 ☞ STA. ON ☞ SURVEY 79+69.74 F.A. PROJ. I- 381 (16) PT-2
				DETAIL			
				TRACED	205		
				CHECKED	202		
				APPROVED			
				SQUAD	65NNAM		

DESIGN DATA

Concrete	1,000 psi.
Reinforcing Steel	18,000 psi.
Design Live Load	H-20-53
Foundation Loads	
Abutments:	0.92 T/sq.Ft.
Piers Direct Load	3.96 T/sq.Ft.

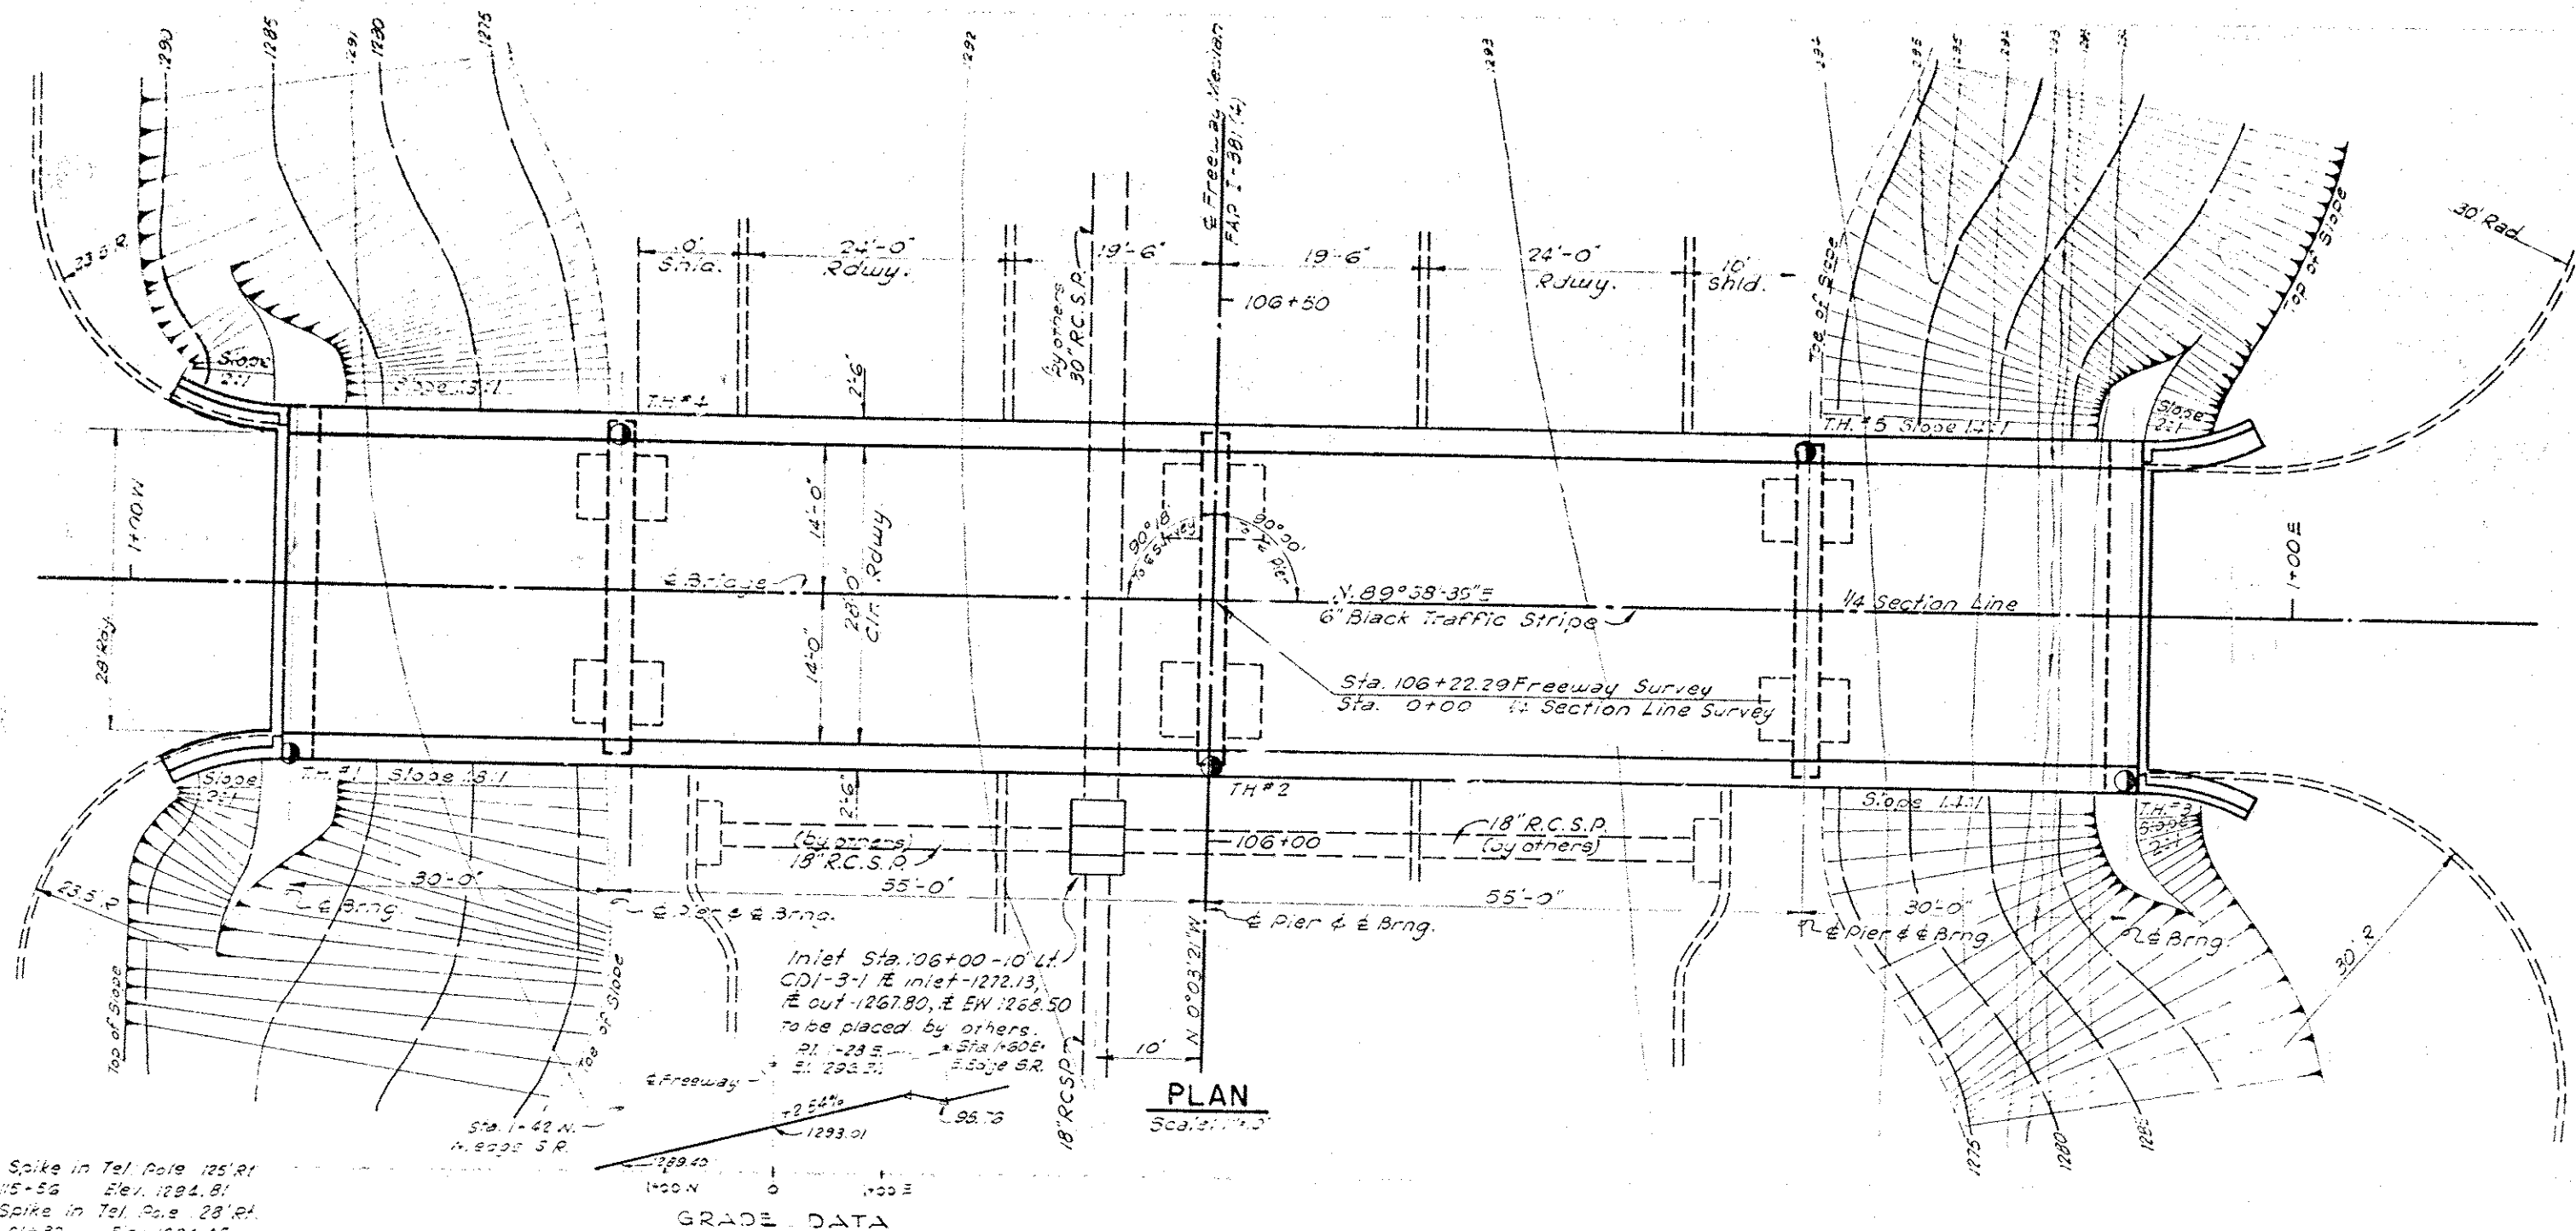

SUMMARY OF QUANTITIES						
ITEM NO.	ITEM	UNIT	Hours	Piers	Super 21'-54'	Bridge
501063	Substruct. Excav. - Common	C.Y.	28			28
501060	Substruct. Excav. - Rock	C.Y.	23	60		63
505026	Steel Handrailing	L.F.			342.5	342.5
505066	Class "A" Concrete	C.Y.	33.6	70.4		104.0
519066	Class "A" Conc. in Perf. Root Bases	C.Y.		29.5		29.5
505066	Class "AA" Concrete	C.Y.			433.3	433.3
51106	Reinforcing Steel	Lbs.	4200	200	66-20	4780
524063	Black Tar-Pg. String	L.F.			7.5	7.5
525063	Aluminum Stringing	L.F.			342.5	342.5

— GENERAL NOTES —


All construction & materials shall be in accordance with the Chamorro Standard Specifications of 1934 & Special Provisions.

All exposed concrete surfaces shall have a carborundum finish.

All reinforcing steel bars shall conform to A.S.T.M. Specifications A-303-49.

Construction shall comply with both types of handling. Use of 1000 W.P.D. equipment will be as needed.

Construction shall not be raised vertically by bulldozers or other heavy foundation machines.

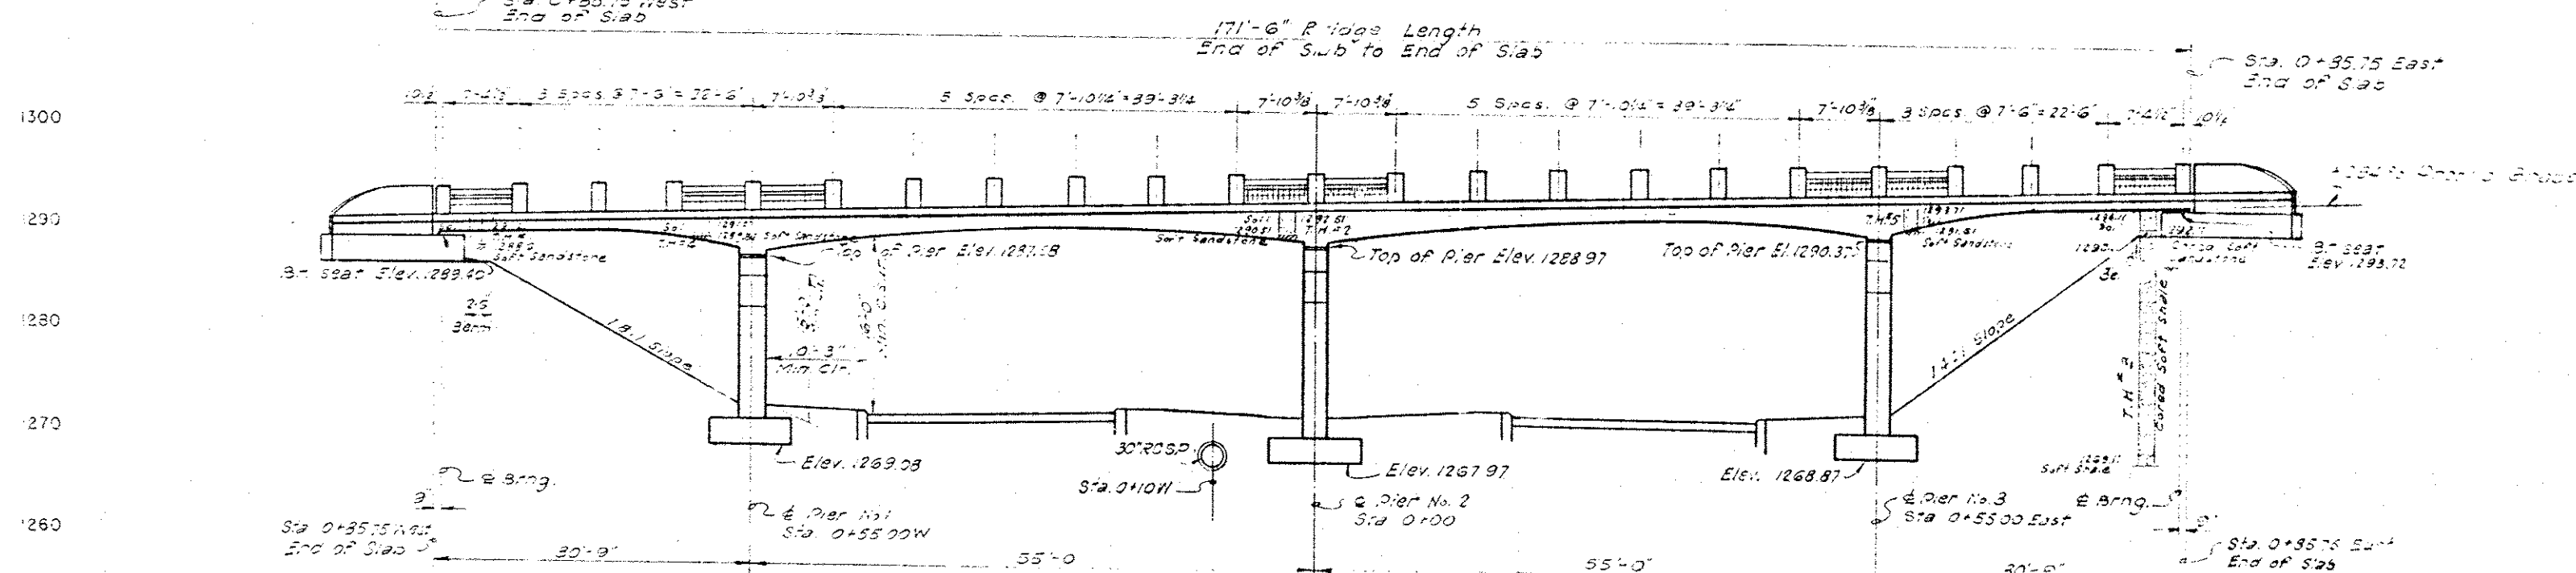

GENERAL ELEVATION

Scale: 1"=12'

[illegible]

SPECIAL PROVISIONS
See Special Provisions Included in the
Proposal For Curing Concrete with
Membrane Curing Compound For
Bridge Structures including Parapet
Walls, Retaining Walls & Railing
414-G (acc) Rev. 7-27-55

Neoprene Rubber for bearing devices
514-1(a) Reinforcing Steel (Axle Steel)
723-1(a) Rev. 2-21-57
Black Traffic Stripe or Black Traffic
Stripe Arrow 624-1(a) Rev. 10-8-53

REFERENCE LIST OF QUESTIONS

DETAILS * 480TH BATT--S-55- 57
DETAILS * 8308-----S-55- 59
DETAILS * 8108882-----S-55- 75
DETAILS * 8148 ELEPH-----S-55- 80
DETAILS * 814841-----S-55- 80-88

RECORD			OKLAHOMA STATE HIGHWAY COMMISSION
ITEM	BY	DATE	OKLAHOMA CITY, OKLA
DESIGN			STR. No. 9
DETAIL			GENERAL ELEV., PLAN &
TRACED	LS		SUMMARY OF QUANTITIES
CHECKED	222	2/2/51	30'-55'-55'-30' CONC. SLAB SPANS
APPR'D			28' RDY & 2-18" S.C.'s
SQUAD	334444		CL STA. ON CL SURVEY 106 + 22.29
			F.A. PROJ. I-381 (16) PT.-1

1400 WEST


+50 WEST

0+00


+50EAST

1+00 EAST


FED. ROAD DIST. NO.	STATE	PROJECT NO.	SHEET NO.	TOTAL SHEETS
5	OKLA.	I-381 (16) PT-1	57	88

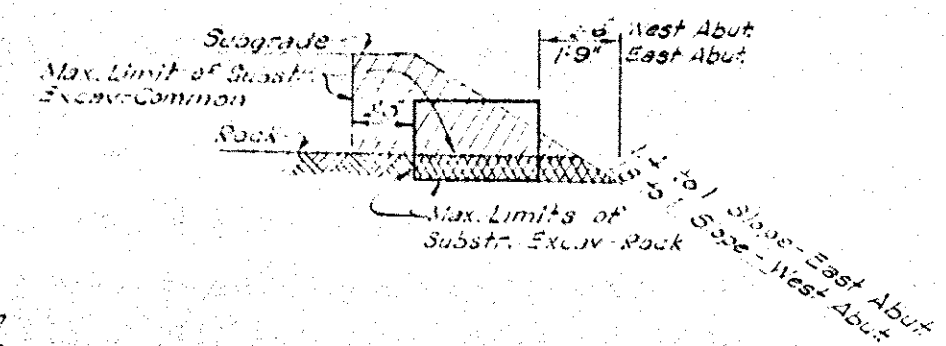


Abut. shall be backfilled and tamped with a mechanical tamper to a minimum of 95% Standard Proctor Density by the bridge contractor after abutment is completed. All cost of backfill shall be included in the unit price bid per Cu.Yd. for Substr. Excav. Common. Contractor may excavate to the neat lines of the abutment and if in satisfactory condition to the resident engineer, he may pour the concrete against the compacted fill. If necessary contractor shall use forms on the back vertical face of the abutment above the rock, and move the same after the concrete is set.

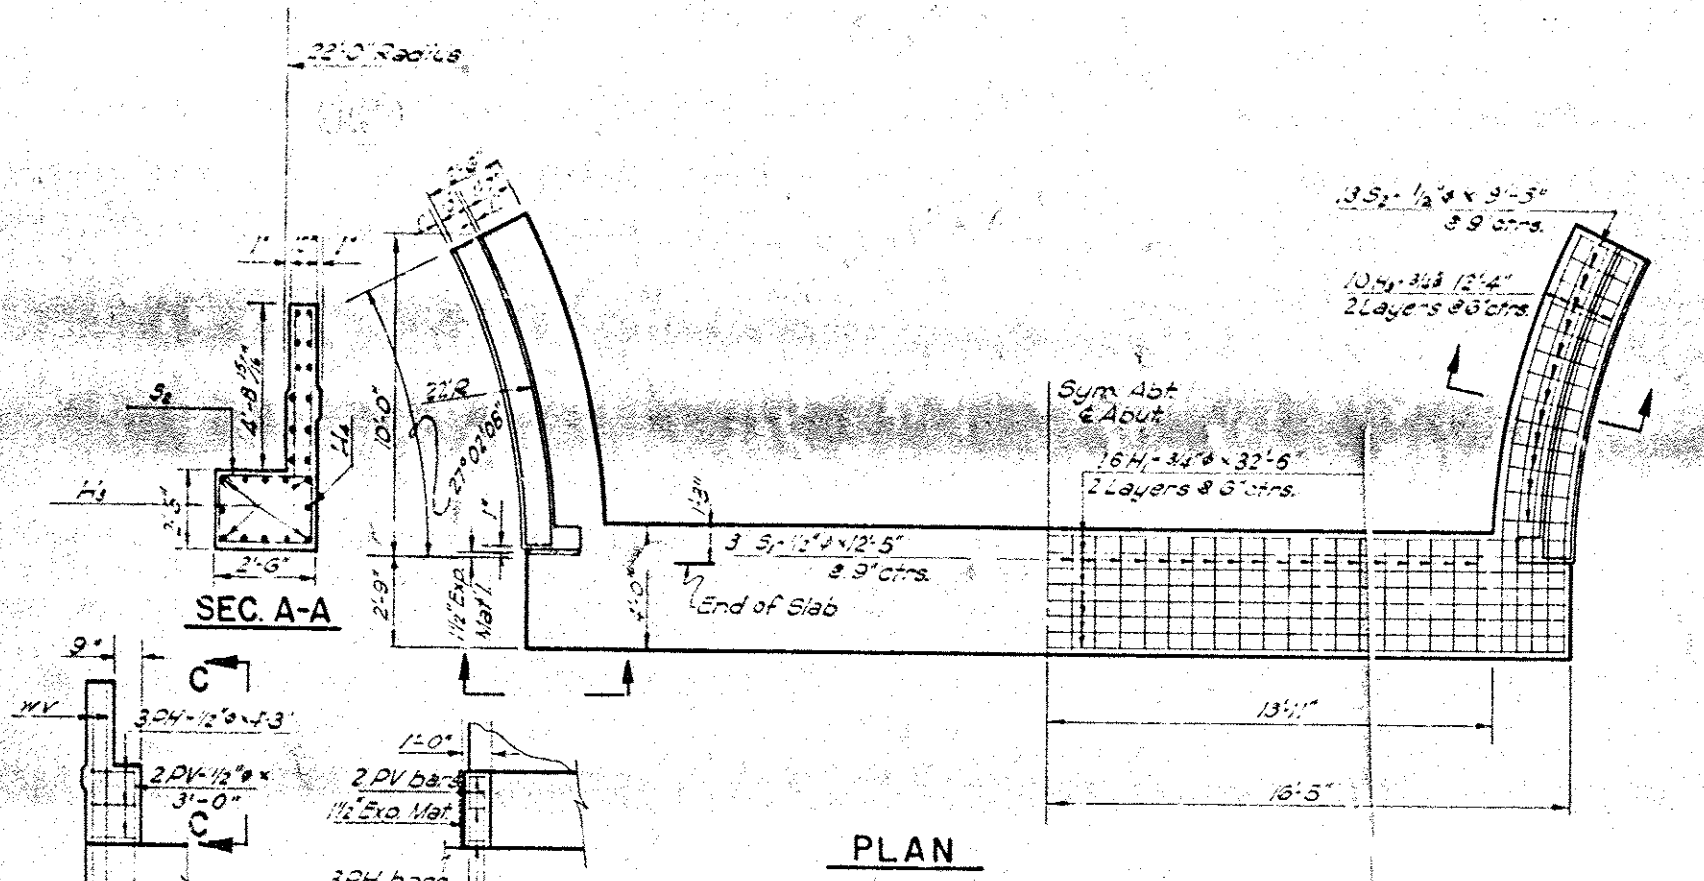



PLAN

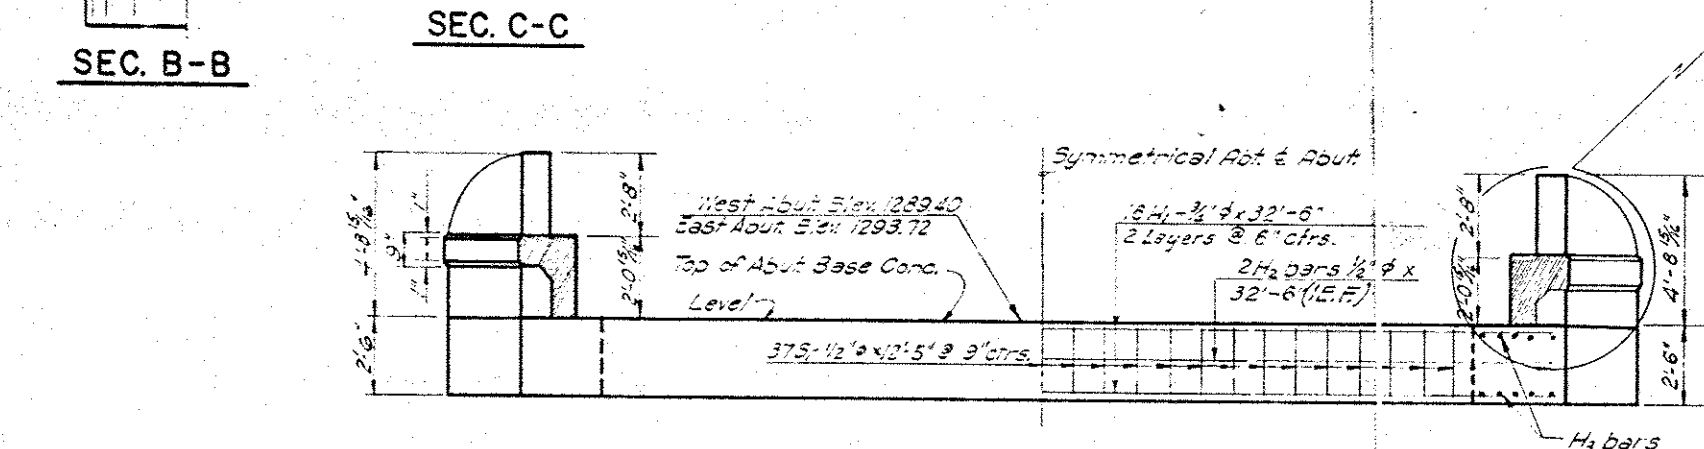


ELEVATION

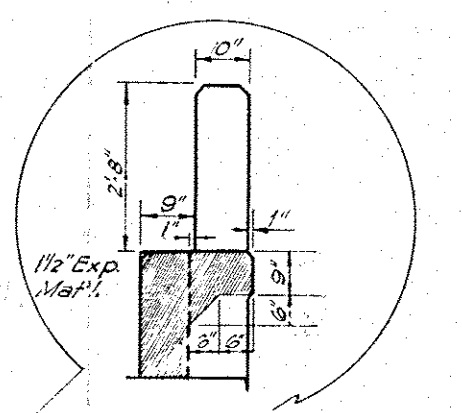


SECTION ON E

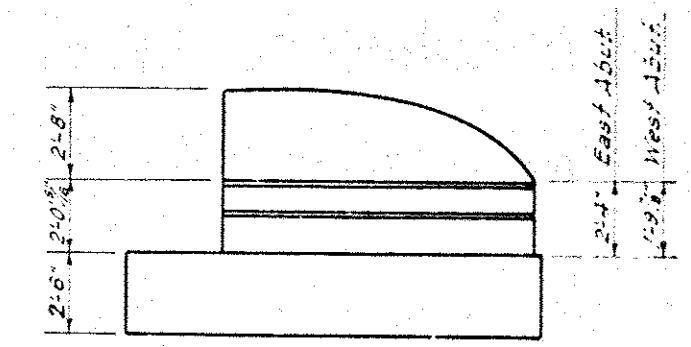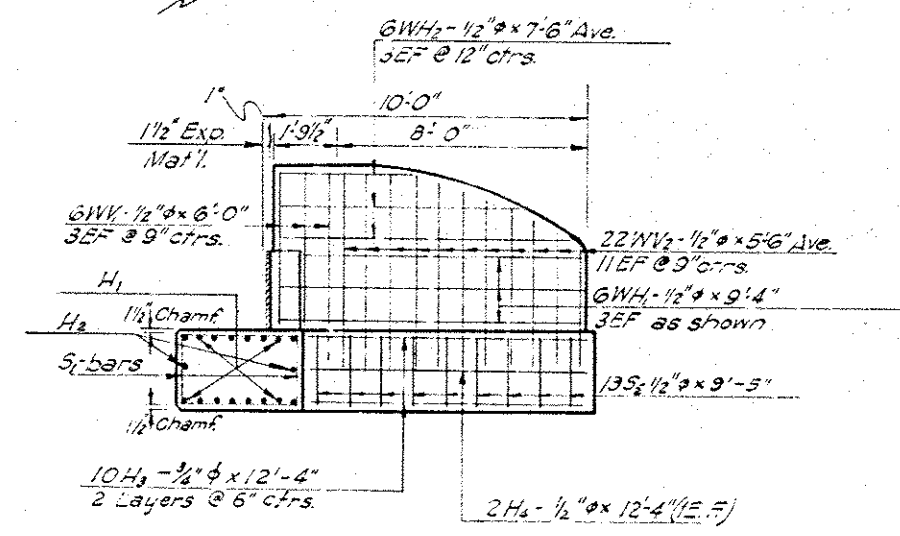

SIDE ELEVATION

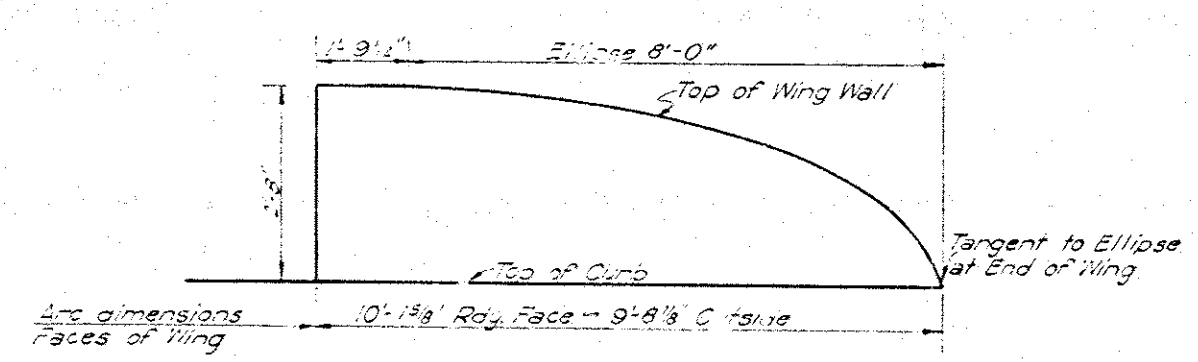

DETAIL OF WING

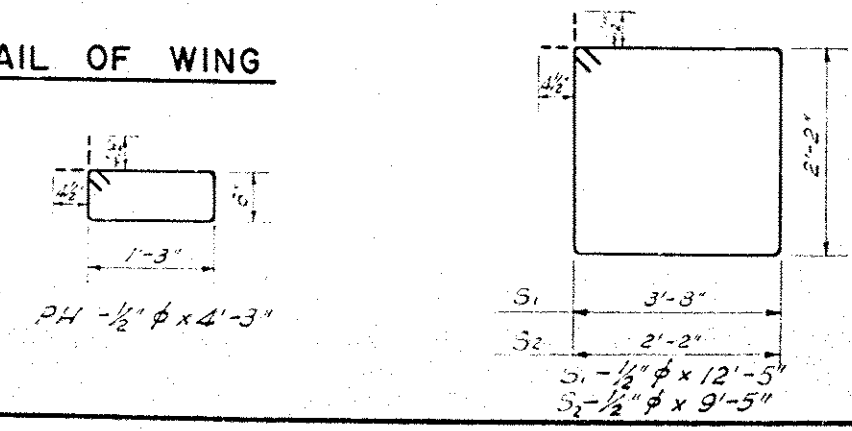

Mark	No.	Size	Form	Length
H1	16	3/4"	Str.	32'-6"
H2	2	1/2"	Str.	32'-6"
H3	20	3/4"	Str.	12'-4"
H4	4	1/2"	Str.	12'-4"
S1	37	1/2"	Bnt	12'-5"
S2	26	1/2"	Bnt	9'-5"
W1	12	1/2"	Str.	9'-4"
W2	12	1/2"	Str.	7'-6" Ave
W3	12	1/2"	Str.	6'-0"
W4	44	1/2"	Str.	5'-6" Ave
PV	6	1/2"	Str.	4'-3"
PV	4	1/2"	Str.	3'-0"

QUANTITIES			
ITEM	UNIT	Abut. (West)	Abut. (East)
Concrete	CY	19.2	19.4
Rein. Steel	Lbs.	2,100	2,100
Substr. Excav. Com.	CY	10	18
Substr. Excav. Rock	CY	5	9

GENERAL NOTES:
 1. Concrete dimensions shall be in accordance with the Oklahoma Standard Specs. of 1954, Section 101-1.01.
 2. Rein. steel bars shall conform to ASTM Specs. A-305-49.
 3. All exposed conc. edges shall have a 3/4" chamf. unless otherwise noted.

REVISIONS			RECORD		OKLAHOMA STATE HIGHWAY COMMISSION	
NO.	DESCRIPTION	BY DATE	ITEM	BY DATE	OKLAHOMA CITY, OKLAHOMA	
			DESIGN		STR. NO. 9 DETAILS OF ABUTMENTS E STA ON E SURVEY 106+22.29	
			DETAIL			
			TRACED	2-28		
			CHECKED	2-28 32		
			APPROVED		FA. PROJ. I- 381 (16)PT-1	
			EQUAD	3-27-44		

FEED ROAD DIST. NO.	STATE	PROJ. NO.	SHEET NO.	TOTAL SHEETS
6	OKLA.	I-381(16)PT-1	58	86

QUANTITIES				
ITEM	UNIT	P1521	P1522	P1523
Class 21 Concrete	C.Y.	22.6	23.3	24.0
Class 21 Conc. Pier Bases	C.Y.	5.9	11.7	8.9
Reinforcing Steel	Lbs.	3,655	4,745	3,910
Substr. Excav. Rock	C.Y.	17	24	9

BAR LIST


PIERS NO. 1 OR NO. 3

Mark	No.	Size	Form	Length	
BH ₁	6	1" #	Bnt.	33'-2"	
BH ₂	4	1/2" #	Str.	29'-6" Ave.	
BH ₃	8	1/2" #	Str.	21'-0"	
BH ₄	8	1/2" #	Bnt.	4'-9"	
BH ₅	8	1/2" #	Bnt.	7'-9"	
S ₁	20	3/8" #	Bnt.	11'-6" Ave.	
S ₂	21	3/4" #	Bnt.	12'-6"	
P1521	0	24	3/4" #	Str.	5'-0"
V ₁	1/3	24	3/4" #	Str.	18'-8"
T	1/3	24	3/4" #	Str.	18'-8"
T	1/3	24	1/2" #	Bnt.	8'-9"
T	1/3	30	1/2" #	Bnt.	8'-9"
F ₁	16	1/2" #	Str.	7'-6"	
F ₂	20	3/8" #	Str.	5'-6"	
WH ₁	4	1/2" #	Str.	15'-6"	
WH ₂	6	3/4" #	Str.	19'-0"	
WH ₃	11	1/2" #	Bnt.	12'-5"	


BAR LIST

PIER NO. 2


Mark	No.	Size	Form	Length
BH ₁	6	1/2" #	Bnt.	33'-6"
BH ₂	4	1/2" #	Str.	29'-6" Ave.
BH ₃	8	1/2" #	Str.	21'-0"
BH ₄	8	1/2" #	Bnt.	4'-9"
BH ₅	8	1/2" #	Bnt.	7'-9"
S ₁	20	3/8" #	Bnt.	11'-6" Ave.
S ₂	20	3/8" #	Bnt.	12'-6"
T	28	1/2" #	Bnt.	8'-9"
1/3	24	3/4" #	Str.	18'-2"
D	24	3/4" #	Str.	5'-0"
F	28	1/2" #	Str.	5'-6"
F	24	1/2" #	Str.	6'-6"
WH ₁	4	1/2" #	Str.	18'-6"
WH ₂	6	3/4" #	Str.	9'-0"
WH ₃	11	1/2" #	Bnt.	12'-5"

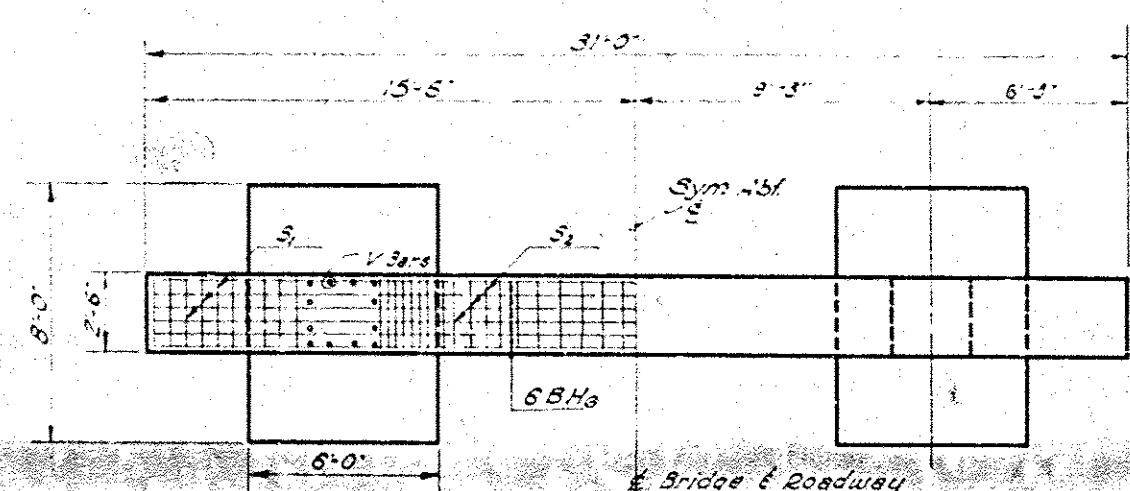


PLAN-PIER NO. 1 OR NO. 3

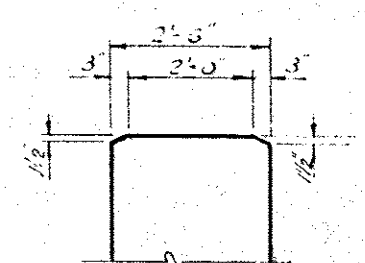


DETAIL OF PIER TOP

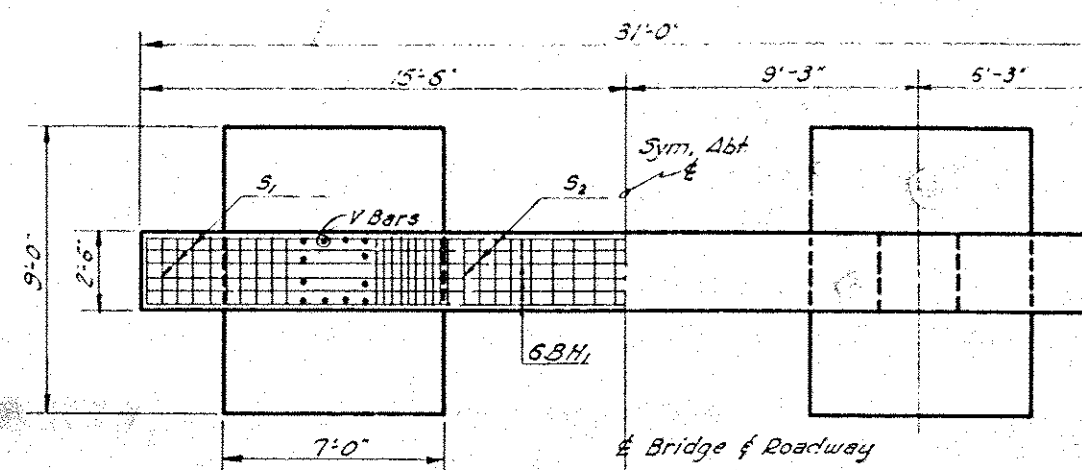


PLAN-PIER NO. 2

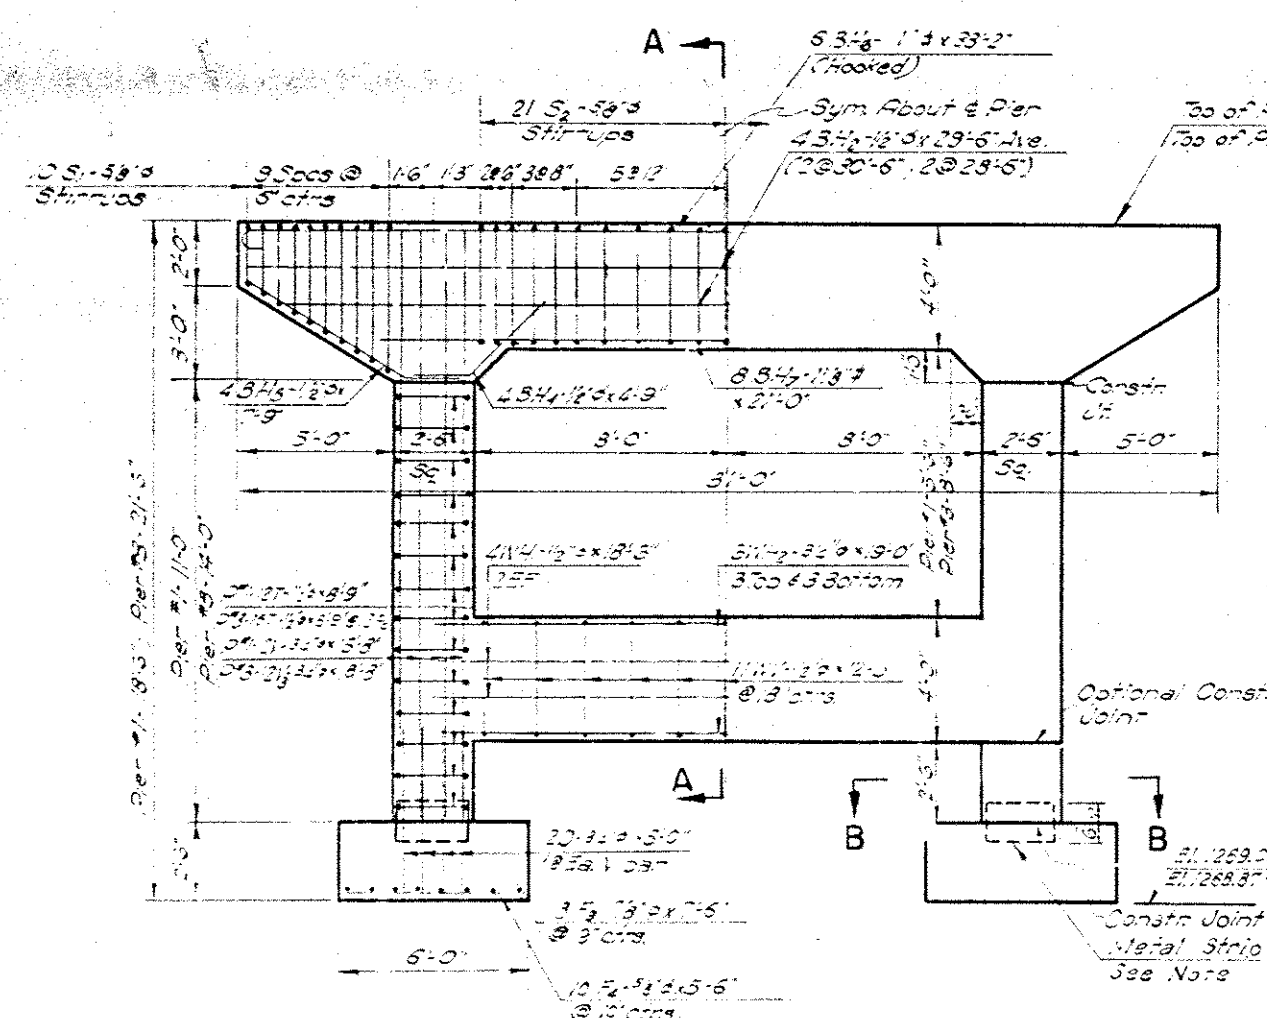


ELEVATION-PIER NO. 1 & 3

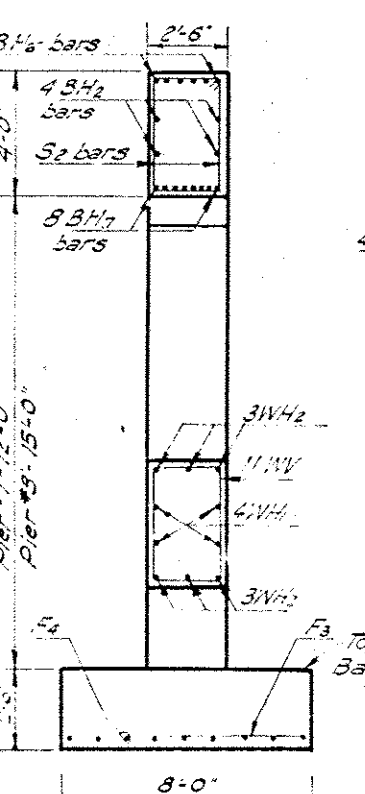


SECTION A-A

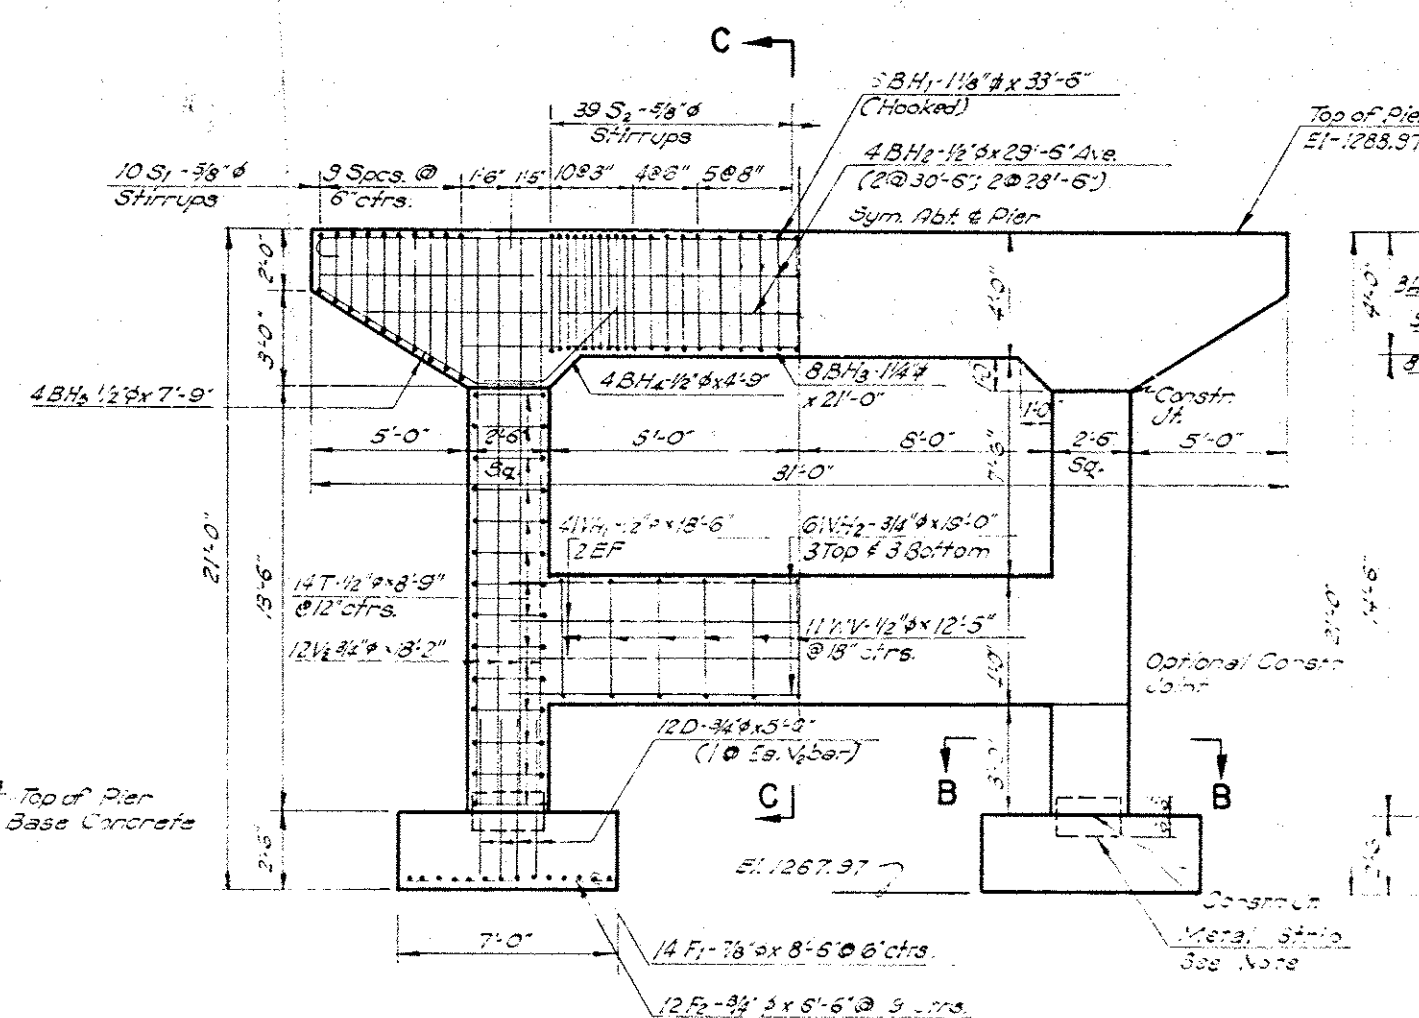


ELEVATION-PIER NO. 2

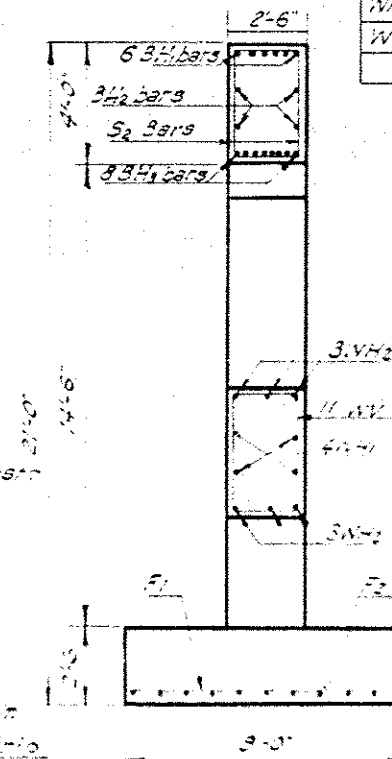

SECTION C-C

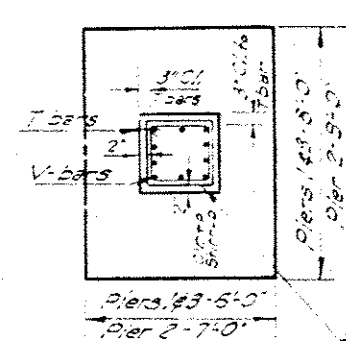


SECTION B-B

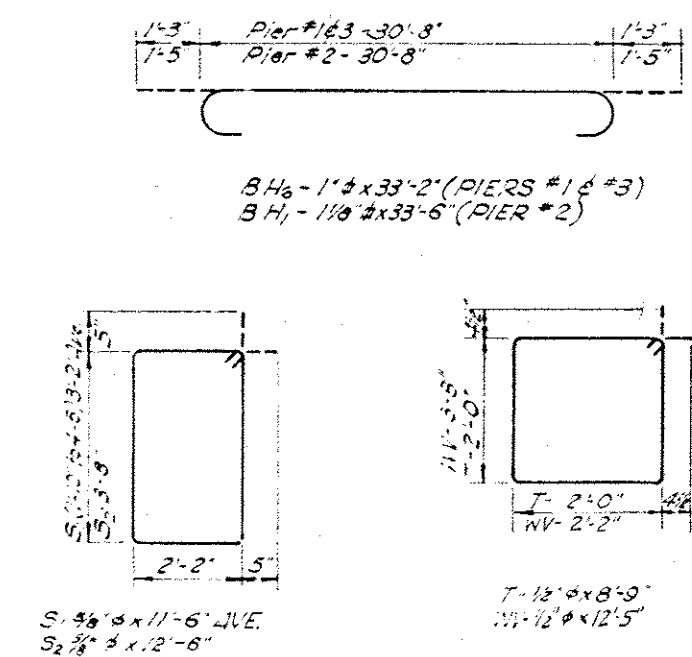

NOTES:
1. All reinforcing steel bars shall conform to ASTM Spec. A 615-47.
2. Enclosed details shall have a 1/2" dimension unless otherwise noted.
3. Concrete shall be placed and cured.


NOTES: METAL STRIP & REINFORCING BASE CONCRETE
Refer to details notes on Details of Piers -
Sheet No. 22

REVISIONS				RECORD				OKLAHOMA STATE HIGHWAY COMMISSION OKLAHOMA CITY, OKLAHOMA STR. NO. 9 DETAILS OF PIERS E STA ON E SURVEY 106+22.29 FA. PROJ. I-381 (16)PT-1	
NO.	DESCRIPTION	BY	DATE	ITEM	BY	DATE			
				DESIGN					
				DETAIL					
				TRACED	KCS				
				CHECKED	222	57			
				APPROVED					
				SQUAD	SENHAM				

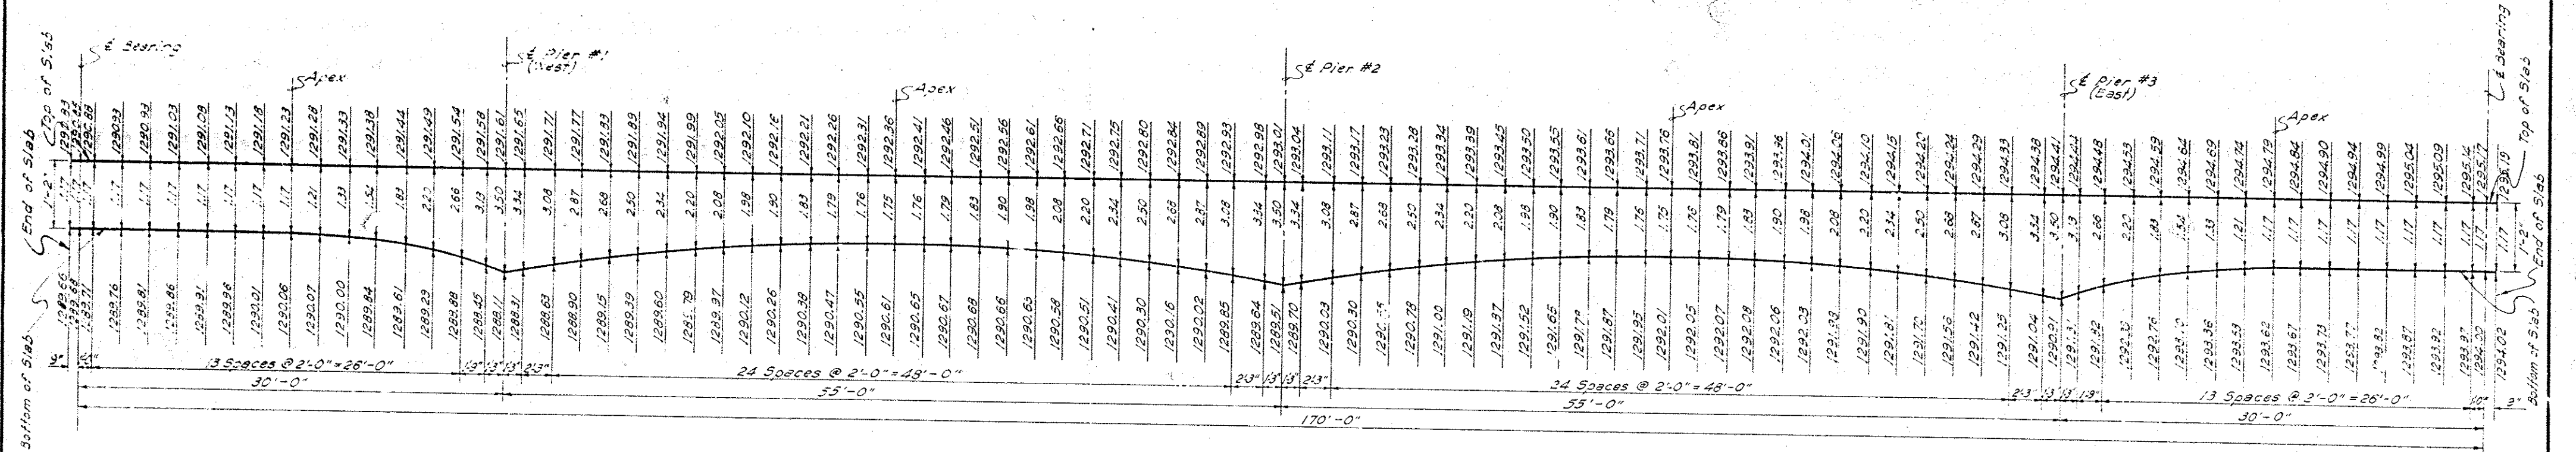


SOFFIT ELEVATIONS & SLAB DIMENSIONS AT \mathcal{C} ROADWAY

Note: Elevations shown include allowance for dead load deflection on 50' span only.

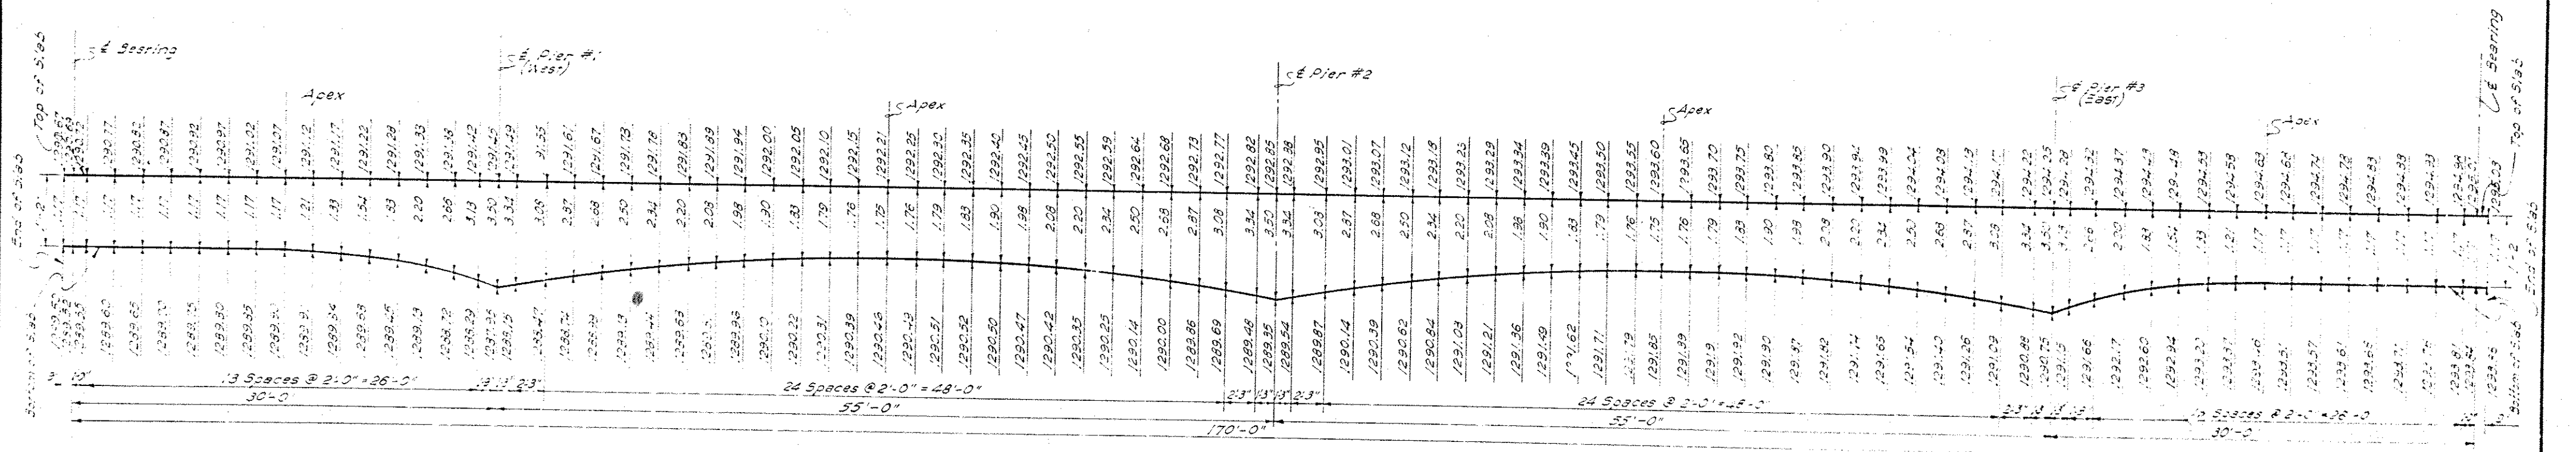

SOFFIT ELEVATIONS & SLAB DIMENSIONS 15.5' LT. & RT. OF \mathcal{C} ROADWAY

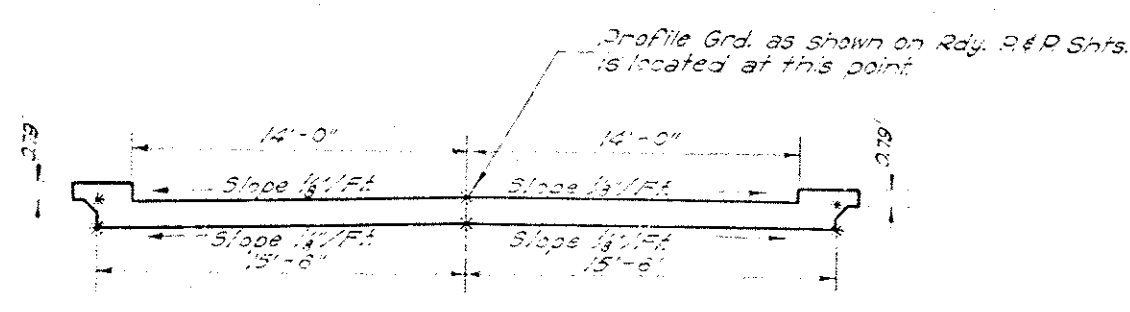

* Points of Elevation

Note: For Top of Curb Elevation Add 0.79' to Top of Slab.
 Note: Elevations and dimensions shown above are for forming 90' P.H. Curves and Top of Bridge Floor. Anticipated deflections due to dead load have been considered and no other allowance for these deflections shall be made.

REVISIONS				RECORD		OKLAHOMA STATE HIGHWAY COMMISSION OKLAHOMA CITY, OKLAHOMA	
NO.	DESCRIPTION	BY	DATE	ITEM	DATE		
				DESIGN			
				DETAIL			
				TRACED			
				CHECKED			
				APPROVED		STR. NO. 9 DETAIL OF SLAB ELEVATIONS STA ON \mathcal{C} SURVEY 106+22.29 F.A. PROJ. 1-381 (16) PT-1	
				SQUAD			

DESIGN DATA

L.L. H20-S6-S3; RDM 20-4
 Concrete 1000 psi
 Reinforcing Steel 60,000 psi
 Foundation Loads: 20.3 Tons
 Piers: Direct Load 2.97 Tons

SUMMARY OF QUANTITIES

ITEM No.	ITEM	UNIT	Abut.	Piers	Supp.	Bridge	Rdy.
202.00	Class "D" Excavation	C.Y.					200
308.00	4" Sand Cushion	S.Y.					179.5
442.00	Approach Slabs	S.Y.					179.5
501.00	Substr. Excav. - Common	C.Y.	90	385			575
501.00	Substr. Excav. - Rock	C.Y.		44			44
505.00	Steel Handrailing	L.F.			305		305
509.00	Class "A" Concrete	C.Y.	590	792			1382
509.00	Class "A" Conc. in Pier Bases	C.Y.		522			522
509.00	Class "AA" Concrete	C.Y.			700.3		700.3
511.00	Reinforcing Steel	Lbs.	7580	23,380	35,380		144,500
533.00	15" C.M. Pipe	L.F.					36
540.00	18" R.C. Piling	L.F.	581				581
542.00	12" R.C. Piling	L.F.					1
544.00	Black Traffic Stripe	L.F.					303.5
544.00	4" Concrete Slope Wall	S.Y.					374.2
544.00	Special Aluminum Handrailing	L.F.			305		305

GENERAL NOTES

- All construction & materials shall be in accordance with the Oklahoma Standard Specifications of 1954 & Special Provisions.
- All exposed concrete surfaces shall have a carborundum finish.
- All reinforcing steel bars shall conform to A.S.T.M. Specifications A-305-49.
- Piling shall be driven using leads of sufficient strength to control piles.
- Piling shall be driven to practical refusal if above grade or to a minimum bearing of 50 tons if at or below grade.
- All abutment piling shall be driven through the compacted fill 12" & Pilot holes shall be drilled to Elev. 1295.50 @ Abut. No. 1 & to Elev. 1241.00 @ Abut. No. 2. Then 8" & 12" holes to Elev. 1257.00 @ Abut. No. 1 & to Elev. 1258.50 @ Abut. No. 2. All cost of Pilot holes shall be included in the unit price bid for 18" R.C. Piling.
- Contractor shall submit logs on both sides of handrailing type of material used, will be determined by logs received.
- Plan footing elevations shall not be made shall be lowered only if firm footing foundation material is not found at plan elevation.

SKREW 72°-30' RT. FWD.

RECORD	BY DATE
DESIGN	
DETAIL	
TRACED / S.	
CHECKED	
APPROVE	
SQUAD	35144

OKLAHOMA STATE HIGHWAY COMMISSION
 OKLAHOMA CITY, OKLAHOMA
STR. NO. 10
 GENERAL ELEV. PLAN &
 SUMMARY OF QUANTITIES
 42'-66'-42' CONC. SLAB SPANS
 37' R.D.Y. & 2-18" S.C.s
 @ STA ON @ SURVEY 132+90.25
 F.A. PROJ. I-381 (16) PT.-1

PLAN

Scale: 1"=10'

GENERAL ELEVATION

Scale: 1"=10'

SPECIAL PROVISIONS

See Special Provisions included in the Proposal For Curing Concrete with Membrane Curing Compound For Bridge Structures including Parapet Walls, Retaining Walls and Railing 414-6 (ac) Rev. 7-27-55
 Equipment For Driving Piles 514-1 (a) Reinforcing Steel (Axle Steel) 723-1 (a) Rev. 2-21-57
 Black Traffic Stripe or Back Traffic Stripe Arrow 624-1 (a) Rev. 10-18-55
 Neoprene rubber for bearing devices.

NO.	REVISIONS	DESCRIPTION	BY	DATE
1				
2				
3				
4				
5				
6				
7				
8				
9				
10				

132




+50

133




+50

134

FED. ROAD DIST. NO.	STATE	PROJ. NO.	SHEET NO.	TOTAL SHEETS
6	OKLA.	1-38(16)PT-1	62	88

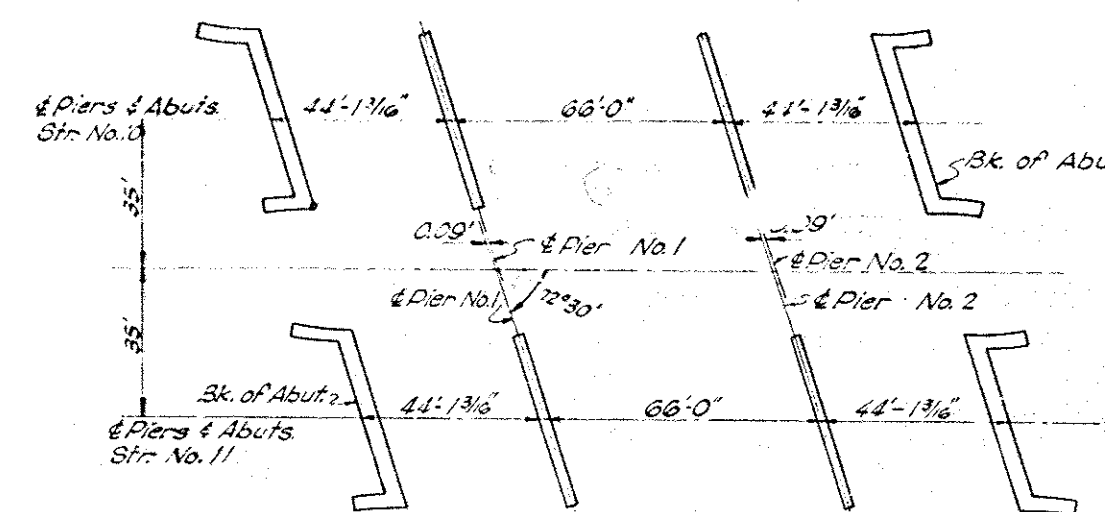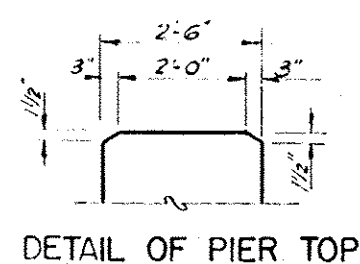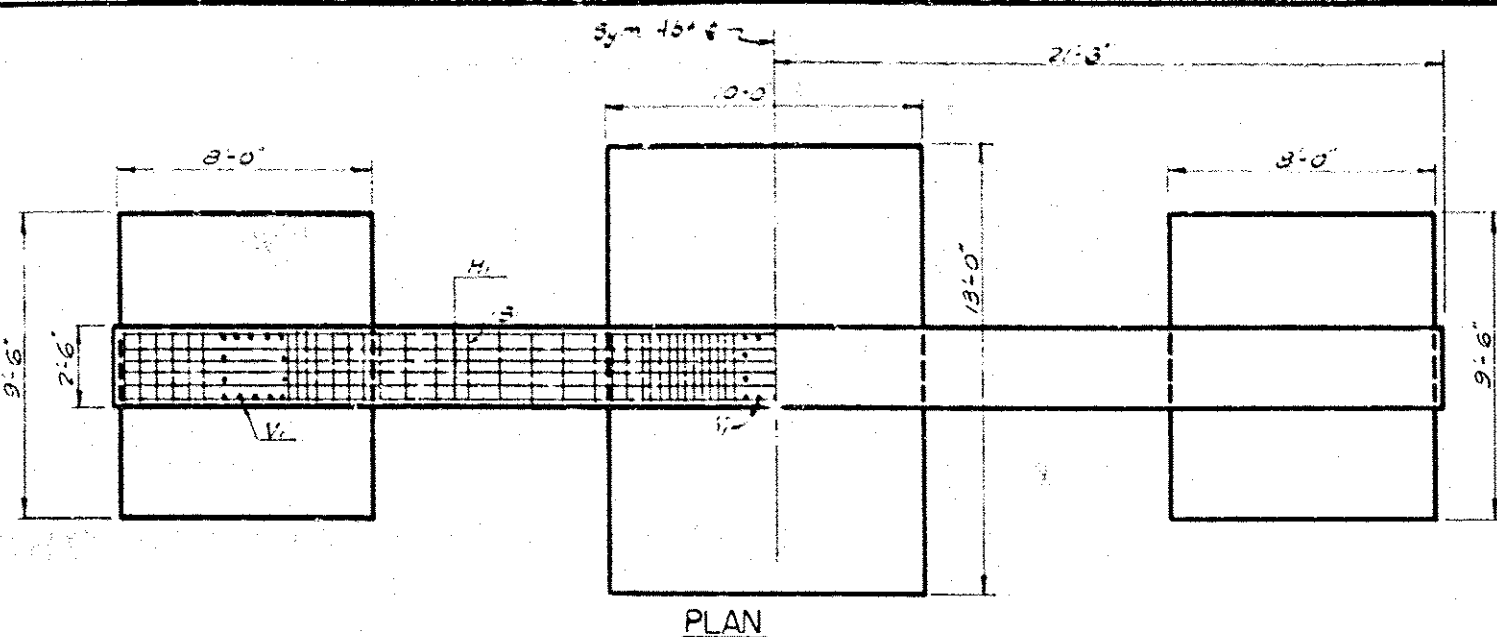

BAR LIST - ONE PIER				
Mark	No.	Size	Form	Length
H ₁	6	1"φ	Bnt	45'-2"
H ₂	6	1 1/8"φ	Str	13'-0"
H ₃	5	1 1/8"φ	Str	36'-6"
H ₄	3	1 1/8"φ	Str	36'-6"
H ₅	4	1 1/8"φ	Str	42'-0" Ave.
BH ₁	16	1/2"φ	Bnt	4'-0"
BH ₂	8	1/2"φ	Bnt	6'-0"
WH ₁	4	1/2"φ	Str	34'-6"
WH ₂	6	3/4"φ	Str	35'-0"
WV	20	1/2"φ	Bnt	12'-5"
S ₁	60	5/8"φ	Bnt	12'-6"
S ₂	12	5/8"φ	Bnt	11'-4" Ave.
T	54	1/2"φ	Bnt	8'-0"
V	42	1"φ	Str	21'-10"
D	42	1"φ	Str	5'-0"
F	28	3/4"φ	Str	7'-6"
F ₂	28	7/8"φ	Str	9'-0"
F ₃	28	7/8"φ	Str	9'-6"
F ₄	24	1"φ	Str	12'-6"

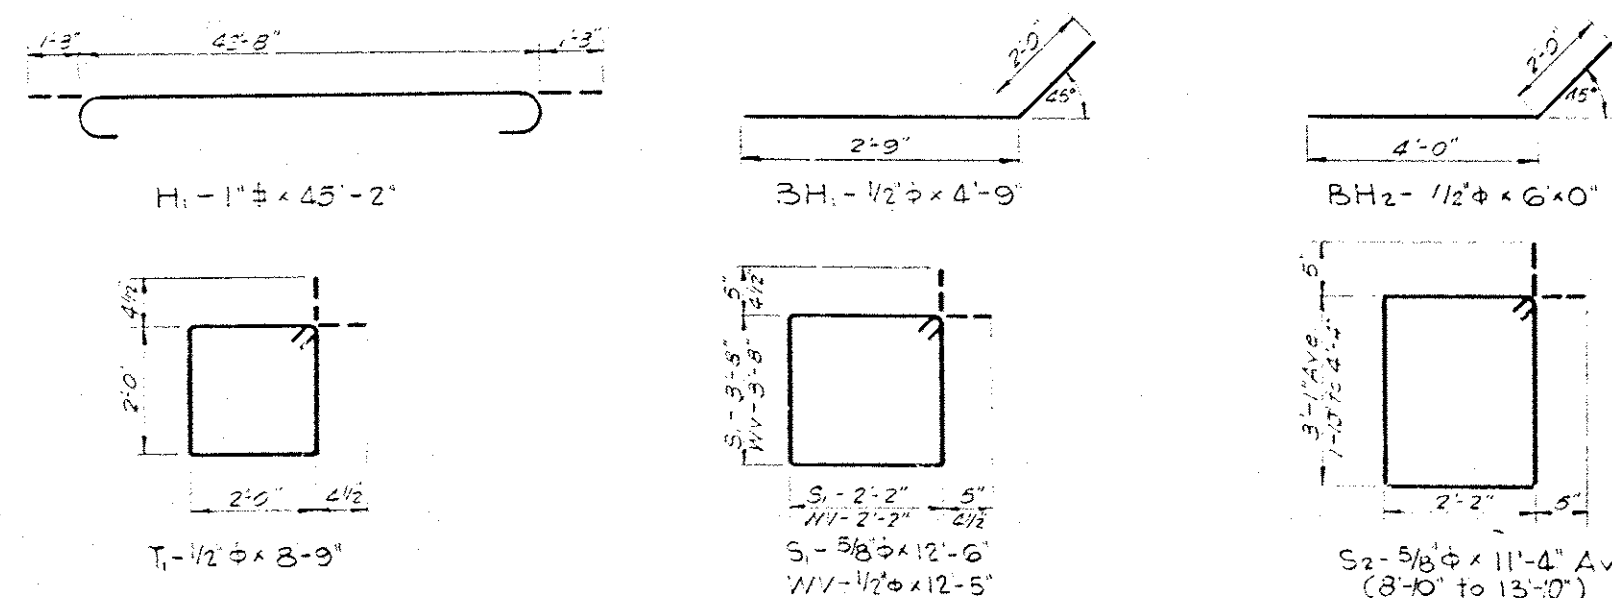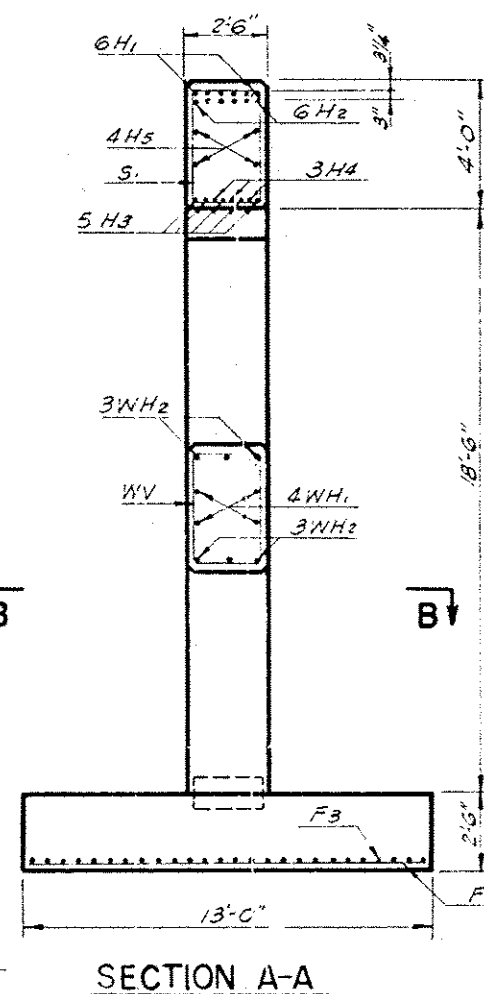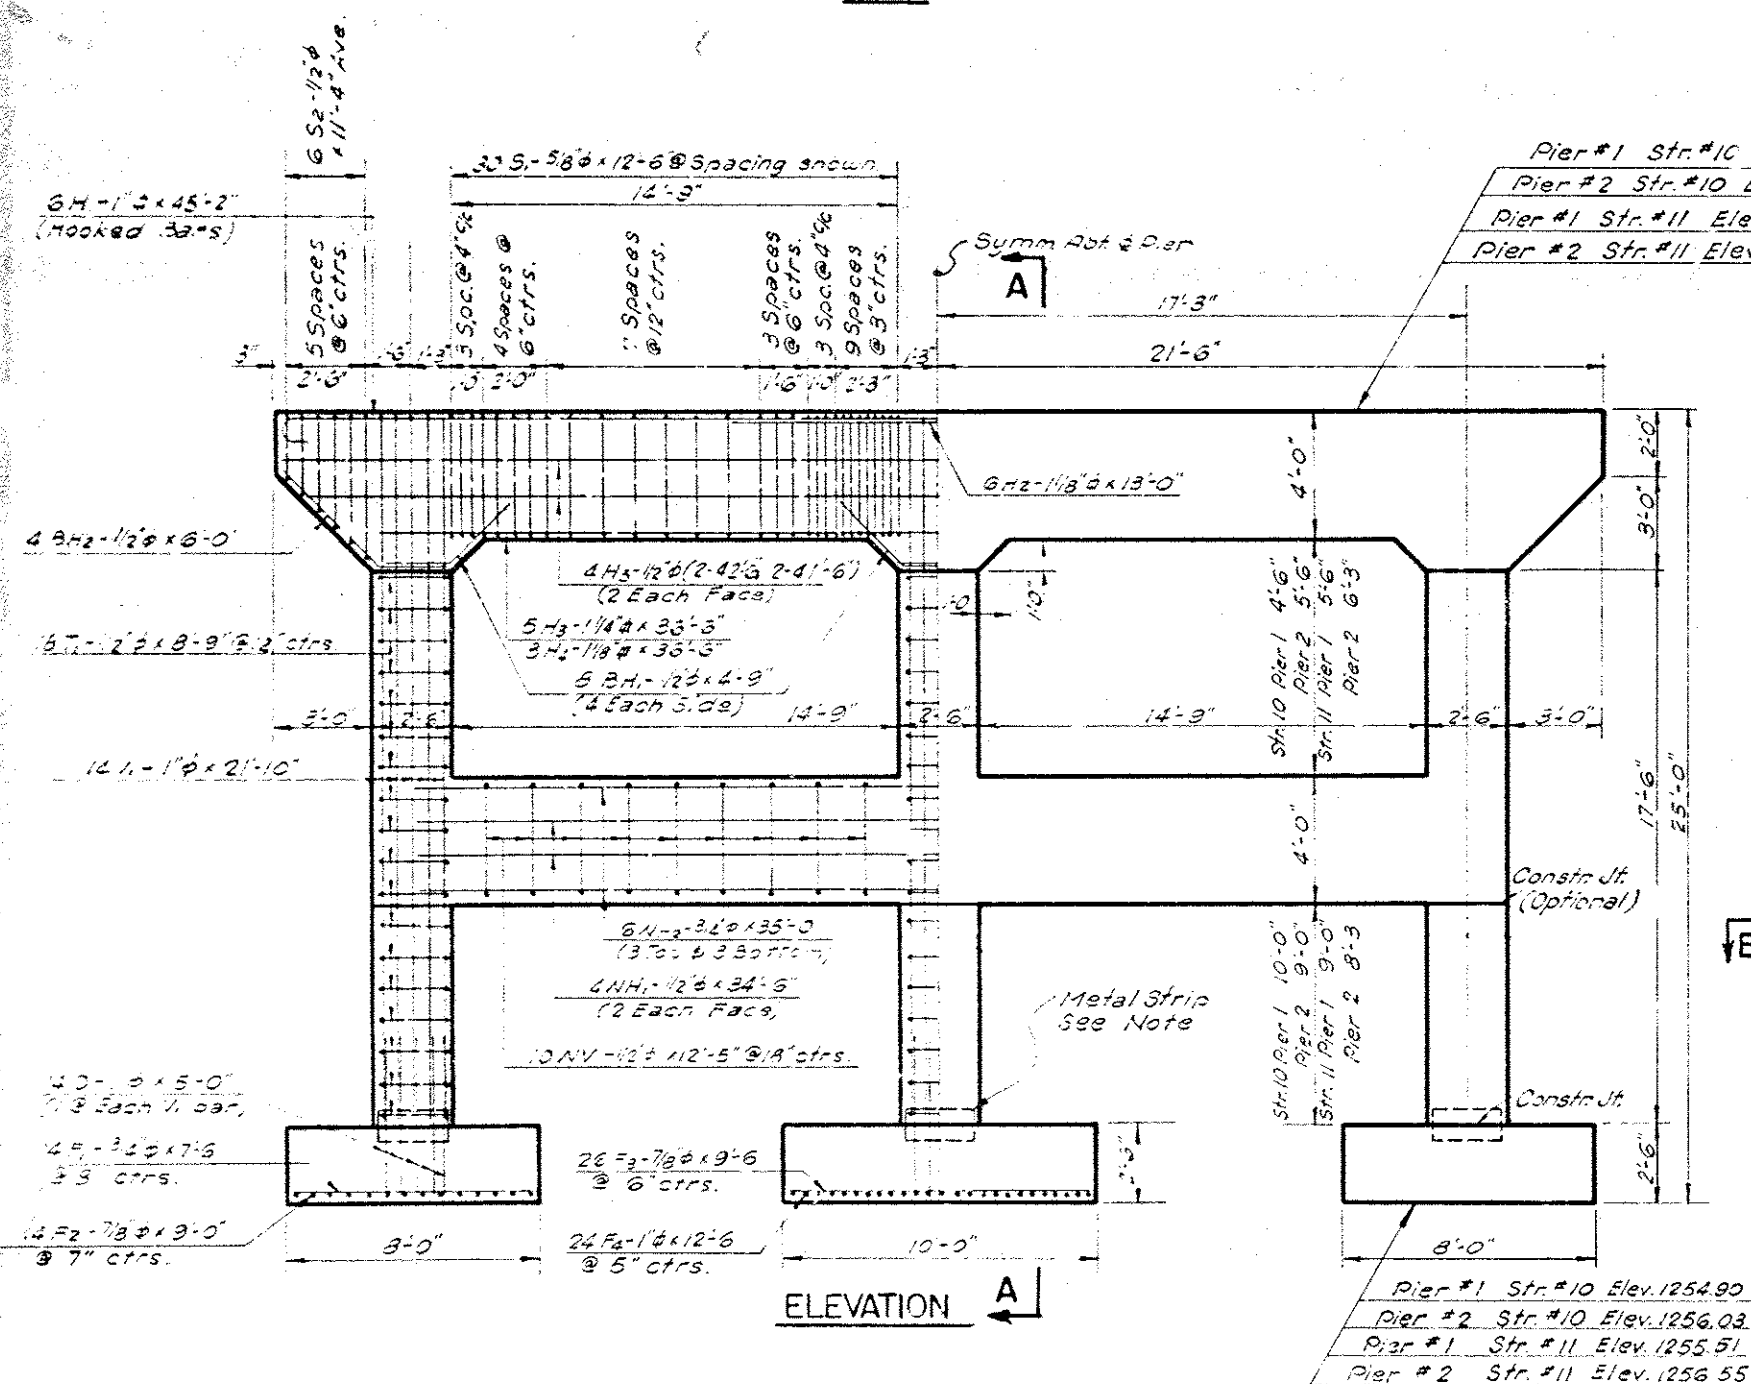

NOTES:
 All reinforcing steel bars shall conform to A.S.T.M. specifications A-305-29.
 All exposed edges shall have a 1/2" chamfer unless otherwise noted.
 All concrete shall be poured dry.

NOTE: METAL STRIP & PIER BASE CONCRETE
 Refer to identical notes on Detail of Piers - Inset Sheet #12.


QUANTITIES - ONE PIER				
ITEM	UNIT	Str. No. 10	Str. No. 11	Str. No. 12
Reinforcing Steel	WTS	3.25	3.25	3.25
Class A Conc. in Piers	CY	39.3	39.3	39.3
Class A Conc. in Pier Bases	CY	26	26	26
Substr. Excav. - Common	CY	226	180	155
Substr. Excav. - Rock	CY	20	24	9

REVISIONS			RECORD		BY DATE	
NO.	DESCRIPTION	BY	DATE	ITEM	BY	DATE
1	DESIGN					
2	DETAIL					
3	TRACED					
4	CHECKED					
5	APPROVED					
6	SQUAD					


OKLAHOMA STATE HIGHWAY COMMISSION
 OKLAHOMA CITY, OKLAHOMA
 DETAILS OF PIERS
 STR. NO. 10
 STA ON SURVEY 132+90.25
 STR. NO. 11
 STA ON SURVEY 133+10.03
 F.A. PROJ. 1-38(16)PT-1

PROJECT NO. 1-38(16)PT-1 SHEET NO. 62

FILE NO.	STATE	PROJ. NO.	SHEET NO.	TOTAL SHEETS
6	OKLA.	I-381(16) PT-1	63	85

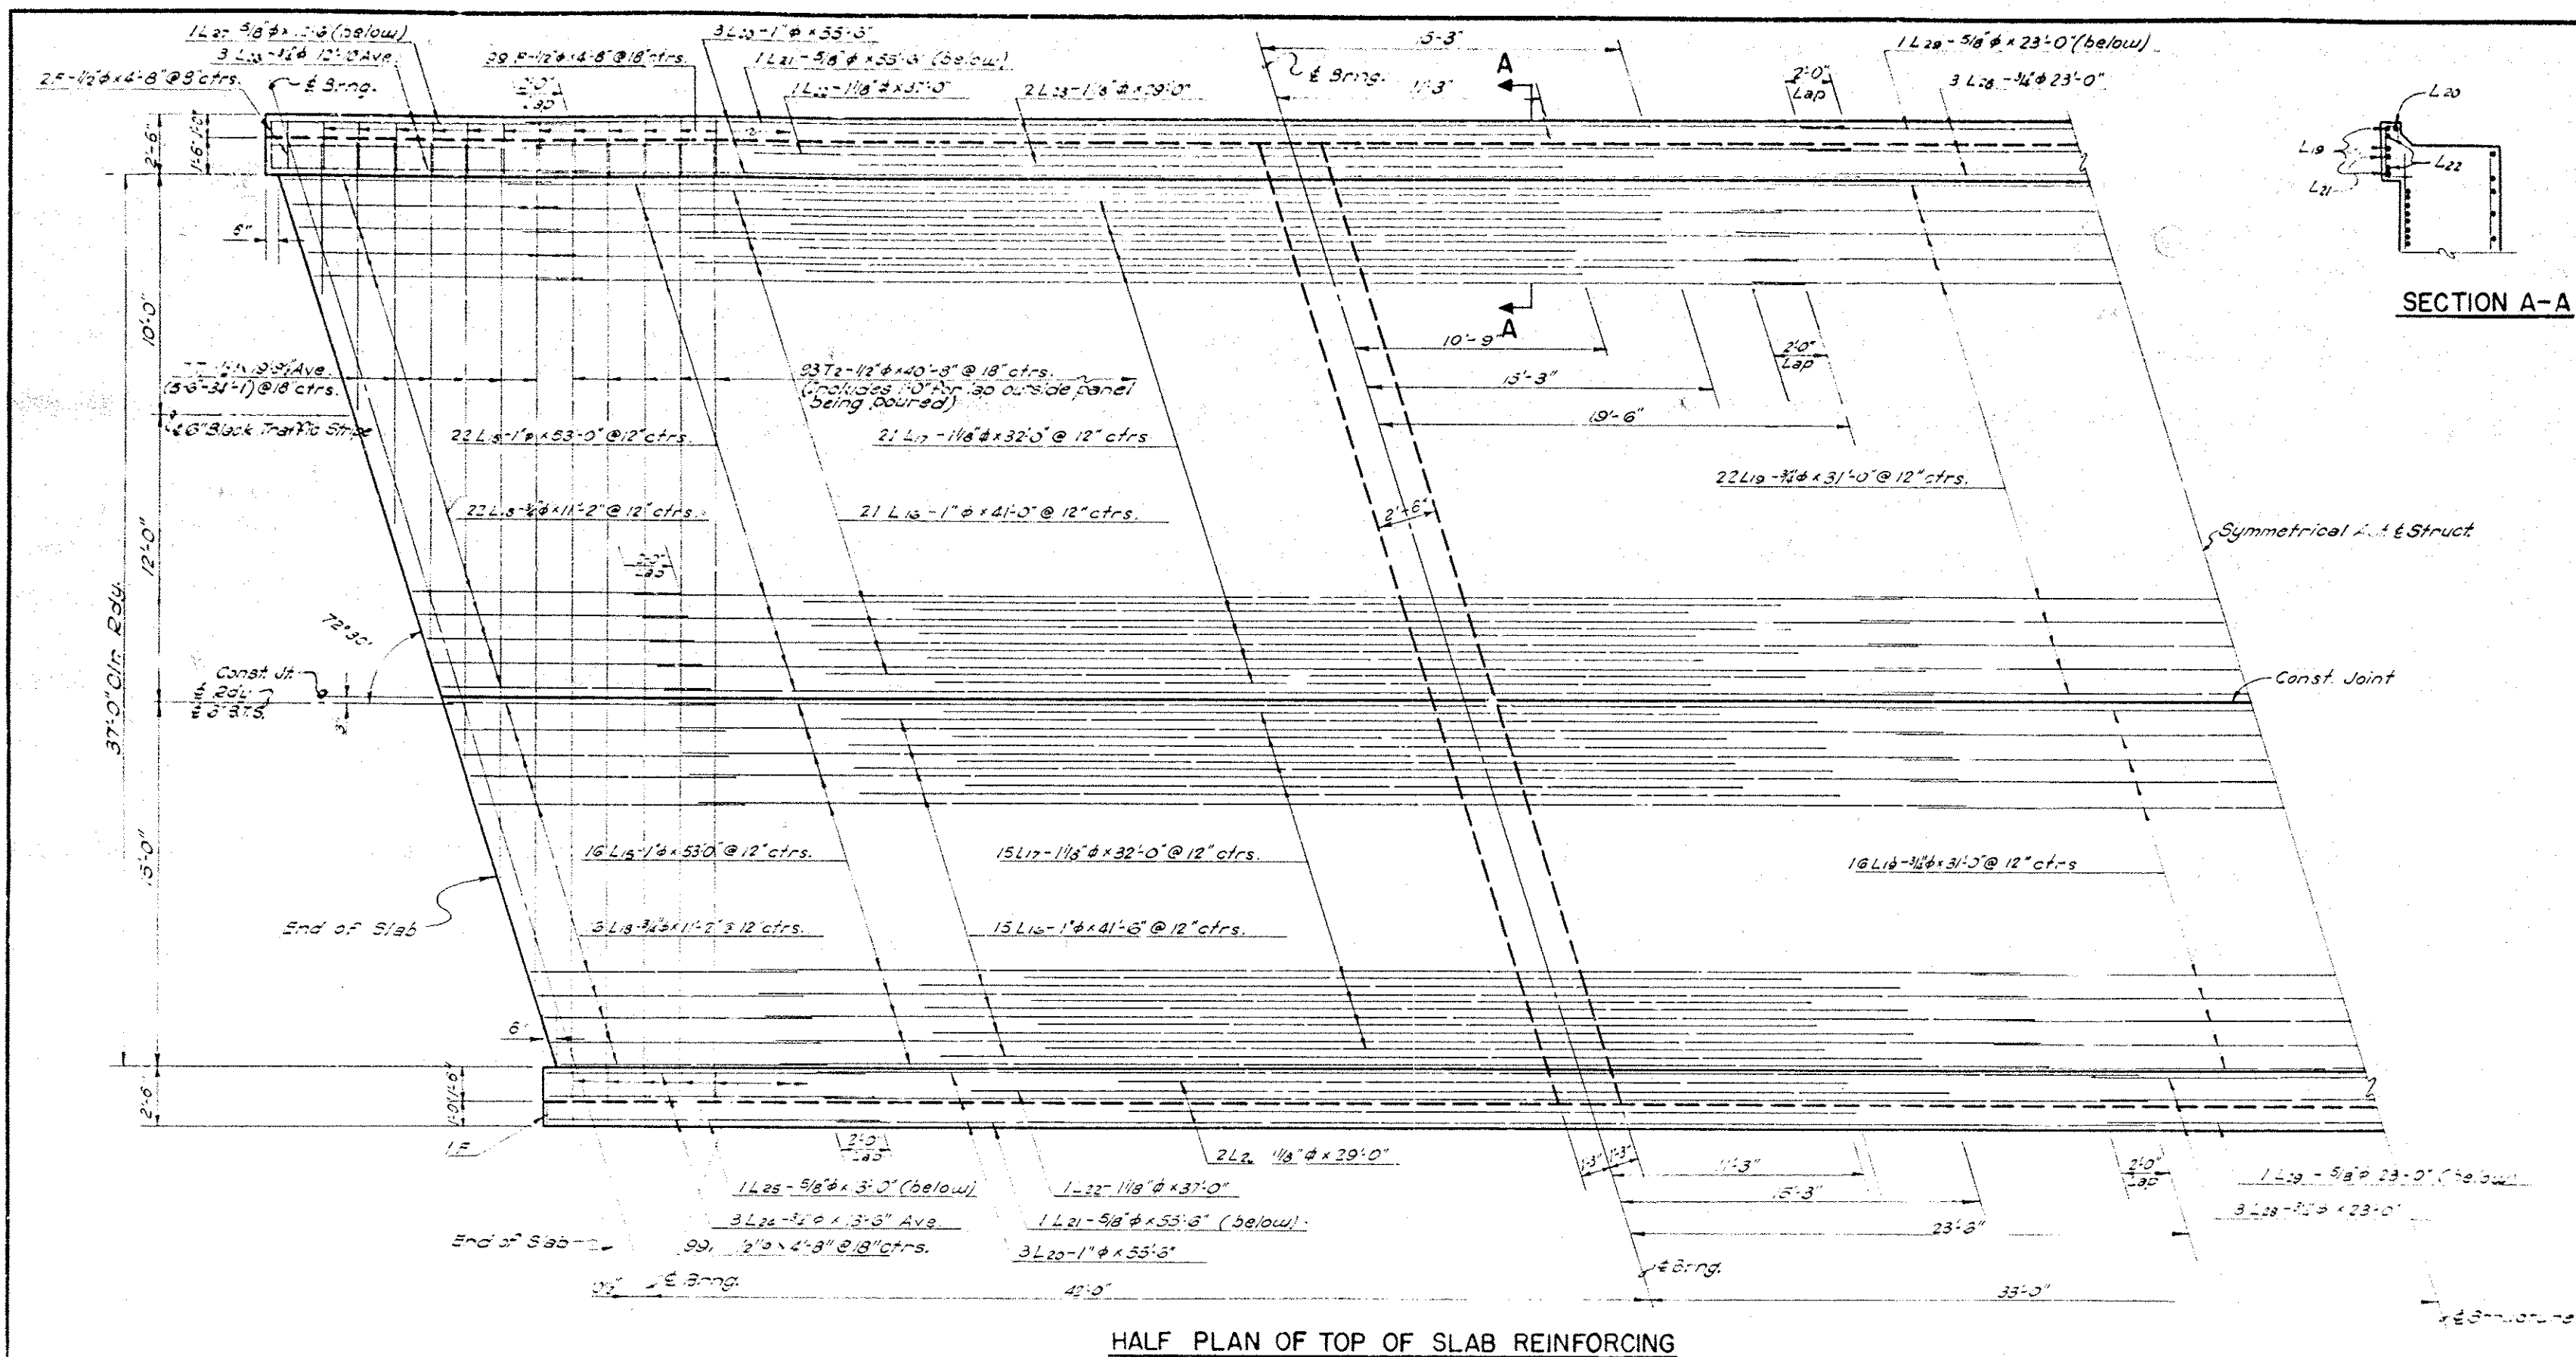

HALF PLAN OF TOP OF SLAB REINFORCING

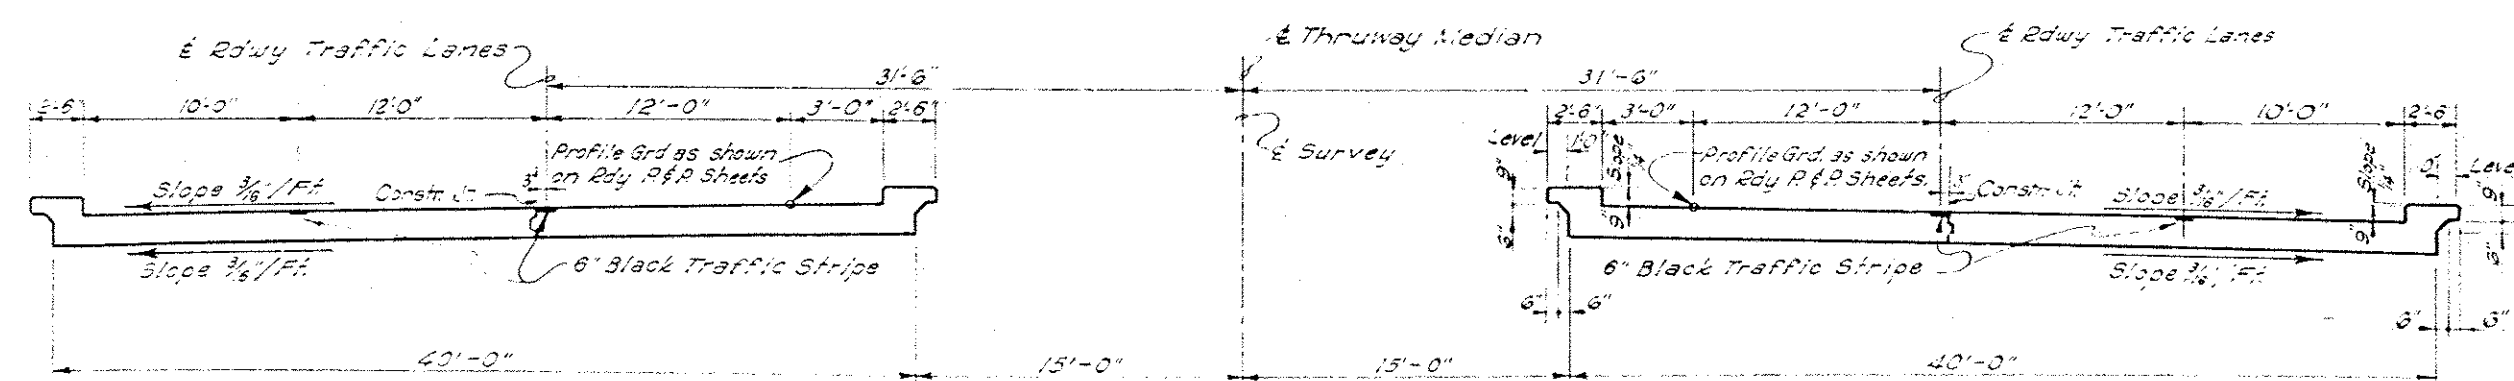

TYPICAL ROADWAY SECTION


GENERAL NOTES:
Refer to General Notes on Index Sheet 16.

REVISIONS				RECORD		OKLAHOMA STATE HIGHWAY COMMISSION	
NO.	DESCRIPTION	BY	DATE	ITEM	DATE	OKLAHOMA CITY, OKLAHOMA	
				DESIGN		DETAILS OF SUPERSTRUCTURE STR. NO. 10 CL STA. ON CL SURVEY 132+90.25 STR. NO. 11 CL STA. ON CL SURVEY 133+10.03 FA. PROJ. I-381 (16) PT-1	
				DETAIL			
				TRACED			
				CHECKED			
				APPROVED			
				SQUAD			


FED. ROAD DIST. NO.	STATE	PRJ. NO.	SHEET NO.	TOTAL SHEETS
6	OKLA.	I-381(16)PT. I	64	88

Mark No.	Size	Form	Length
L1	7/8"	Str.	44'-0"
L2	7/8"	"	28'-8"
L3	7/8"	"	20'-8"
L4	7/8"	"	44'-8" Ave.
L5	7/8"	"	23'-7"
L6	7/8"	"	44'-2" Ave.
L7	7/8"	"	23'-2"
L8	3/4"	"	59'-9"
L9	3/4"	"	40'-6"
L10	3/4"	"	23'-8"
L11	3/4"	"	10'-9"
L12	4"	"	57'-9"
L13	4"	"	33'-0"
L14	4"	"	12'-9"
L15	7/8"	"	53'-0"
L16	7/8"	"	41'-8"
L17	7/8"	"	32'-0"
L18	7/8"	"	11'-2"
L19	7/8"	"	3'-0"
L20	12"	"	55'-6"
L21	4"	"	55'-6"
L22	4"	"	37'-0"
L23	8"	"	29'-0"
L24	8"	"	3'-6" Ave.
L25	2"	"	13'-10"
L26	6"	"	12'-0" Ave.
L27	2"	"	12'-6"
L28	6"	"	23'-0"
L29	2"	"	33'-0"
L30	3"	"	40'-9"
L31	19"	"	23'-0" Ave.
L32	3"	"	3'-0" Ave.
L33	6"	"	2'-1" Ave.
L34	4"	"	1'-3"
L35	12"	"	9'-9" Ave.
L36	12"	"	40'-3"
L37	2"	"	1'-6"

ITEM	UNIT	TOTAL
Class AA Concrete	C.Y.	700.3
Reinforcing Steel	Lbs.	8593.0
Handrailing	L.F.	305
6" Black Traffic Stripe	L.F.	303.5

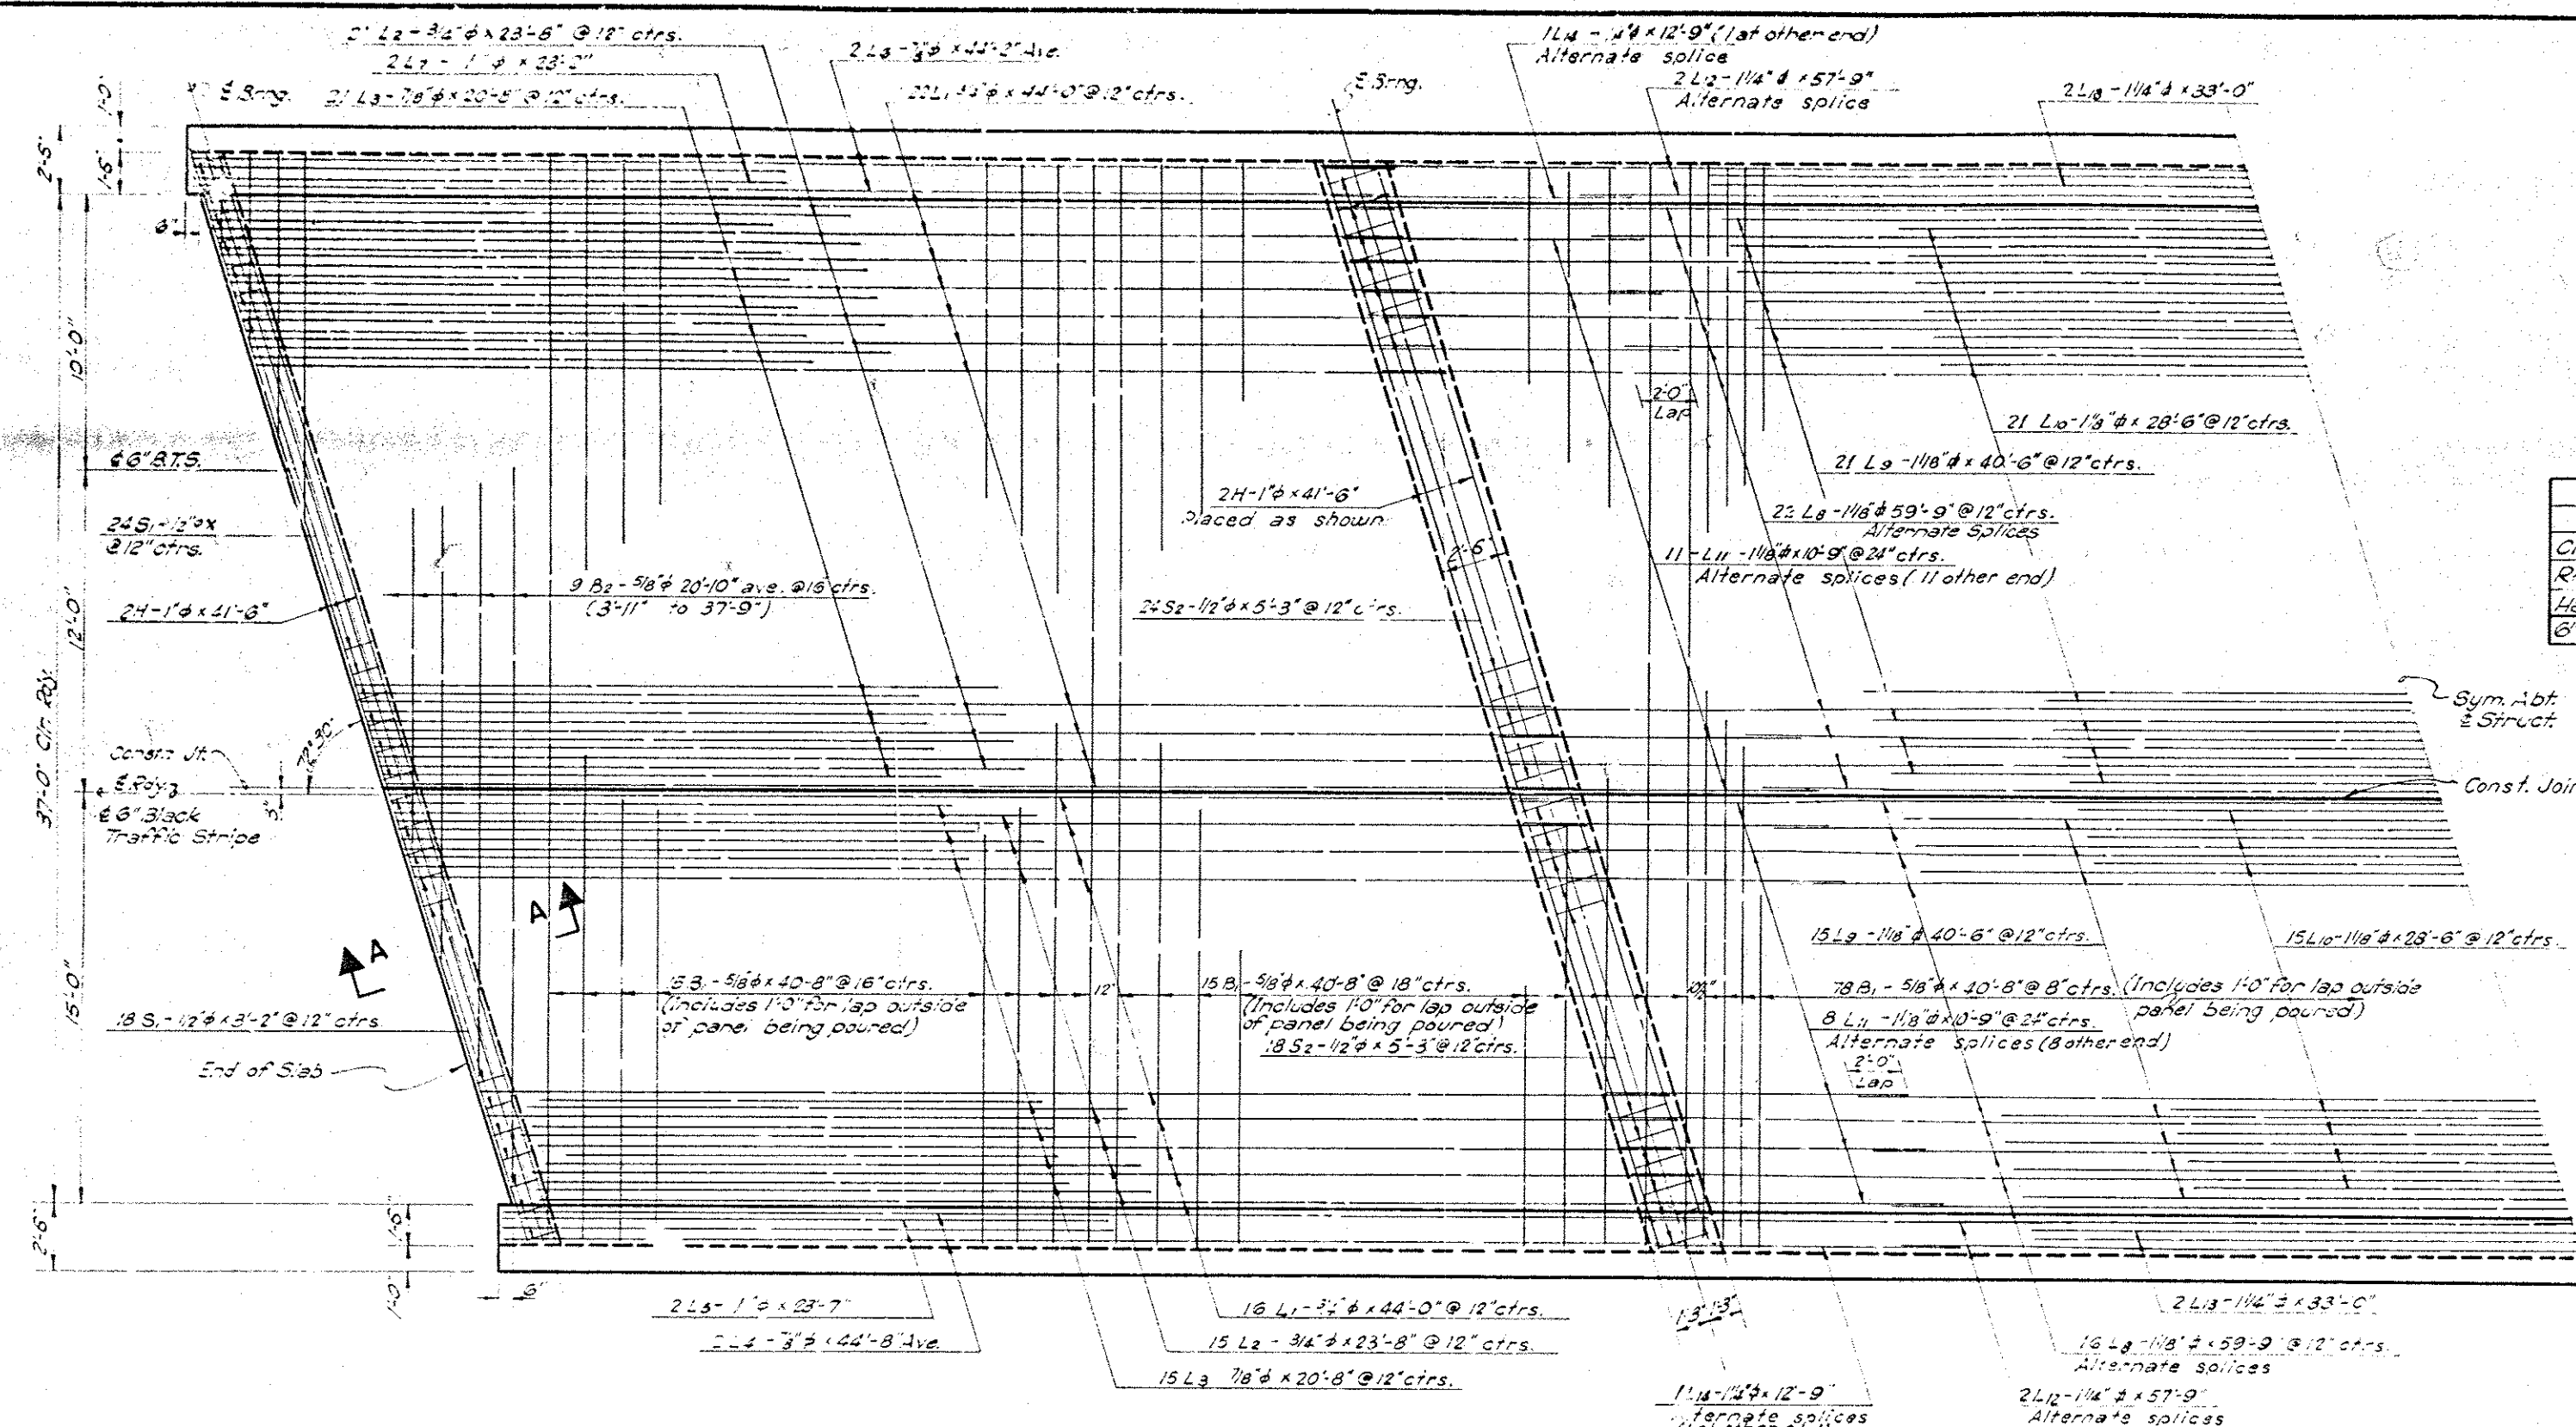

HALF PLAN OF BOTTOM OF SLAB REINFORCING

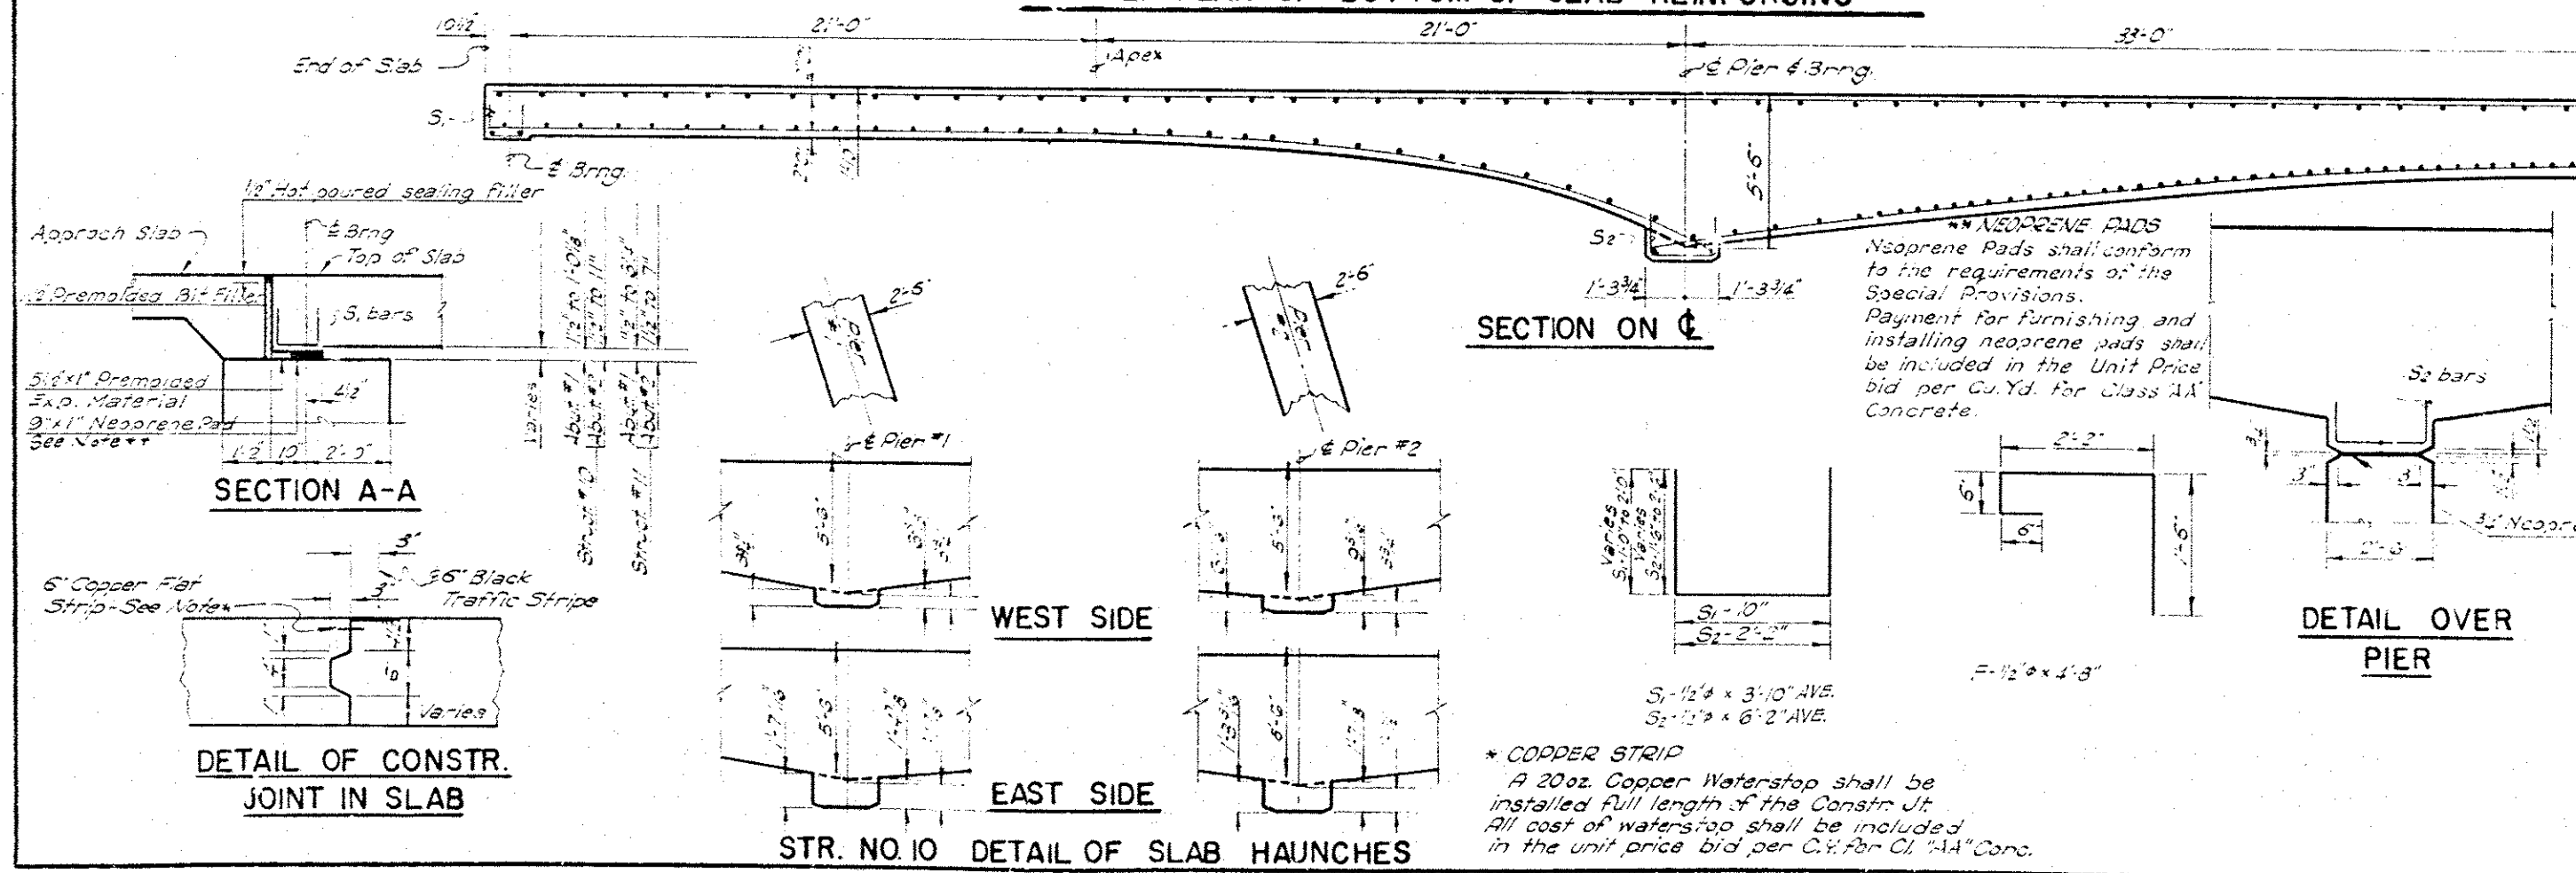

SECTION A-A

DETAIL OF CONSTR. JOINT IN SLAB


WEST SIDE

EAST SIDE

STR. NO. 10 DETAIL OF SLAB HAUNCHES

SECTION ON C

DETAIL OVER PIER

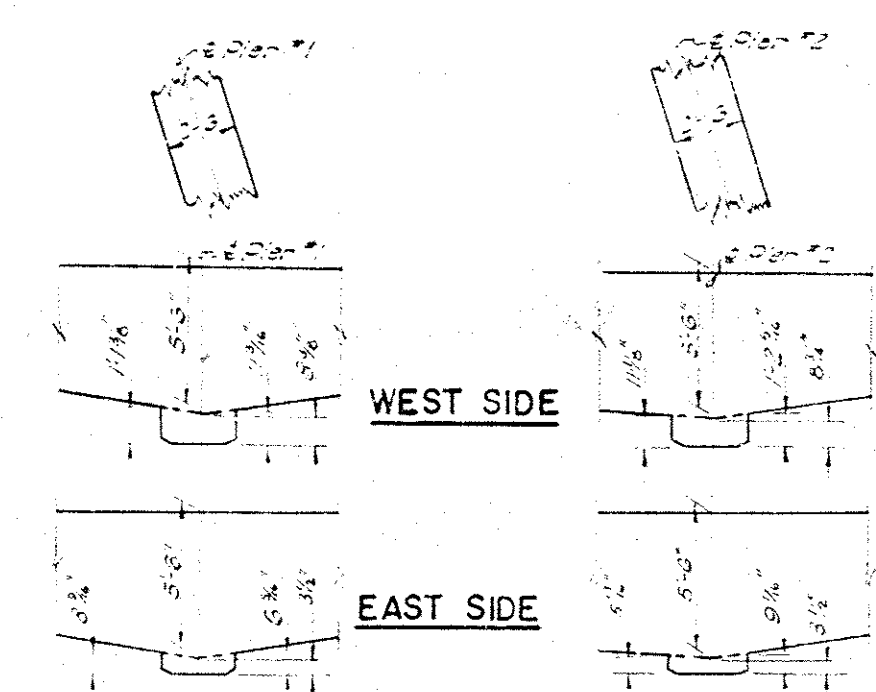

WEST SIDE

EAST SIDE


STR. NO. 11-DETAIL OF SLAB HAUNCHES

REVISIONS	BY	DATE
DESIGN		
DETAIL		
TRACED		
CHECKED		
APPROVED		
SQUAD		


OKLAHOMA STATE HIGHWAY COMMISSION
OKLAHOMA CITY, OKLAHOMA

DETAILS OF SUPERSTRUCTURE
STR. NO. 10
CL STR. ON CL SURVEY 132+90.25
STR. NO. 11
CL STA. ON CL SURVEY 133+10.03
FA. PROJ. I-381 (16) PT. I


PROJECT NO. I-381 (16) PT. I SHEET NO. 64

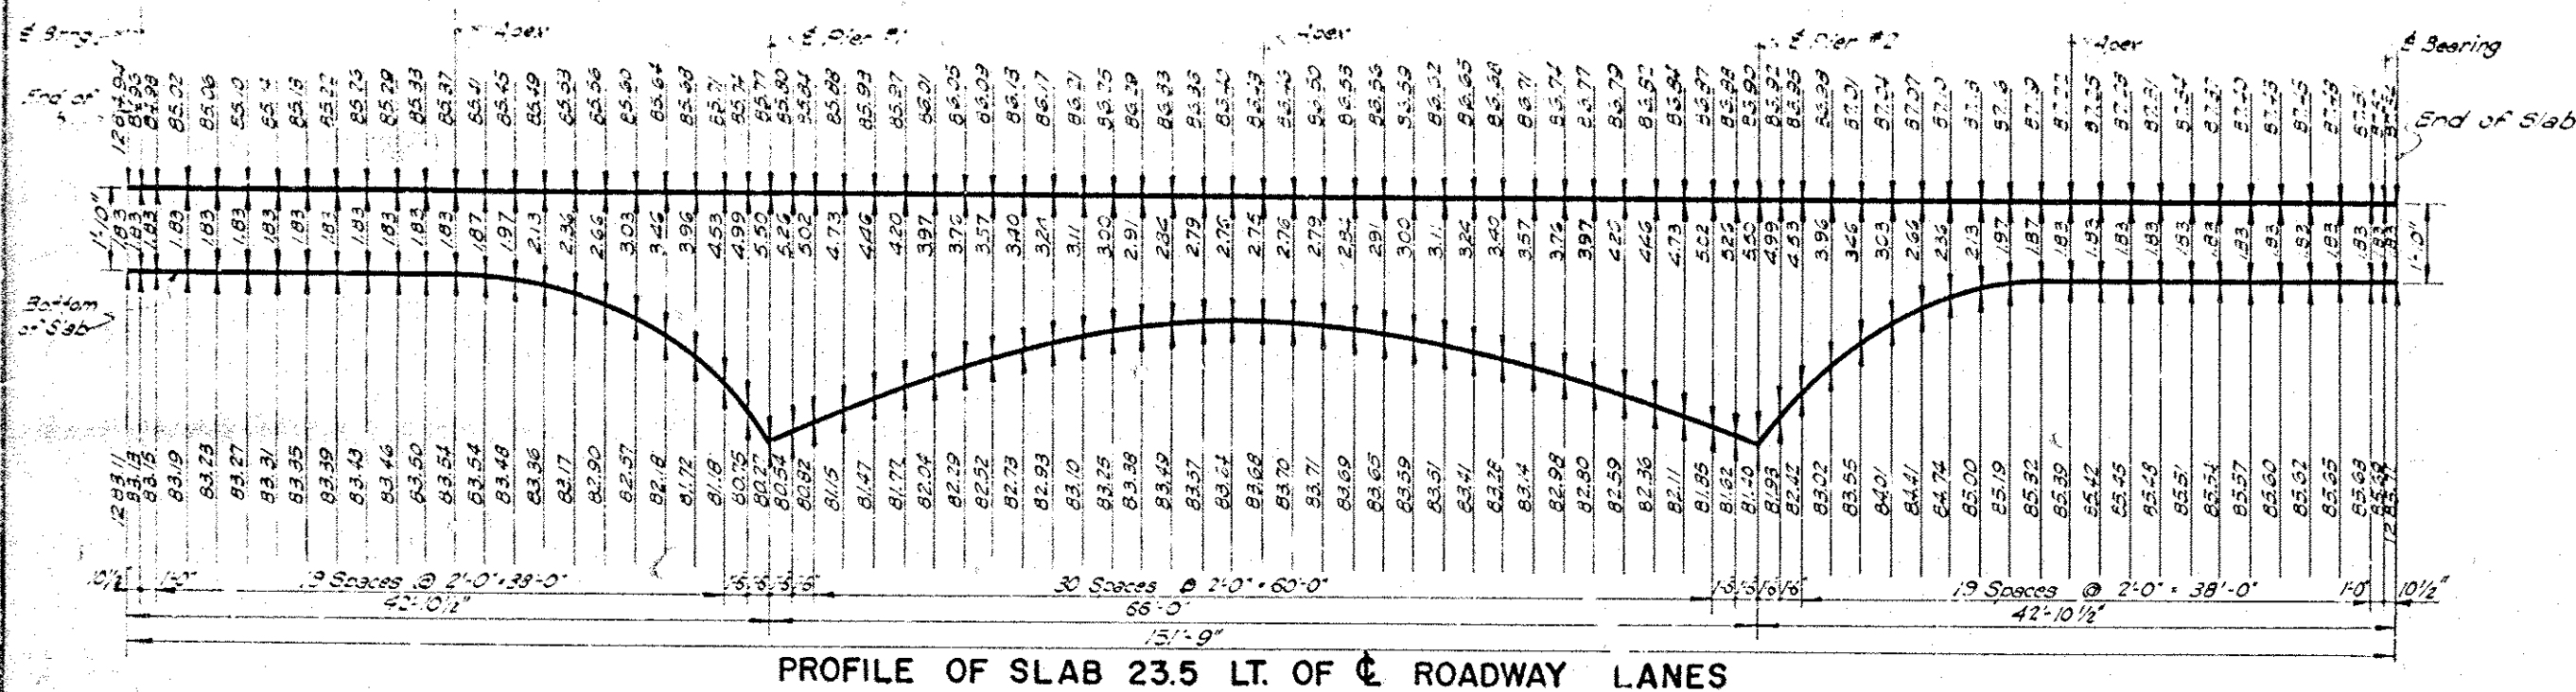

PROFILE OF SLAB 23.5 LT. OF ROADWAY LANES

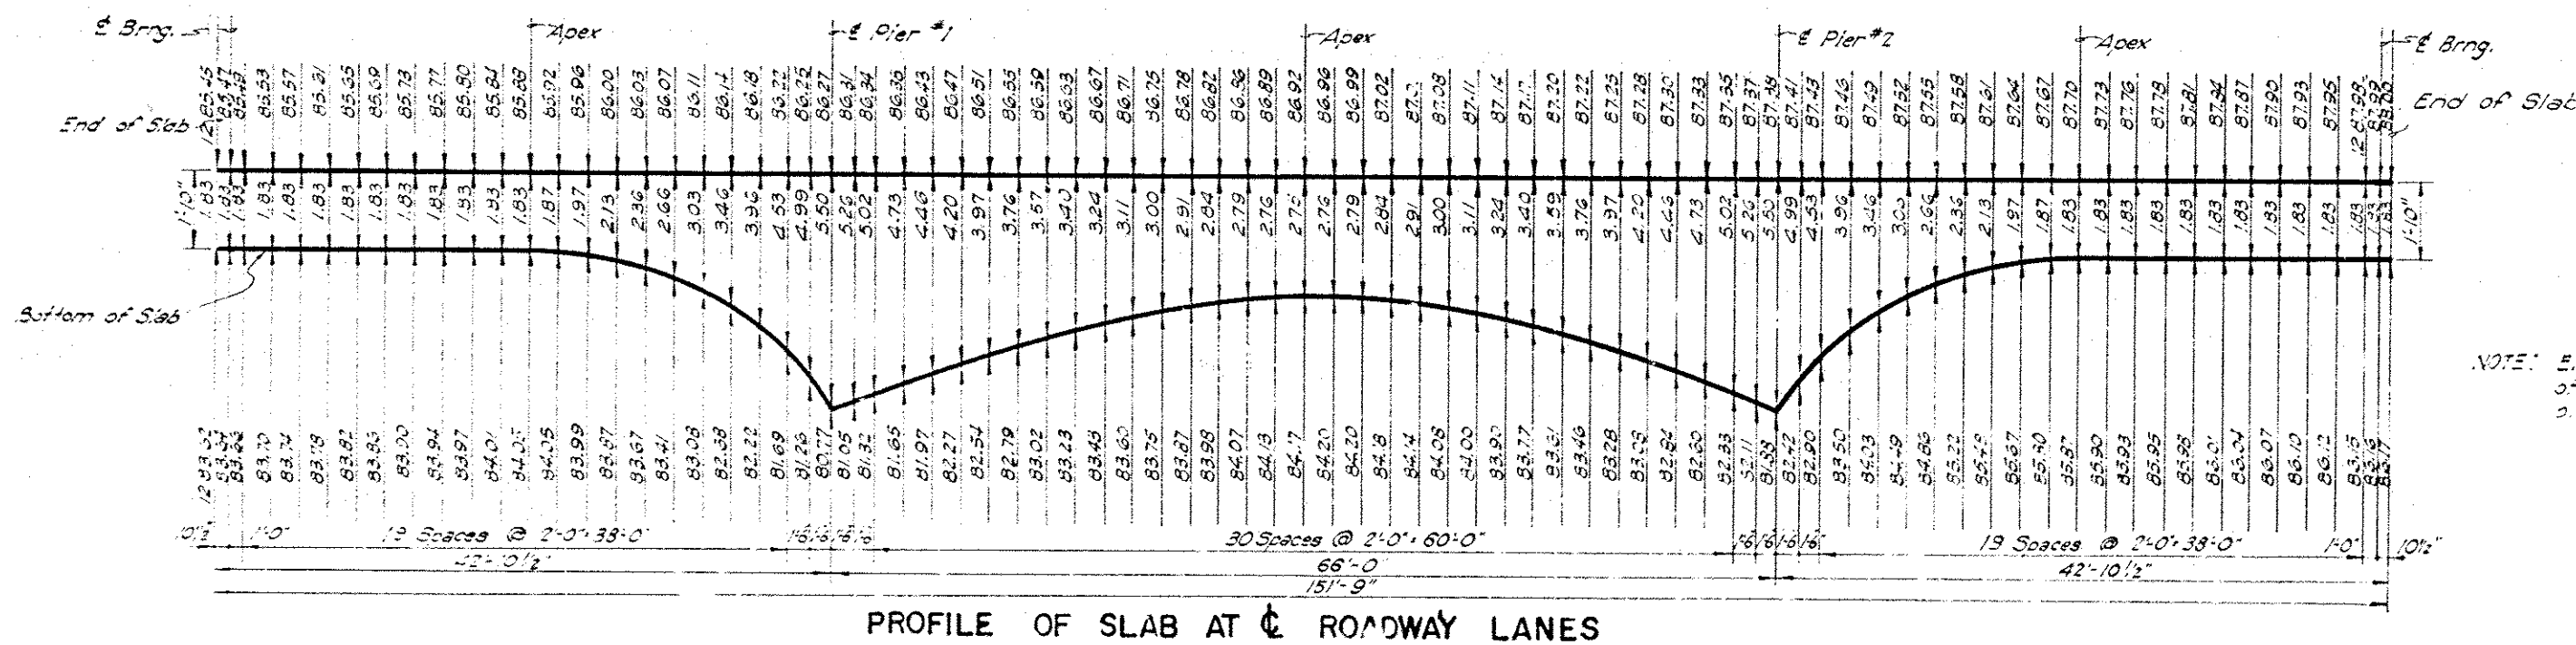


PROFILE OF SLAB AT ROADWAY LANES

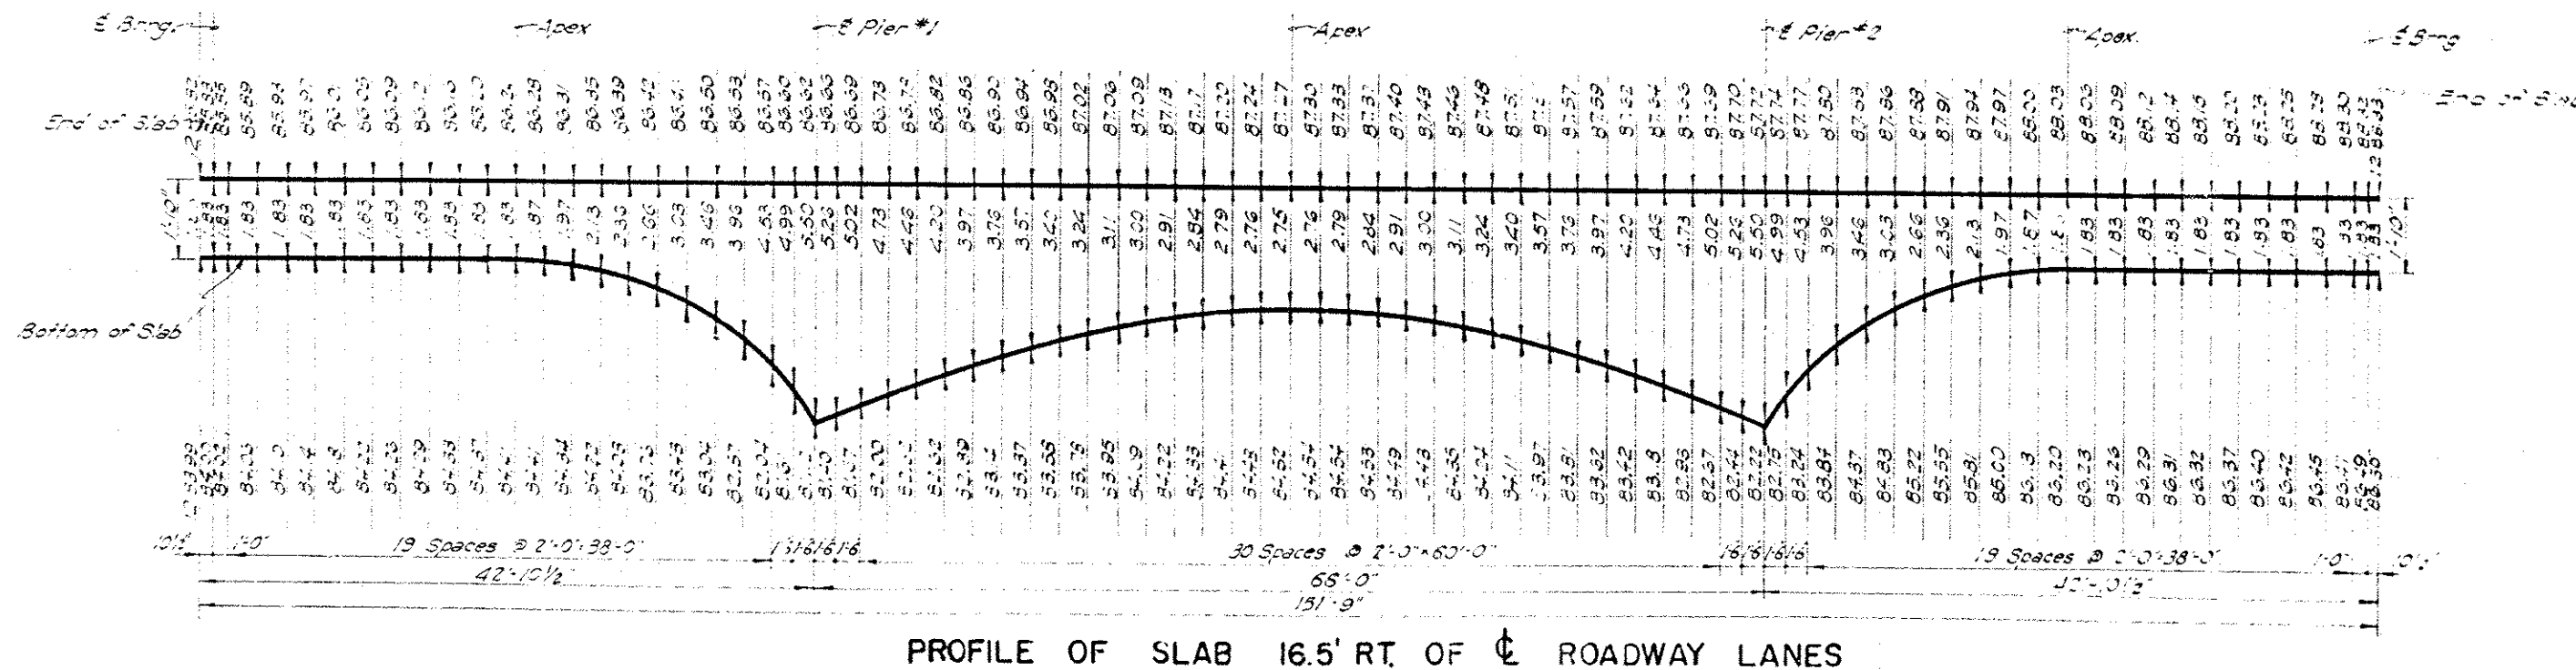

PROFILE OF SLAB 16.5 RT. OF ROADWAY LANES

FED. ROAD DIST. NO.	STATE	PROJ. NO.	SHEET NO.	TOTAL SHEETS
6	OKLA.	I-381(16)PT. I	65	88

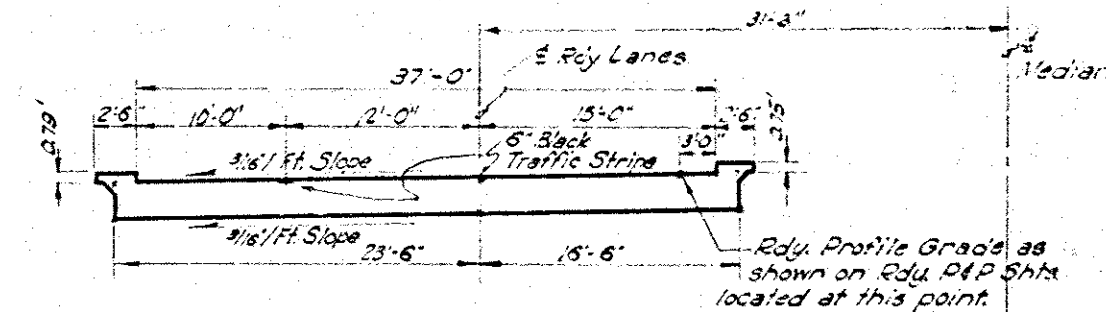


* Points of Elevation.
NOTE: For top of Curb Elevation add 0.294 to top of Slab Elevation.

NOTE: Elevations & Dimensions shown above are for forming Soffit Curves & Top of Bridge Floor. Anticipated deflections due to dead load have been considered & no other allowance for these deflections shall be made.

NOTE: Elevations shown include allowance of 1/8" for dead load deflection on center-line only.

REVISIONS			RECORD		OKLAHOMA STATE HIGHWAY COMMISSION	
NO.	DESCRIPTION	BY DATE	ITEM	BY DATE	OKLAHOMA CITY, OKLAHOMA	
			DESIGN		STRUCTURE NO. 10	
			DETAIL		DETAILS OF SLAB	
			TRACED	1-22	ELEVATIONS	
			CHECKED	2-22	STA. ON SURVEY 132+9025	
			APPROVED		F.A. PROJ. I-381(16)PT. I	
			SIGNED	2-21-51		


FED. ROAD DIST NO.	STATE	PROJ. NO.	SHEET NO.	TOT. SHEETS
6	OKLA.	I-18(14) P.T.	66	46

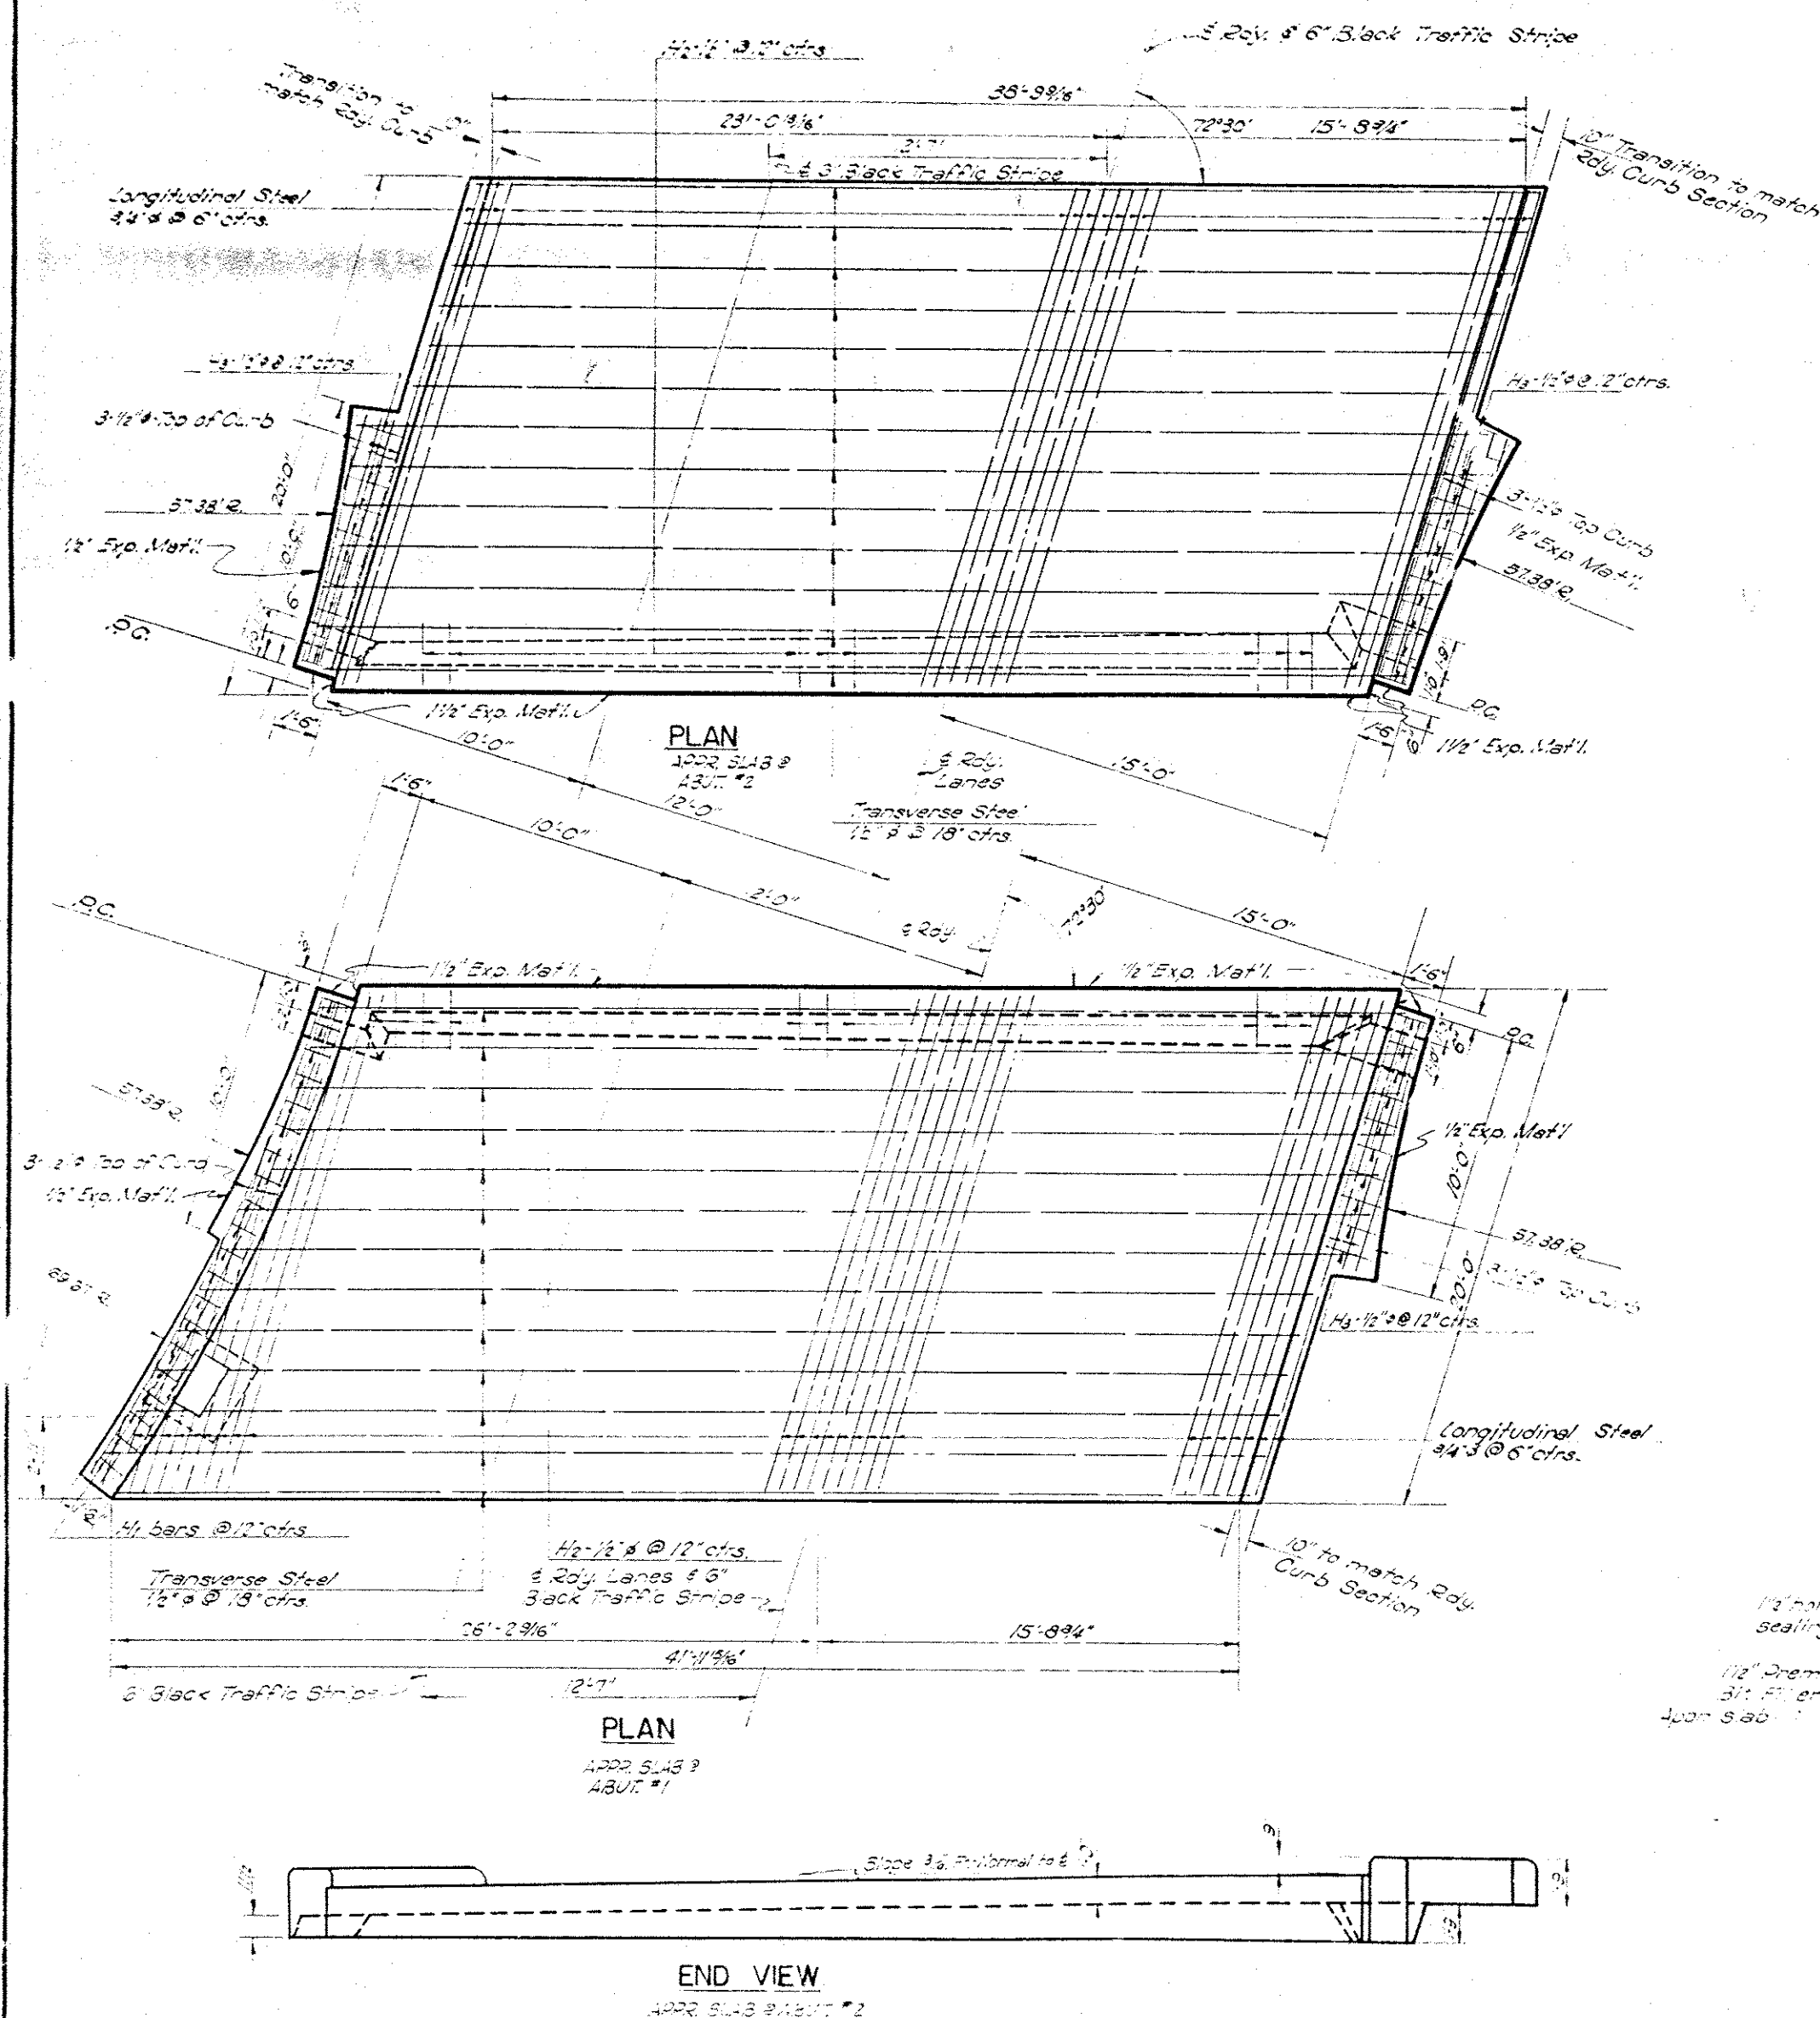

QUANTITIES- ONE APPROACH SLAB		
ITEM	UNIT	TOTAL
Approach Slab	S.Y.	88.754w
* Reinforcing Steel	Lbs.	3,200
6" Black Traffic Stripe	L.F.	40

*Note: Cost of Reinforcing Steel in Approach Slab shall be included in price bid per Sq. Yd. of Approach Slab.

Note: Cost of Curb on Approach Slab shall be included in price bid per Sq. Yd. of Approach Slab.

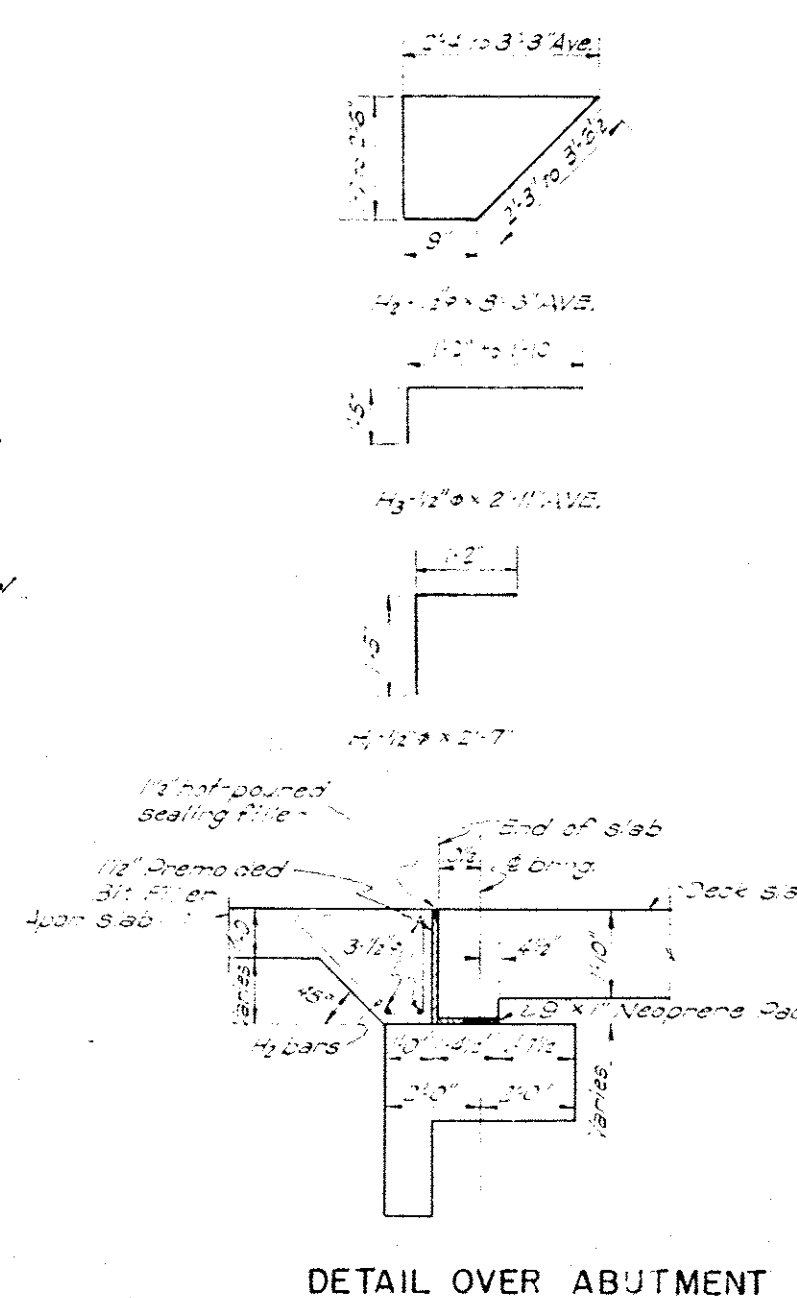


REVISIONS			RECORD		OKLAHOMA STATE HIGHWAY COMMISSION OKLAHOMA CITY, OKLAHOMA
NO.	DESCRIPTION	BY DATE	ITEM	BY DATE	
			DESIGN		STR. NO. 10 DETAILS OF APPROACH SLABS @ STA. ON @ SURVEY 132+90.25
			DETAIL		
			TRACED	4/25	
			CHECKED	2/2 95	
			APPROVED		FA. PROJ. 1-381 (16)PT.-
			SQUAD	3-24-68	

DESIGN DATA

LL H20-44; PGV 20-4

Concrete	10,000 psi
Reinforcing Steel	18,000 psi
Foundation Loads:	
Abutments	20.3 Tons
Piers: Direct Load	29.7 Tons

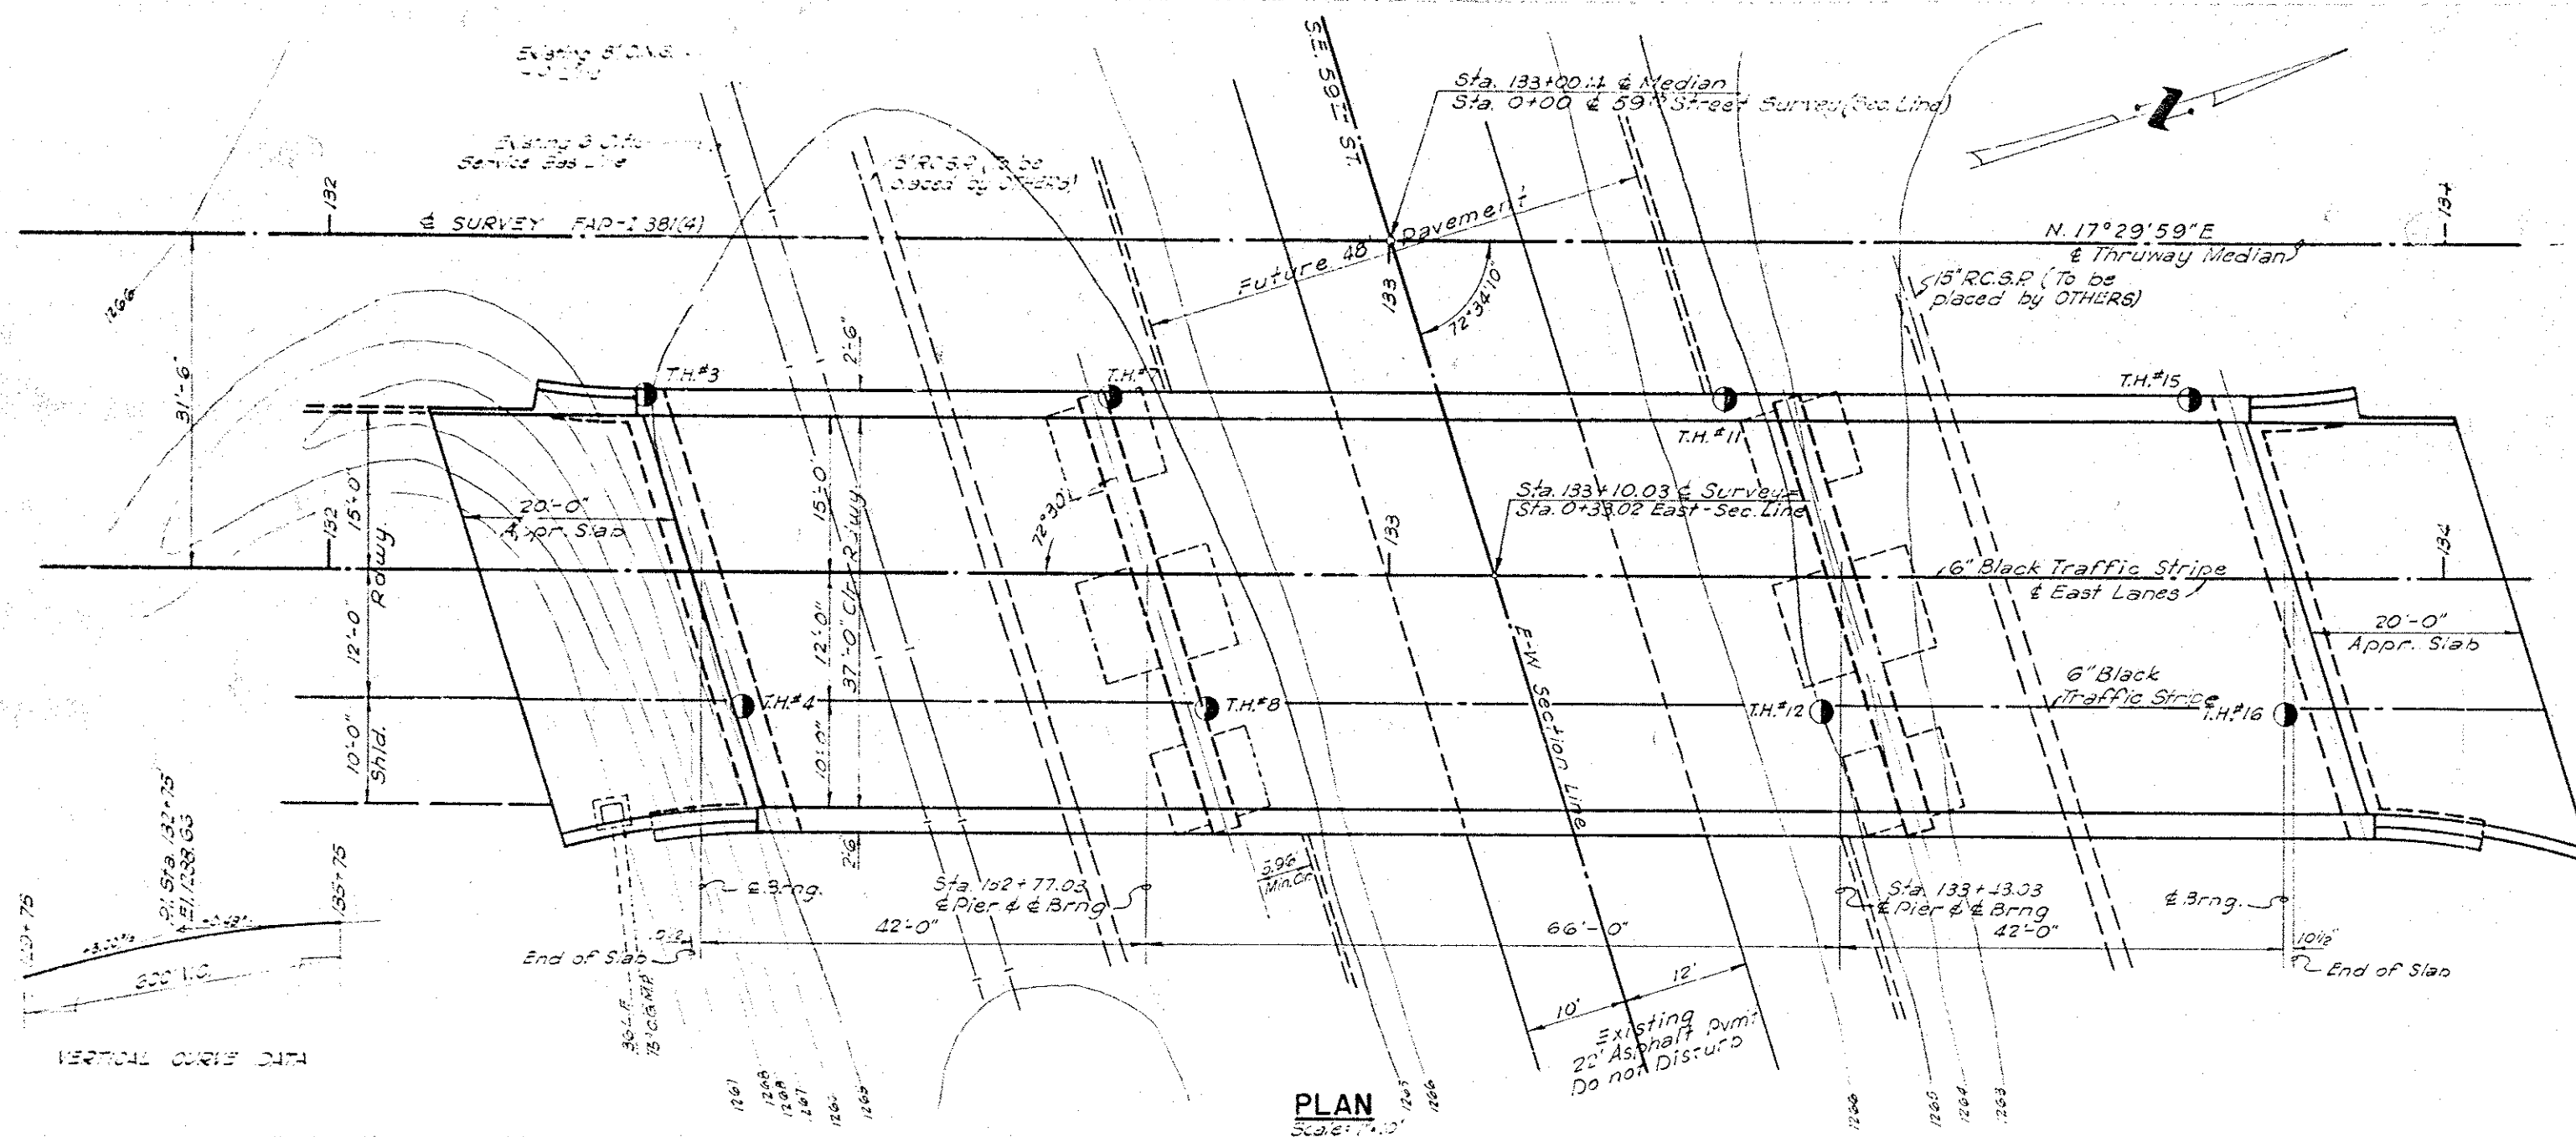


3.14 - 3 on 3.14 Car Derrick Flng - 65 Rt Tan
Sta. 130-23 Elev. 28752

3.14 - 2.2 Spike in hole pole 62 Rt Tan
Sta. 123-46 Elev. 28708

LIST OF SPECIAL PROVISIONS
INCLUDED IN THE PROPOSAL;

See Special Provisions Included in
the Proposal For Curing Concrete
with Membrane Curing Compound
for Bridge Structures Including
Parapet Walls, Retaining Walls &
Railing 414.6 (a) Rev. 7-27-55

Equipment For Driving Piles
514-1(a) Reinforcing Steel (Axle Steel) -
723-1(a) Rev. 2-21-57.
Black Traffic Stripe or Black Traffic
Stripe Arrow 624-1(a) Rev. 01-8-55. 6" x 12" Width, 25' Lg.
Neoprene Rubber For bearing drives

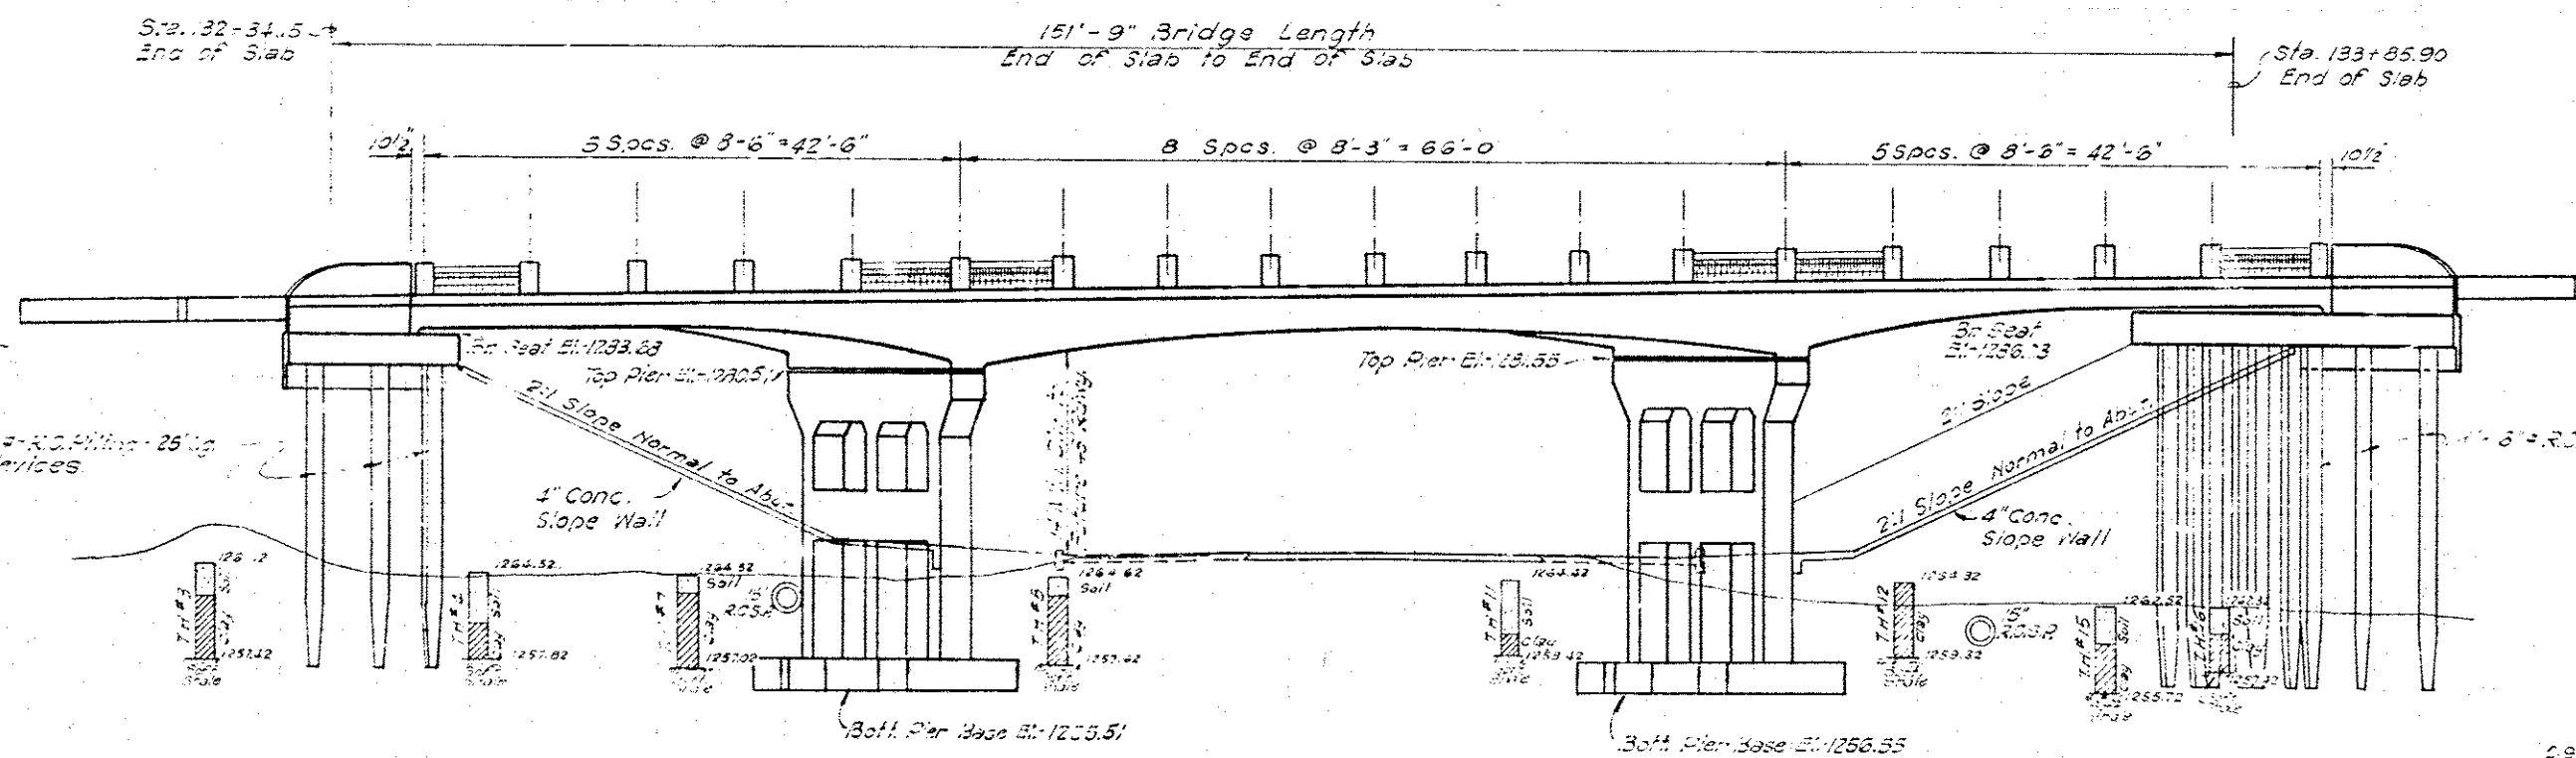

GENERAL ELEVATION

Scale: 1"=10'

[illegible]

132

RESERVES LIST & Chgs.

DETAILS	27	4307VENTS----	8-5577	60
DETAILS	27	PIERS-----	8-5578	61
DETAILS	27	SUPERSTOR-----	8-5579	62
DETAILS	27	SLAS SLEV-----	8-5579	63
DETAILS	27	400R SLNS-----	8-5579	60
DETAILS	27	400R SLNS-----	8-5579	60
DETAILS	27	FLNG-----	8-5579	62

RECORD	
ITEM	BY DATE
DESIGN	
DETAIL	
TRACED	2005
CHECKED	222 9/5
APPROVED	
SQUAD	221-201

SKEW 72°-30' RT. FWD.

OKLAHOMA STATE HIGHWAY COMMISSION
OKLAHOMA CITY, OKLAHOMA

STR. NO. 11
GENERAL ELEVATION, PLAN
& SUMMARY OF QUANTITIES
42'-66'-42" CONC. SLAB SPANS
30' RDY & 2-18" S.C.'s
① STA. ON ① SURVEY 133 + 10.03
FA. PROJ. 1-381 (6) PT.-1

250


STATE	PROJECT NO.	SHEET NO.	TOTAL SHEETS
OKLA.	I-381(6)PT.1	68	88

BAR LIST-ONE ABUT.

Bar	No.	Size	Form	Length
H ₁	15	3/4"	Str.	43'-0"
H ₂	110	1/2"	Str.	3'-8"
H ₃	10	3/4"	Str.	13'-5 1/2"
H ₄	34	3/4"	Str.	2'-10"
H ₅	10	3/4"	Str.	12'-3"
CH ₁	3	1/2"	Str.	41'-7"
CH ₂	3	1/2"	Str.	11'-6"
CH ₃	5	1/2"	Str.	11'-0"
CH ₄	3	1/2"	Str.	43'-0"
CH ₅	3	1/2"	Str.	12'-4"
V ₁	58	1/2"	Str.	2'-0"
V ₂	40	1/2"	Str.	3'-0"
V ₃	24	1/2"	Str.	2'-2"
WH ₁	12	1/2"	Str.	9'-6"
WH ₂	12	1/2"	Str.	7'-0 1/2"
WH ₃	6	1/2"	Str.	7'-0"
WH ₄	6	1/2"	Str.	6'-9"
WH ₅	27	1/2"	Str.	7'-0 1/2"
WH ₆	22	1/2"	Str.	6'-3 1/2"
H	21	3/4"	Str.	3'-8"

QUANTITIES-ONE ABUTMENT


Quantity	Concrete	Steel
Class 4 Concrete	64	33.1
Reinforcing Steel	108	33.0
Subtotal Steel - Common	64	95

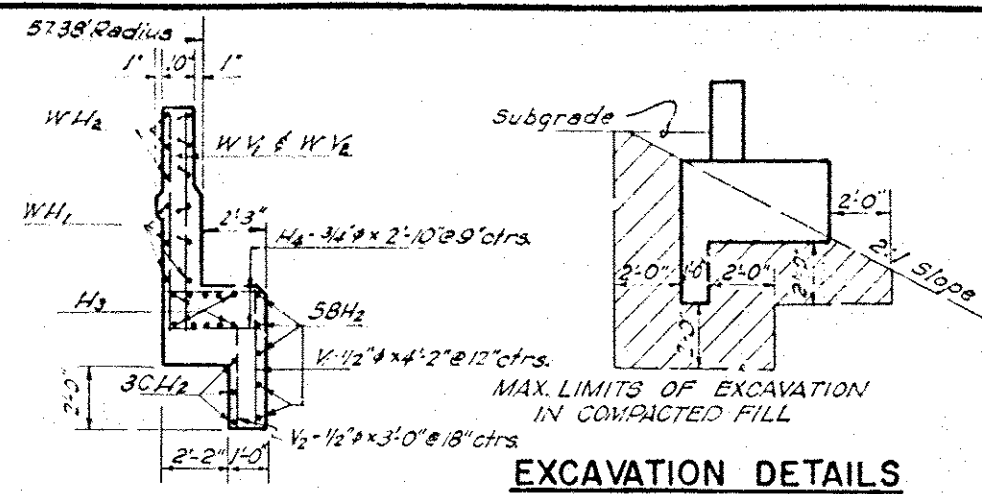


SECTION A-A

Refer to identical note on Sheet No. 21

END VIEW OF WING

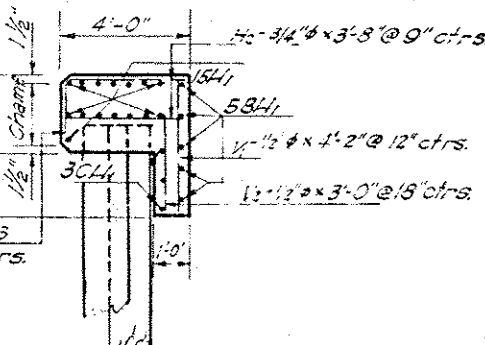

SECTION B-B

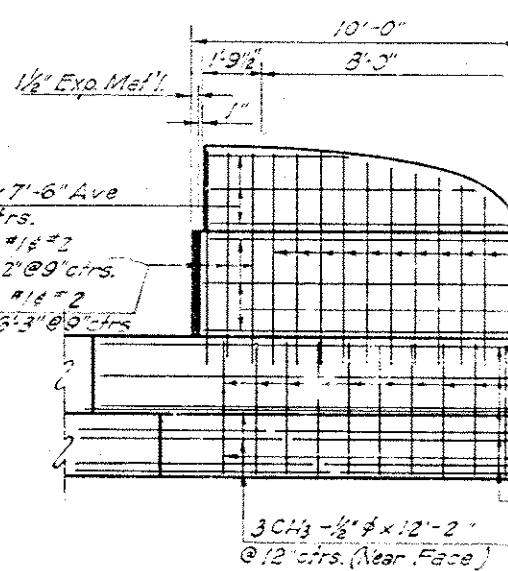


SECTION C-C

GENERAL NOTES:


1. Construction materials shall be in accordance with the Oklahoma Standard Specifications of 1954 & 1957.
2. Reinforcing steel shall conform to ASTM Specs. A-305-42.
3. Shaded concrete edges shall have a 4\"/>

REVISIONS				RECORD		OKLAHOMA STATE HIGHWAY COMMISSION	
NO.	DESCRIPTION	BY	DATE	ITEM	DATE	OKLAHOMA CITY, OKLAHOMA	
				DESIGN			
				DETAIL			
				TRACED			
				CHECKED			
				APPROVED			
				SQUAD			

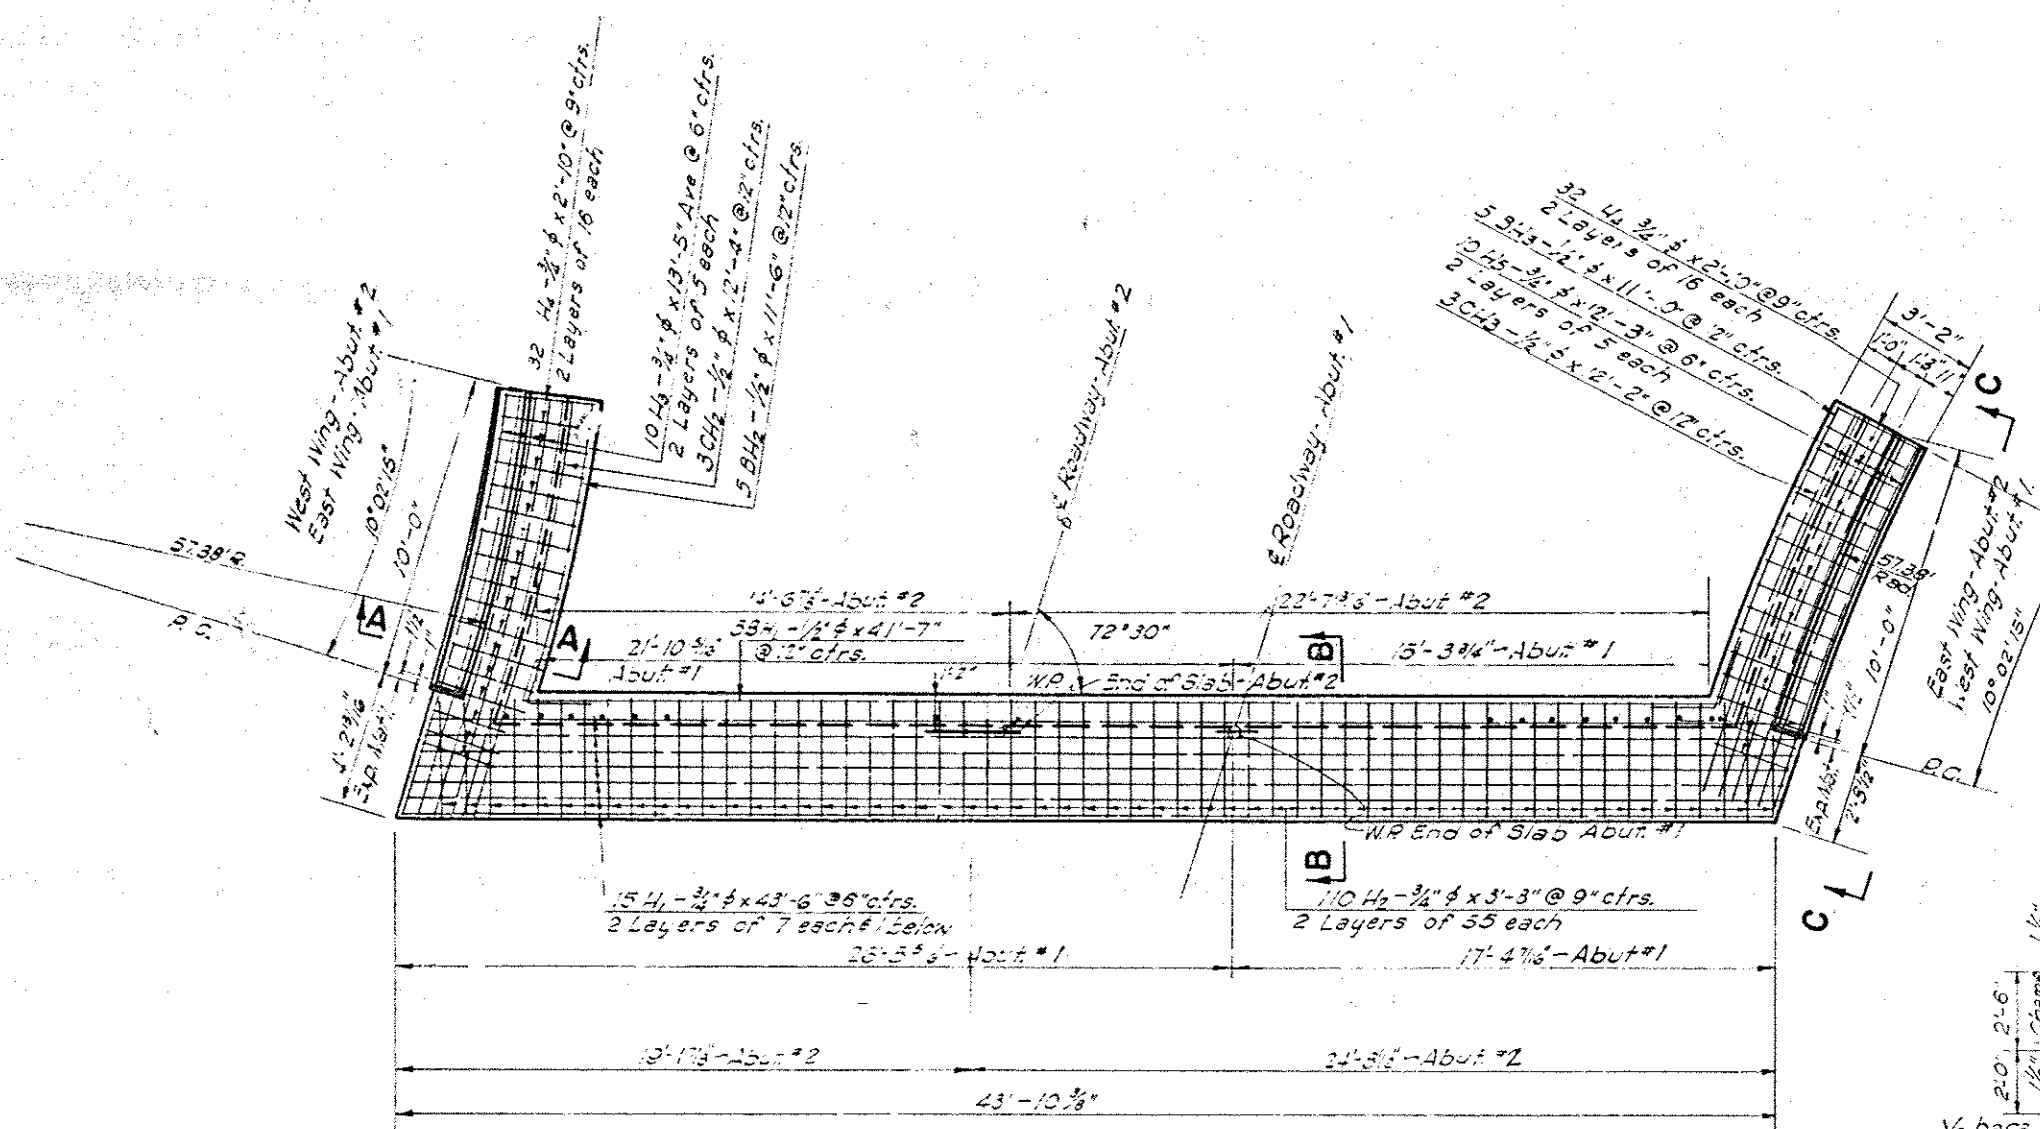


PLAN


5-3/4\"/>

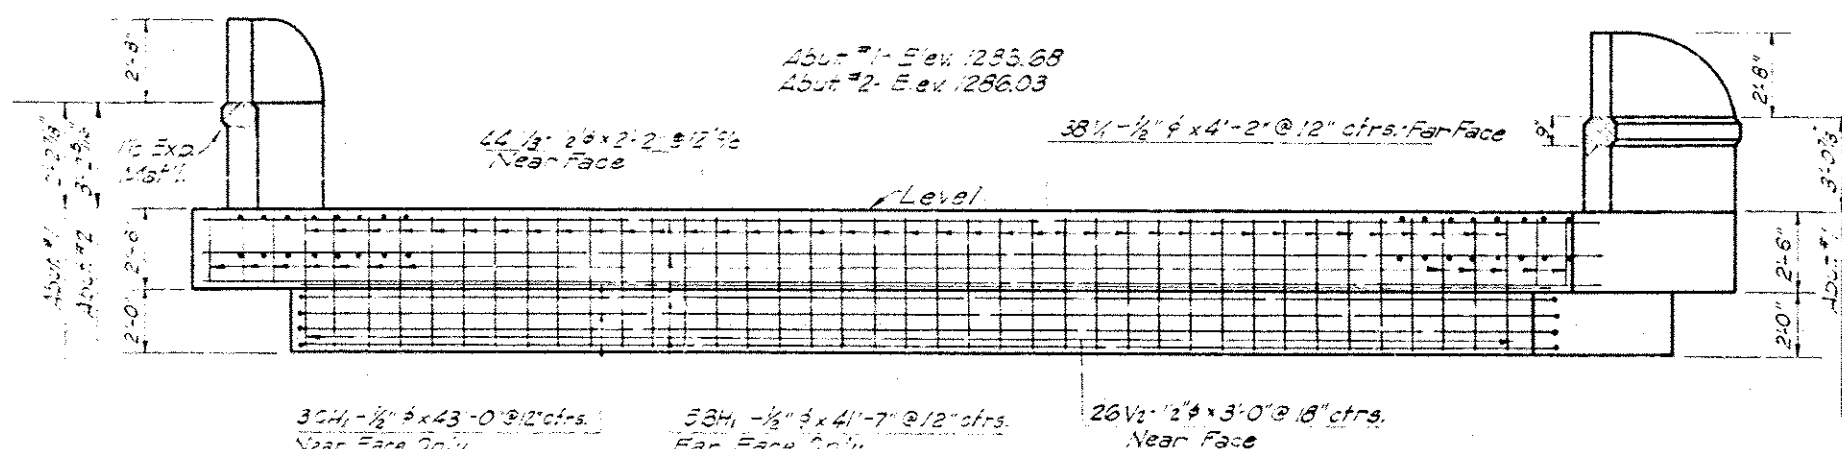

ELEVATION

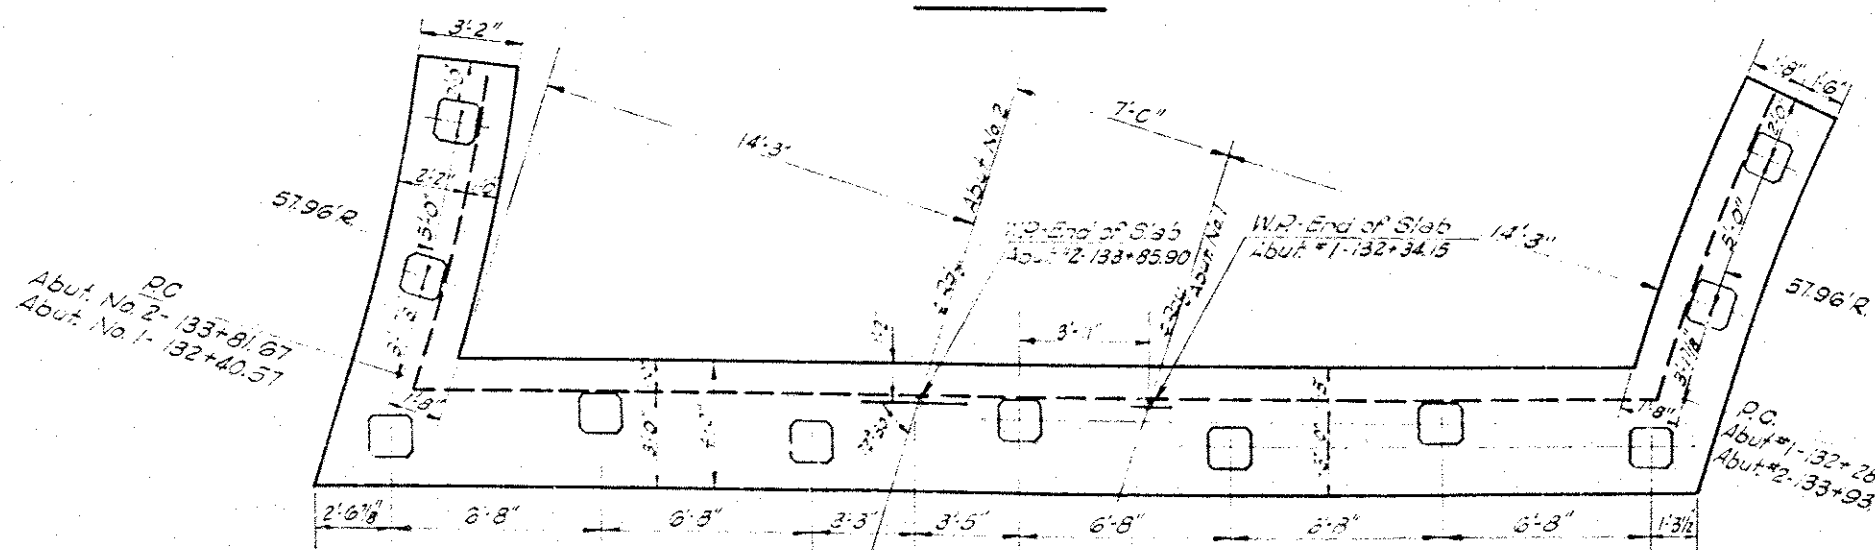


PILE SPACING DIAGRAM

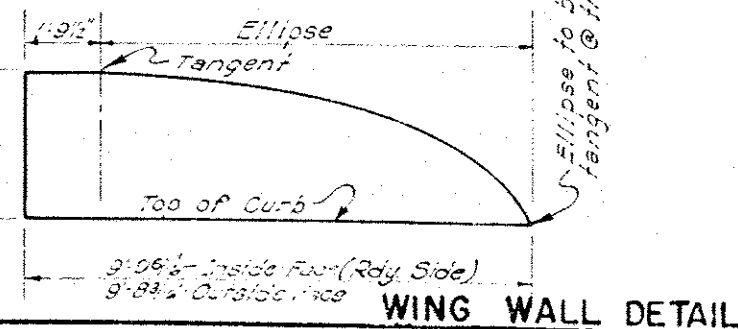


WING WALL DETAIL

FED. ROAD DIST. NO.	STATE	PROJ. NO.	SHEET NO.	TOTAL SHEETS
6	OKLA.	I-381(4)PT-1	69	88

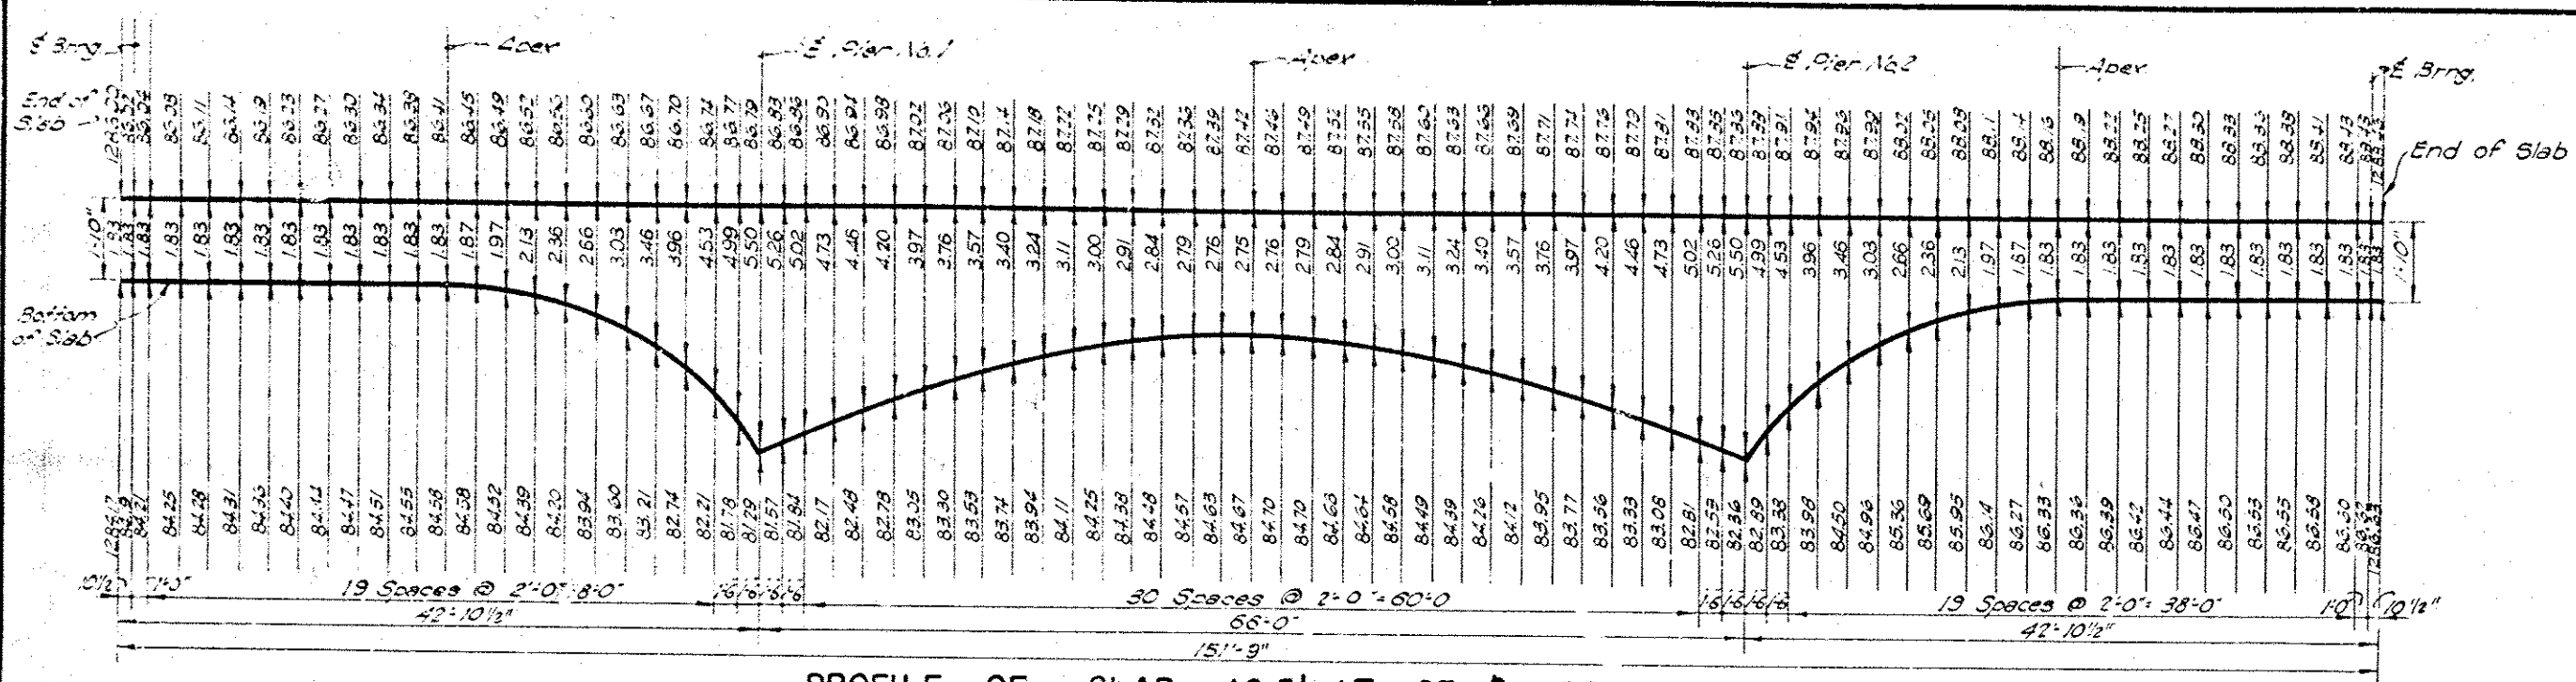

PROFILE OF SLAB 16.5' LT. OF ROADWAY LANES

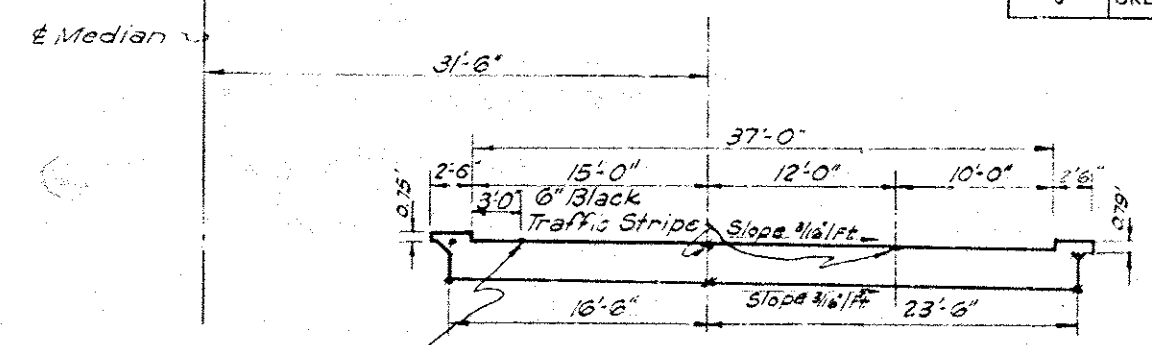


Rdy. Profile as Shown on Rdy. P&P Shfts. located at this point.

* Points of Elevation


NOTE: For top of Curb Elevation add 0.75' to top of Slab Elevation at Lt. Curb "R".

NOTE: Elevations & Dimensions shown above are for forming soffits. Curves & Top of Bridge Floor. Anticipated deflections due to dead load have been considered & no other allowance for these deflections shall be made.

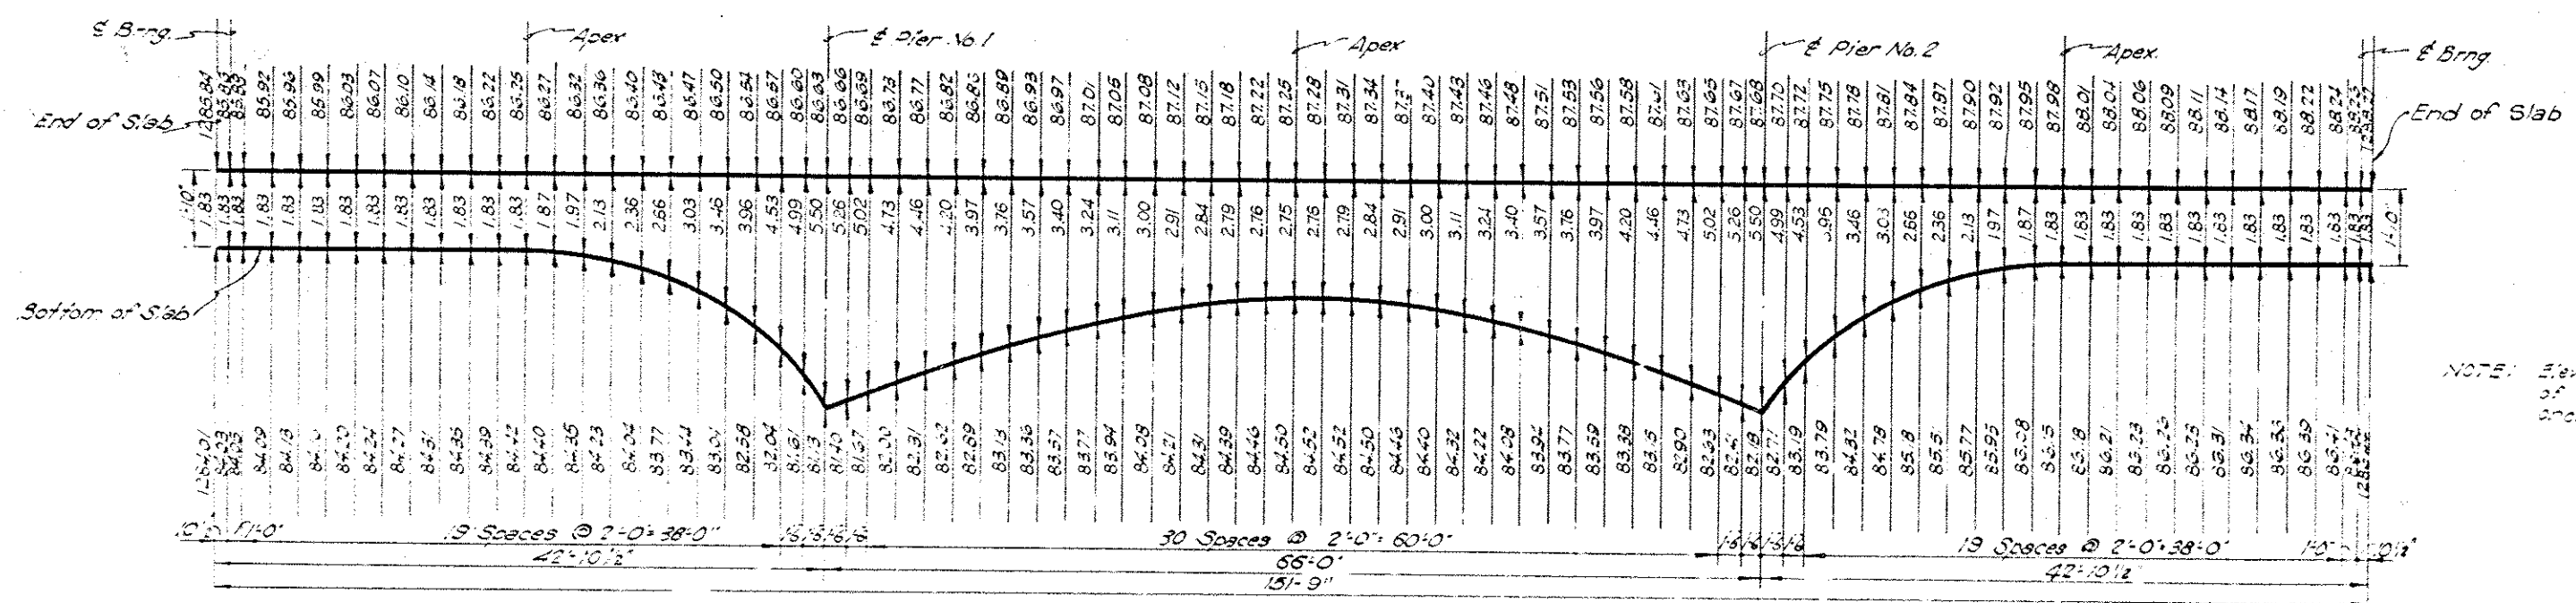

PROFILE OF SLAB AT ROADWAY LANES


NOTE: Elevations shown include allowance of .8" for dead load deflection center-span only.

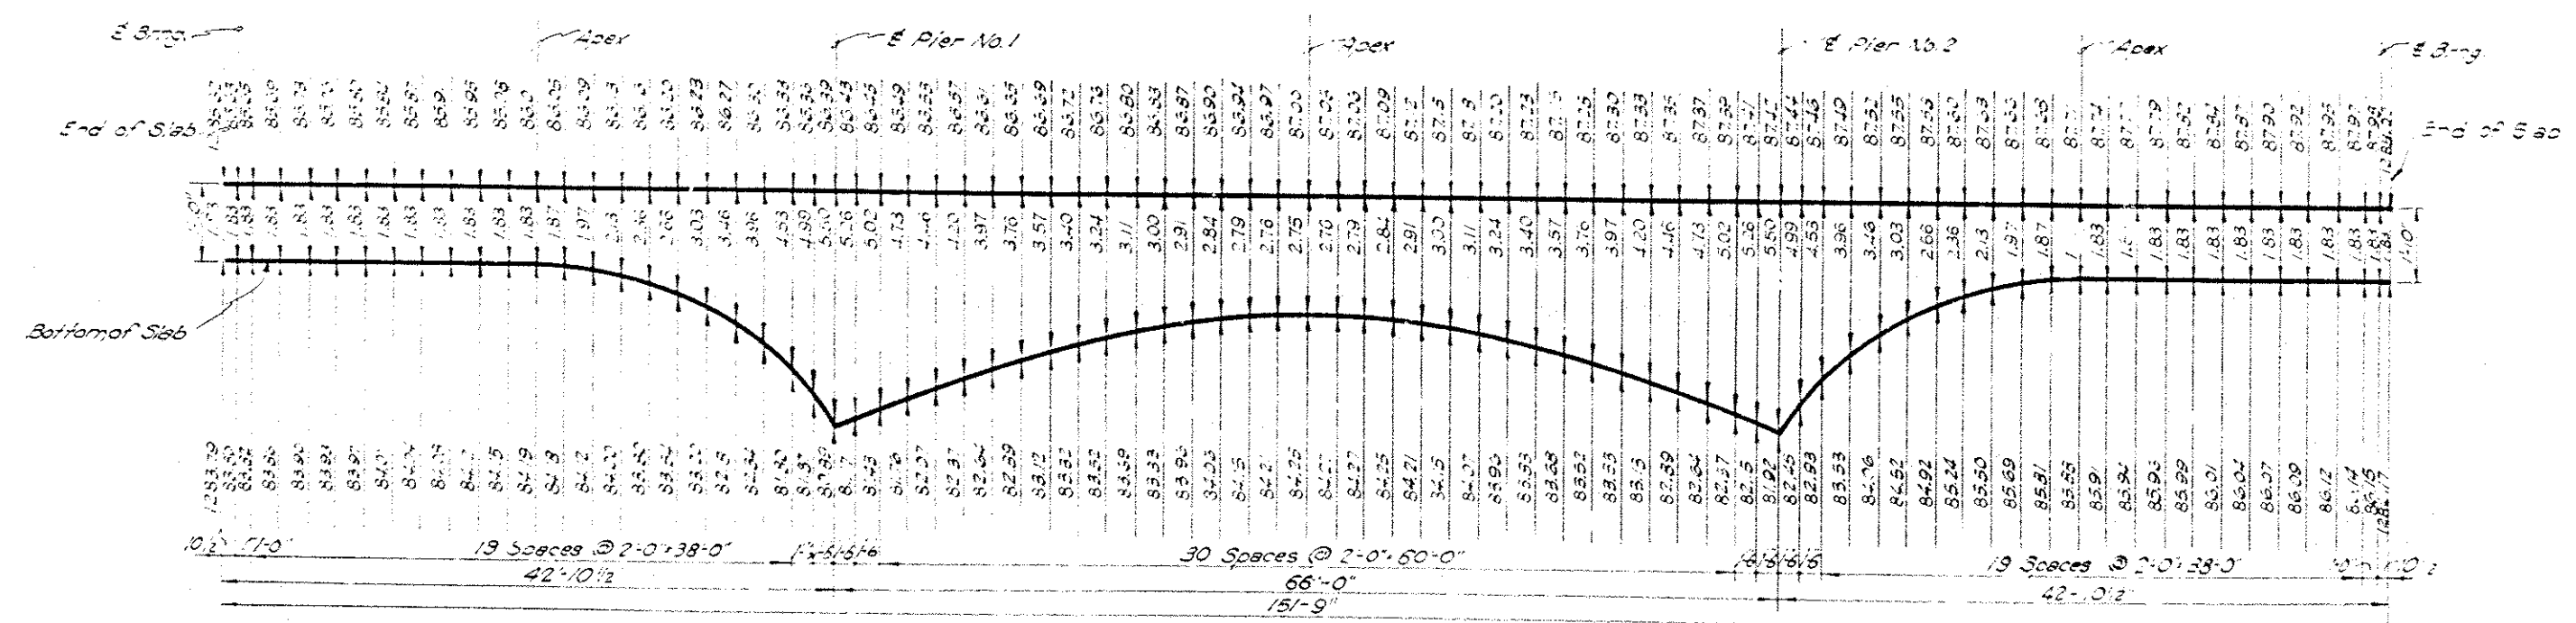

PROFILE OF SLAB 23.5' RT. OF ROADWAY LANES







REVISIONS			RECORD		OKLAHOMA STATE HIGHWAY COMMISSION OKLAHOMA CITY, OKLAHOMA STRUCTURE NO. 11 DETAILS OF SLAB ELEVATIONS CL STA. ON CL SURVEY 133+10.03 F.A. PROJ. I-381(4)PT-1
NO.	DESCRIPTION	BY DATE	ITEM	BY DATE	
			DESIGN		
			DETAIL		
			TRACED		
			CHECKED		
			APPROVED		
			SQUAD		

FED. ROAD DIST. NO.	STATE	PROJ. NO.	SHEET NO.	TOTAL SHEETS
5	OKLA.	1-381(4) PT-1	70	88

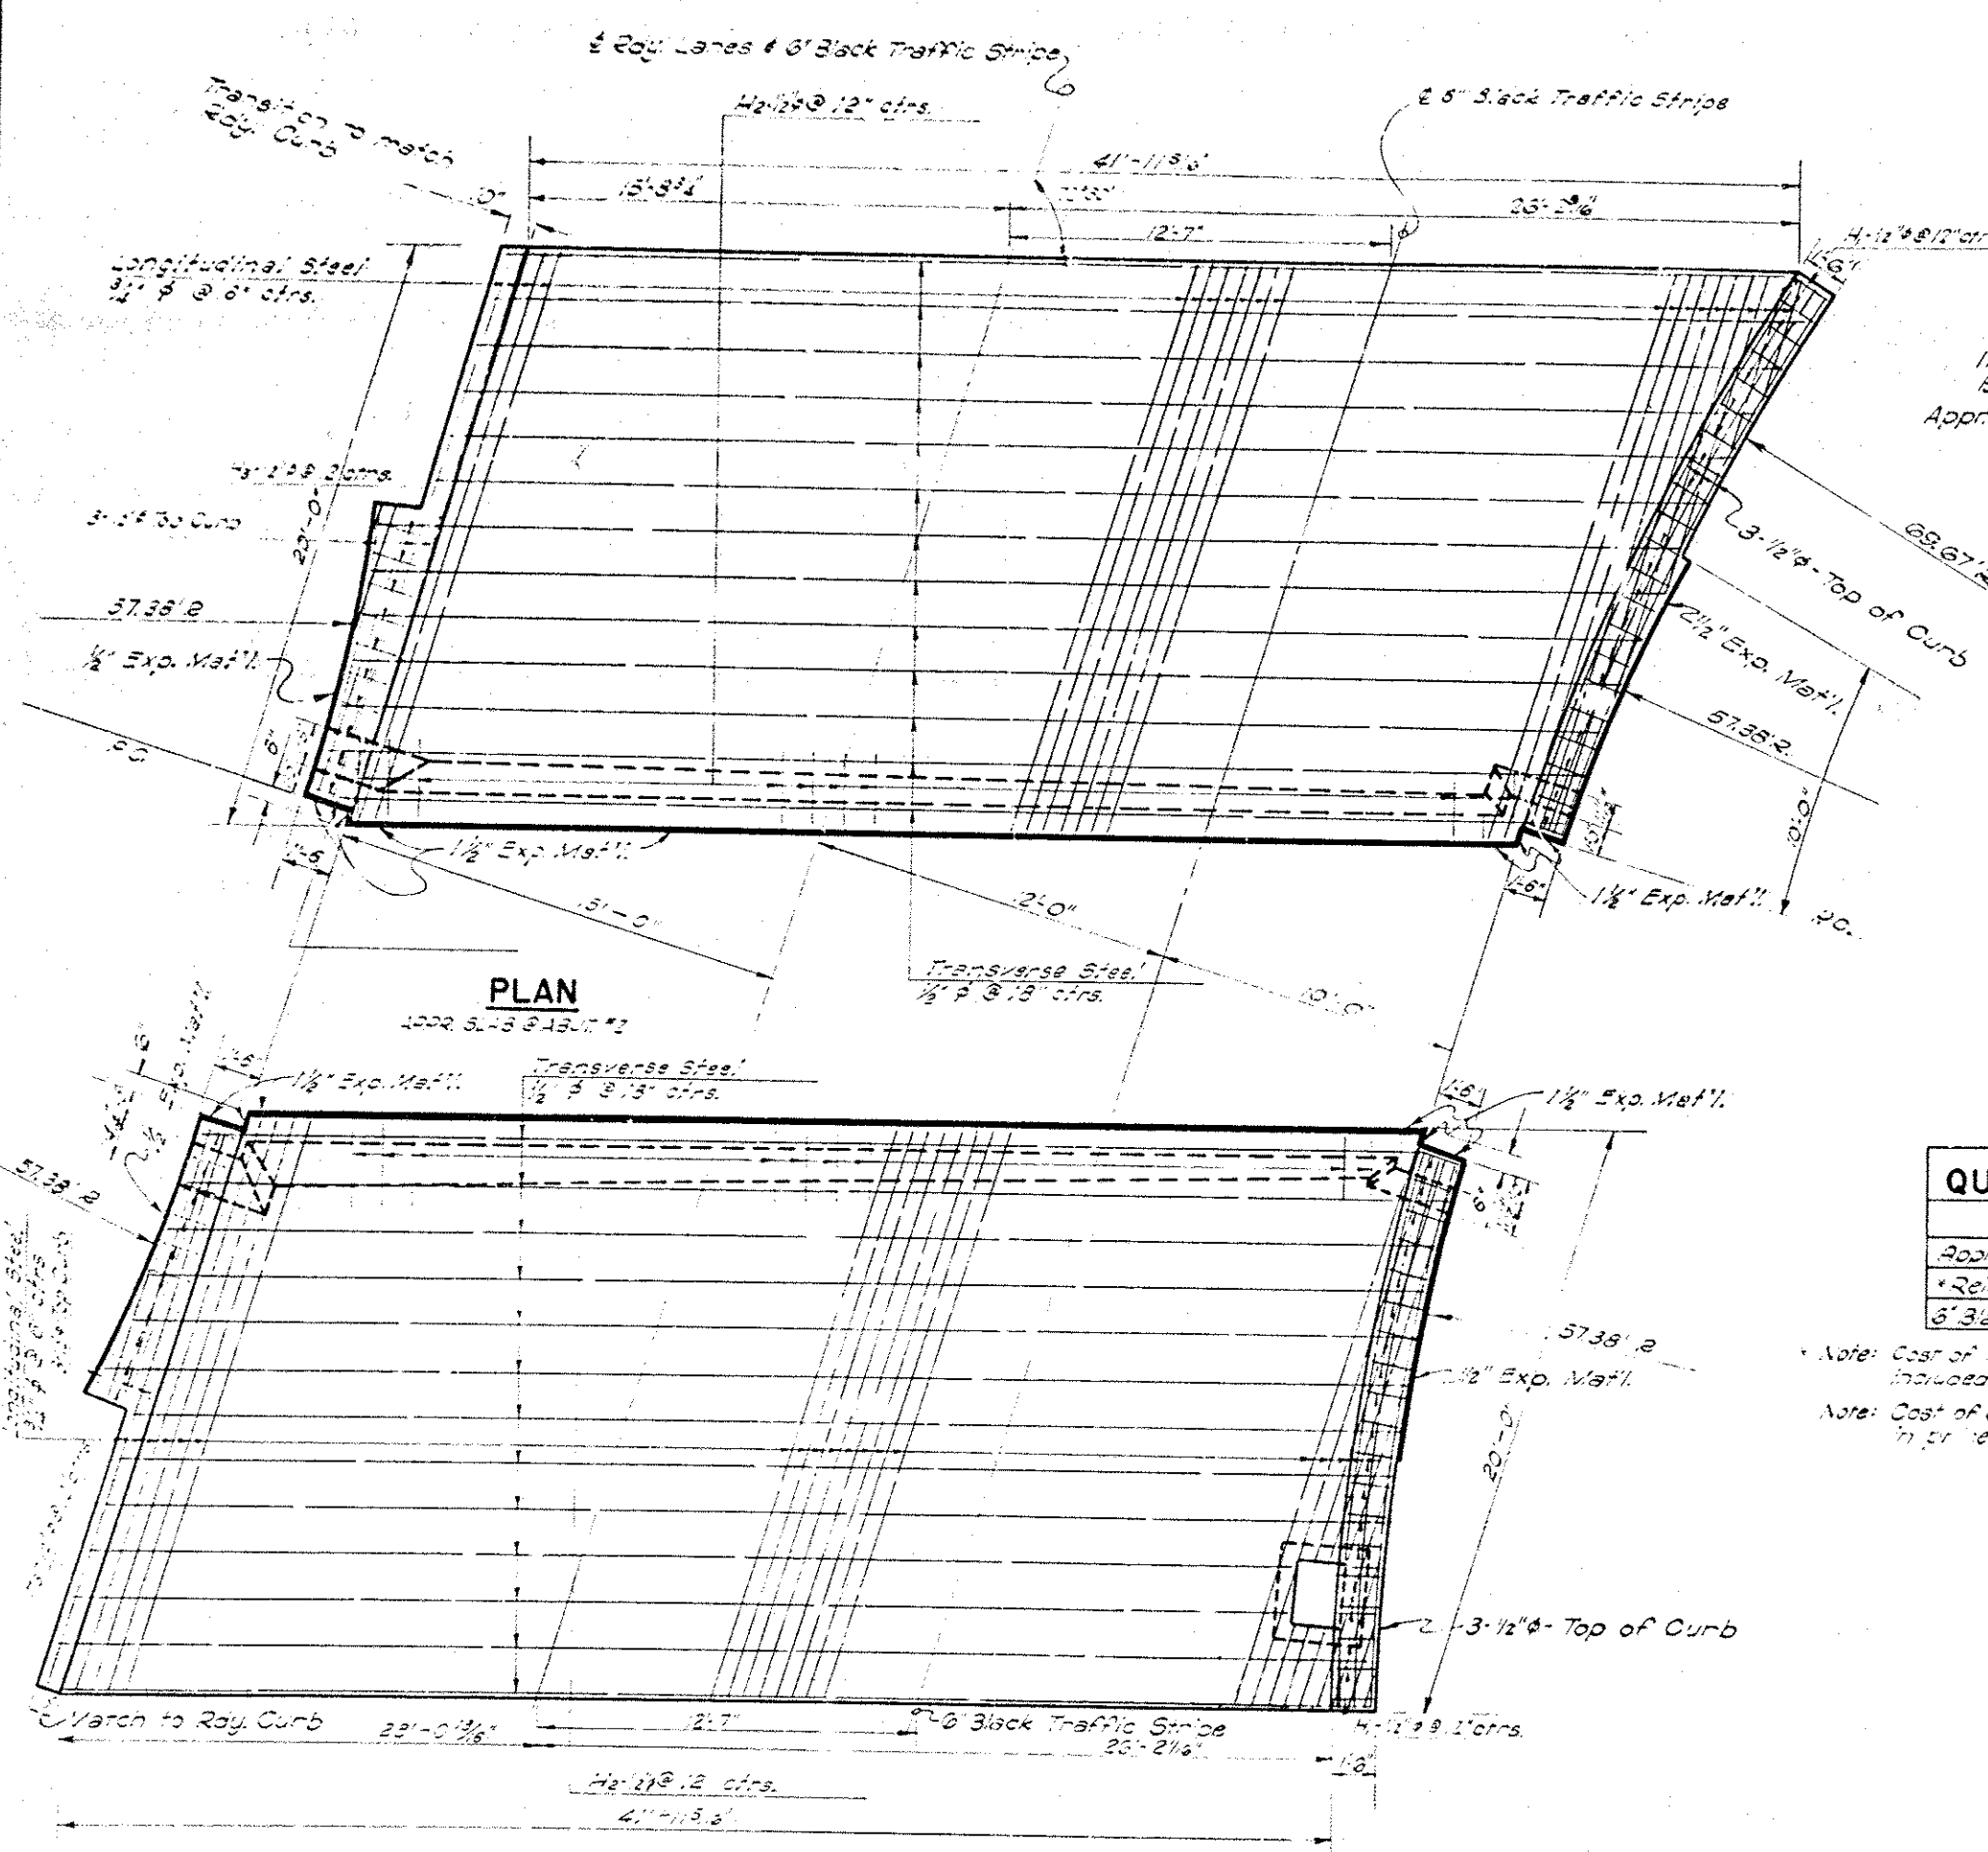

QUANTITIES-ONE APPROACH SLAB			
ITEM	UNIT	TOTAL	
Approach Slab	Sq. Yd.	9,354.16	
Reinforcing Steel	Lbs.	8,200	
Black Traffic Stripe	Lf.	10	


Note: Cost of Reinforcing Steel in Approach Slab shall be included in price bid per Sq. Yd. of Approach Slab.
 Note: Cost of Curb on Approach Slab shall be included in price bid per Sq. Yd. of Approach Slab.

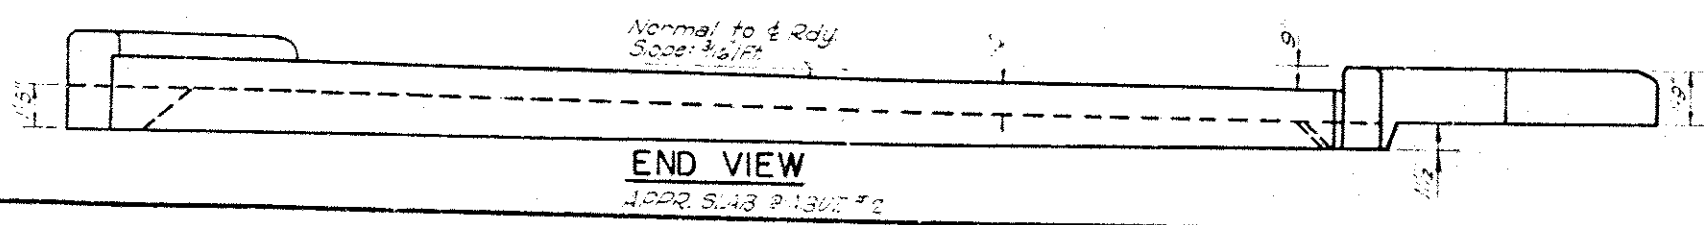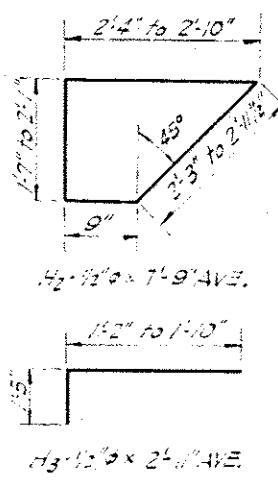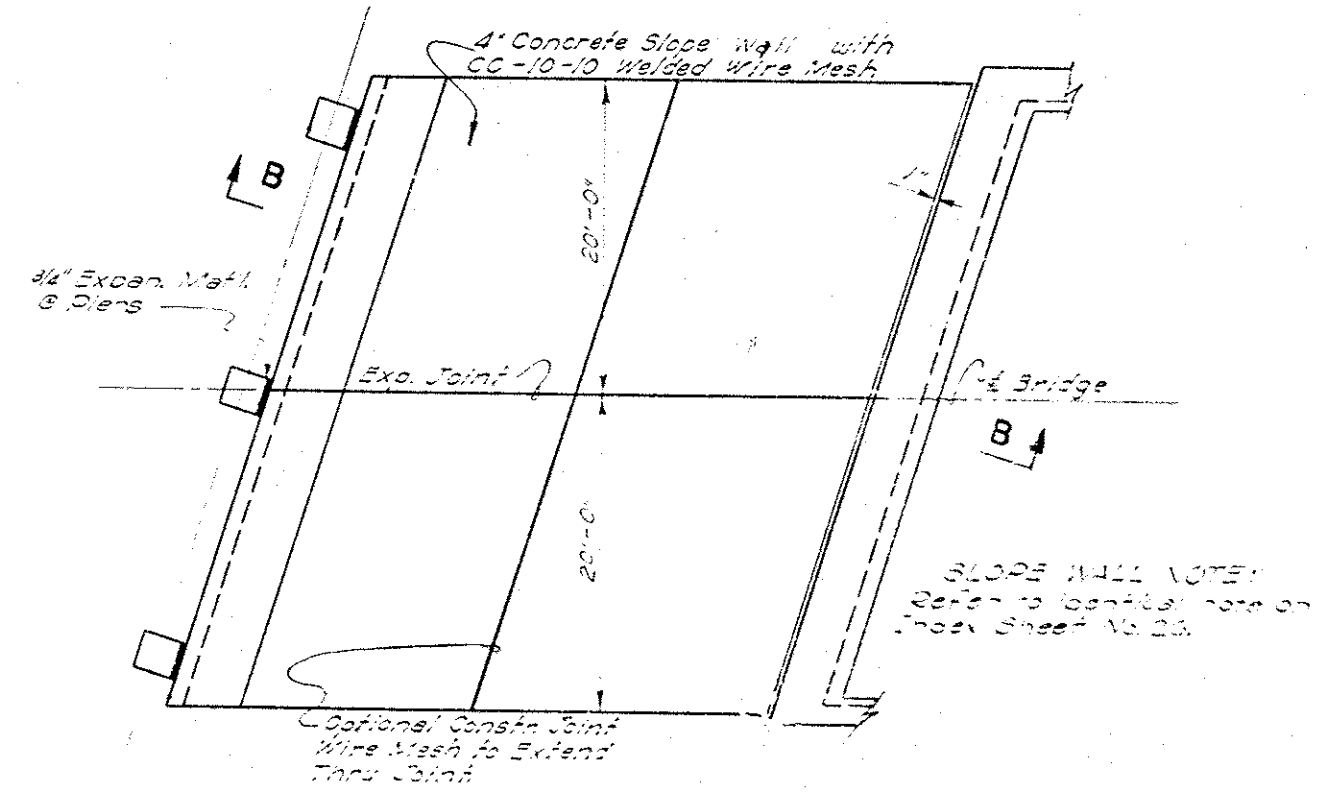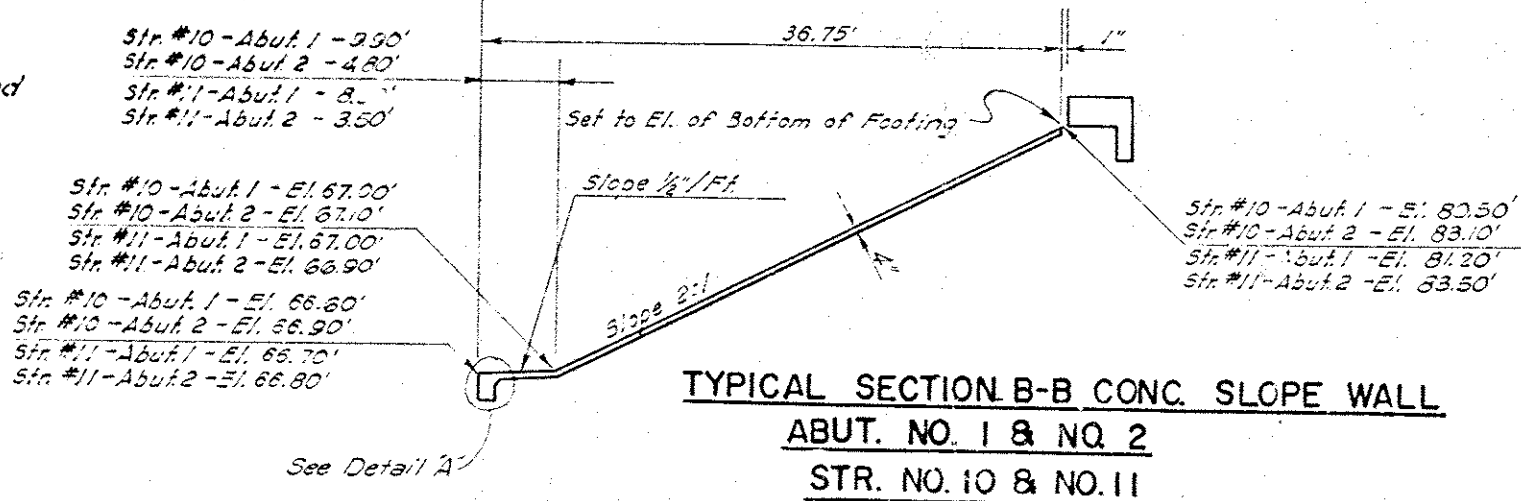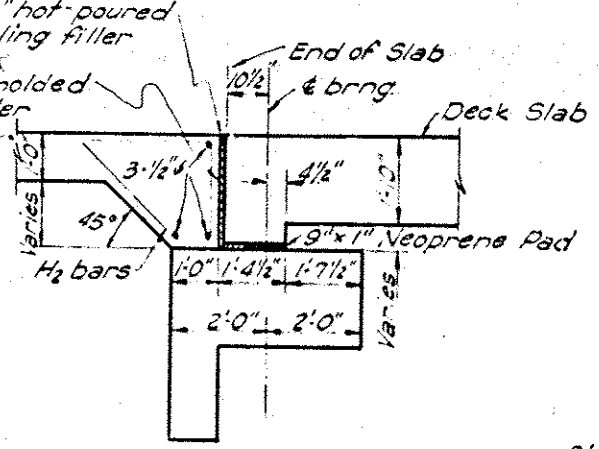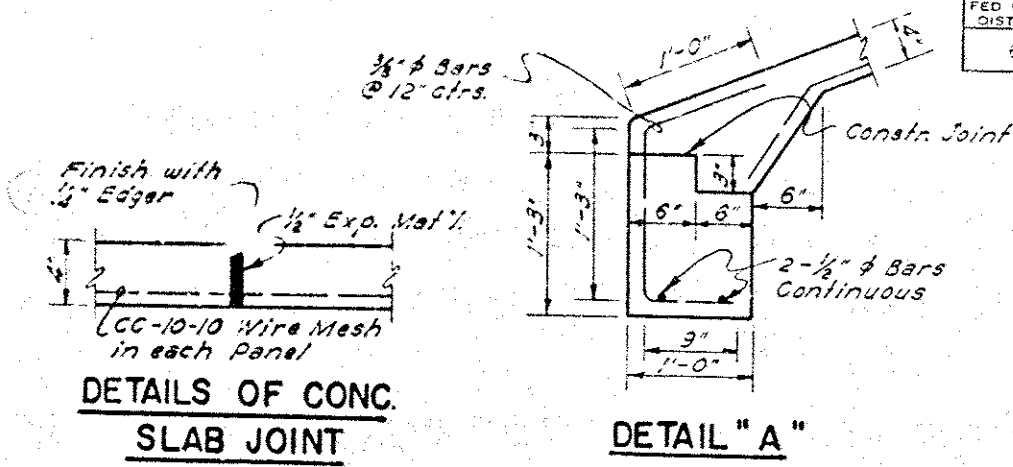



REVISIONS				RECORD		OKLAHOMA STATE HIGHWAY COMMISSION	
NO.	DESCRIPTION	BY	DATE	ITEM	BY	DATE	OKLAHOMA CITY, OKLAHOMA
				DESIGN			
				DETAIL			
				TRACED	K.J.S.		
				CHECKED	222	9/37	
				APPROVED			
				SQUAD	32/VH/M		

BAR LIST-ONE ABUT


Mark	No.	Size	Form	Length
H ₁	9	3/4"	Str.	50'-0"
H ₂	118	3/4"	Str.	5'-0"
H ₃	10	3/4"	Str.	5'-0" Ave.
H ₄	78	3/4"	Str.	2'-10"
H ₅	10	3/4"	Str.	16'-7" Ave.
CH ₁	3	1/2"	Bnt.	17'-9"
CH ₂	3	1/2"	Bnt.	13'-0"
CH ₃	3	1/2"	Bnt.	11'-4"
CH ₄	3	1/2"	Bnt.	48'-0"
CH ₅	5	1/2"	Bnt.	12'-9"
CH ₆	5	1/2"	Bnt.	9'-9"
CH ₇	3	1/2"	Str.	50'-0"
V ₁	62	1/2"	Str.	4'-2"
V ₂	45	1/2"	Str.	3'-0"
V ₃	31	1/2"	Str.	2'-2"
V ₄	51	1/2"	Str.	3'-10" Ave.
WH ₁	8	1/2"	Str.	10'-4"
WH ₂	6	1/2"	Str.	12'-11"
WH ₃	6	1/2"	Str.	10'-4"
WH ₄	8	1/2"	Str.	12'-11"
WH ₅	8	1/2"	Str.	9'-6"
WH ₆	12	1/2"	Str.	7'-8" Ave.
WH ₇	6	1/2"	Str.	9'-0"
WH ₈	6	1/2"	Str.	9'-4"
WH ₉	20	1/2"	Str.	9'-6"
WH ₁₀	20	1/2"	Str.	7'-10"
WH ₁₁	4	1/2"	Str.	4'-8"
WH ₁₂	4	1/2"	Str.	3'-10"
WH ₁₃	22	1/2"	Str.	3'-8"
H	14	3/4"	Bnt.	8'-8"
CH	32	1/2"	Bnt.	4'-0" Ave.

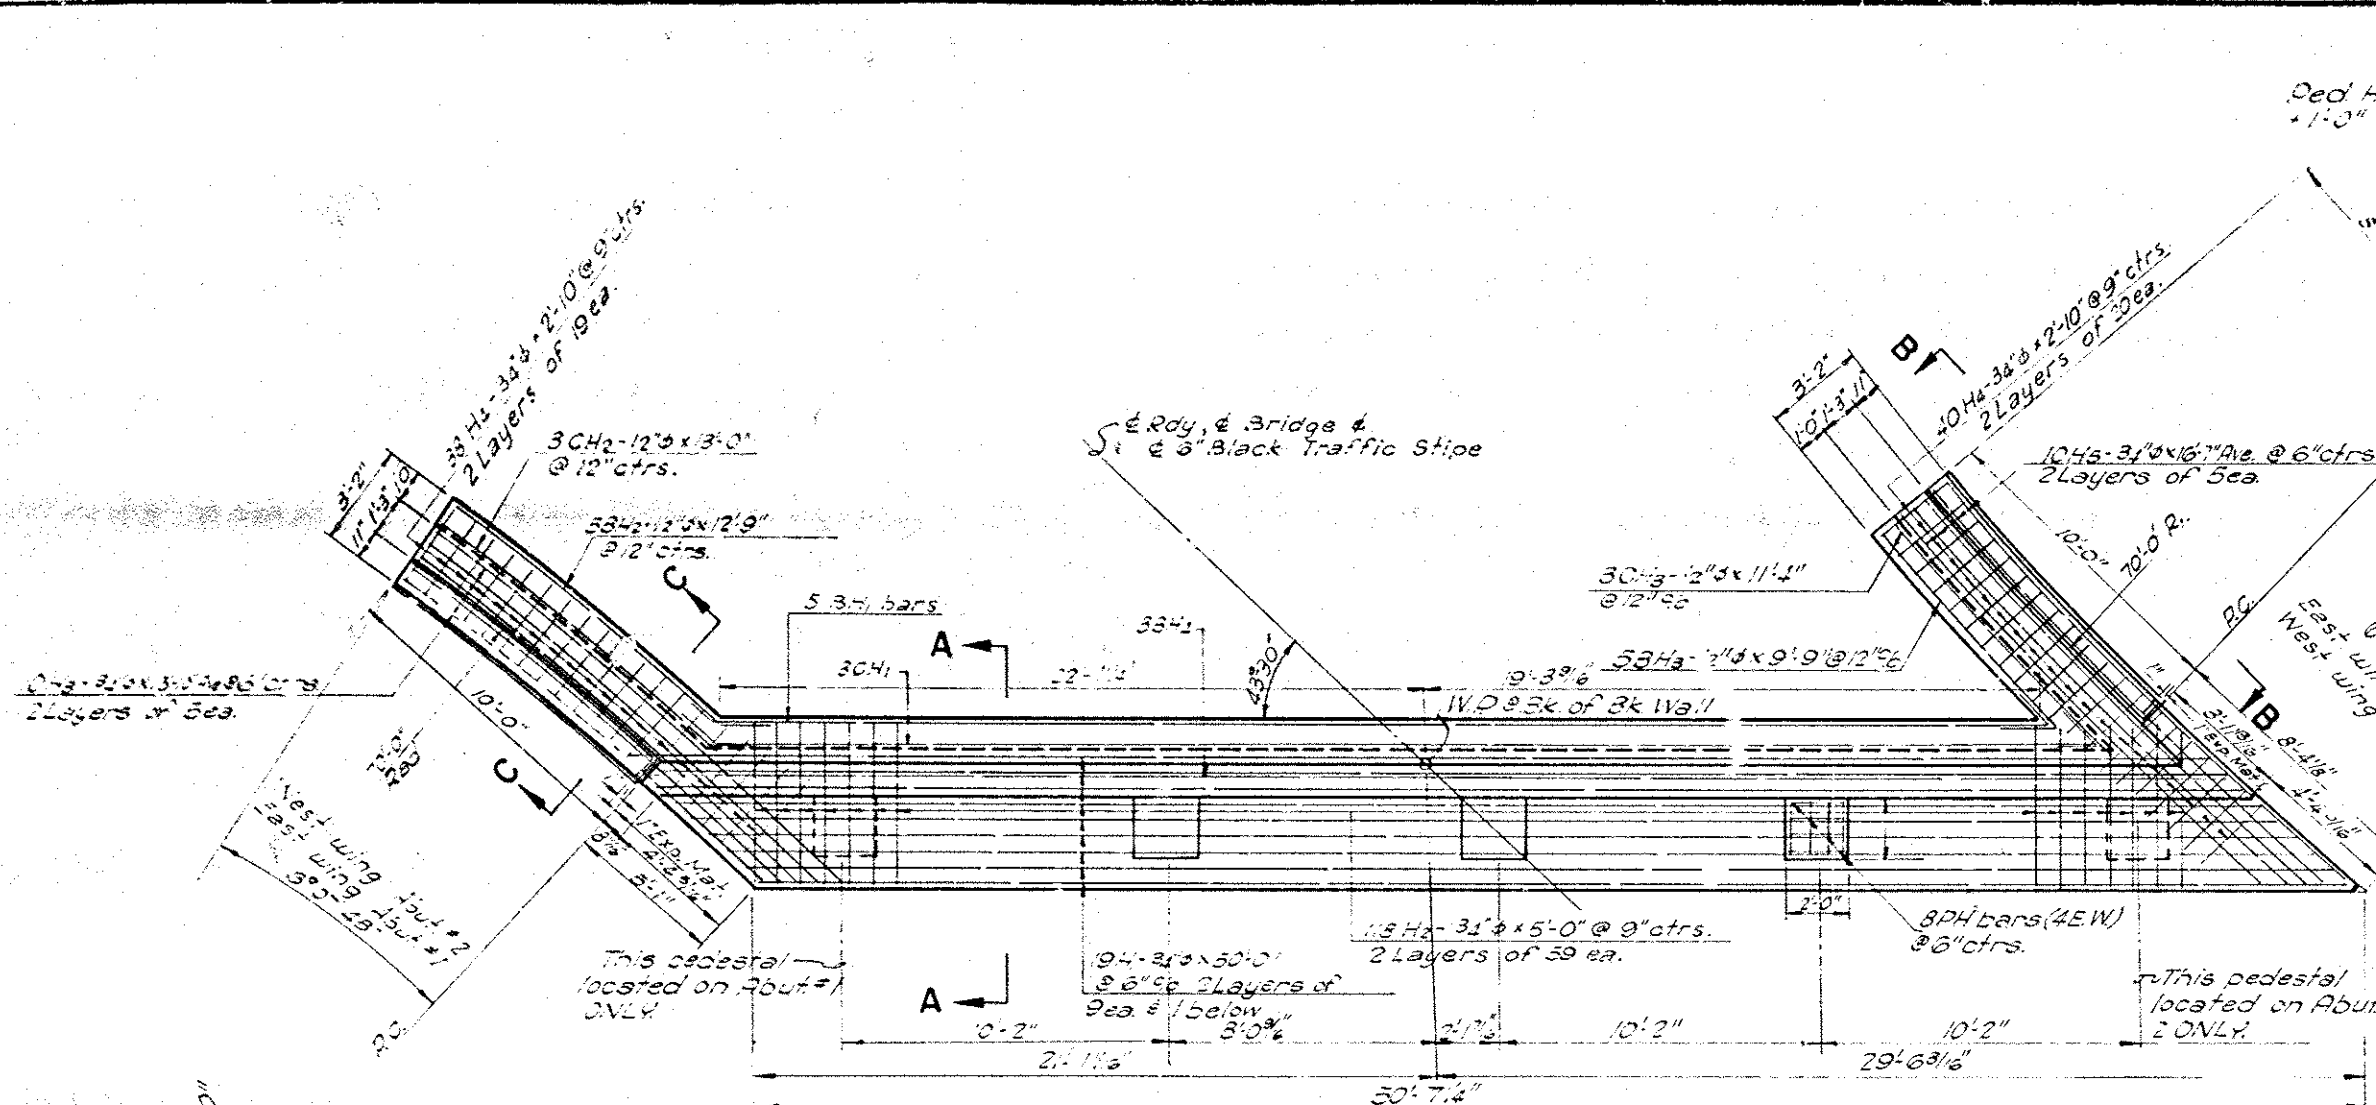


WING WALL DETAIL

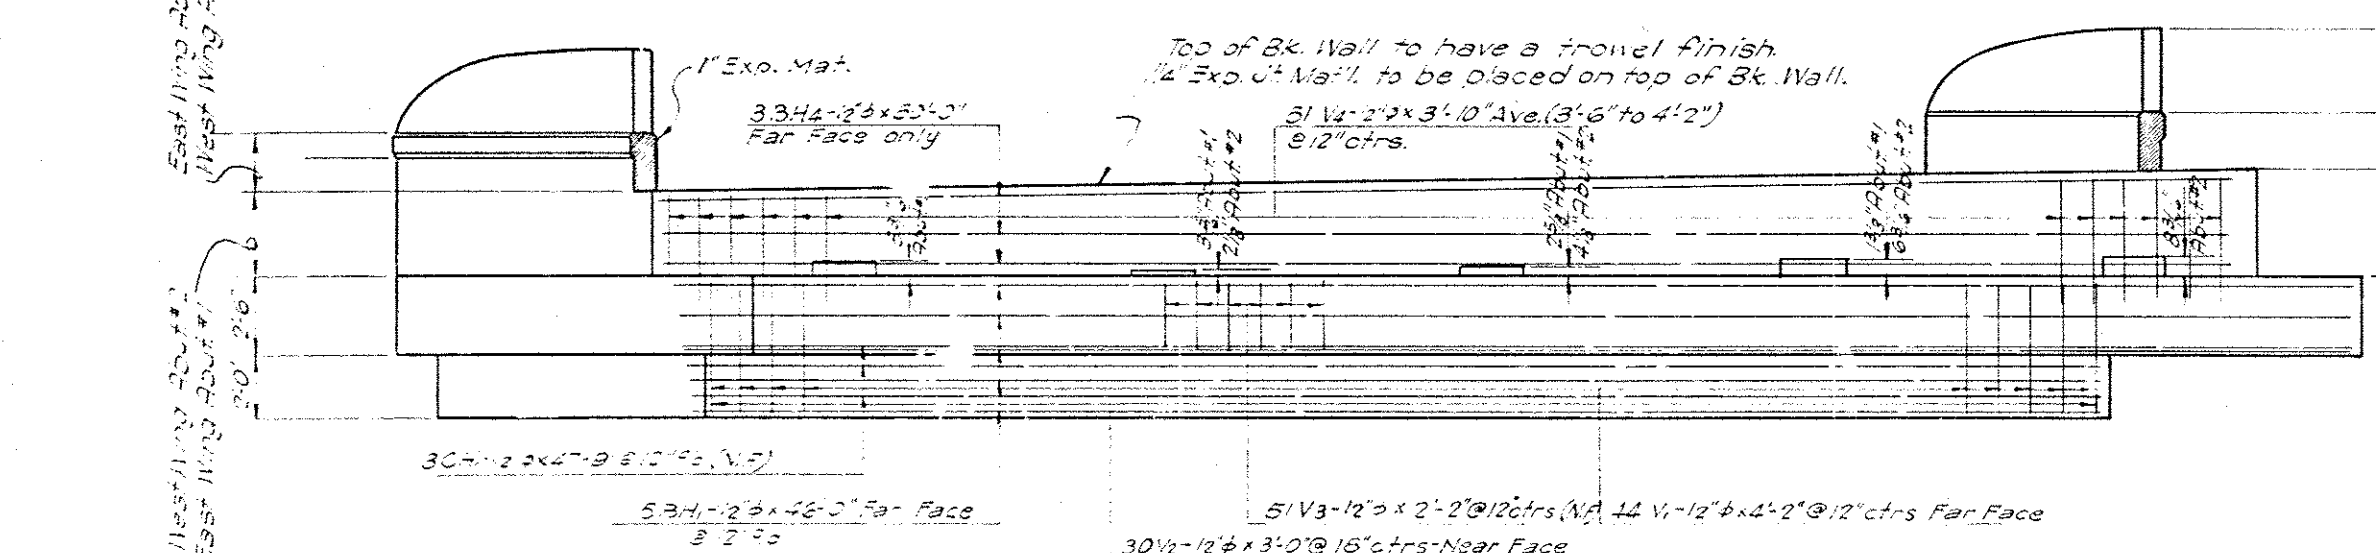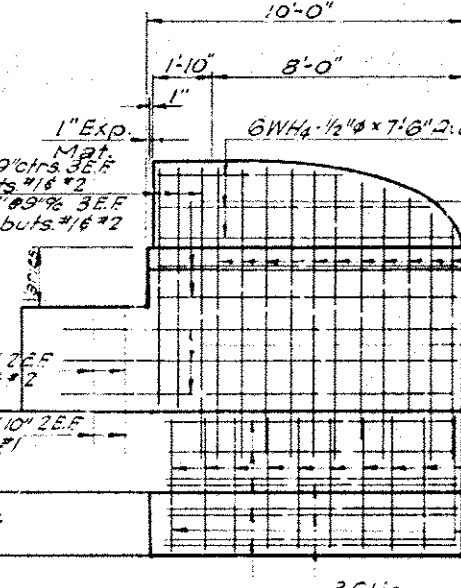

SECTION A-A

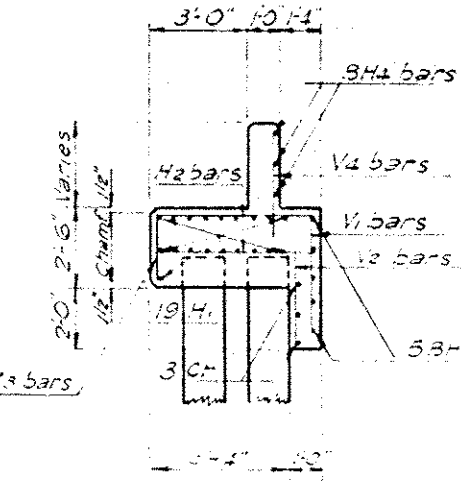

SECTION C-C

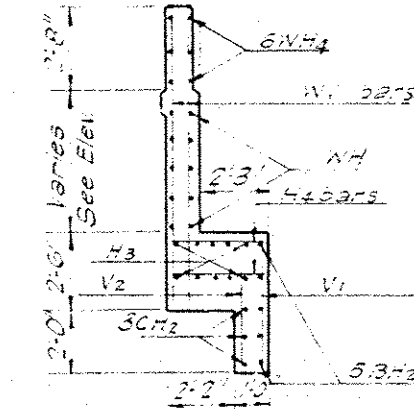

EXCAVATION DETAILS

MAX. LIMITS OF EXCAVATION IN COMPACTED FILL

Refer to identical note on Sheet No. 2

QUANTITIES-ONE ABUTMENT

ITEM	UNIT	QTY
Concrete	CU YD	44.8
Reinforcing Steel	LB	5355
Subgrade	CU YD	110

GENERAL NOTES:


All construction and materials shall be in accordance with the Oklahoma Standard Specifications of 1954 & Special Provisions.

All reinforcing steel bars shall conform to A.S.T.M. Specs A-305-49.


All exposed concrete edges shall have a 3/4" chamfer unless otherwise shown or noted.

For details of Piling & P.H. bars, refer to Std. Dwg. CSP-3.

WING WALL DETAIL

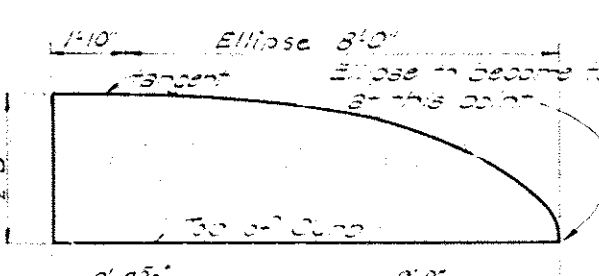


PILE SPACING PLAN

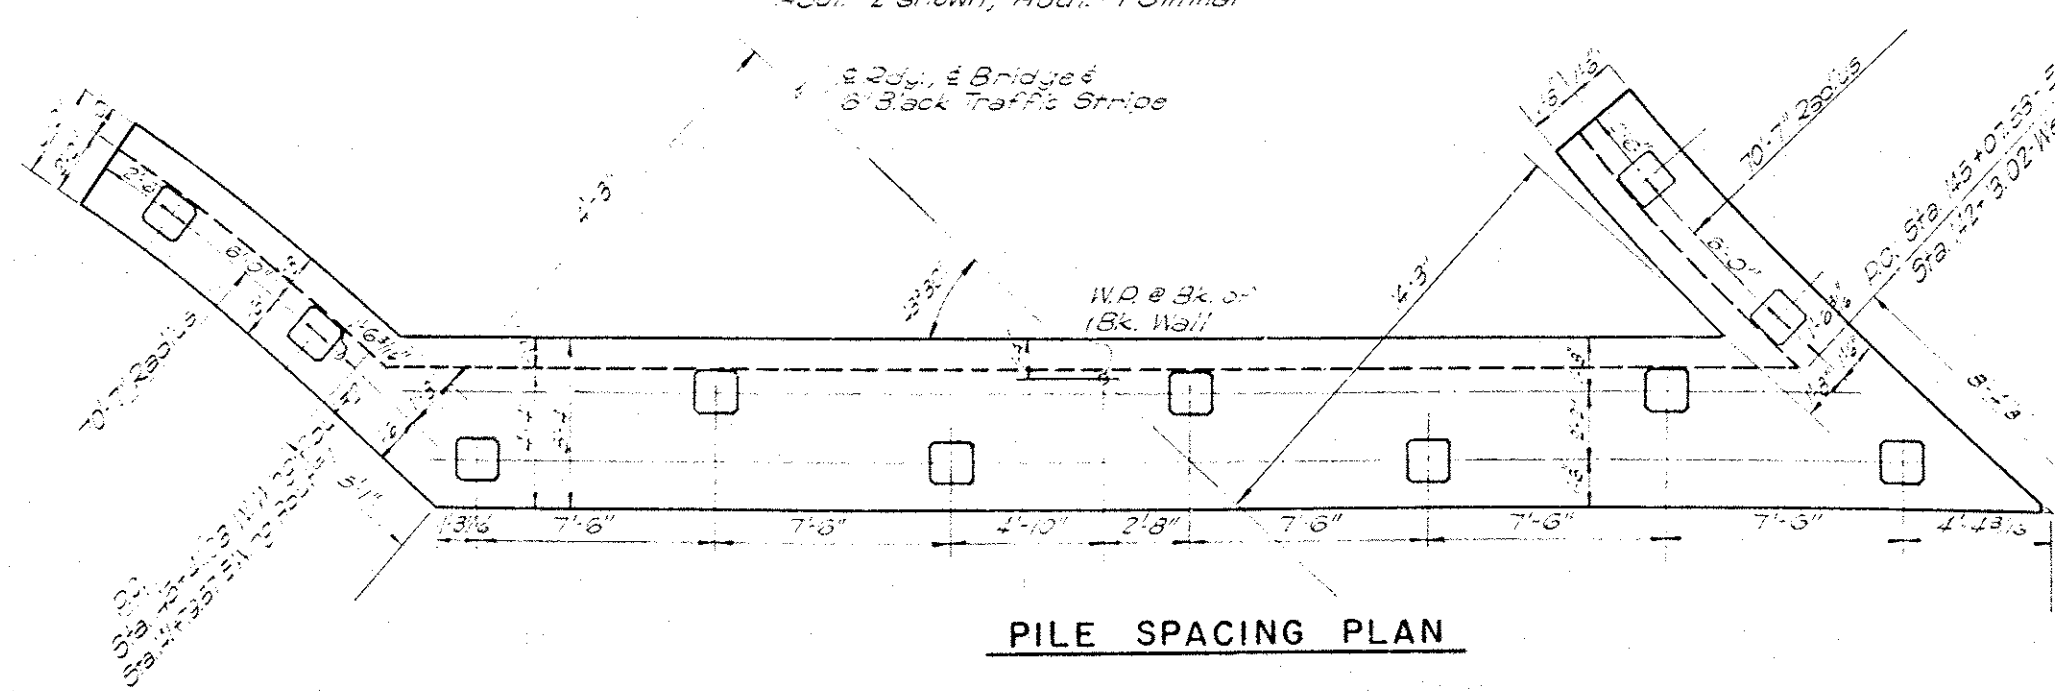

REVISIONS			RECORD		OKLAHOMA STATE HIGHWAY COMMISSION OKLAHOMA CITY, OKLAHOMA
NO.	DESCRIPTION	BY	DATE	ITEM	
				BY DATE	
				DESIGN	
				DETAIL	
				TRACED	DFB
				CHECKED	BAR
				APPROVED	
				SIGNED	BENHAM

FED. ROAD DIST. NO.	STATE	PROJ. NO.	SHEET NO.	TOTAL SHEETS
6	OKLA.	1-381(16) PT-2	73	88

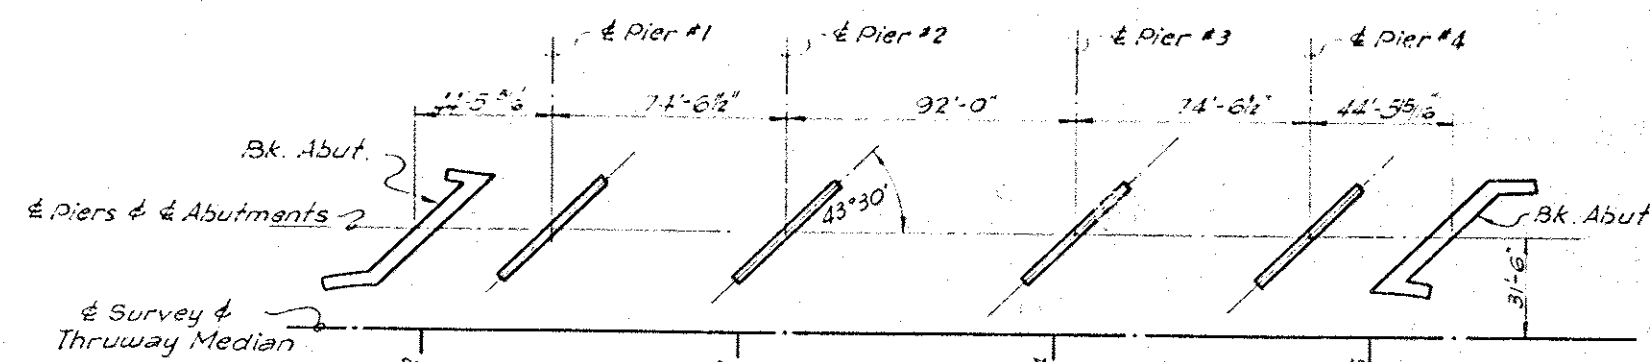


LAYOUT OF PIERS & ABUTMENTS


BAR LIST-ONE PIER

Mark	No	Size	Form Length
H ₂	5	1/2"	8ft 38'-6"
H ₄	4	1/2"	8ft 44'-0"
BH ₁	13	1/2"	8ft 5'-3"
BH ₂	8	1/2"	8ft 6'-6"
D	48	7/8"	8ft 5'-0"
F ₁	22	5/8"	8ft 4'-6"
F ₂	18	1/2"	8ft 10'-6"
F ₃	10	1/8"	8ft 10'-6"
F ₄	11	5/8"	8ft 5'-6"
S ₅	6	1/2"	8ft 12'-3/4"

PIER#	PIER#4
H ₁	H ₂
T ₁	T ₂
T ₂	T ₃
T ₃	T ₄
T ₄	T ₅
T ₅	T ₆
T ₆	T ₇
T ₇	T ₈
T ₈	T ₉
T ₉	T ₁₀
T ₁₀	T ₁₁
T ₁₁	T ₁₂
T ₁₂	T ₁₃
T ₁₃	T ₁₄
T ₁₄	T ₁₅
T ₁₅	T ₁₆
T ₁₆	T ₁₇
T ₁₇	T ₁₈
T ₁₈	T ₁₉
T ₁₉	T ₂₀
T ₂₀	T ₂₁
T ₂₁	T ₂₂
T ₂₂	T ₂₃
T ₂₃	T ₂₄
T ₂₄	T ₂₅
T ₂₅	T ₂₆
T ₂₆	T ₂₇
T ₂₇	T ₂₈
T ₂₈	T ₂₉
T ₂₉	T ₃₀
T ₃₀	T ₃₁
T ₃₁	T ₃₂
T ₃₂	T ₃₃
T ₃₃	T ₃₄
T ₃₄	T ₃₅
T ₃₅	T ₃₆
T ₃₆	T ₃₇
T ₃₇	T ₃₈
T ₃₈	T ₃₉
T ₃₉	T ₄₀
T ₄₀	T ₄₁
T ₄₁	T ₄₂
T ₄₂	T ₄₃
T ₄₃	T ₄₄
T ₄₄	T ₄₅
T ₄₅	T ₄₆
T ₄₆	T ₄₇
T ₄₇	T ₄₈
T ₄₈	T ₄₉
T ₄₉	T ₅₀
T ₅₀	T ₅₁
T ₅₁	T ₅₂
T ₅₂	T ₅₃
T ₅₃	T ₅₄
T ₅₄	T ₅₅
T ₅₅	T ₅₆
T ₅₆	T ₅₇
T ₅₇	T ₅₈
T ₅₈	T ₅₉
T ₅₉	T ₆₀
T ₆₀	T ₆₁
T ₆₁	T ₆₂
T ₆₂	T ₆₃
T ₆₃	T ₆₄
T ₆₄	T ₆₅
T ₆₅	T ₆₆
T ₆₆	T ₆₇
T ₆₇	T ₆₈
T ₆₈	T ₆₉
T ₆₉	T ₇₀
T ₇₀	T ₇₁
T ₇₁	T ₇₂
T ₇₂	T ₇₃
T ₇₃	T ₇₄
T ₇₄	T ₇₅
T ₇₅	T ₇₆
T ₇₆	T ₇₇
T ₇₇	T ₇₈
T ₇₈	T ₇₉
T ₇₉	T ₈₀
T ₈₀	T ₈₁
T ₈₁	T ₈₂
T ₈₂	T ₈₃
T ₈₃	T ₈₄
T ₈₄	T ₈₅
T ₈₅	T ₈₆
T ₈₆	T ₈₇
T ₈₇	T ₈₈
T ₈₈	T ₈₉
T ₈₉	T ₉₀
T ₉₀	T ₉₁
T ₉₁	T ₉₂
T ₉₂	T ₉₃
T ₉₃	T ₉₄
T ₉₄	T ₉₅
T ₉₅	T ₉₆
T ₉₆	T ₉₇
T ₉₇	T ₉₈
T ₉₈	T ₉₉
T ₉₉	T ₁₀₀

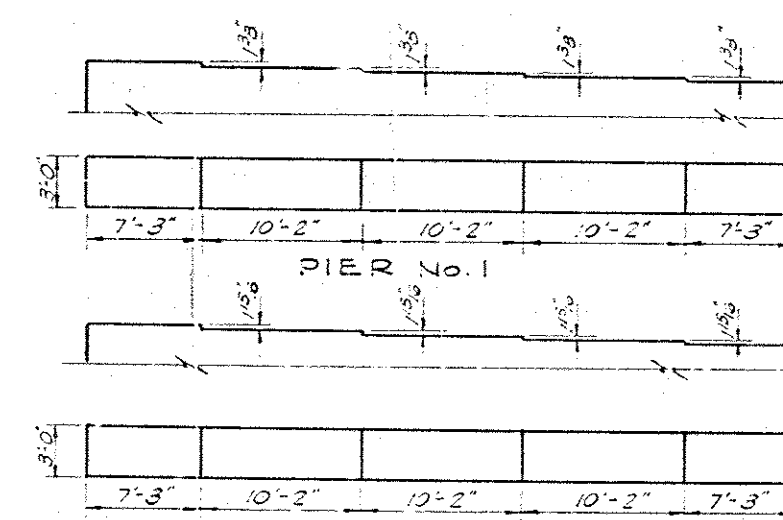



DETAILS OF PIER TOPS

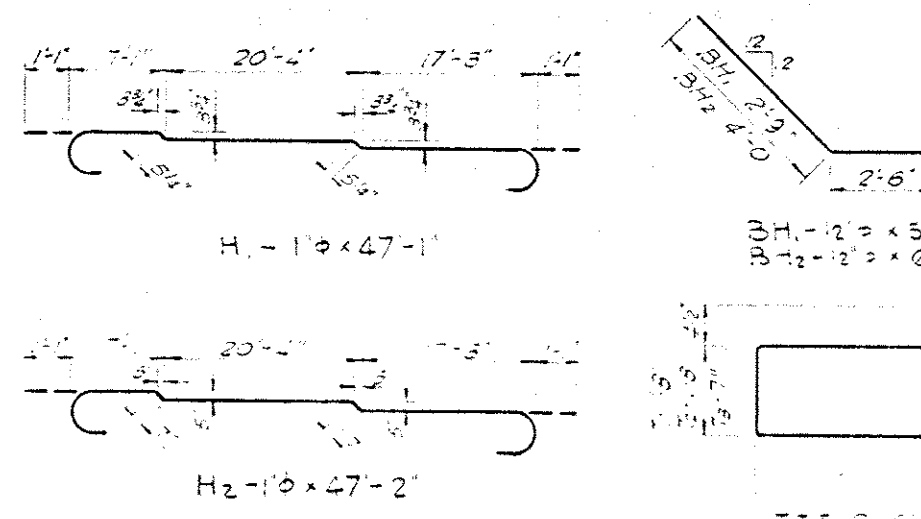

ITEM	UNIT	PIER#1	PIER#4
Reinforcing Steel	Lb.	7575	7540
Class A Concrete	C.Y.	625	61
Class A Conc'n Pier Base	C.Y.	133	133
Substr. Excav. - Common	C.Y.	470	478
Substr. Excav. - Rock	C.Y.	5	17

REVISIONS				RECORD		
NO.	DESCRIPTION	BY	DATE	ITEM	BY	DATE
				DESIGN		
				DETAIL		
				TRACED	J.S.	
				CHECKED	J.S.	
				APPROVED		
				SQUAD	BENHAM	

OKLAHOMA STATE HIGHWAY COMMISSION
OKLAHOMA CITY, OKLAHOMA
STR. NO. 12
DETAILS OF PIERS
PIER NO. 1 & PIER NO. 4
CL STA. ON CL SURVEY 143+60.30
FA. PROJ. 1-381(16) PT-2

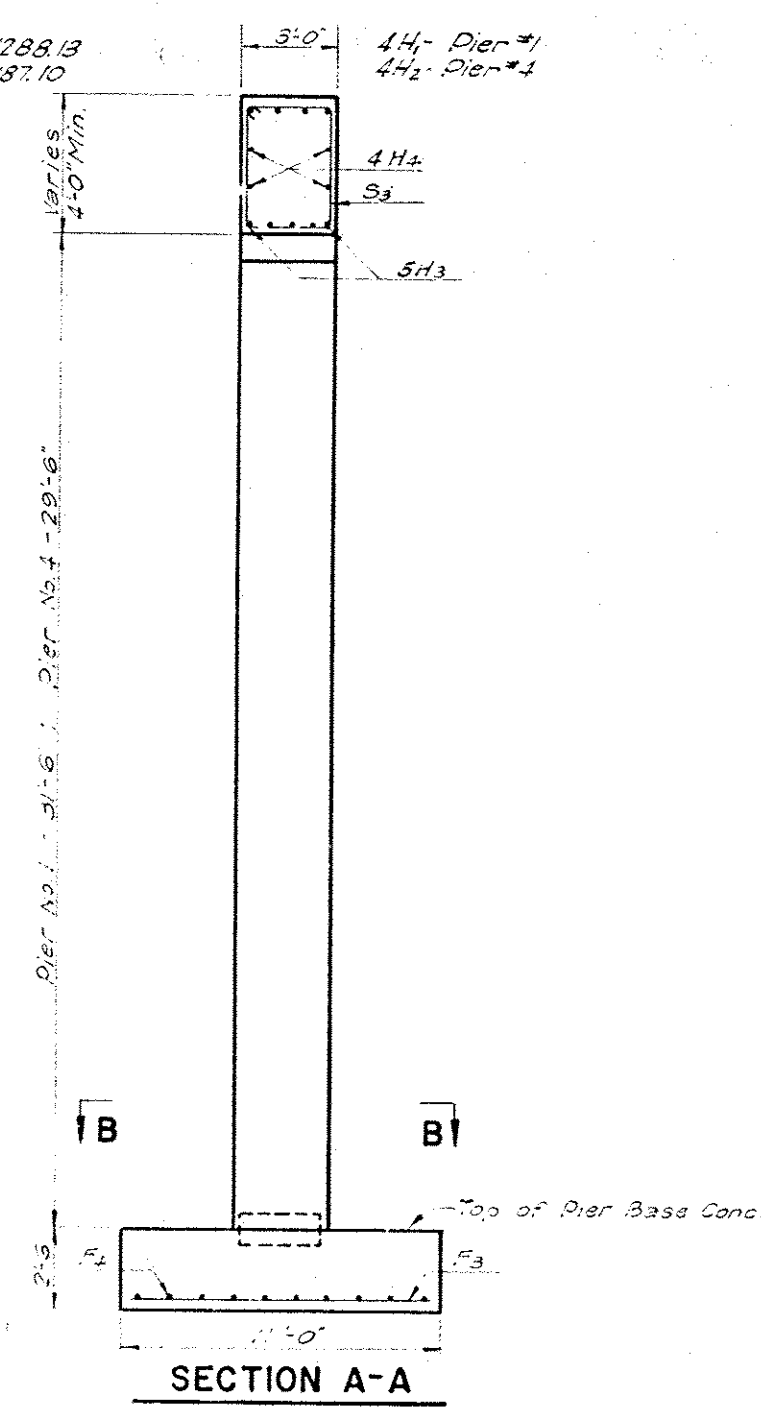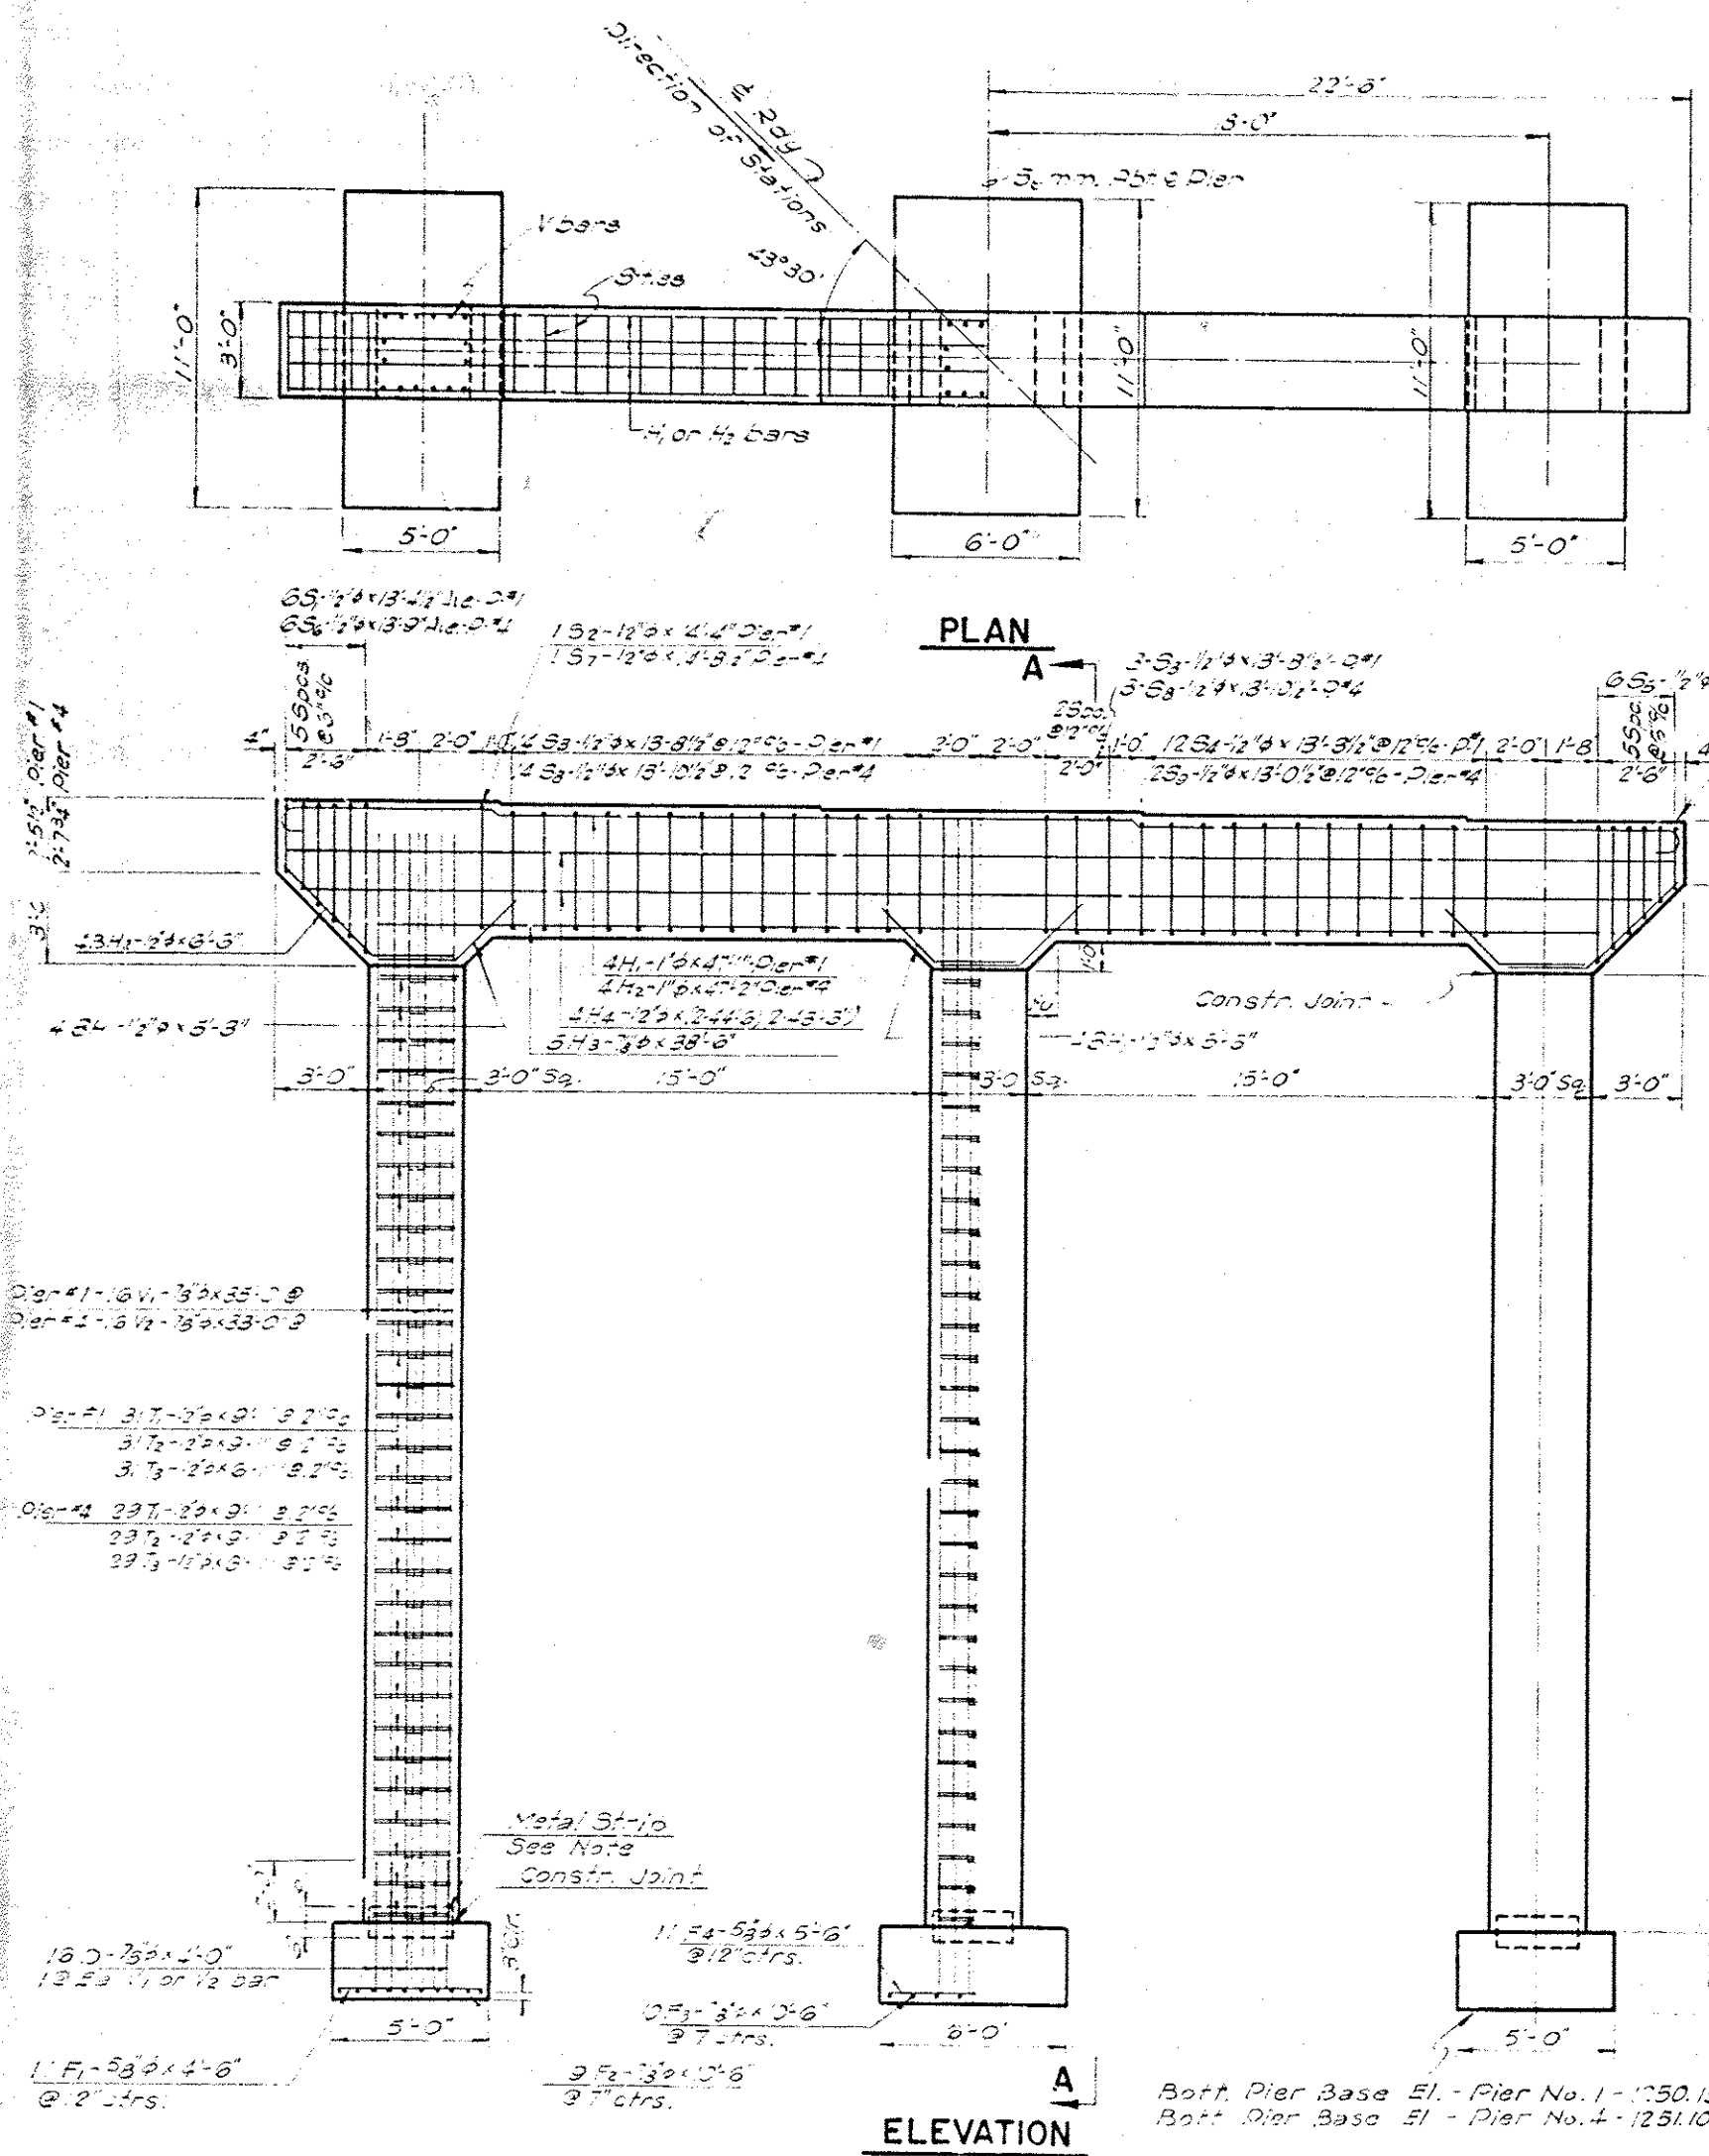


SECTION A-A


SECTION B-B

STATE	PROJ. NO.	SHEET NO.	TOTAL SHEETS
OKLA.	1-381(16) PT-2	74	88


BAR LIST - ONE PIER				
Bar No.	Size	Length	Notes	
1	7/8"	37'-0"	Stn. 138'-0"	
2	7/8"	37'-0"	Stn. 138'-0"	
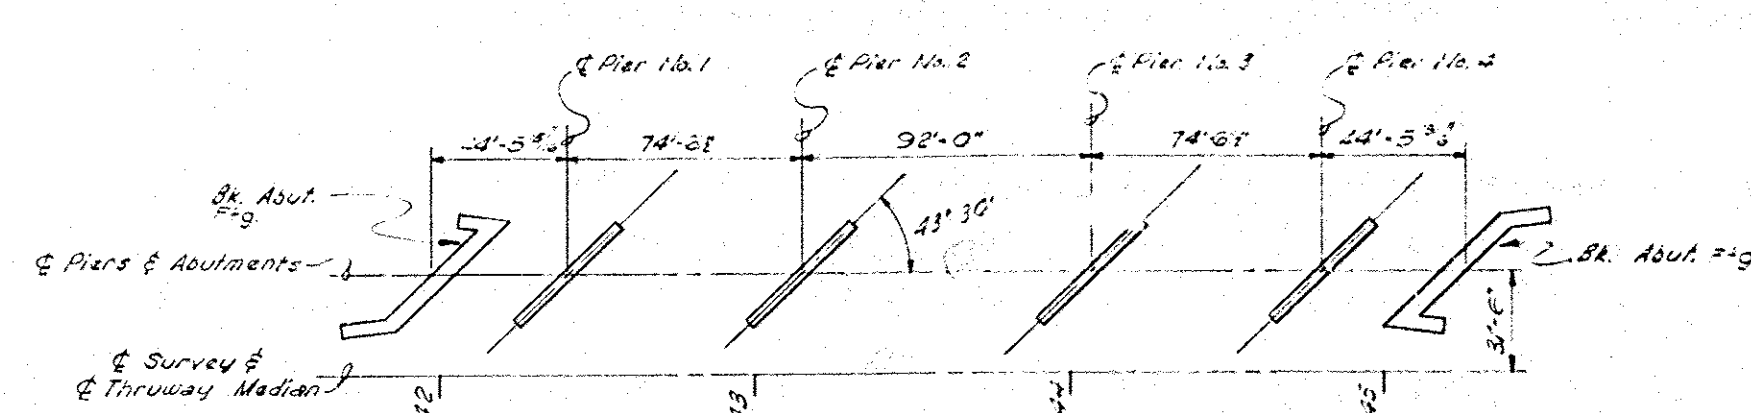

LAYOUT OF PIERS & ABUTMENTS

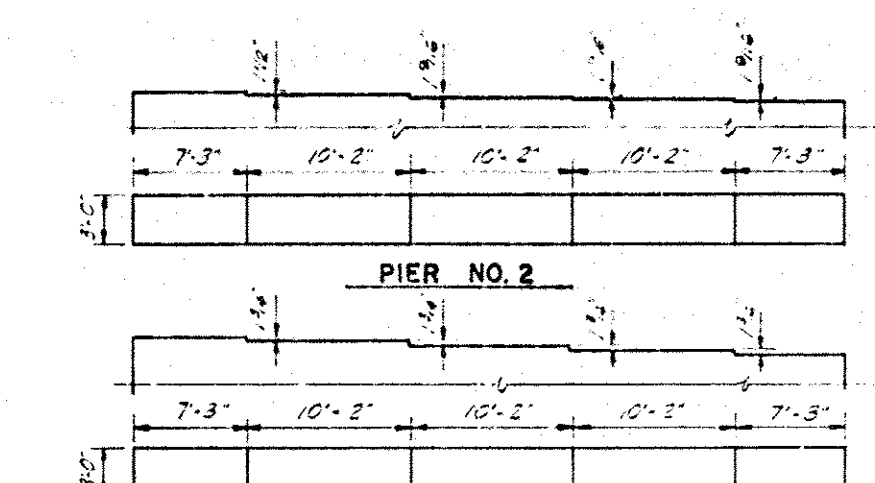


DETAILS OF PIER TOPS

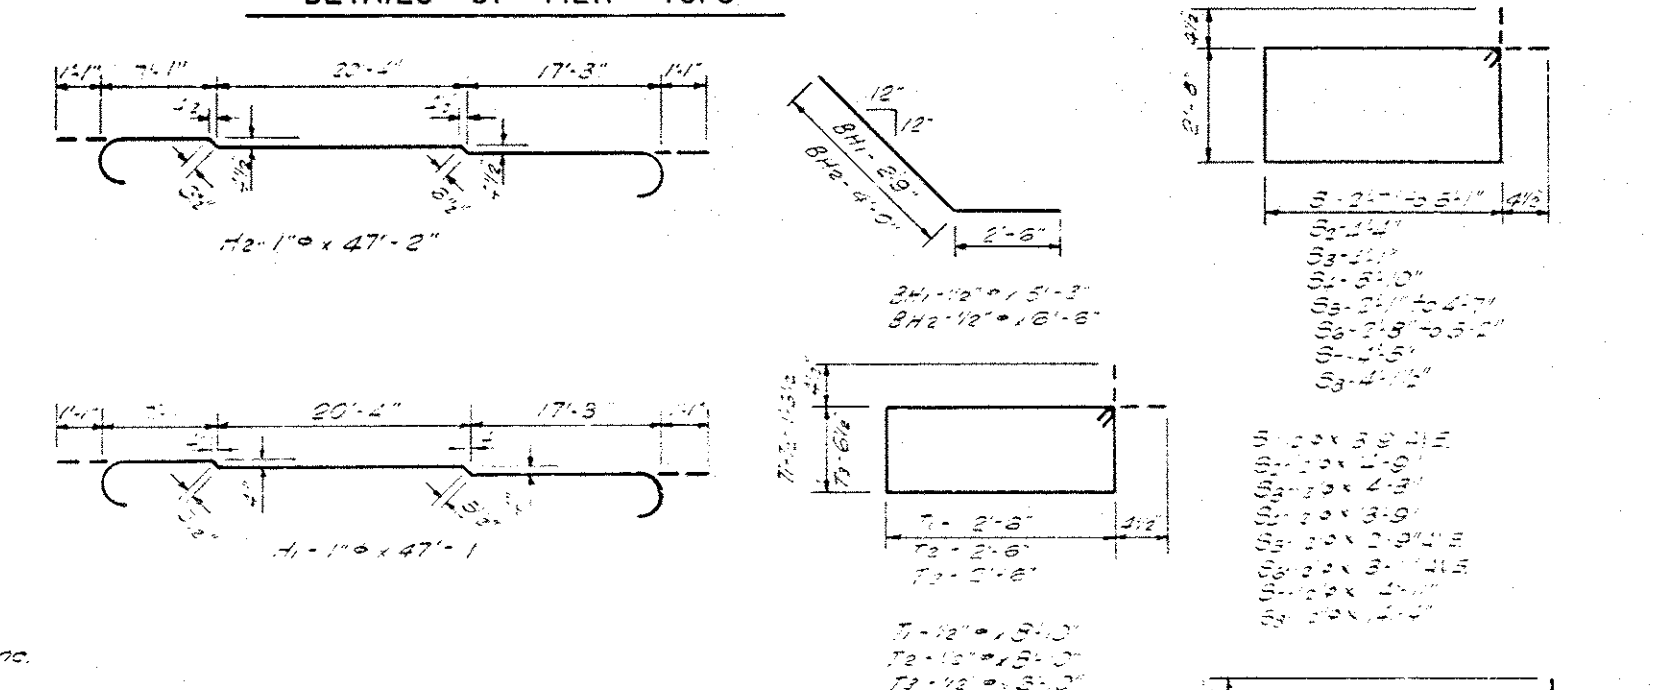

QUANTITIES - ONE PIER				
ITEM	UNIT	PIER NO. 2	PIER NO. 3	
Reinforcing Steel	lbs	5,250	5,250	
Class "A" Concrete	cu yd	730	730	
Class "A" Conc. in Pier Bases	cu yd	233	233	
Subgrade Excav. - Common	sq ft	50	50	
Subgrade Excav. - Road	sq ft	23	23	

NOTES:
All reinforcing steel bars shall conform to ASTM Spec. A 603-42.
All exposed edges shall have 1/2" minimum unless otherwise noted.


NOTE: METAL STRIP FOR PIER BASE CONCRETE
Refer to identical note on Details of Piers under Sheet 75.

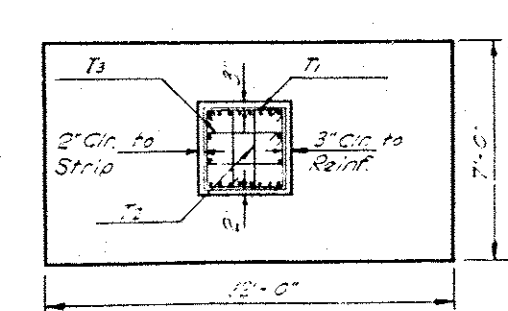


SECTION B-B

REVISIONS			RECORD		OKLAHOMA STATE HIGHWAY COMMISSION	
NO.	DESCRIPTION	BY DATE	ITEM	BY DATE	OKLAHOMA CITY, OKLAHOMA	
			DESIGN			
			DETAIL			
			TRACED	J.H.		
			CHECKED	J.R.D.		
			APPROVED			
			SQUAD	BEHINAM		


FED. ROAD DIST. NO.	STATE	PROJ. NO.	SHEET NO.	TOTAL SHEETS
6	OKLA.	I-381(16) PT-2	76	88

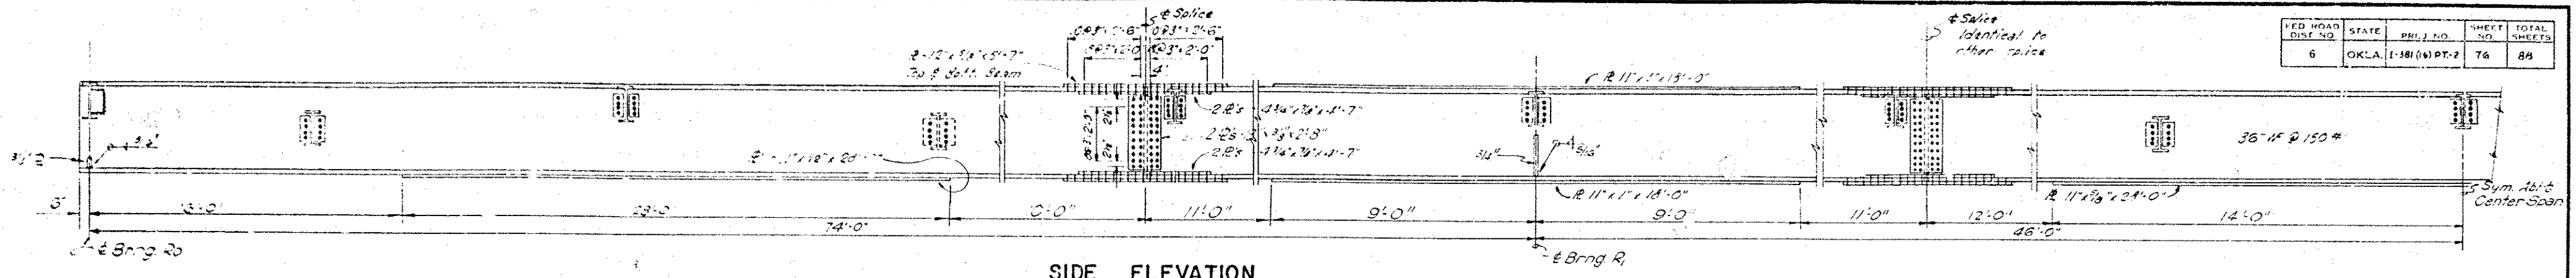


SIDE ELEVATION

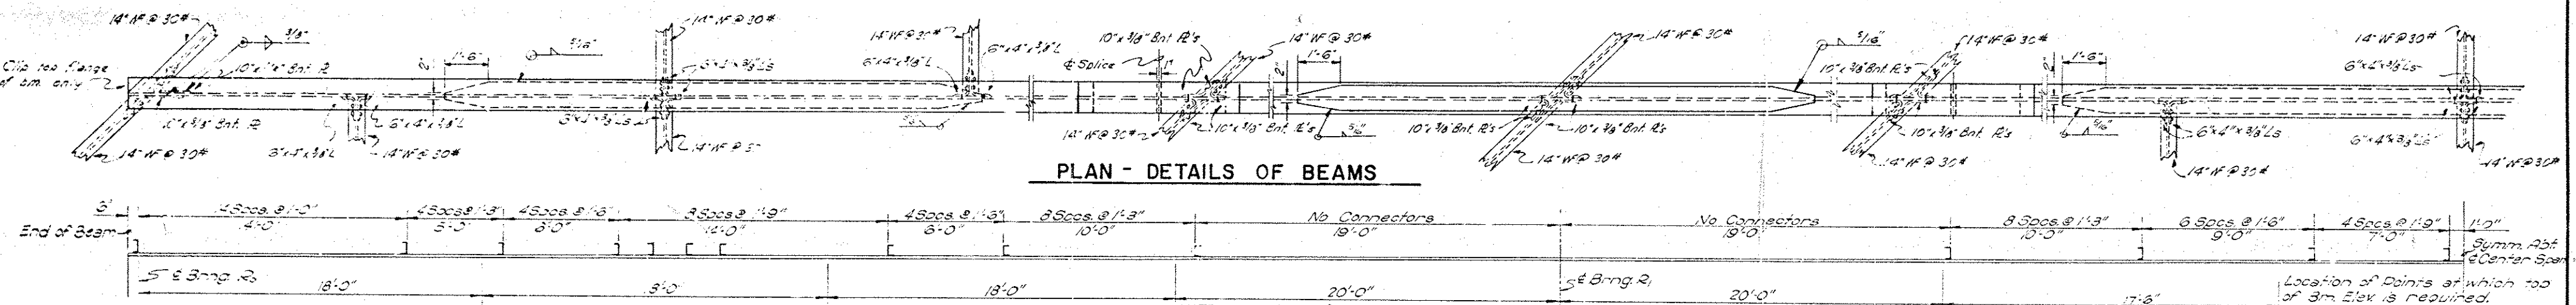


PLAN - DETAILS OF BEAMS

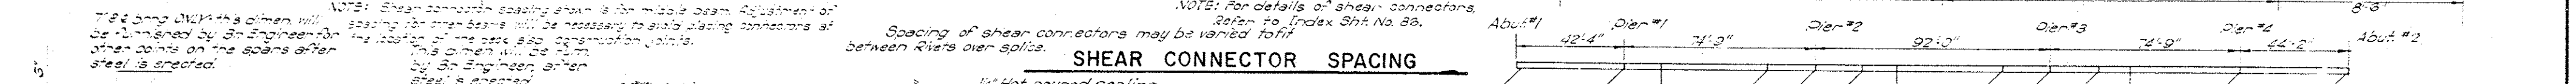


SHEAR CONNECTOR SPACING

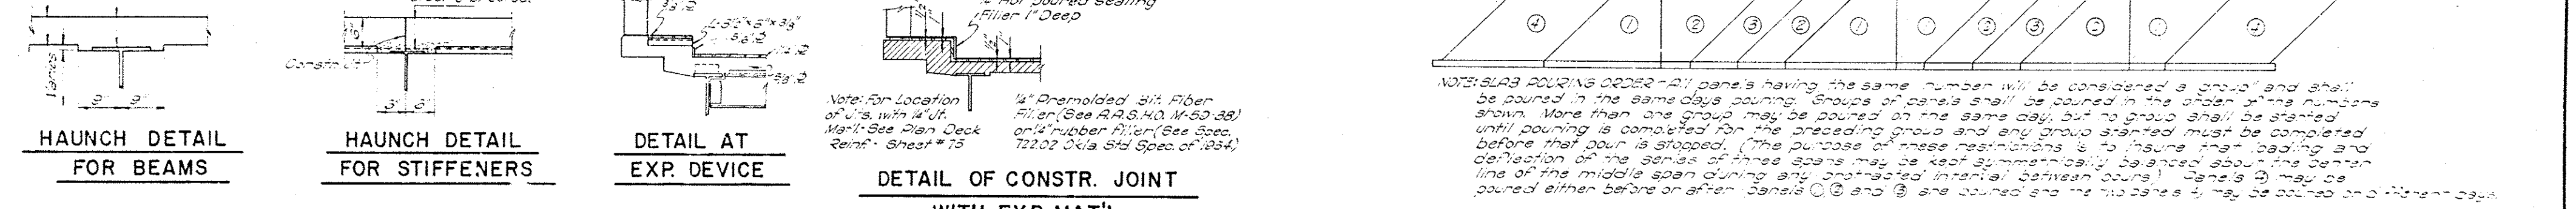


DETAIL OF CONSTR. JOINT WITH EXP. MAT'L.

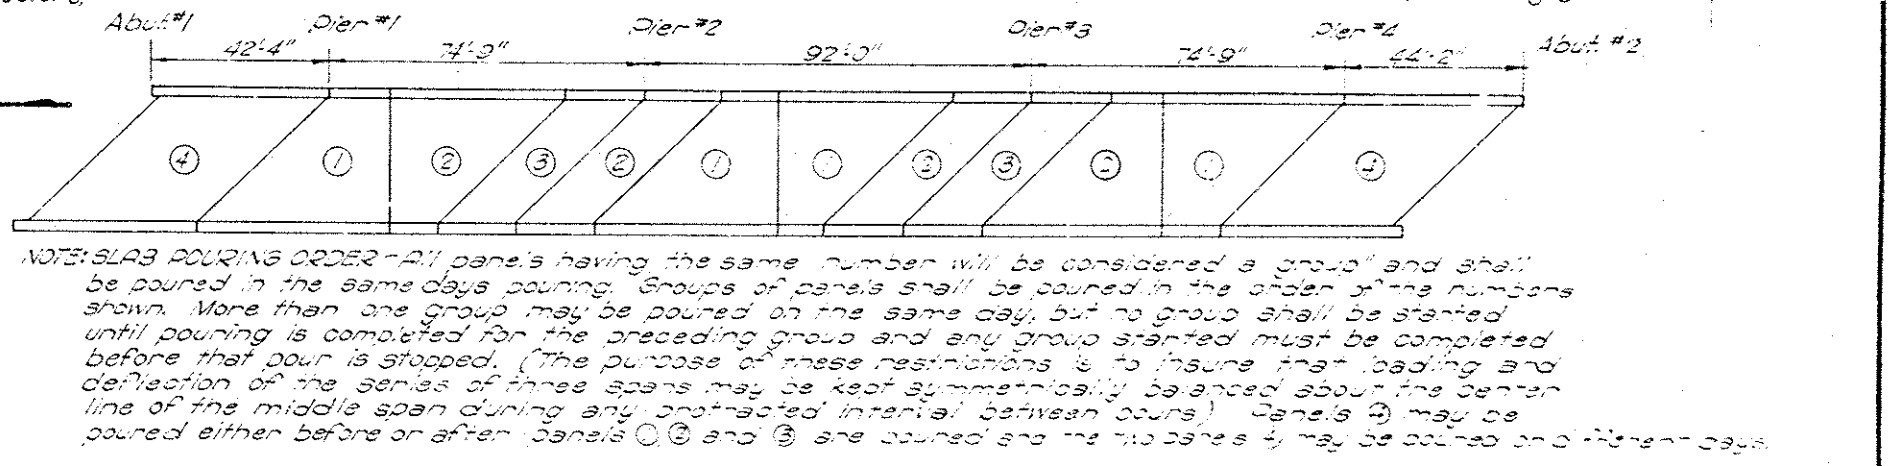

ORDER OF SLAB POURING

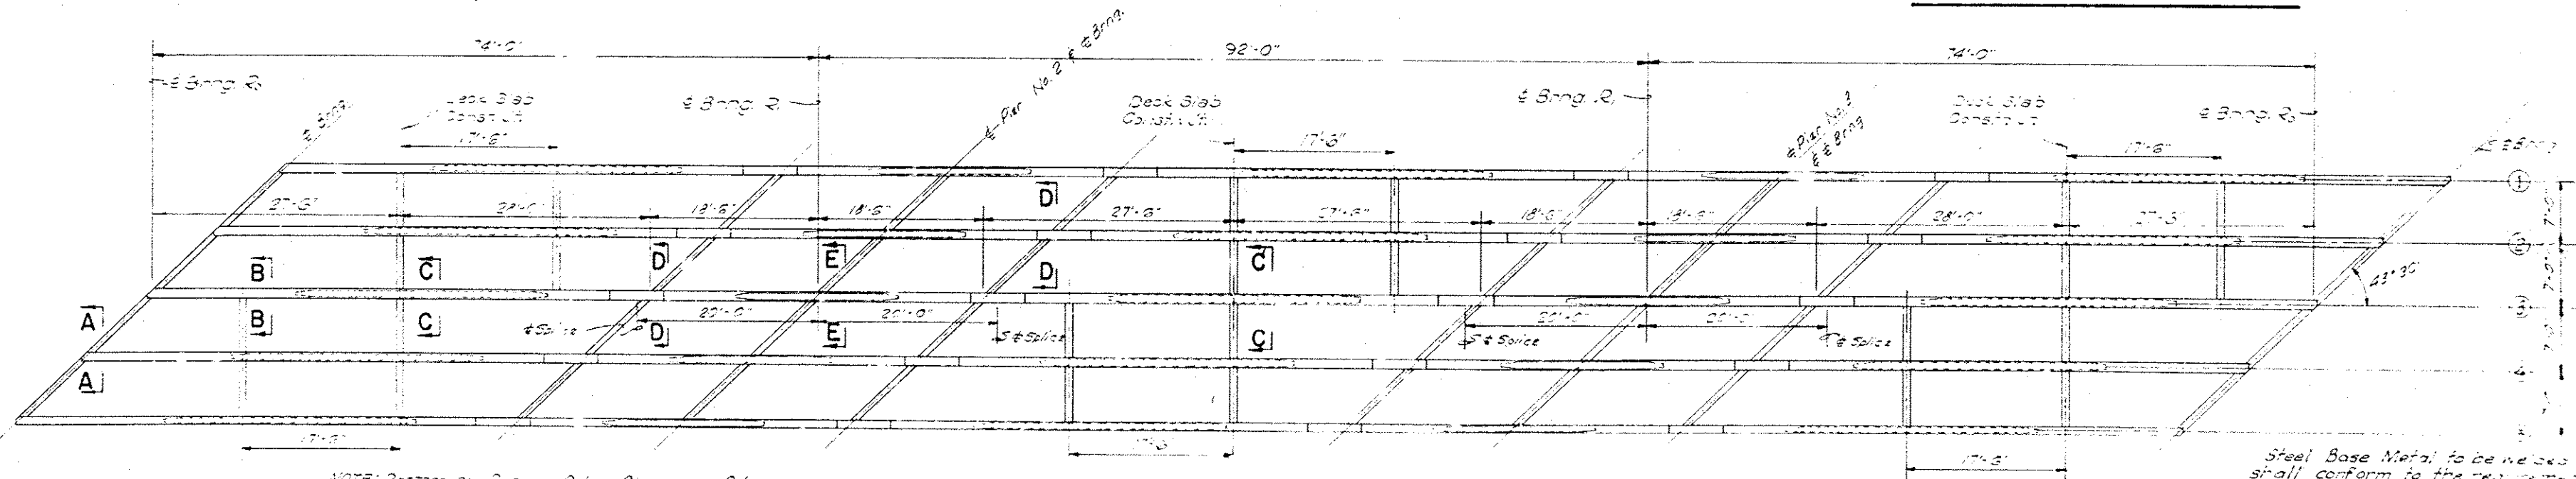

LAYOUT OF BEAMS & STIFFENERS (74'-92'-74' CONT. SPAN)

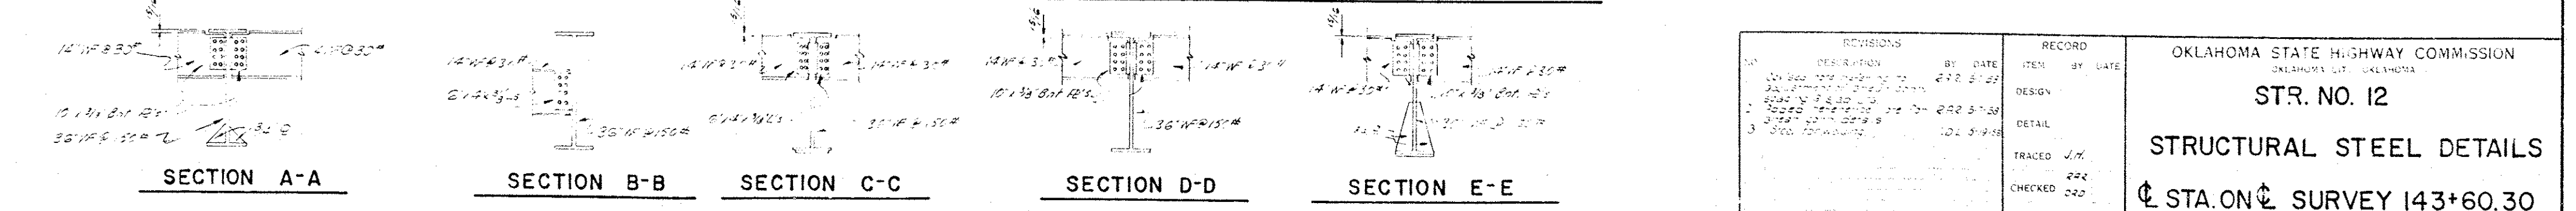

SECTION A-A

SECTION B-B


SECTION C-C

SECTION D-D


SECTION E-E

REVISIONS			RECORD		OKLAHOMA STATE HIGHWAY COMMISSION	
NO.	DESCRIPTION	BY DATE	ITEM	BY DATE	OKLAHOMA CITY, OKLAHOMA	
1	As per original design	2/12/52	DESIGN			
2	As per original design	2/12/52	DETAIL			
3	As per original design	2/12/52	TRACED	J.H.		
			CHECKED	222		
			APPROVED	222		
			SQUAD	BENHAM		

FED. ROAD DIST. NO.	STATE	PROJECT	SHEET NO.	TOTAL SHEETS
6	OKLA.	1-381(16) PT-2	77	98

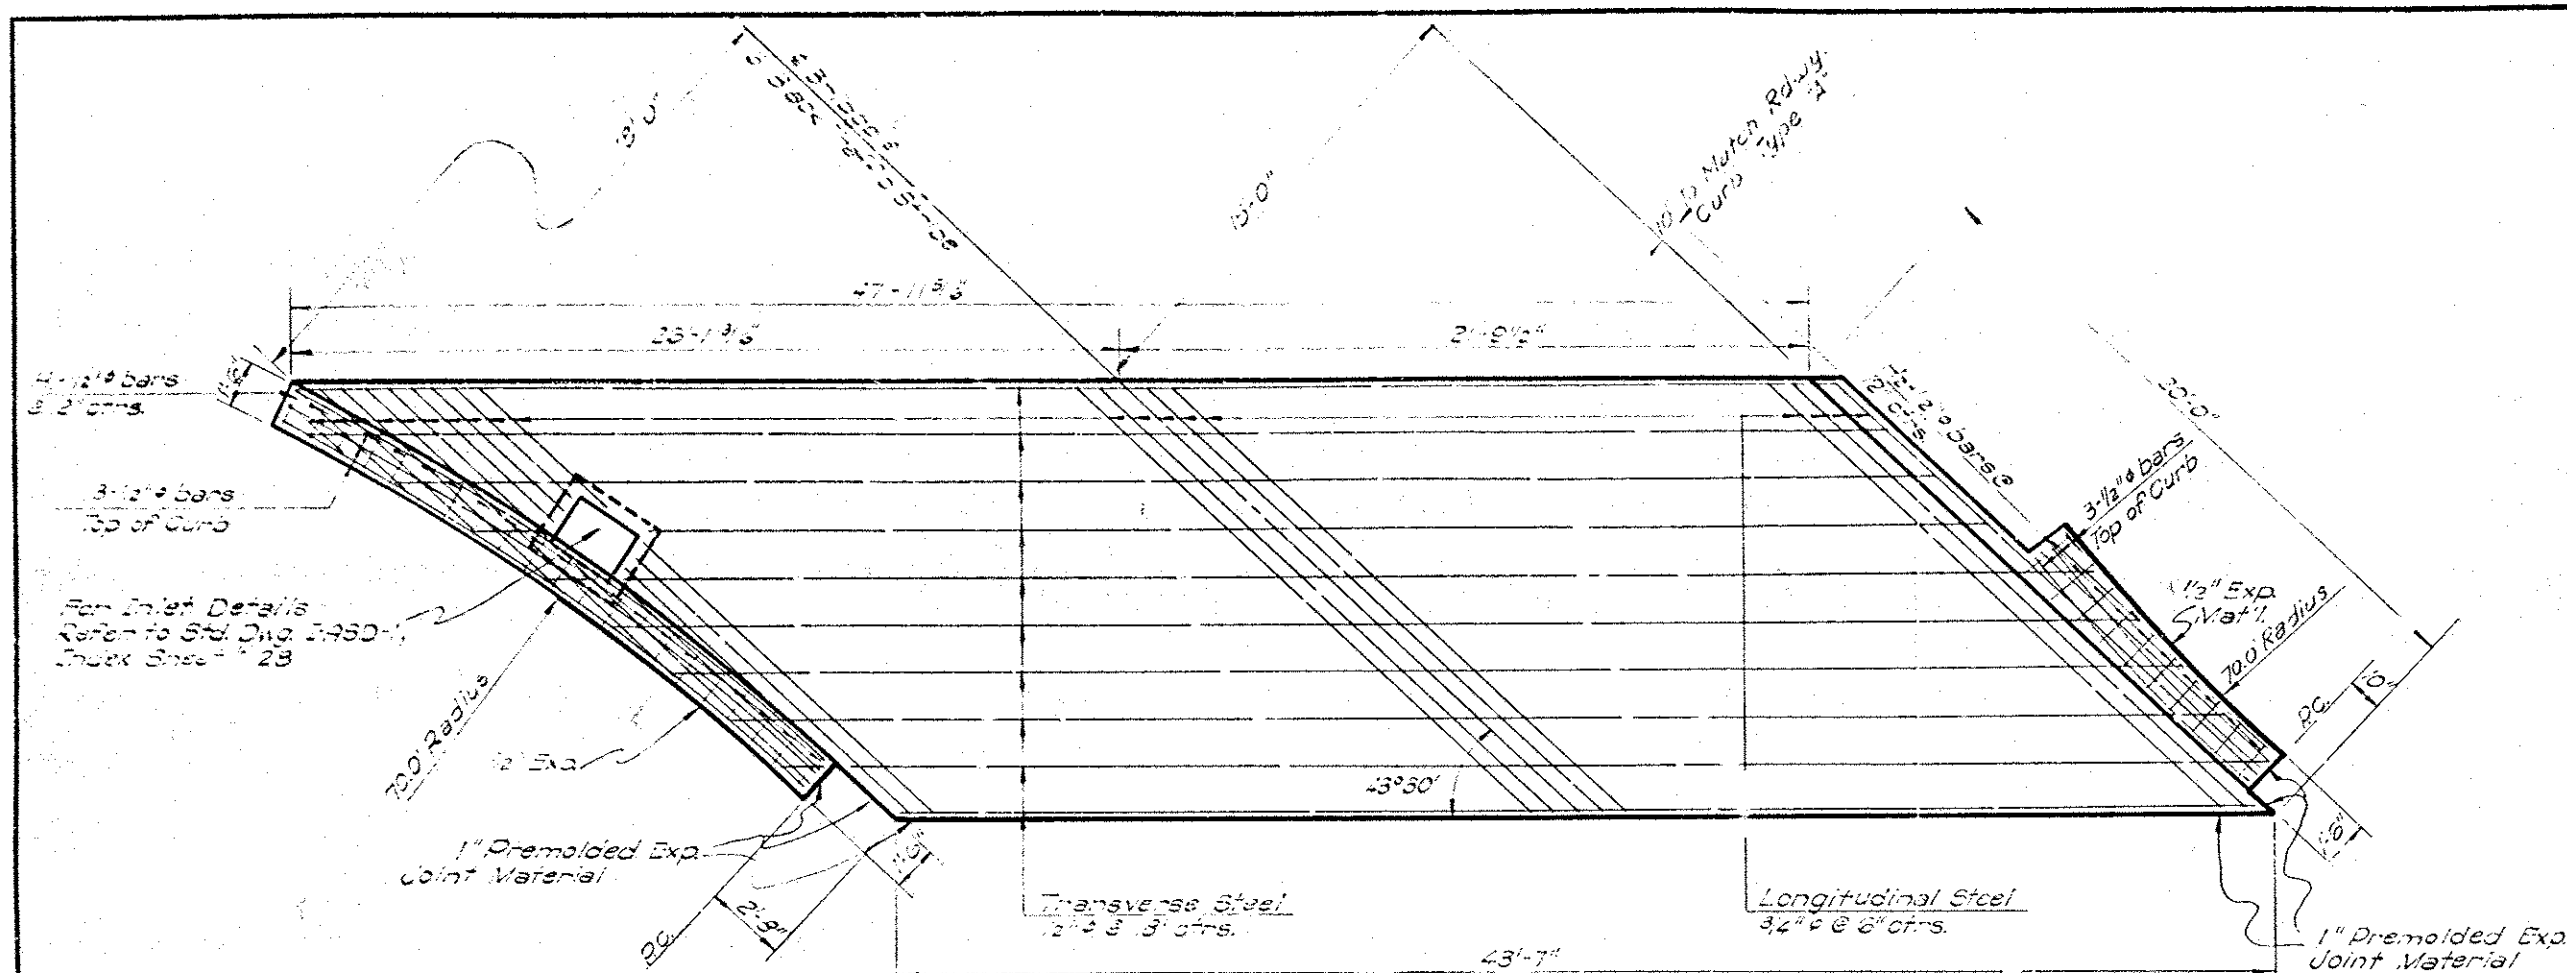


PLAN
APPR. SLAB & ABUT. #2

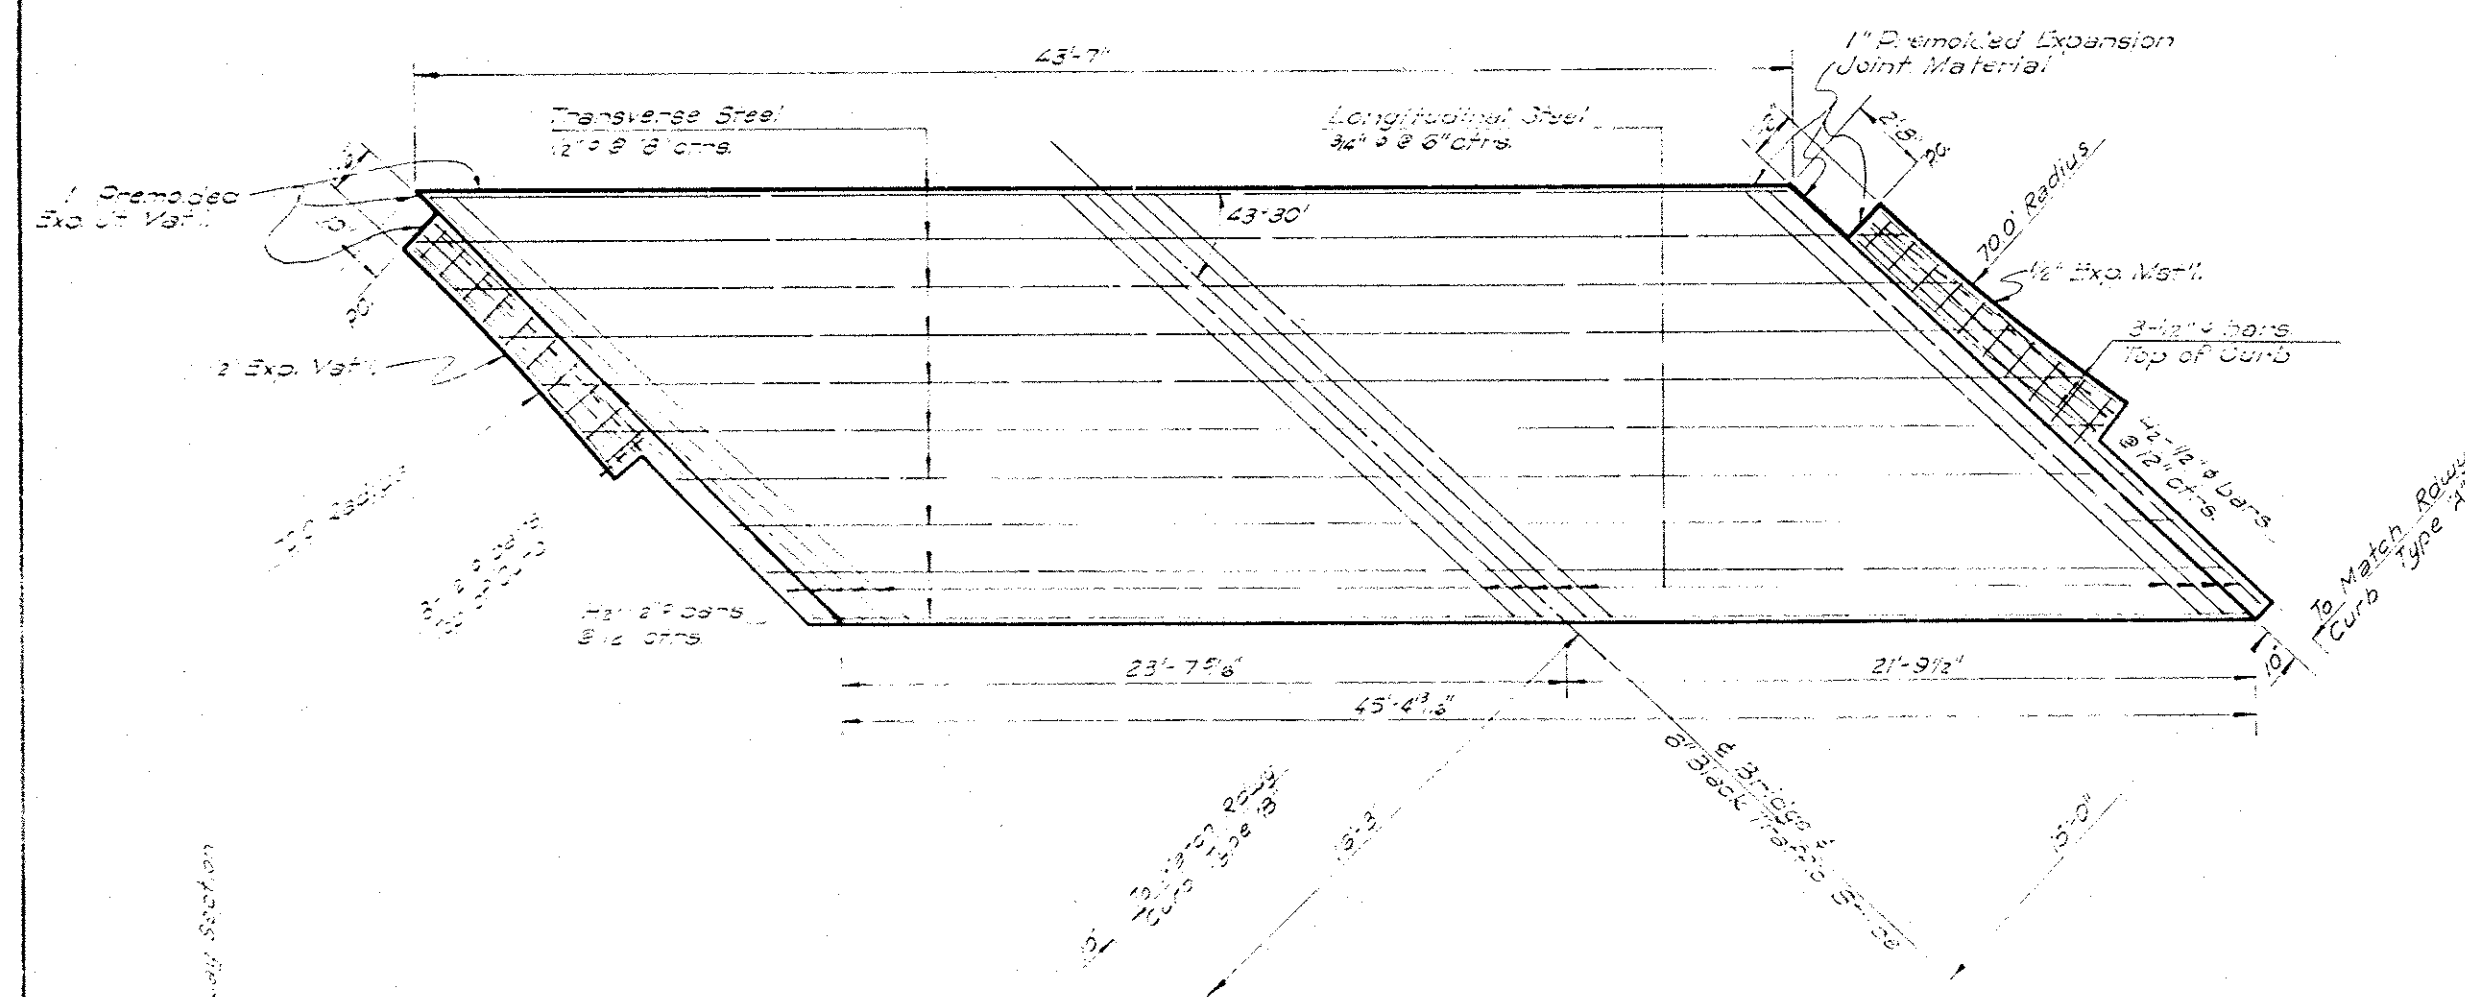


PLAN
APPR. SLAB & ABUT. #1

QUANTITIES - ONE APPROACH SLAB		
ITEM	UNIT	TOTAL
Approach Slab	Sq. Yd.	13.8
* Reinforcing Steel	Lbs.	2,320
6" Black Traffic Stripe	L.F.	20

*Note: Cost of Reinforcing Steel in Approach Slab shall be included in price bid per Sq. Yd. of Approach Slab.
Note: Cost of Curbs on Approach Slab shall be included in price bid per Sq. Yd. of Approach Slab.

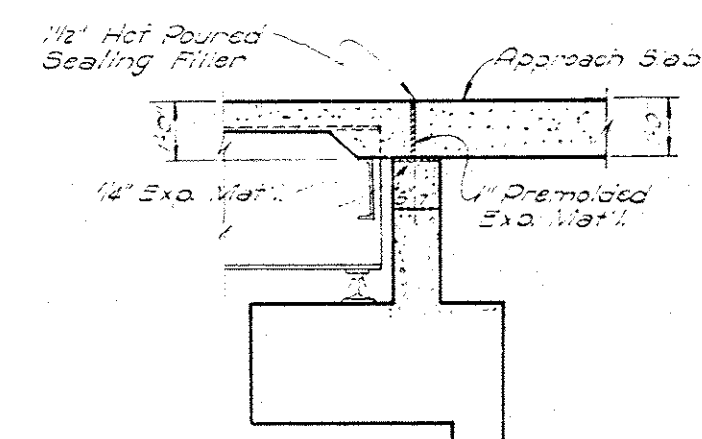


DETAIL OVER ABUTMENT

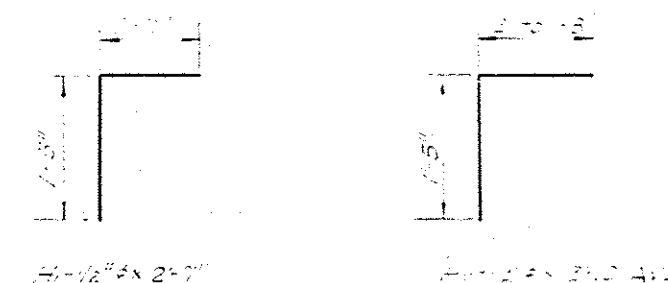

REVISIONS			RECORD		OKLAHOMA STATE HIGHWAY COMMISSION	
NO.	DESCRIPTION	BY	DATE	ITEM	BY	DATE
				DESIGN		
				DETAIL		
				TRACED	OK	
				CHECKED	OK	
				APPROVED		
				SIGNED	BAW	4/17


OKLAHOMA CITY, OKLAHOMA
STR. NO. 12
DETAILS OF APPROACH SLABS
STATION SURVEY 143+60.64
FA. PROJ. I-381(16) PT-2

END VIEW

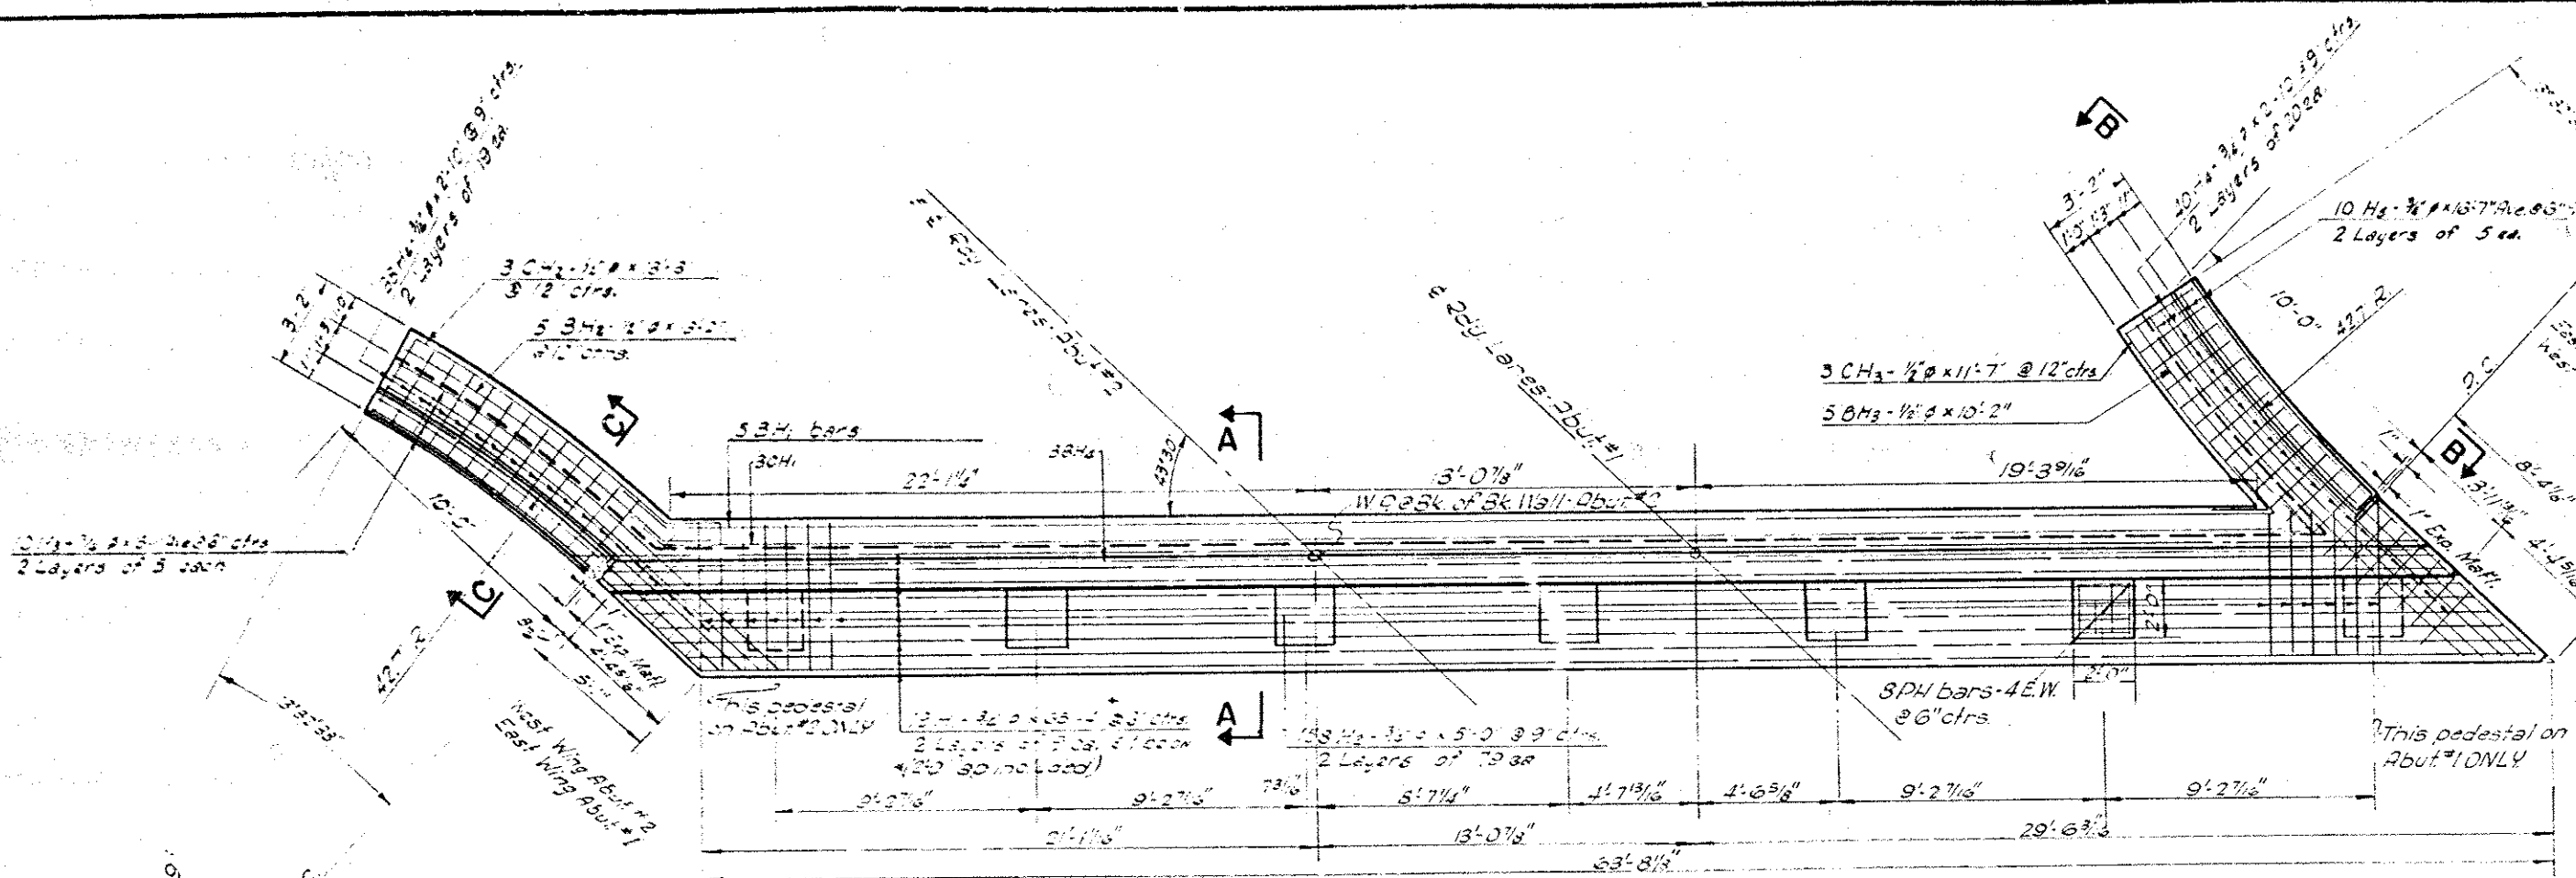


PLAN

Abut. No. 1 shown; Abut. No. 2 Similar

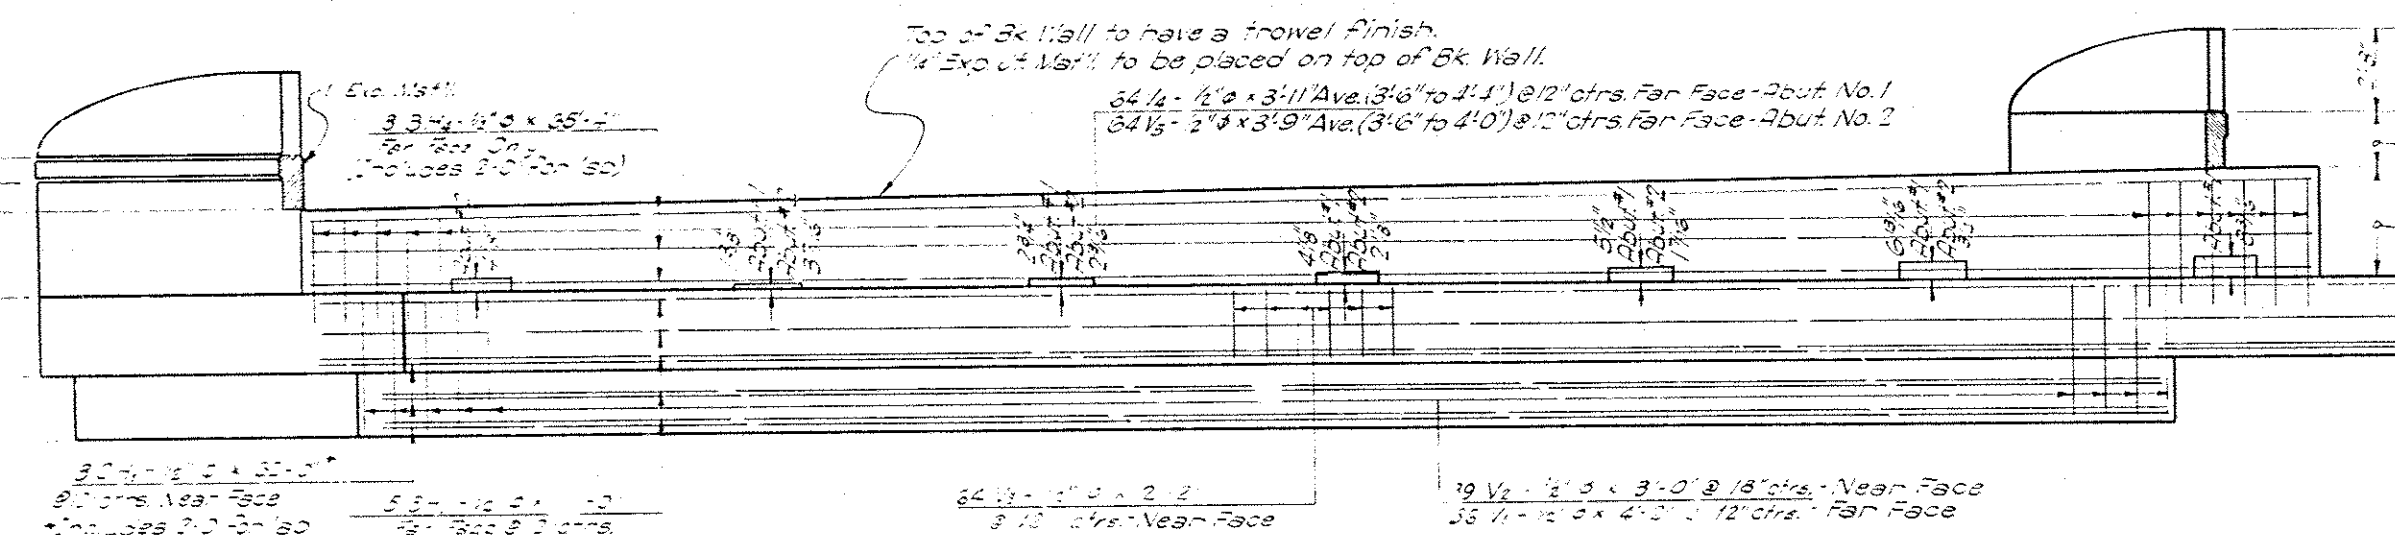


ELEVATION

Abut. No. 1 Shown
Abut. No. 2 Similar

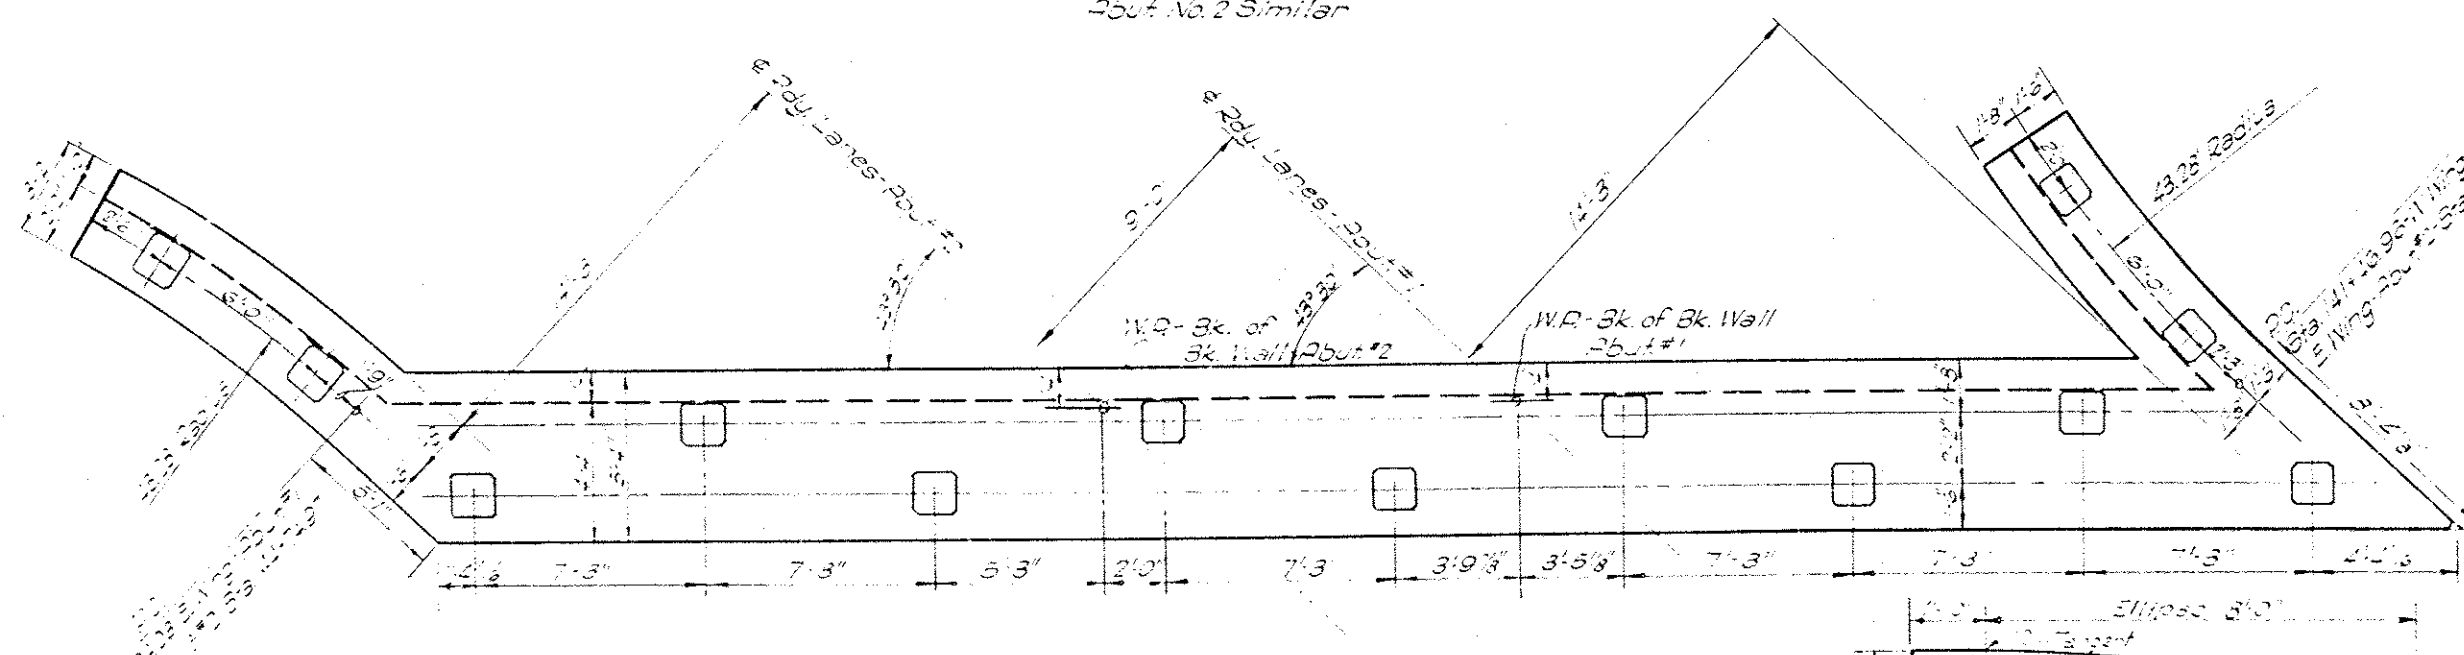


PILE SPACING PLAN

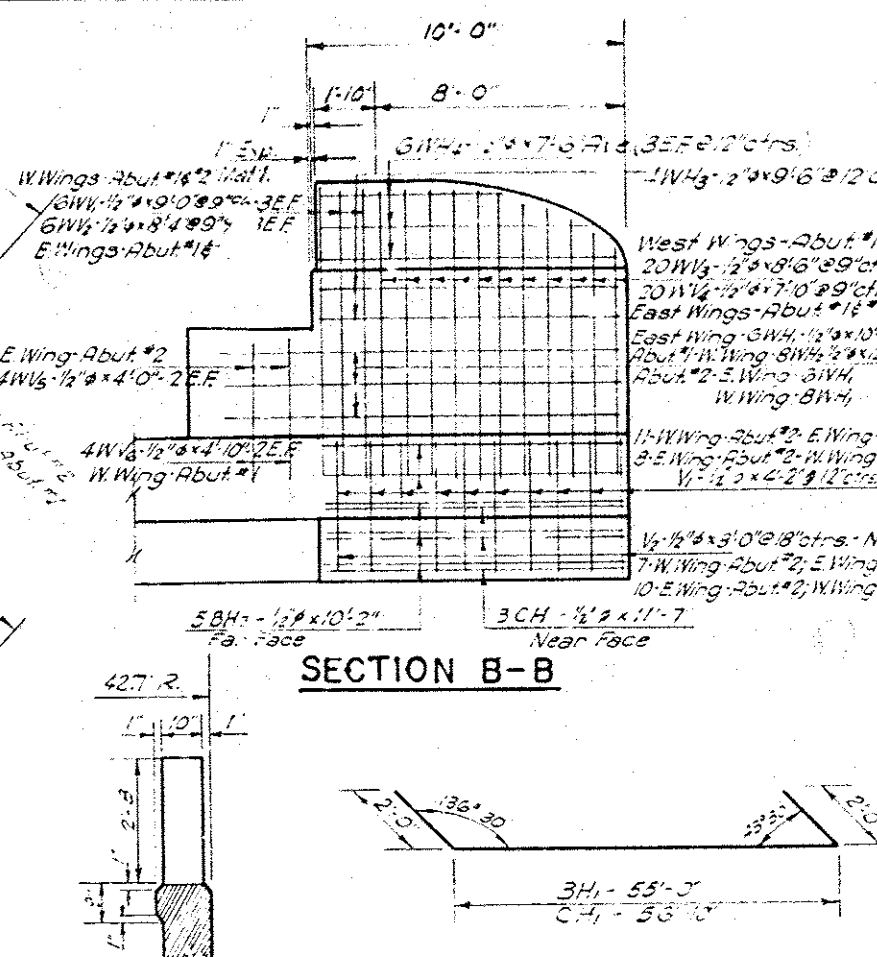


SECTION B-B

WING WALL DETAIL

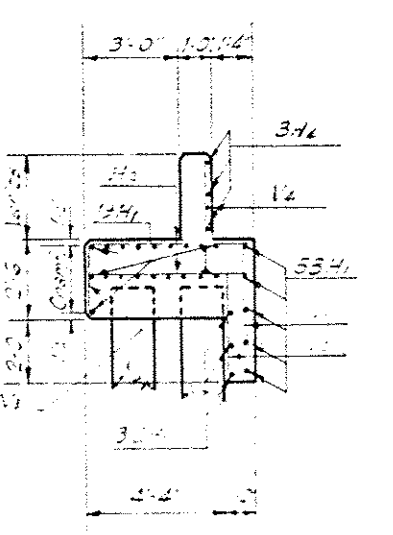

SECTION A-A

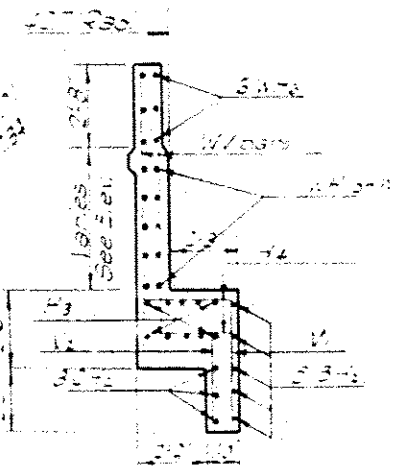

SECTION C-C

BAR LIST-ONE ABUT.

Mark	No.	Size	Form	Length
H1	19	3/4"	Str.	65'-4"
H2	158	3/4"	Str.	5'-0"
H3	10	3/4"	Str.	15'-11" Ave.
H4	78	3/4"	Str.	2'-10"
H5	10	3/4"	Str.	6'-7" Ave.
H6	3	1/2"	Str.	56'-10"
H7	3	1/2"	Str.	13'-3"
H8	3	1/2"	Str.	11'-7"
H9	3	1/2"	Str.	59'-0"
H10	5	1/2"	Str.	18'-2"
H11	5	1/2"	Str.	10'-2"
H12	3	1/2"	Str.	65'-4"
V1	75	1/2"	Str.	4'-2"
V2	56	1/2"	Str.	3'-0"
V3	64	1/2"	Str.	2'-2"
V4	64	1/2"	Str.	3'-11" Ave.
V5	64	1/2"	Str.	3'-9" Ave.
W1	6	1/2"	Str.	0'-1"
W2	8	1/2"	Str.	12'-11"
W3	8	1/2"	Str.	10'-4"
W4	6	1/2"	Str.	12'-11"
W5	8	1/2"	Str.	9'-6"
W6	12	1/2"	Str.	7'-8" Ave.
W7	12	1/2"	Str.	9'-0"
W8	12	1/2"	Str.	8'-4"
W9	20	1/2"	Str.	8'-8"
W10	20	1/2"	Str.	7'-10"
W11	2	1/2"	Str.	2'-0"
W12	2	1/2"	Str.	2'-0"
W13	2	1/2"	Str.	2'-0"
W14	2	1/2"	Str.	2'-0"
W15	2	1/2"	Str.	2'-0"
W16	2	1/2"	Str.	2'-0"
W17	2	1/2"	Str.	2'-0"
W18	2	1/2"	Str.	2'-0"
W19	2	1/2"	Str.	2'-0"
W20	2	1/2"	Str.	2'-0"

QUANTITIES-ONE ABUTMENT

Item	Quantity	Unit
Class 3 Concrete	5.4	CY
Reinforcing Steel	65.3	TON
Subgrade Excav. Common	5.0	CY

EXCAVATION DETAILS




Refer to Section 100 on Sheet No. 2.

GENERAL NOTES


1. Construction of bridge shall be in accordance with the Oklahoma Standard Specifications for Highway Construction.
2. All materials shall be of the best quality and conform to the A.S.T.M. Specification.
3. All concrete shall be placed in one lift unless otherwise noted.
4. For details of pile caps and other foundation details refer to Sheet No. 2.

REVISIONS NO. DESCRIPTION BY DATE		RECORD ITEM BY DATE		OKLAHOMA STATE HIGHWAY COMMISSION OKLAHOMA CITY, OKLAHOMA STR. NO. 13 DETAILS OF ABUTMENTS STA. ON SURVEY 142+94.24 FA. PROJ. I-38(16) PT. 2
DESIGN		DESIGN		
DETAIL		DETAIL		
TRACED C.H.		TRACED C.H.		
CHECKED		CHECKED		
APPROVED		APPROVED		
SIGNED		SIGNED		

FED. ROAD DIST. NO.	STATE	PROJECT NO.	SHEET NO.	TOTAL SHEETS
6	OKLA.	1-381(16)PT. 2	30	38

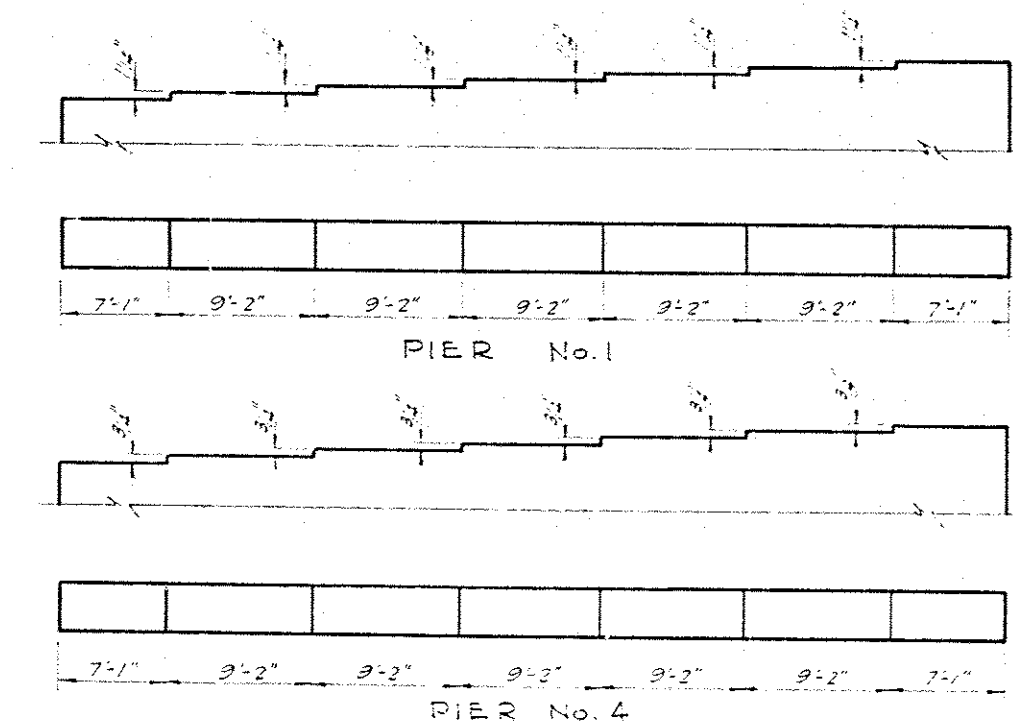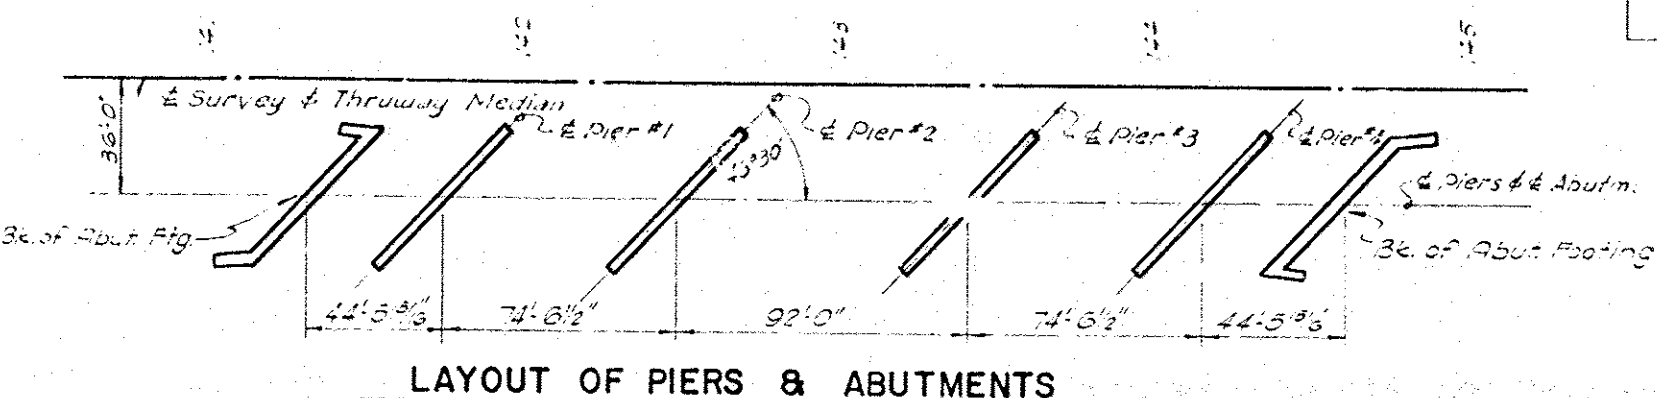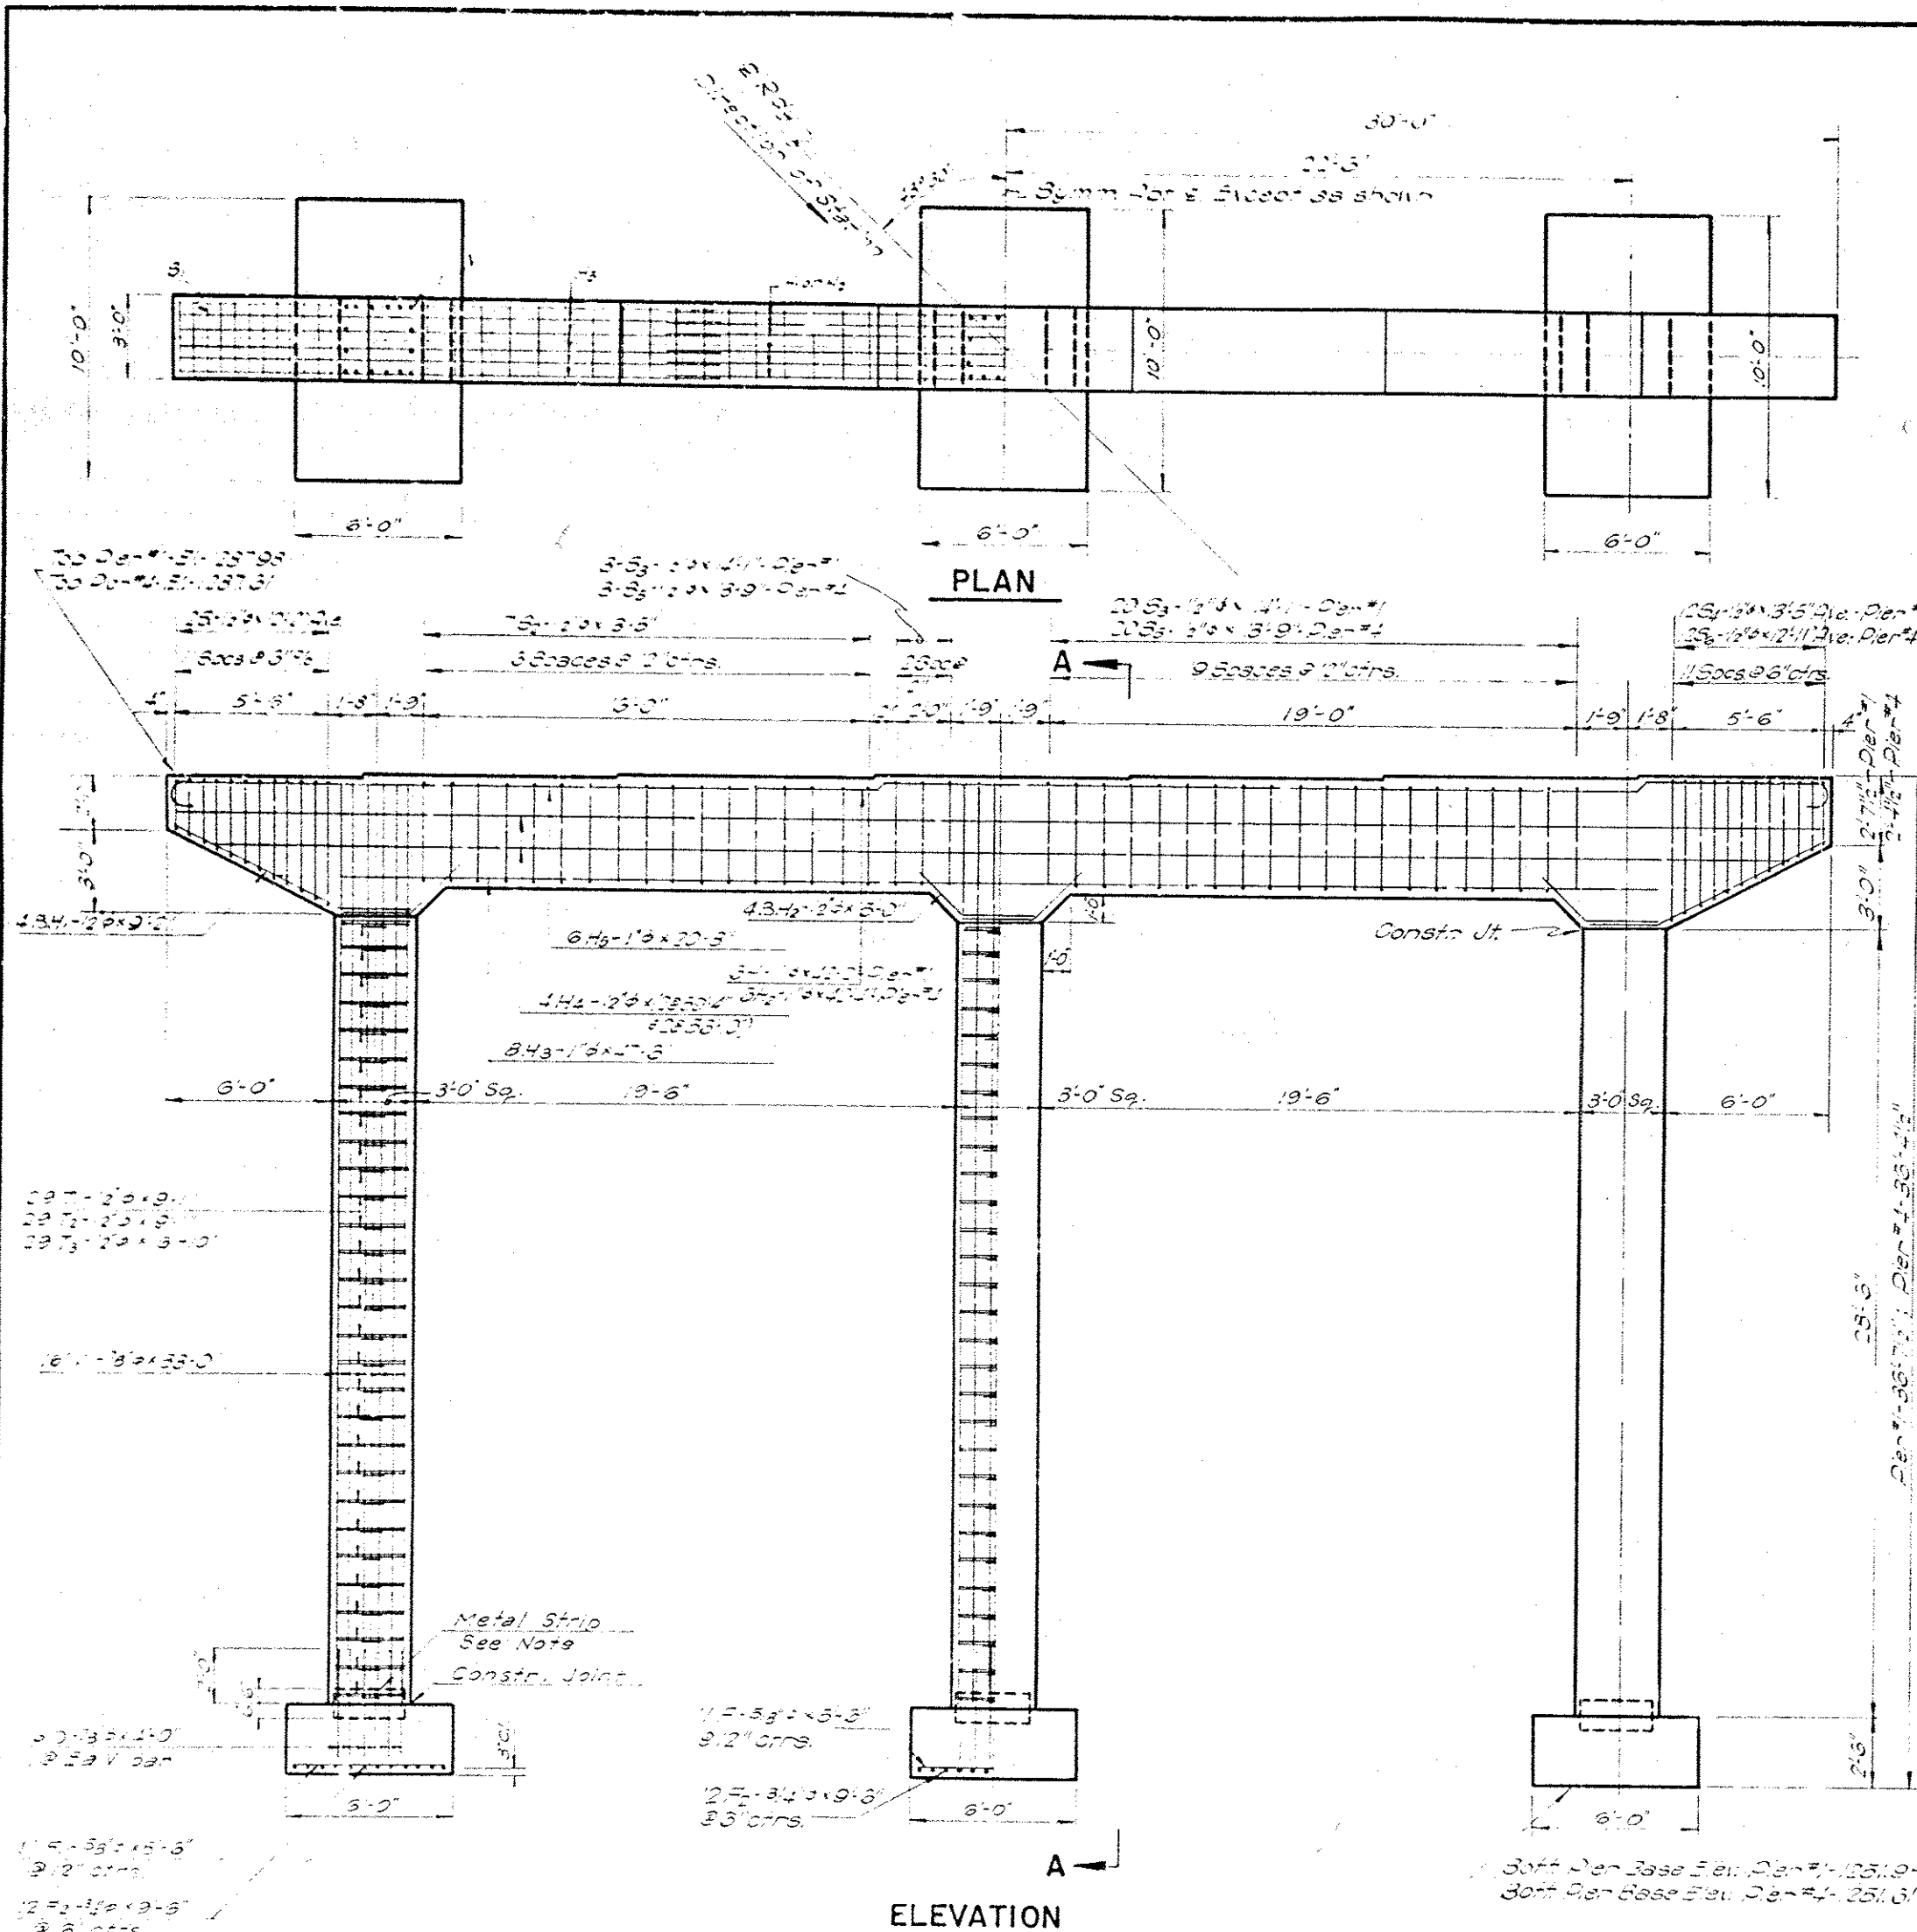

MARK	No.	SIZE	FORM	LENGTH
43	8	1/2"	3'-0"	17'-6"
44	4	1/2"	3'-0"	58'-3/4"
45	6	1/2"	3'-0"	20'-3"
46	8	1/2"	3'-0"	51'-2"
47	16	1/2"	3'-0"	3'-0"
48	30	3/4"	3'-0"	33'-0"
49	27	3/4"	3'-0"	9'-11"
50	23	3/4"	3'-0"	9'-0"
51	23	3/4"	3'-0"	3'-0"
52	2	3/4"	3'-0"	22'-2 1/2"
53	23	3/4"	3'-0"	3'-5"
54	23	3/4"	3'-0"	2'-11"
55	23	3/4"	3'-0"	3'-5 1/2"
56	23	3/4"	3'-0"	3'-9"
57	2	3/4"	3'-0"	2'-11"
58	2	3/4"	3'-0"	2'-11"
59	2	3/4"	3'-0"	2'-11"
60	2	3/4"	3'-0"	2'-11"

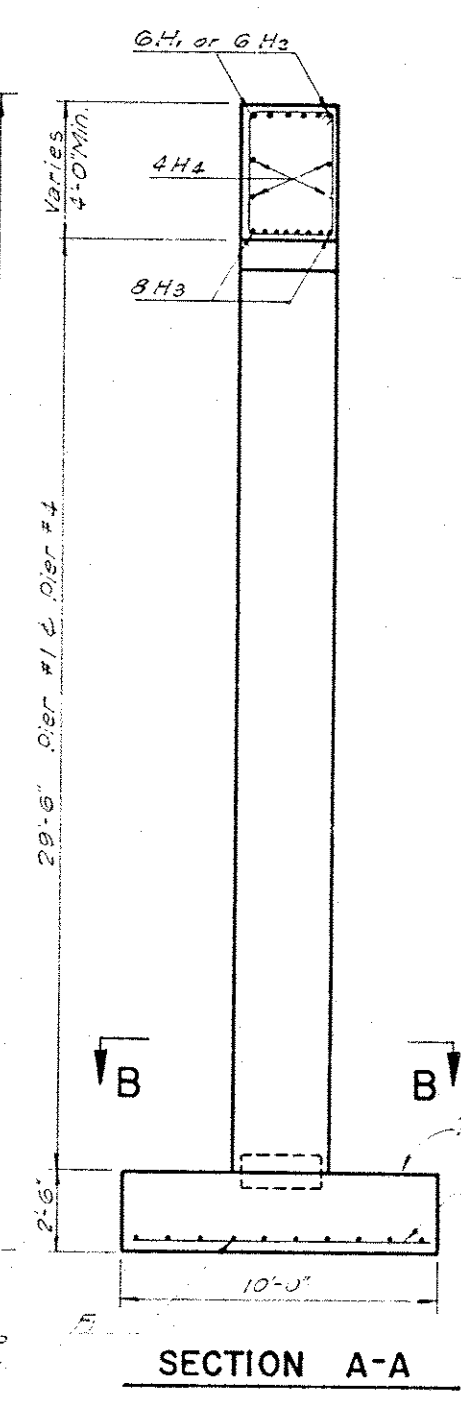

ITEM	UNIT	PIER #1	PIER #4
Reinforcing Steel	TON	57.00	57.00
Class A Concrete	CU YD	57.8	57.8
Class B Concrete Base	CU YD	3.7	3.7
Subgrade Excav. Common	CU YD	4.0	4.0
Subgrade Excav. Rock	CU YD	9	9

NO.	DESCRIPTION	BY	DATE	RECORD	BY	DATE
	DESIGN					
	DETAIL					
	TRACED					
	CHECKED					
	APPROVED					
	SIGNED					

OKLAHOMA STATE HIGHWAY COMMISSION
OKLAHOMA CITY, OKLAHOMA

STR. NO. 13

DETAILS OF PIERS

PIER NO. 1 & PIER NO. 4

STATION & SURVEY 142+94.24


FA. PROJ. 1-381(16)PT. 2

FED. ROAD DIST. NO.	STATE	PROJ. NO.	SHEET NO.	TOTAL SHEETS
6	OKLA.	1-381(16) PT. 2	81	88

BAR LIST - ONE PIER

ITEM	NO.	SIZE	FORM	LENGTH
H1	9	1/2"	Sfr	17'-6"
H2	4	1/2"	Sfr	58'-1 1/2"
H3	8	1/2"	Bnt	9'-2"
H4	16	1/2"	Bnt	5'-0"
V	30	1/2"	Sfr	35'-0"
T1	23	1/2"	Bnt	5'-0"
T2	23	1/2"	Bnt	9'-0"
T3	23	1/2"	Bnt	7'-11"
D	60	1/2"	Sfr	4'-0"
WH1	10	1/2"	Sfr	45'-0"
WH2	8	3/4"	Sfr	45'-0"
WV	19	1/2"	Bnt	13'-5"
F2	42	5/8"	Sfr	8'-6"
S1	12	5/8"	Bnt	12'-3 1/2"
S2	10	5/8"	Bnt	13'-6"
S3	15	5/8"	Bnt	13'-10"
S4	19	5/8"	Bnt	14'-9"
S5	12	5/8"	Bnt	13'-5 1/2"
S6	19	5/8"	Bnt	14'-1"
H1	7	1/2"	Bnt	13'-1 1/2"
H2	7	1/2"	Bnt	43'-6"
H3	7	1/2"	Bnt	20'-11"
H4	7	1/2"	Bnt	20'-11"
F1	42	1/2"	Sfr	12'-6"
F2	22	1/2"	Sfr	7'-6"

PIER NO.	PIER NO.	PIER NO.
S4	S5	S6
S7	S8	S9
H1	H2	H3
H4	H5	H6
F1	F2	F3

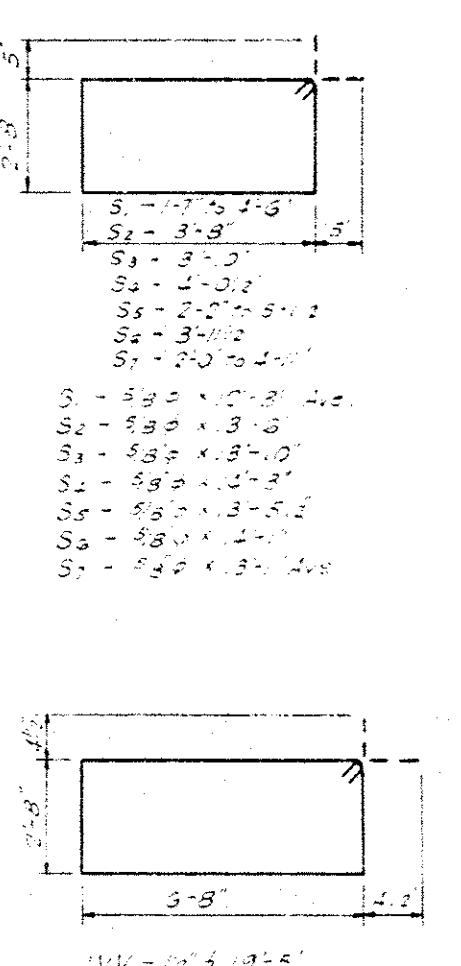

QUANTITIES - ONE PIER

ITEM	UNIT	PIER NO. 2	PIER NO. 3
Reinforcing Steel	LS	9,625	9,625
Class A Concrete	CY	39.9	50.0
Class A Concrete Pier Bases	CY	25.3	25.3
Substr. Fill - Common	CY	91	339
Substr. Fill - Rock	CY	33	11

OKLAHOMA STATE HIGHWAY COMMISSION
OKLAHOMA CITY, OKLAHOMA

STR. NO. 13






DETAILS OF PIERS

PIER NO. 2 & PIER NO. 3

CL STA. ON CL SURVEY 142+94.24

FA. PROJ. 1-381(16) PT-2


REVISIONS	RECORD
NO. DESCRIPTION BY DATE	ITEM BY DATE
DESIGN	
DETAIL	
TRACED	
CHECKED	
APPROVED	
REV. NO. 35X141	

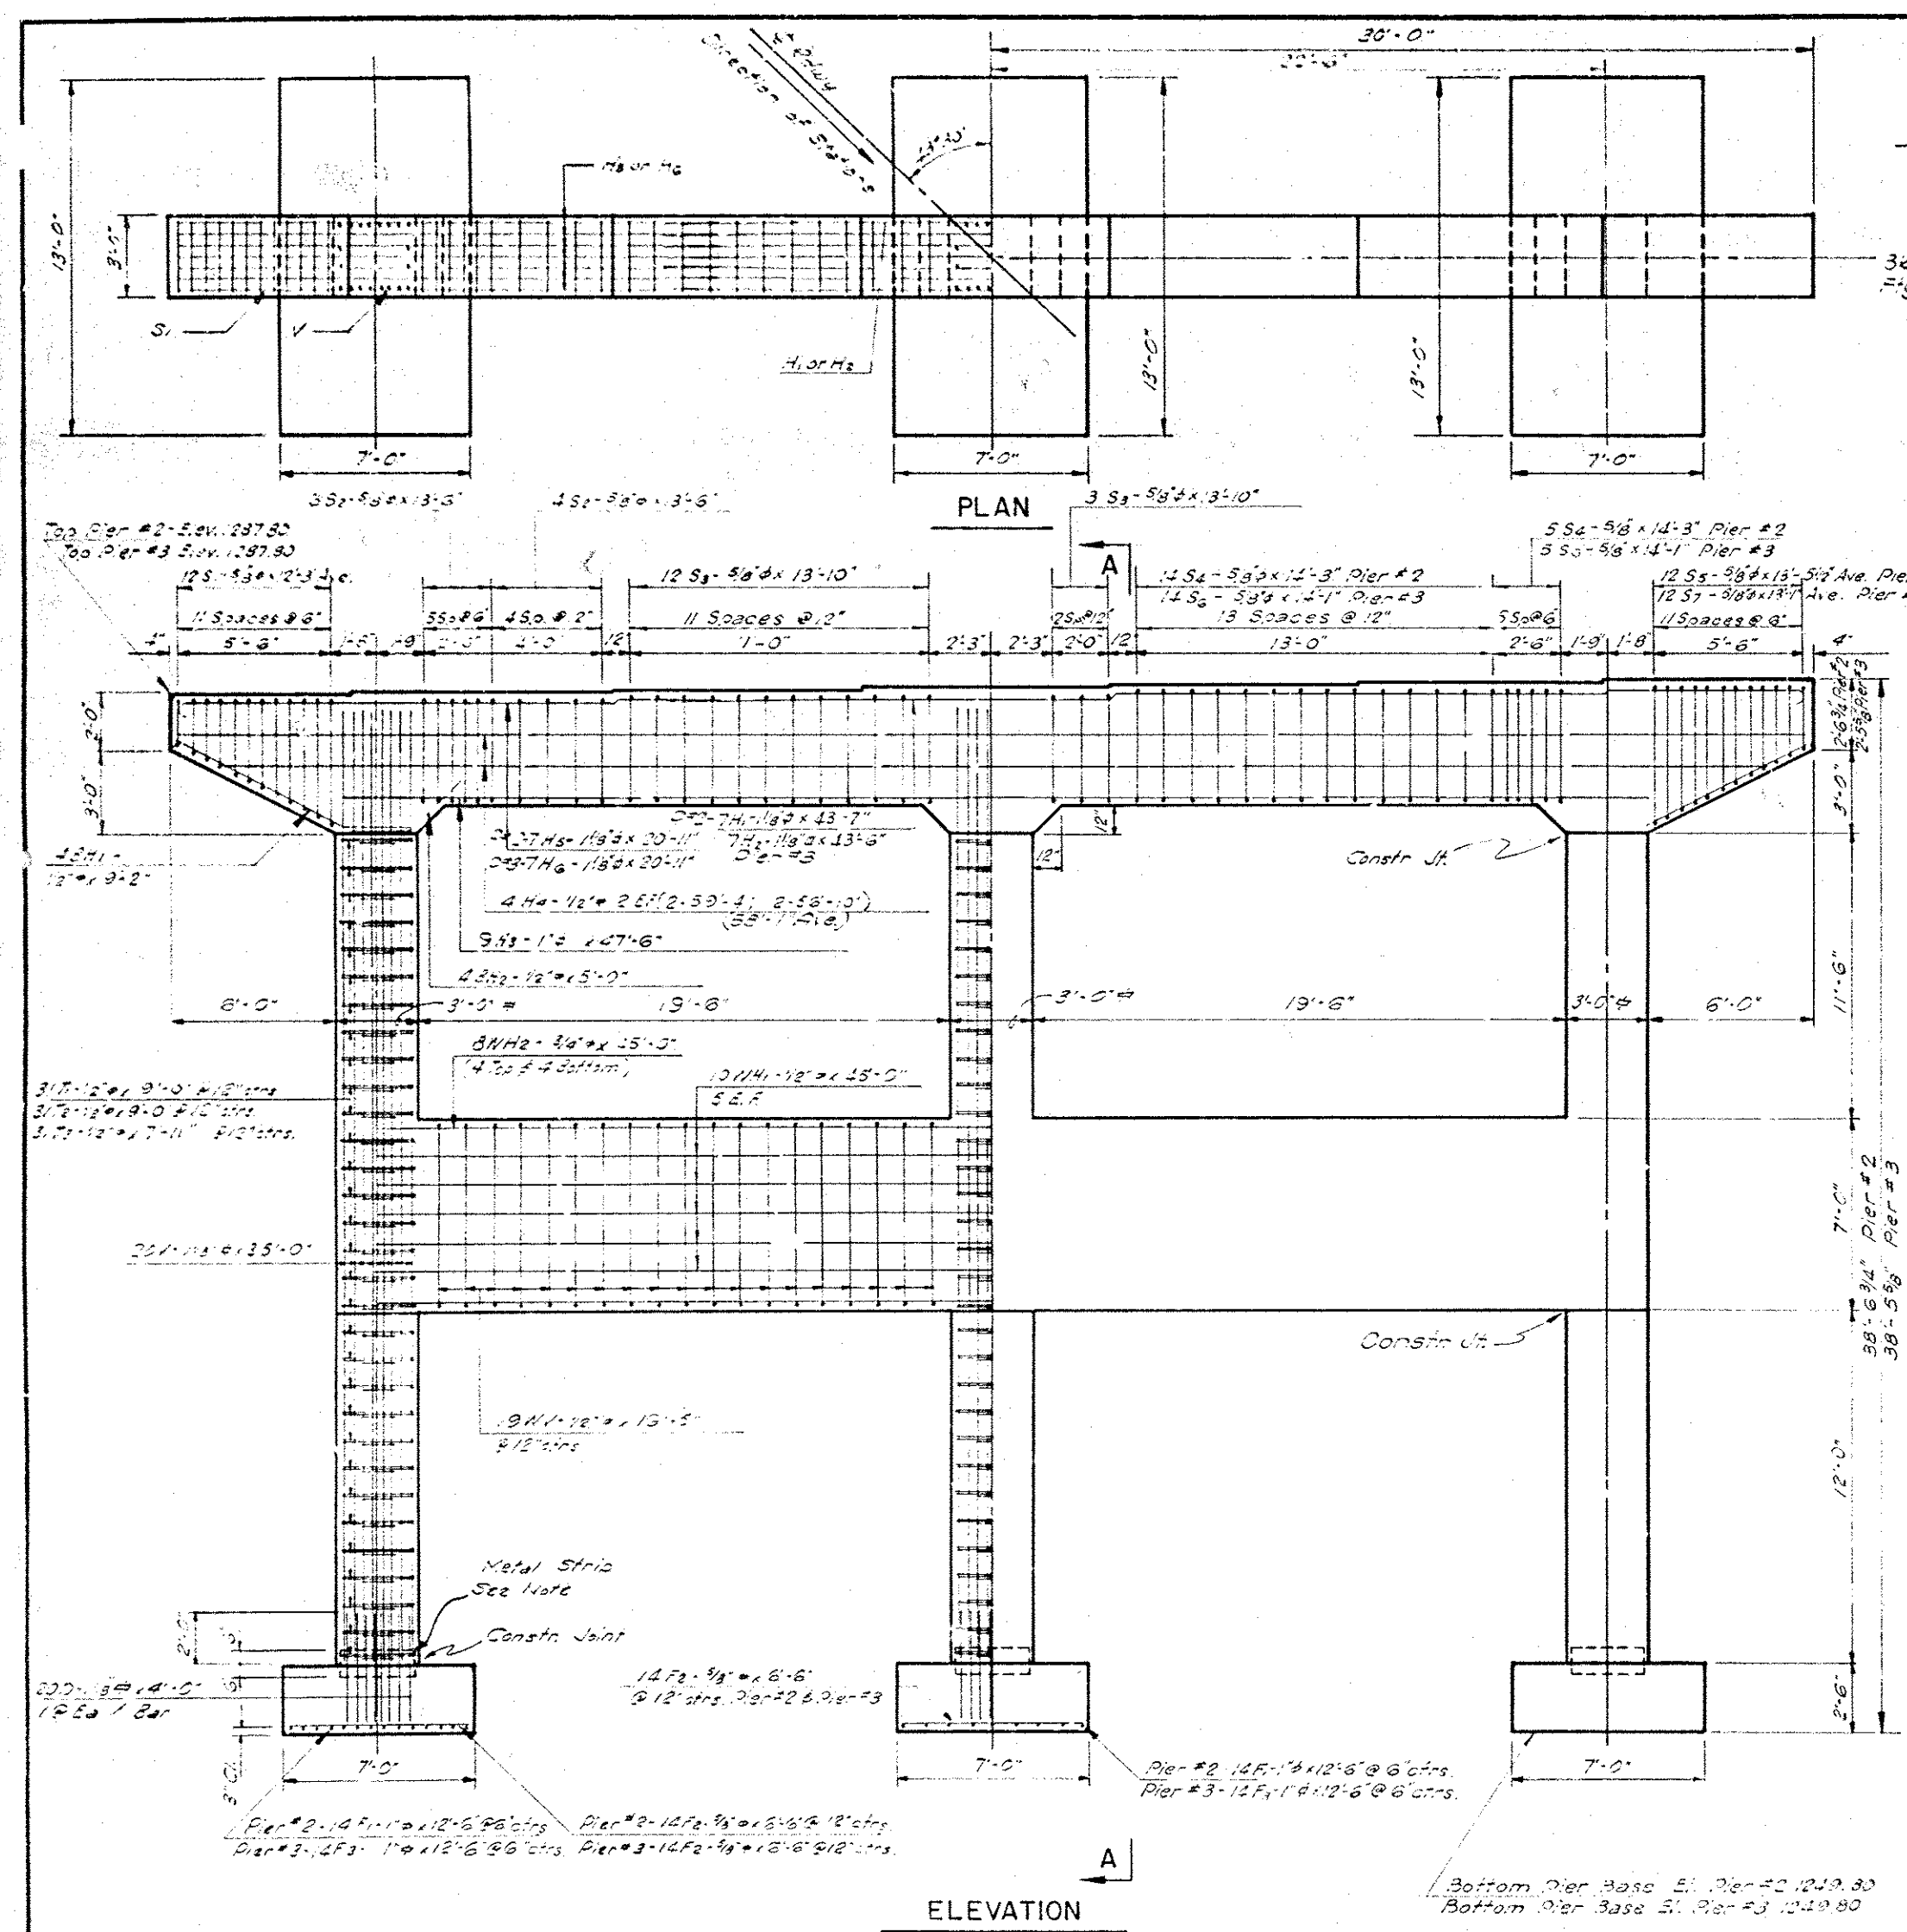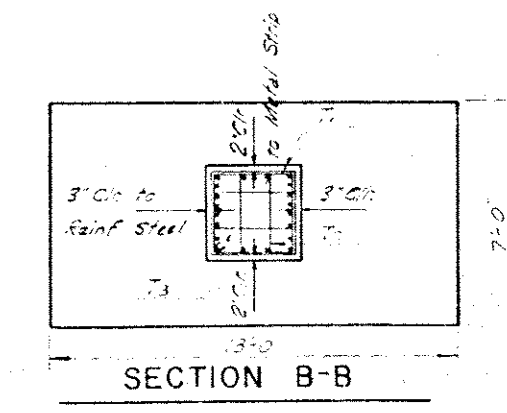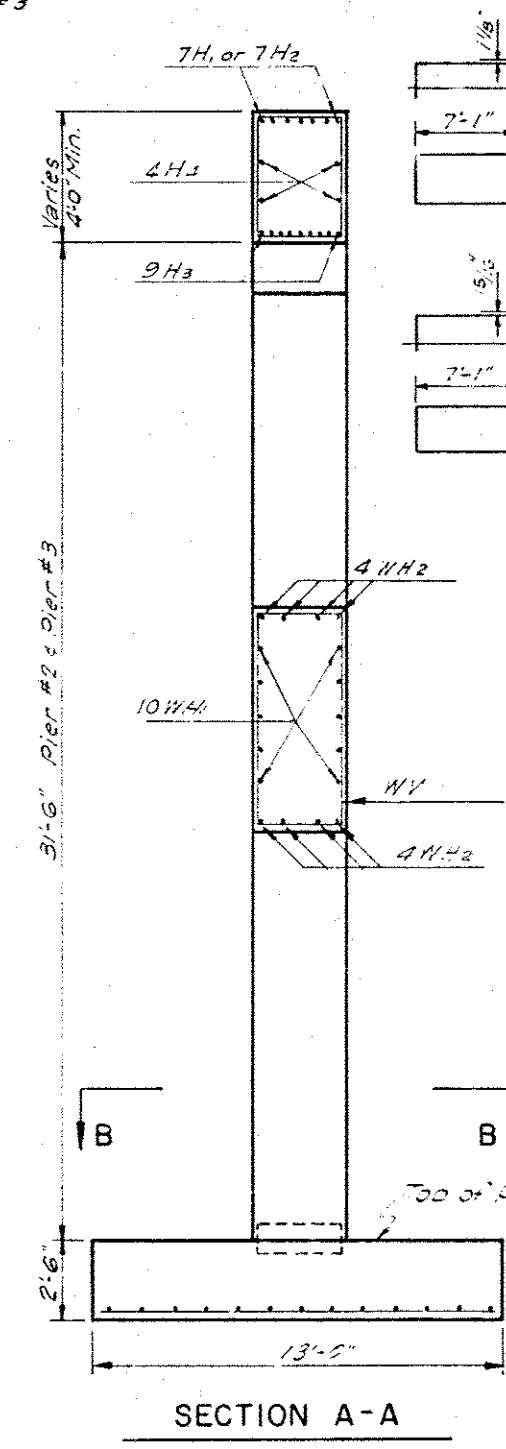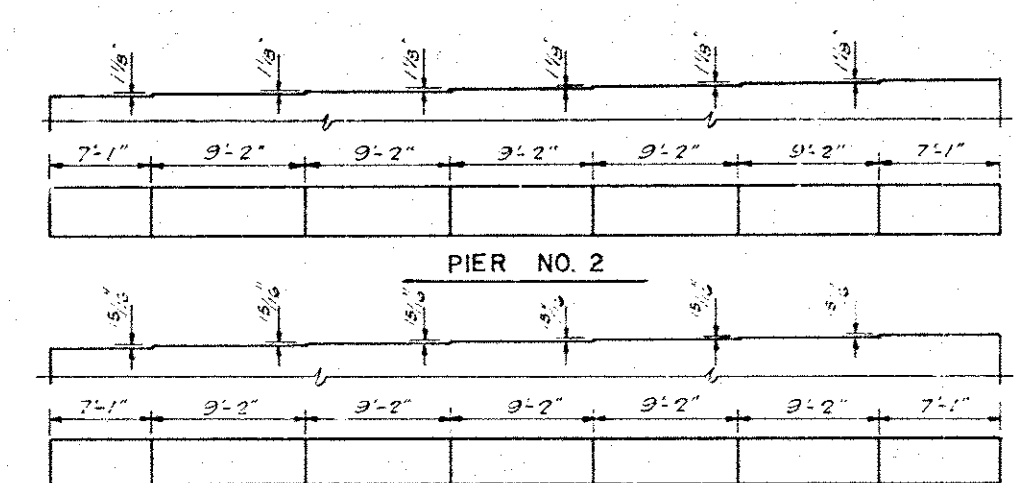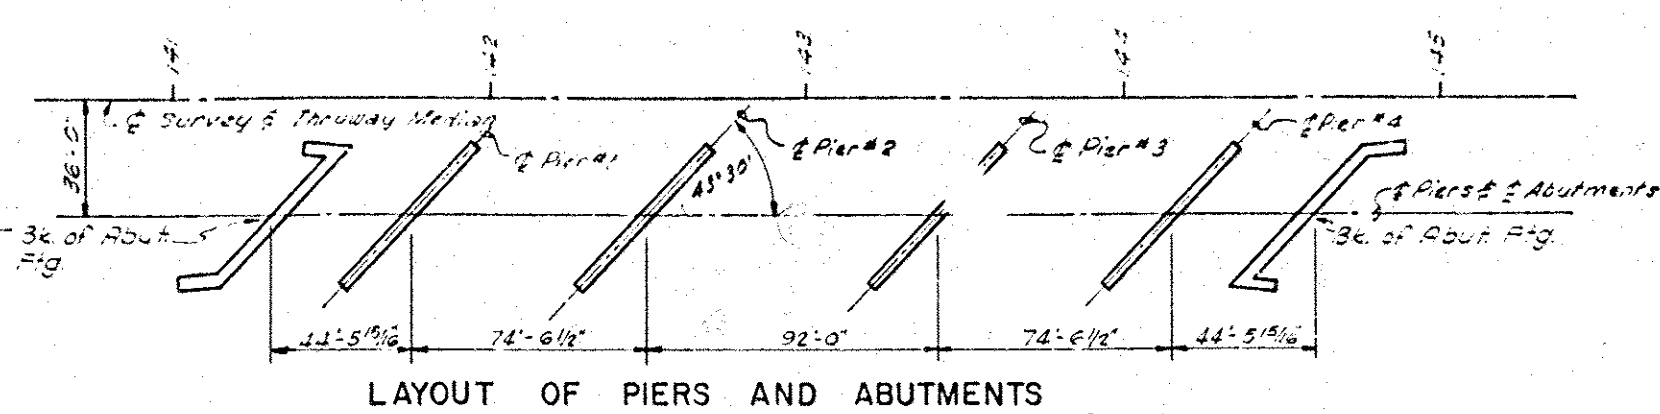


NOTE: All reinforcing steel bars shall conform to A.S.T.M. specifications A-305-49.
All exposed edges shall have a 1/2" chamfer unless otherwise noted.

NOTE: METAL STRIP AND PIER BASE CONCRETE.
Refer to identical notes on Detail of Piers - Index Sheet No. 22

F.D. ROAD DIST. NO.	STATE	PROJ. NO.	SHEET NO.	TOTAL SHEETS
6	OKLA.	1-381(16) PT. 2	82	88

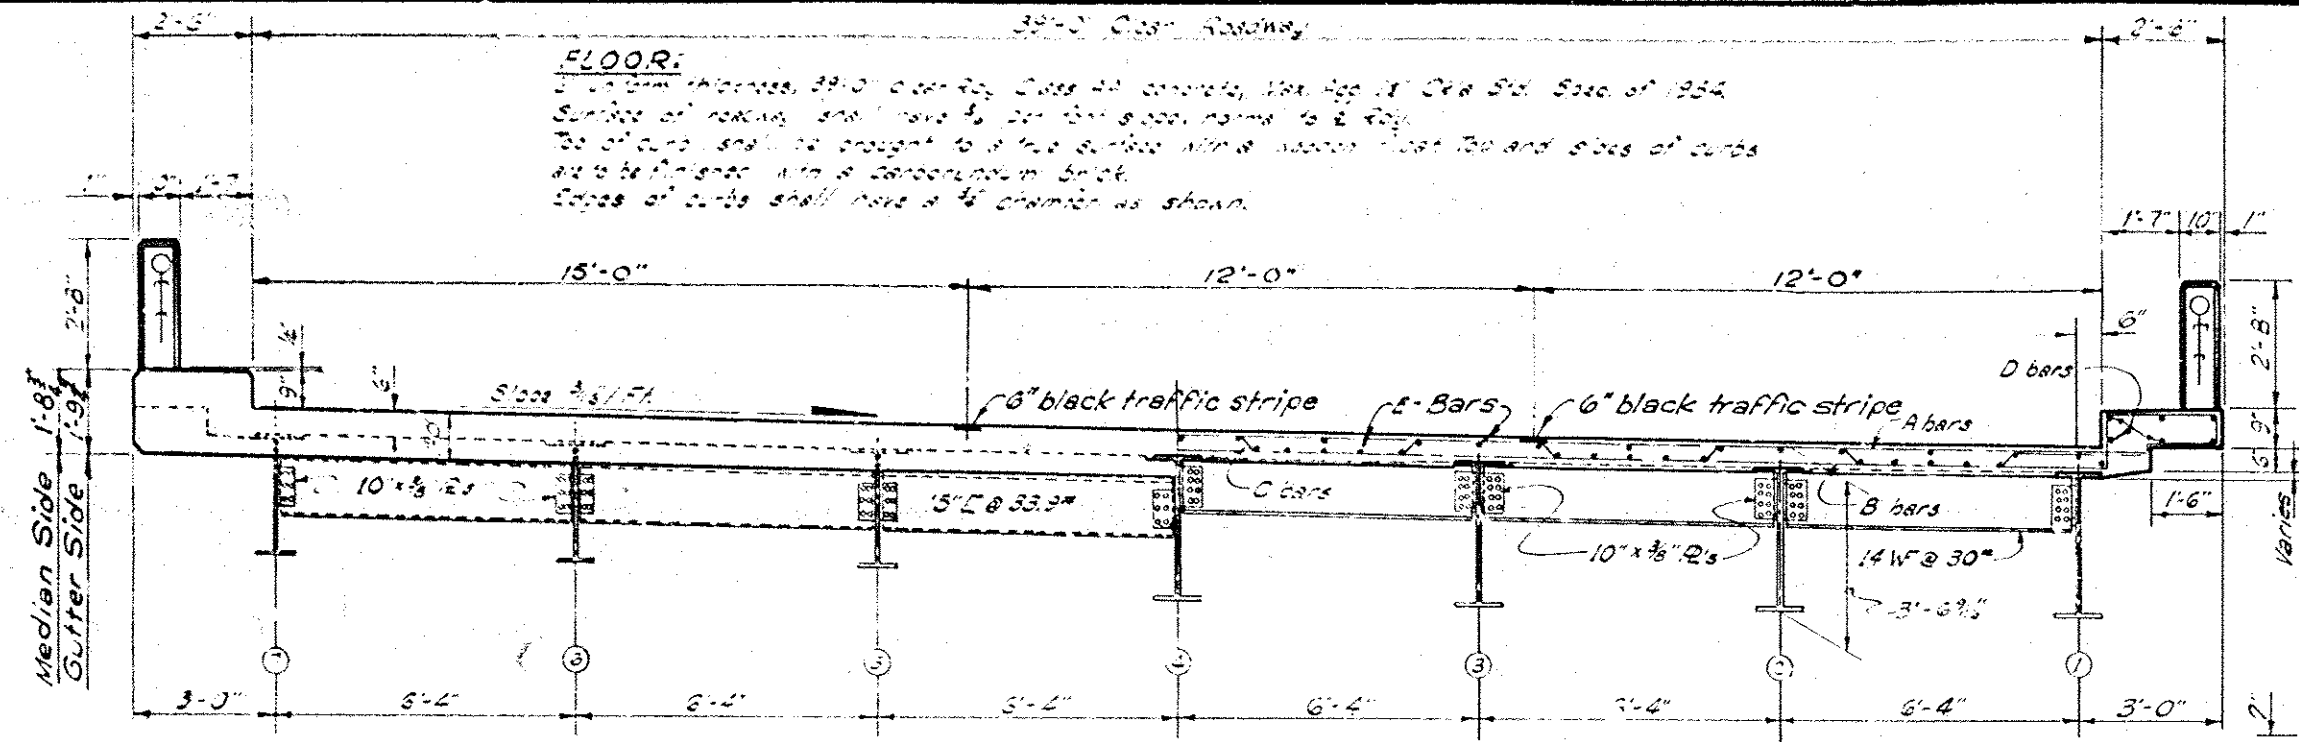

HALF END VIEW

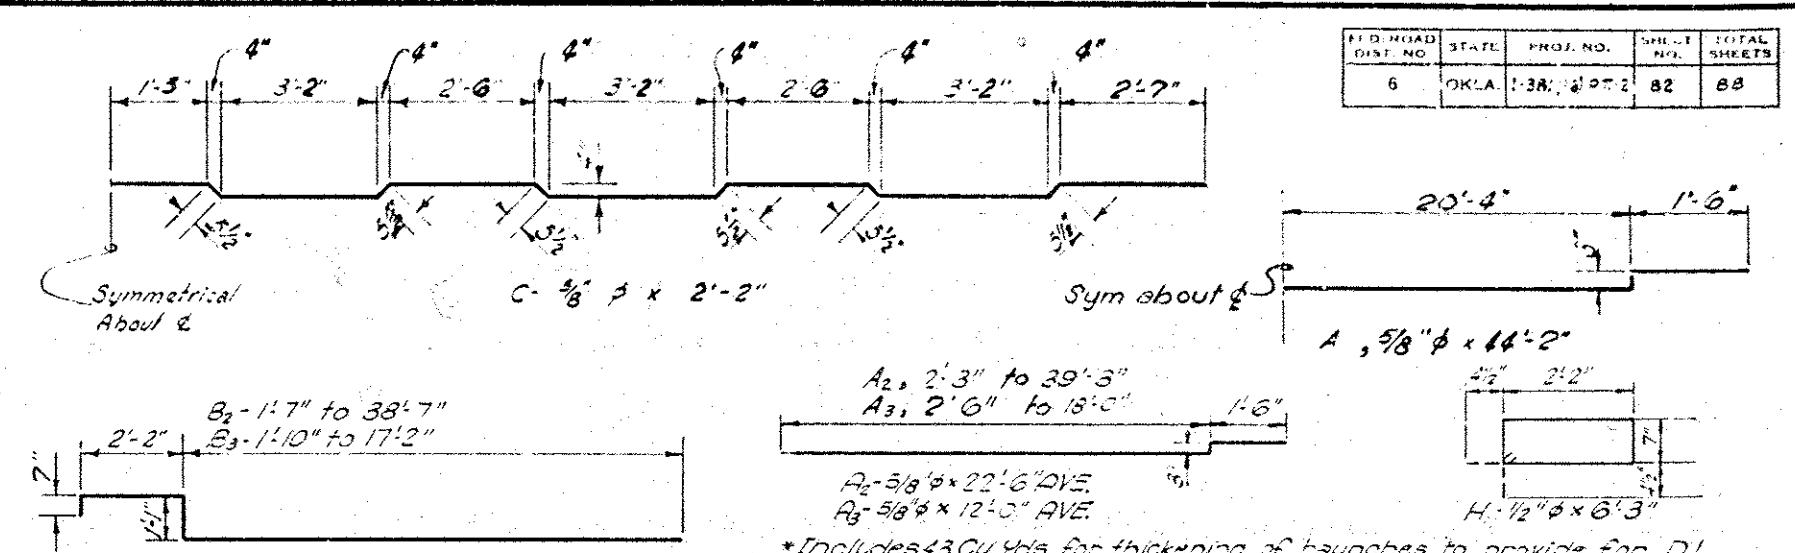


HALF SECTION AT CONSTRUCTION JOINT


REINFC:
 Bars 1 - 1/2" x 3/8" Cts across the Rdy 1/4" below top of slab, bent as shown.
 Bars 2 - 1/2" x 3/8" Cts across the Rdy 1/4" above bottom of slab, bent as shown.
 Bars 3 - 1/2" x 3/8" Cts across the Rdy 1/4" top of bottom.
 Bars 4 - 1/2" x 3/8" Cts across the Rdy 1/4" top of bottom.
 Bars 5 - 1/2" x 3/8" Cts across the Rdy 1/4" top of bottom.
 Bars 100 - 1/2" x 3/8" Cts across the Rdy 1/4" top of bottom.

TABLE OF QUANTITIES-ONE STR.

NO. OF SPANS	SPAN LENGTH	SIZE OF BEAMS	WT. OF BEAM PER FT. LBS.	STIFFENERS COVER 25% OF 3/4" DEFS	WEIGHT LBS.	TOTAL WEIGHT LBS.	FLOOR	Reinf. Concrete Steel Lbs.
2	40'	30" W x 108"	756	28,560	2,800	9,840	79.6	9,755
2	74'	36" W x 130"	1,050	38,550	4,370	32,570	141.8	32,943
1	92'	36" W x 150"	1,050	38,550	4,370	32,570	57.2	20,650
TOTAL						416,910	308.6	178,350

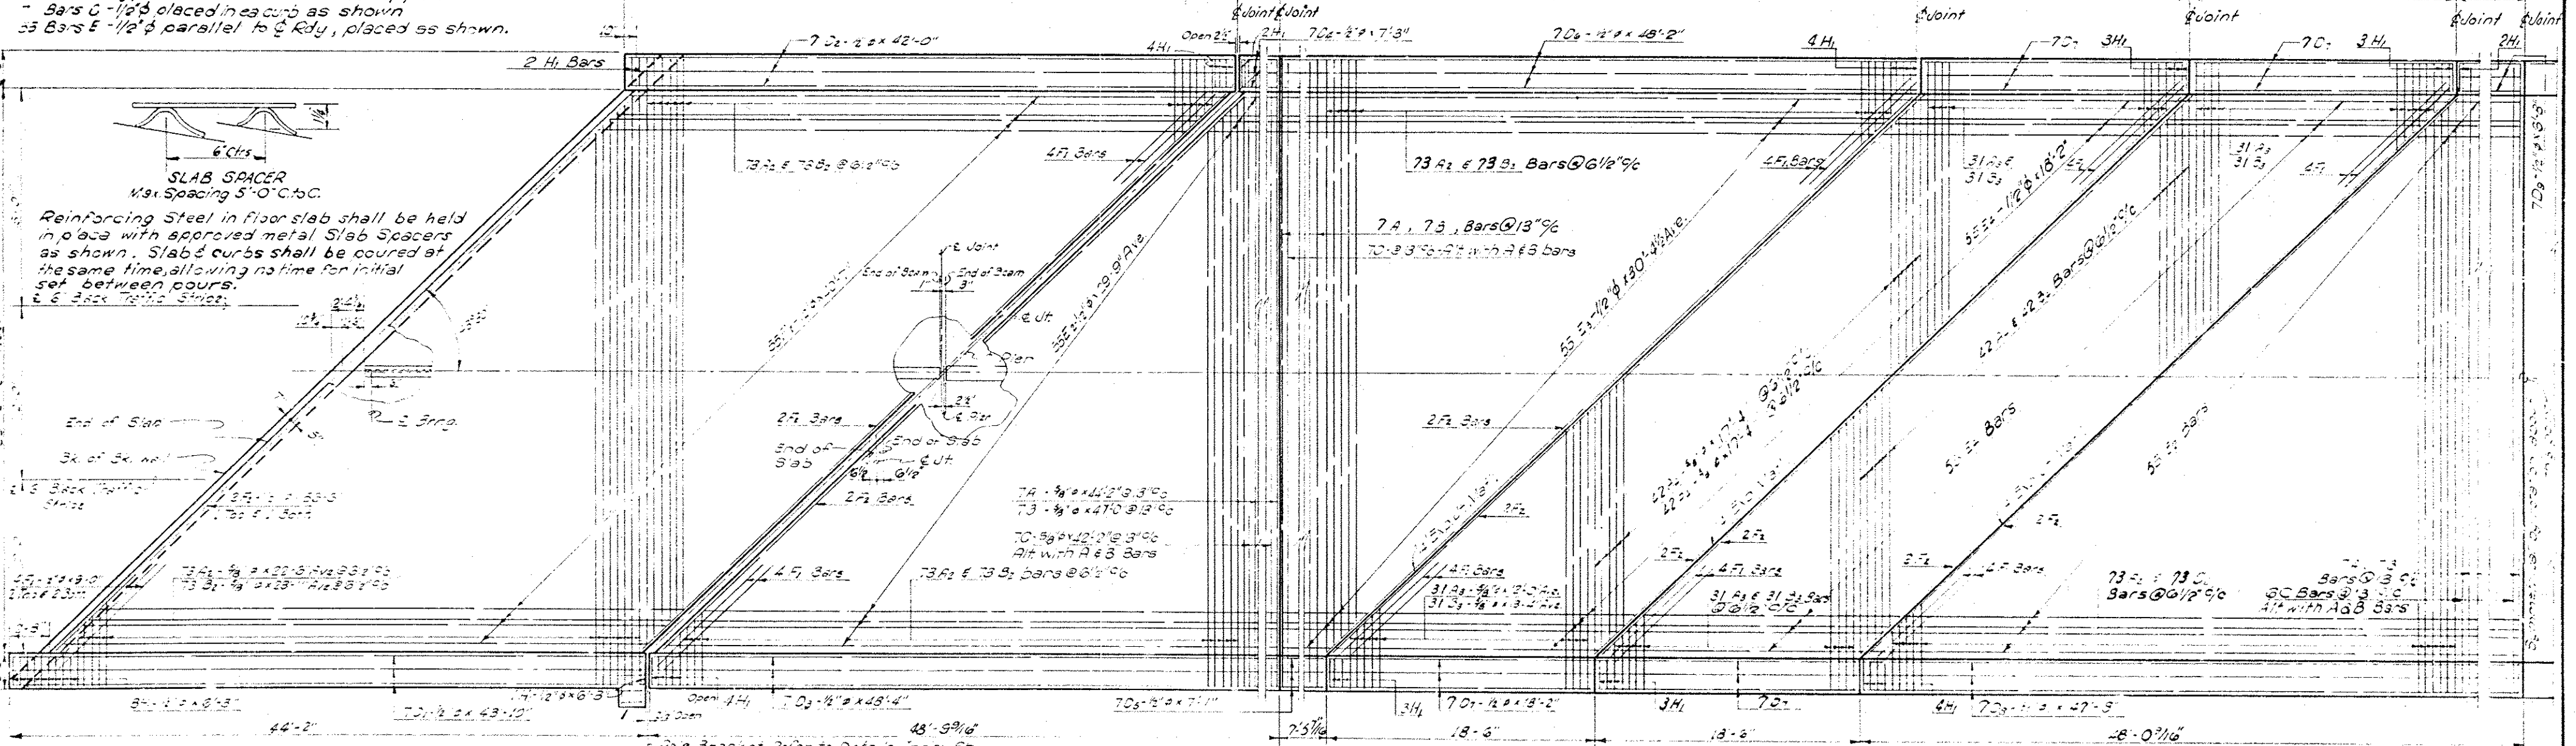

PLAN


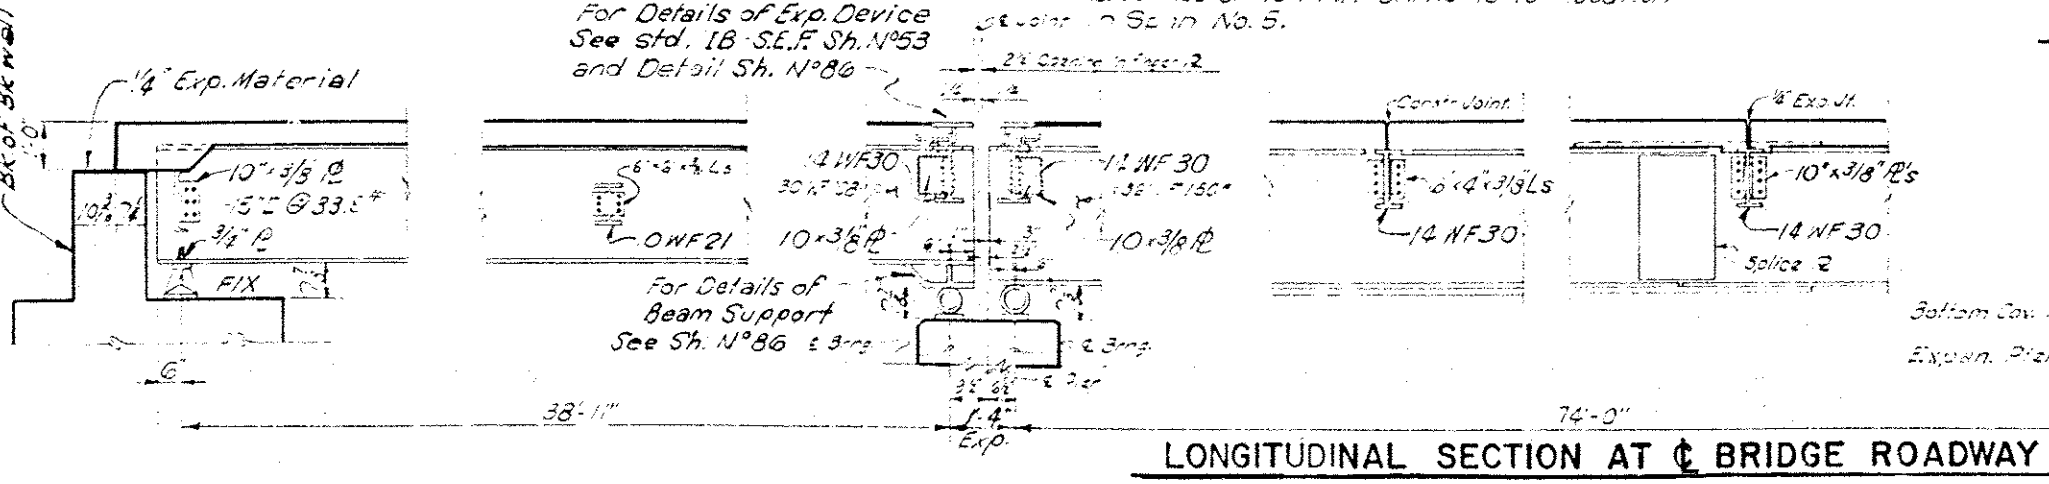


LONGITUDINAL SECTION AT BRIDGE ROADWAY

REVISIONS	BY	DATE	RECORD	BY	DATE
1	DESIGN	2-12-53	DESIGN		
2	DETAIL		TRACED C.A.		
3	CHECKED		APPROVED		
4	SQUAD	3-24-54			


OKLAHOMA STATE HIGHWAY COMMISSION
 OKLAHOMA CITY, OKLAHOMA
STR. NO. 13
DETAILS OF DECK REINFORCING
 STA. ON SURVEY 142+94.24
 F.A. PROJ. I-381(16) PT. 2

PROJECT	DATE	PROJECT NO.	SHEET NO.	TOTAL SHEETS
1-18(14)FF-2			43	48

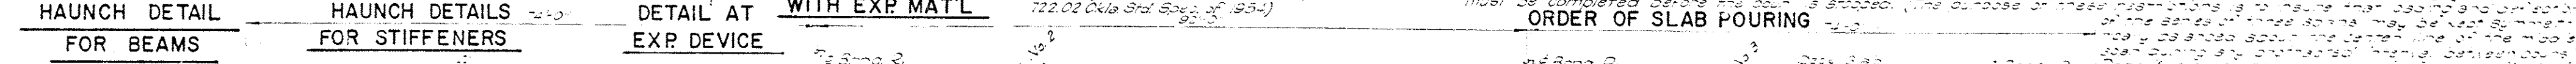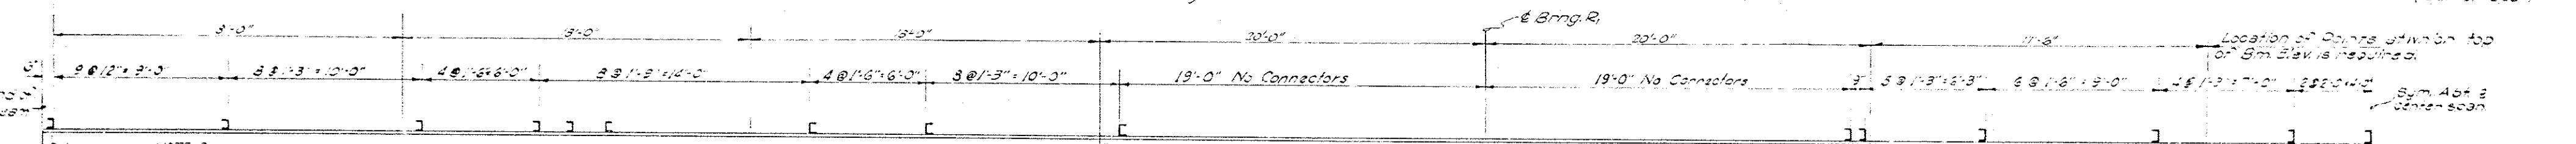


PROJECT NO. 1-381(6)PT-2, SHEET NO. 8


FED. ROAD DIST. NO.	STATE	PROJECT NO.	SHEET NO.	TOTAL SHEETS
6	OKLA.	1-381(16)	94	98

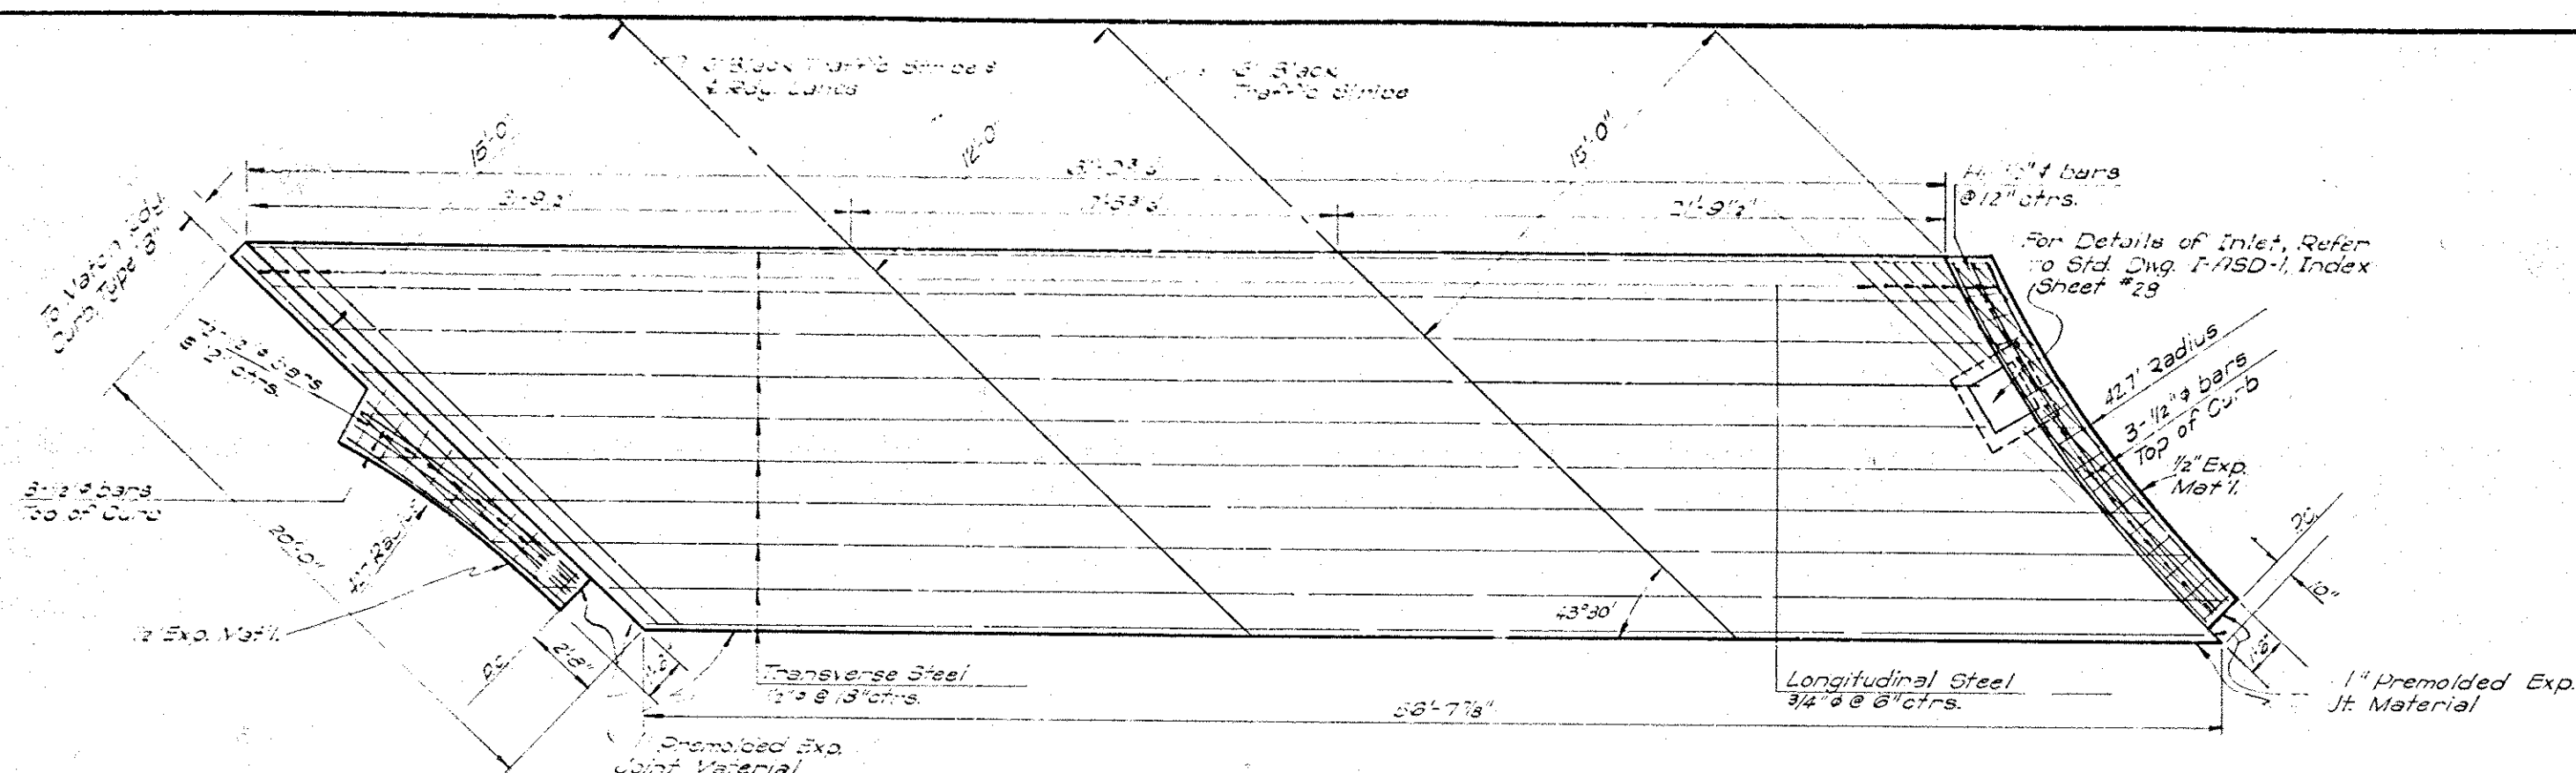

PLAN
APPR. SLAB # ABUT. No. 2

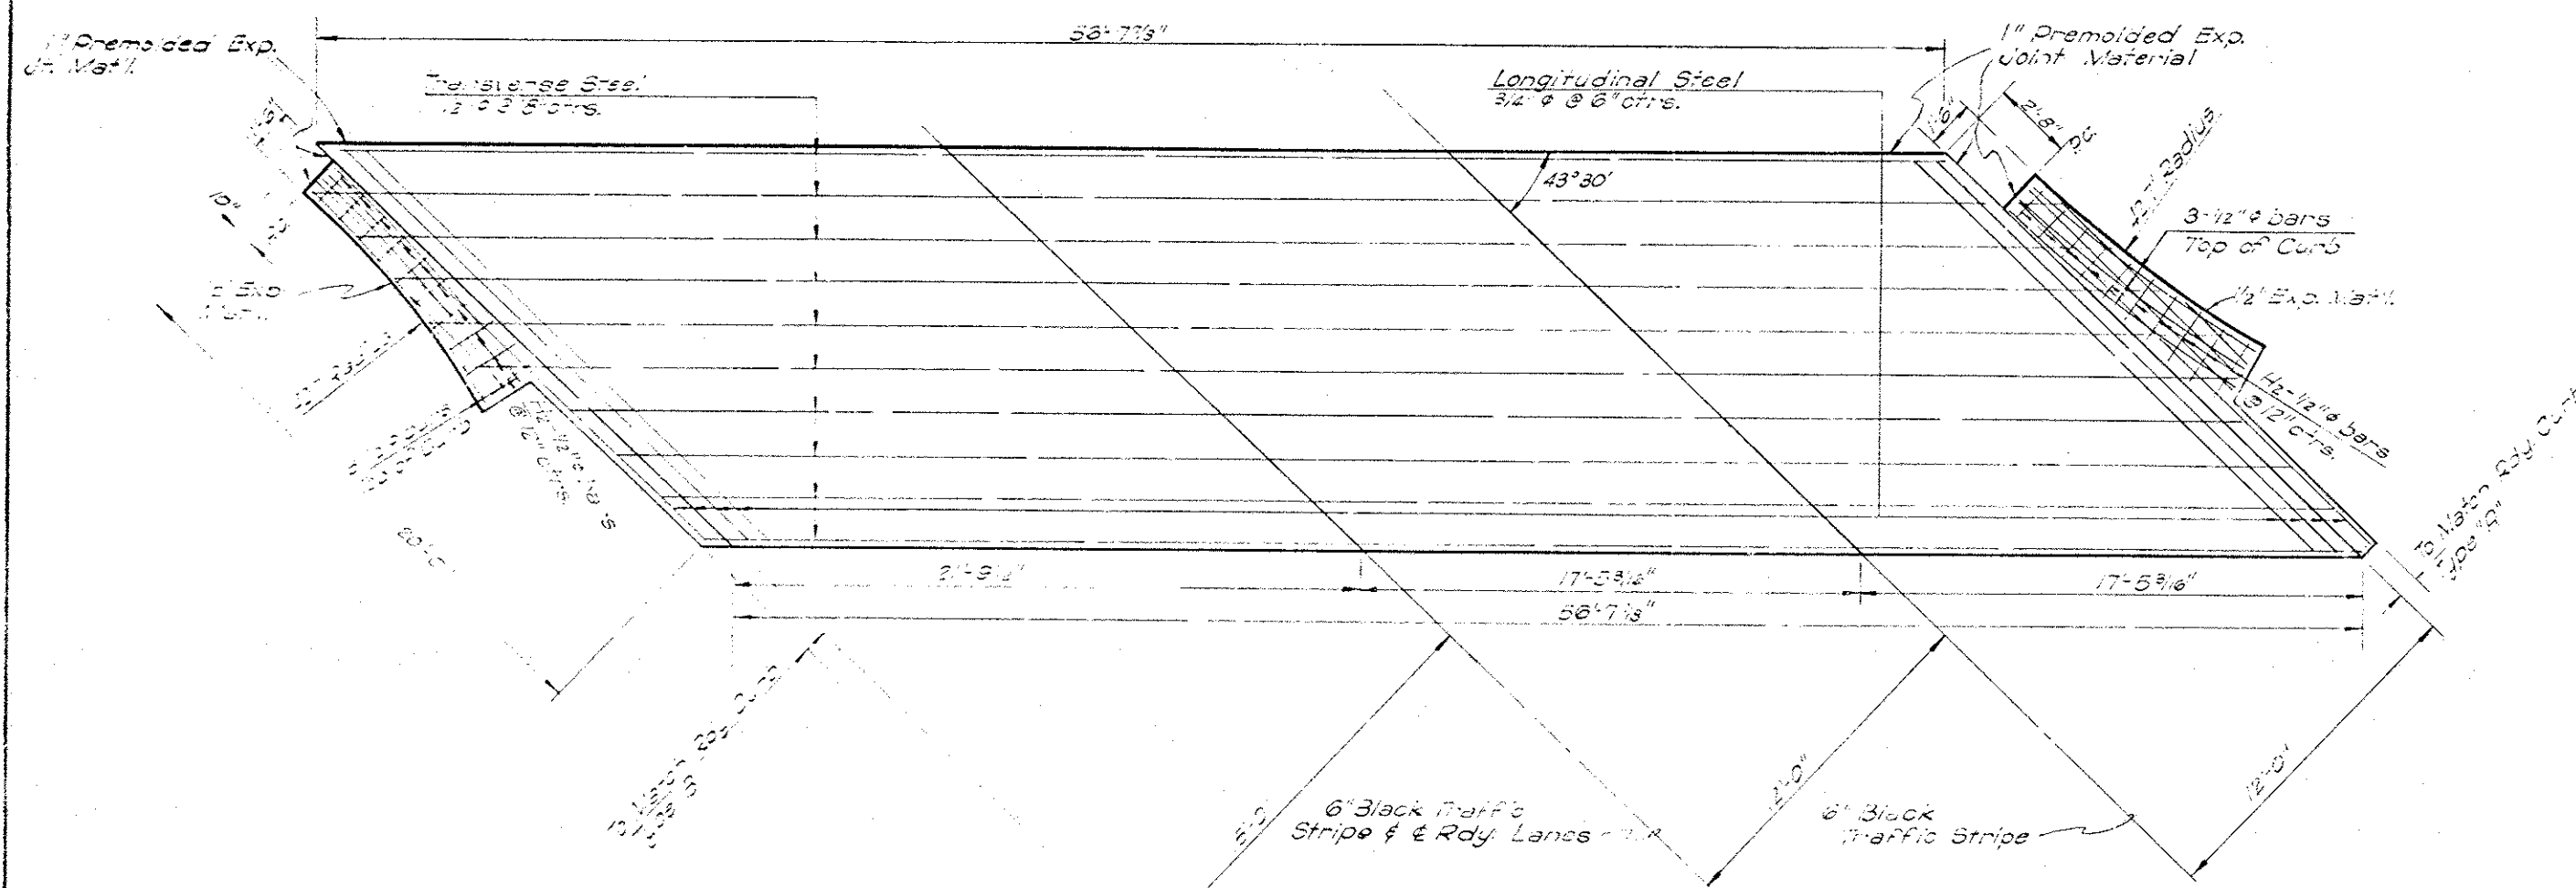


PLAN
APPR. SLAB # ABUT. No. 1

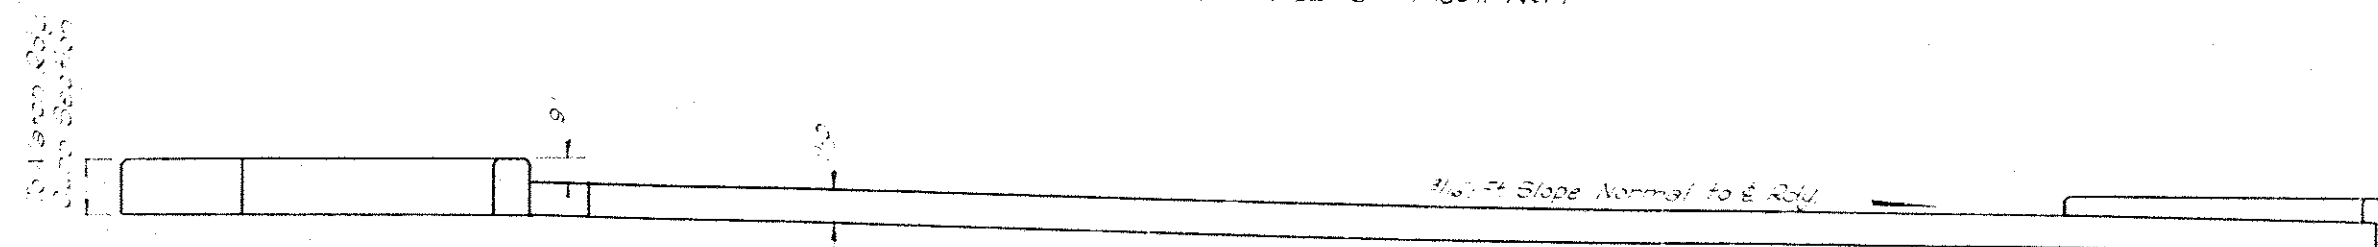


END VIEW

QUANTITIES— ONE APPROACH SLAB		
ITEM	UNIT	TOTAL
Approach Slab	Sq. Yd.	94.1
* Reinforcing Steel	Lbs.	2,395
6" Black Traffic Stripe	L.F.	40


* Note: Cost of Reinforcing Steel in Appr. Slab shall be included in price bid per Sq. Yd. of Approach Slab.
Note: Cost of Curb on Approach Slab shall be included in price bid per Sq. Yd. of Approach Slab.

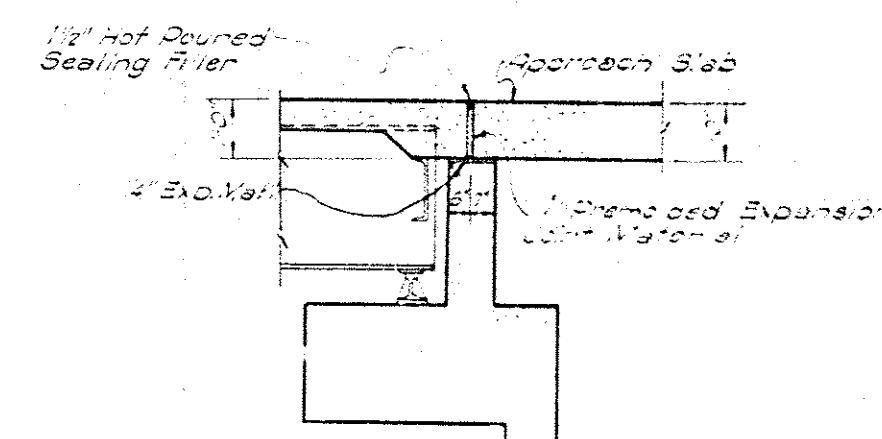


DETAIL OVER ABUTMENTS

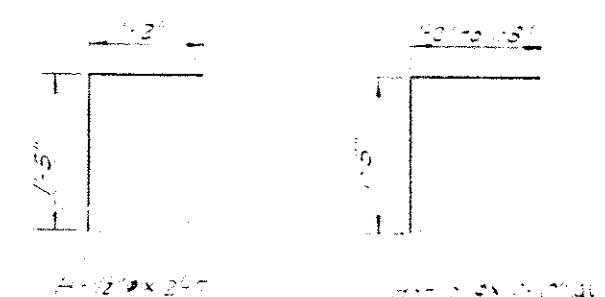


REVISIONS				RECORD				OKLAHOMA STATE HIGHWAY COMMISSION OKLAHOMA CITY, OKLAHOMA	
NO.	DESCRIPTION	BY	DATE	ITEM	BY	DATE			
				DESIGN					
				DETAIL					
				TRACED CFS					
				CHECKED CFC				STR. NO. 13 DETAILS OF APPROACH SLABS STATION SURVEY 142+94.24 FA. PROJ. I-381(16) PT.-2	
				APPROVED					
				SKETCHED BY					

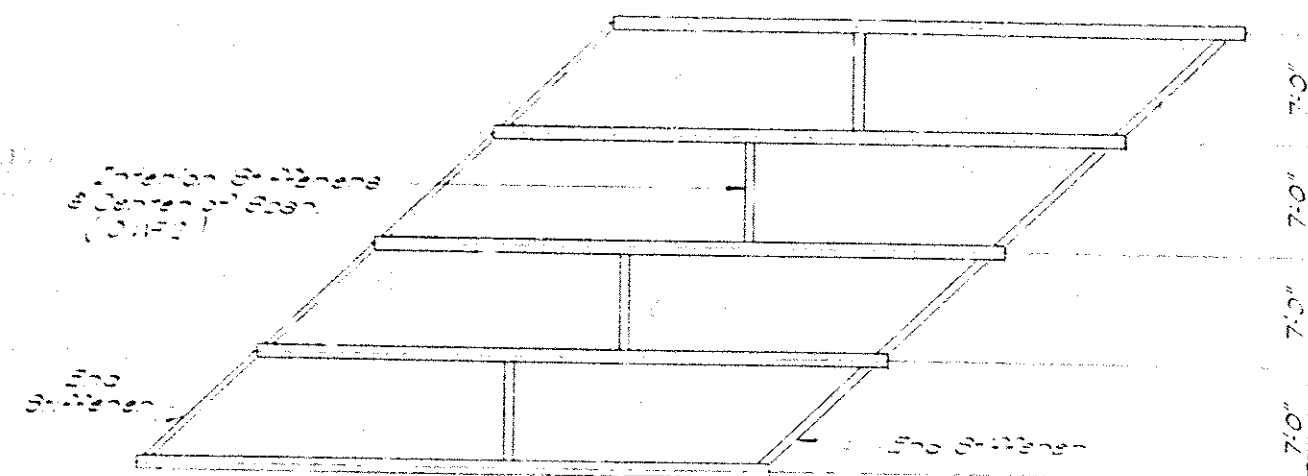


LAYOUT OF BEAMS & STIFFENERS - 40' SPAN
STR. NO. 12

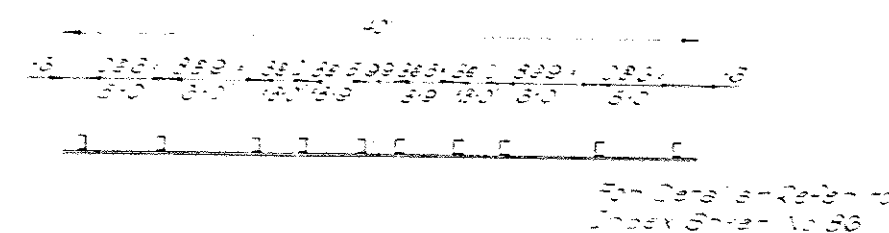


SHEAR CONNECTOR SPACING
FOR STR. NO. 12 & STR. NO. 13

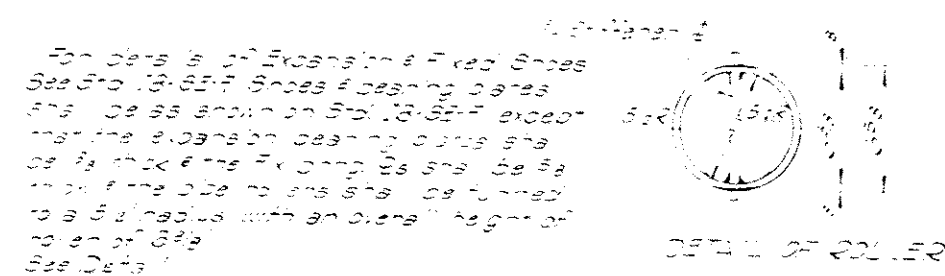


BEARING DETAILS - 40' SPAN
STR. NO. 12
STR. NO. 13

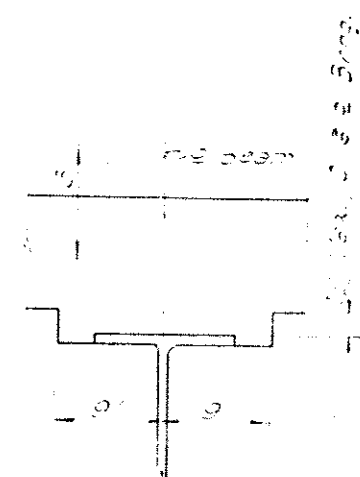



DETAIL OF HAUNCH

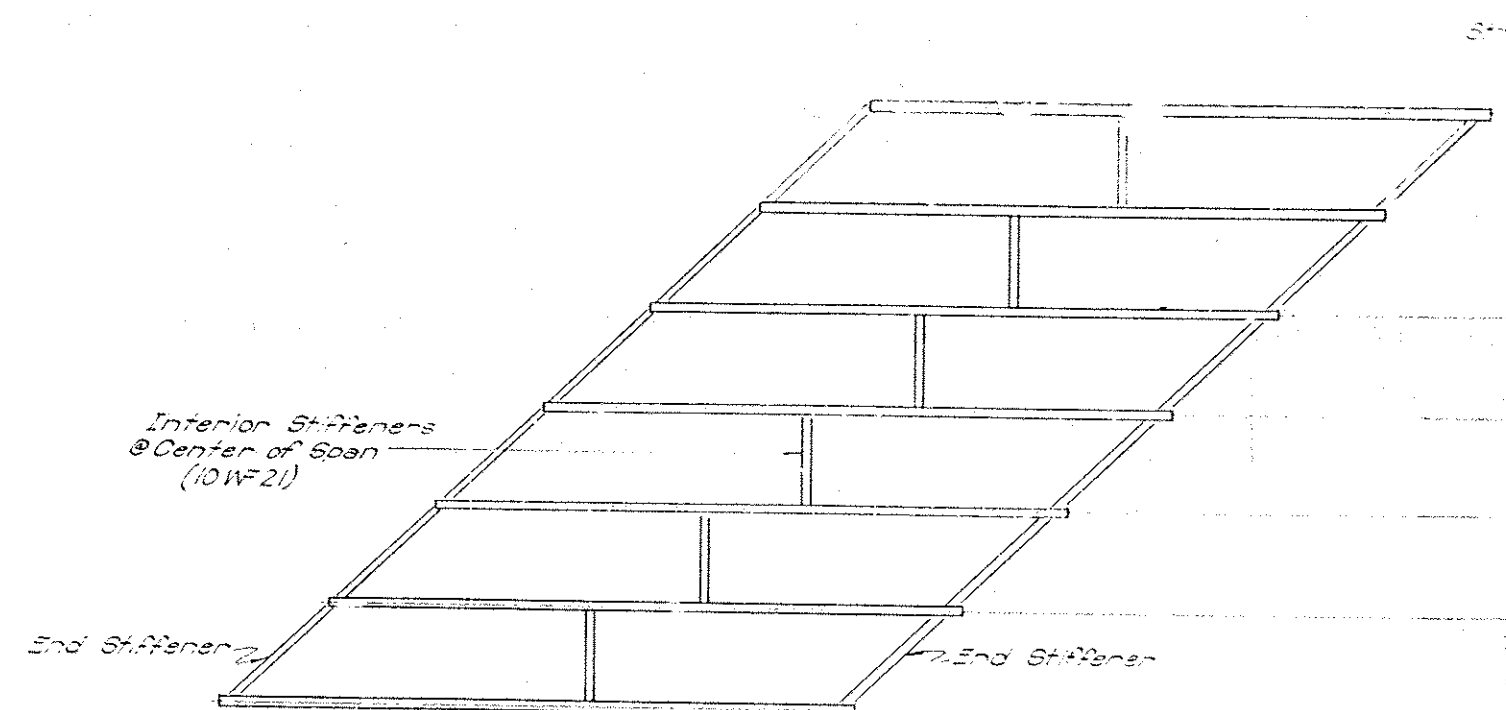

LAYOUT OF BEAMS & STIFFENERS - 40' SPAN
STR. NO. 13

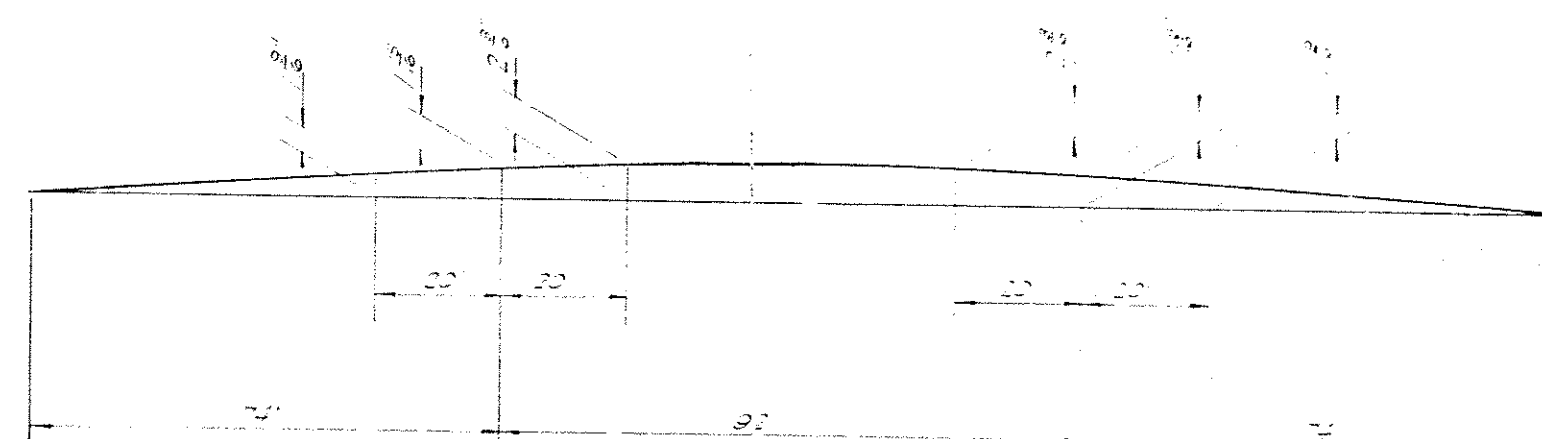


BEAM BLOCKING DIAGRAM
STR. NO. 12
STR. NO. 13


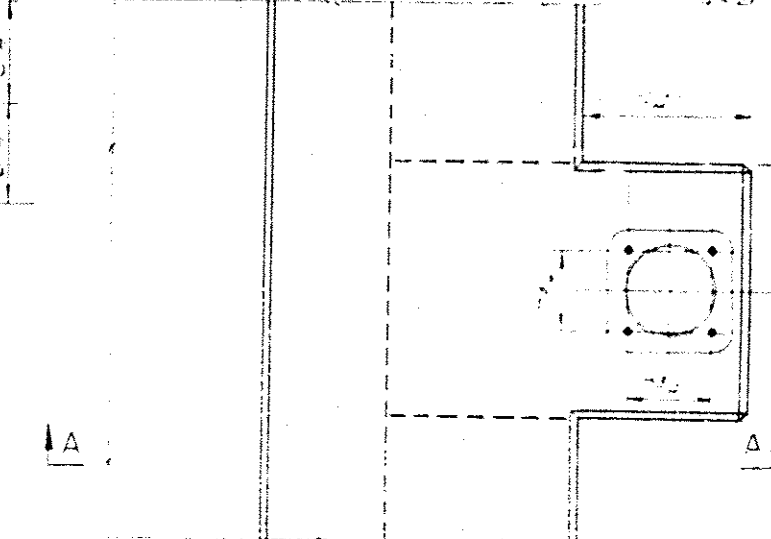
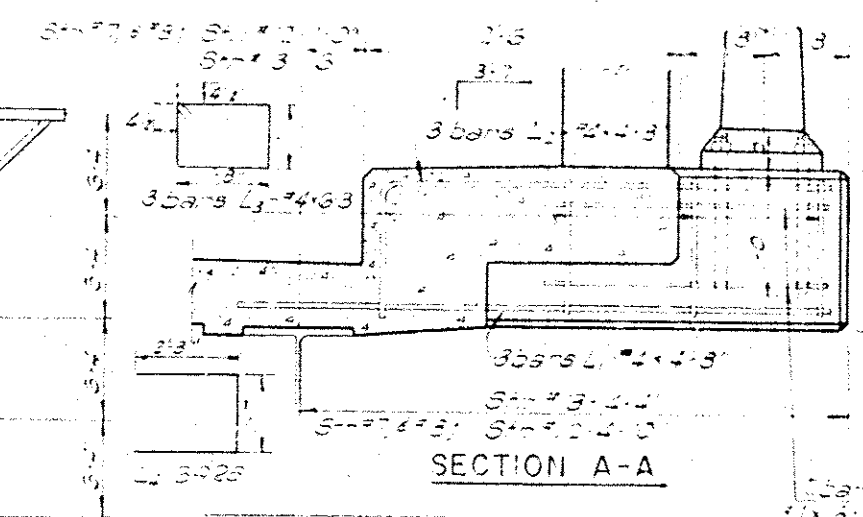


POLE BRACKET DETAILS

<p>DESIGNED BY: [Signature]</p> <p>CHECKED BY: [Signature]</p> <p>DATE: 10/1/81</p>	<p>REVISIONS:</p> <p>NO. 1: [Description]</p> <p>NO. 2: [Description]</p>	<p>OKLAHOMA STATE HIGHWAY COMMISSION</p> <p>STRUCTURAL STEEL DETAILS</p> <p>STR. NO. 12</p> <p>CL STA. ON SURVEY 143+60.30</p> <p>STR. NO. 13</p> <p>CL STA. ON SURVEY 142+94.24</p> <p>FA. PROJ. 1-381(16) PT. 2</p>
---	---	---

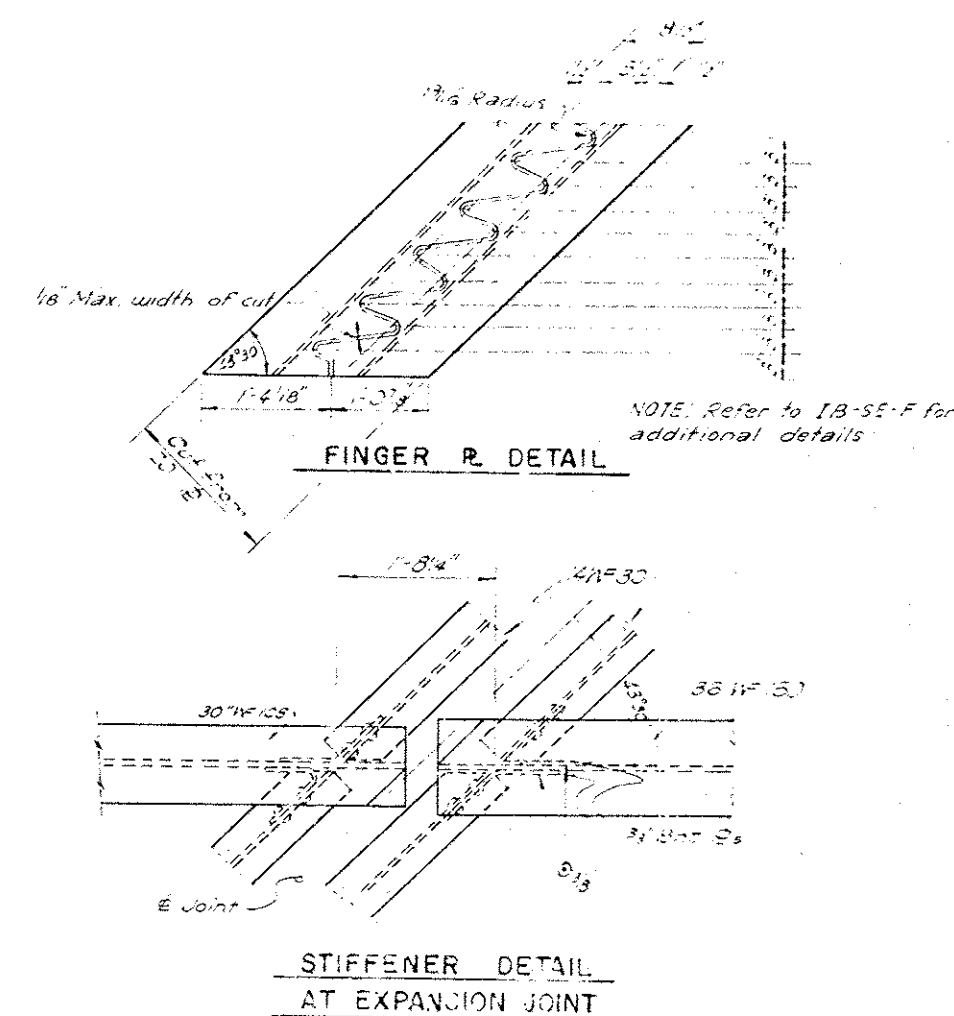

- [illegible]

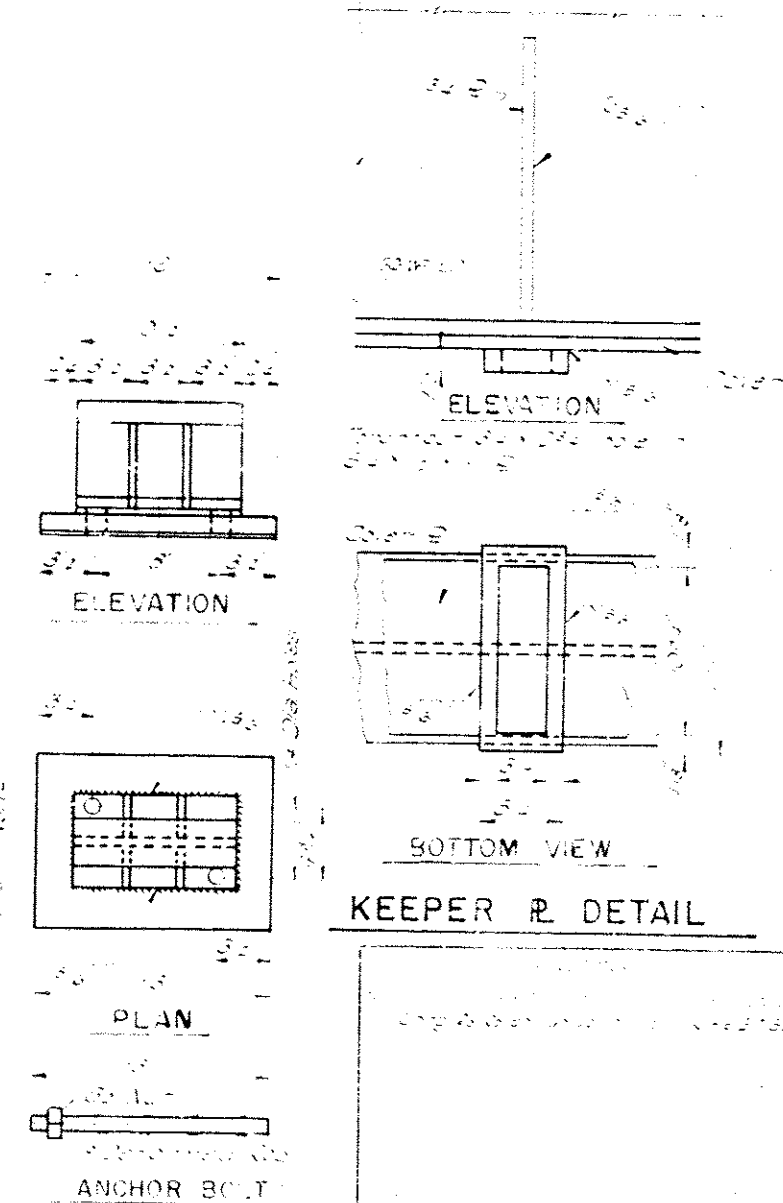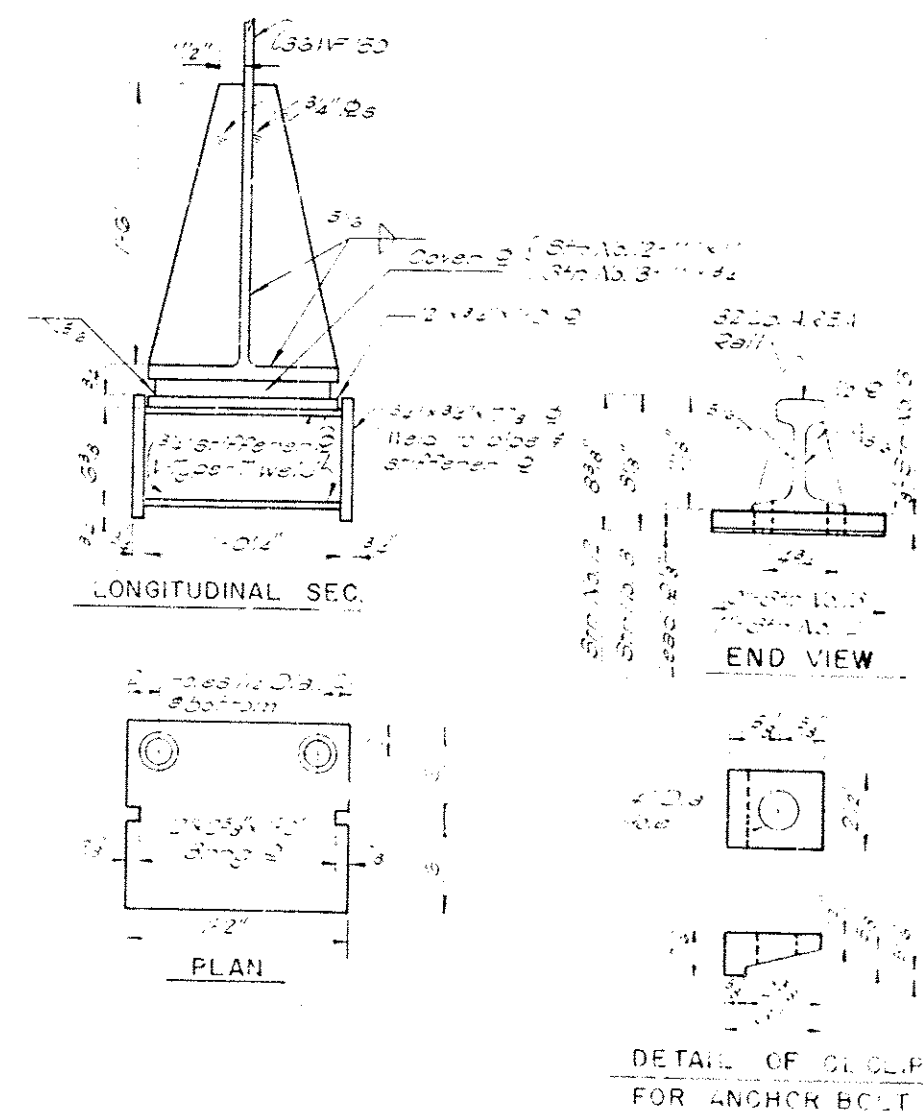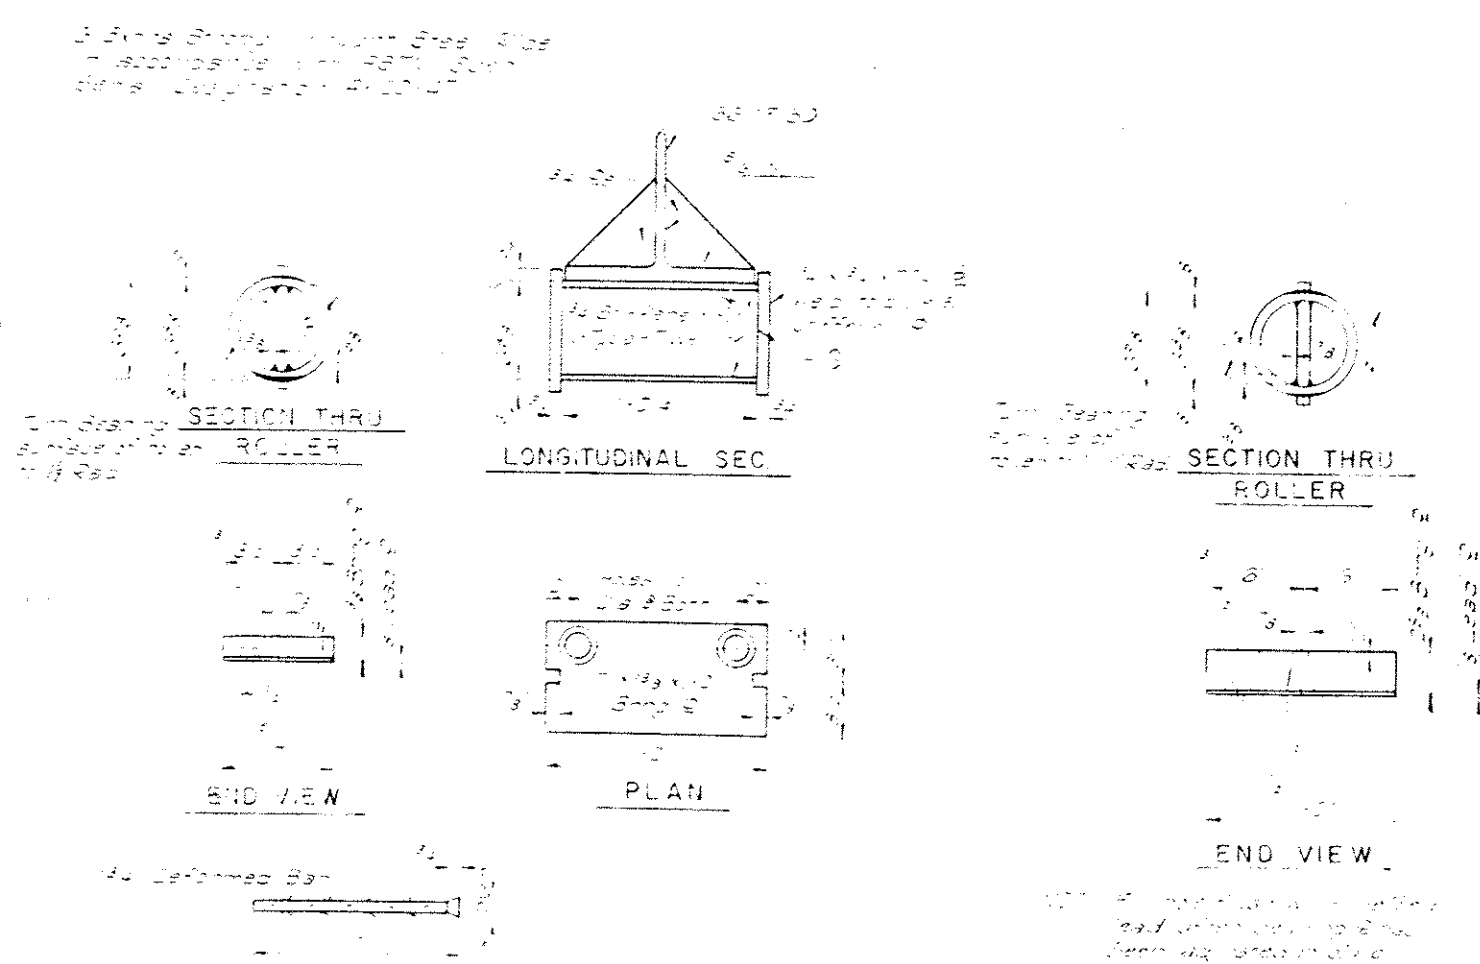

RECORD
DATE
DRAWN
CHECKED
APPROVED
BY

OKLAHOMA STATE HIGHWAY COMMISSION
OKLAHOMA CITY, OKLAHOMA

STRUCTURAL STEEL DETAILS
STR. NO.12
STA. ON SURVEY 143+60.30
STR. NO.13
STA. ON SURVEY 142+94.24
FA. PROJ. 1-381(16) PT. 2